




115+50

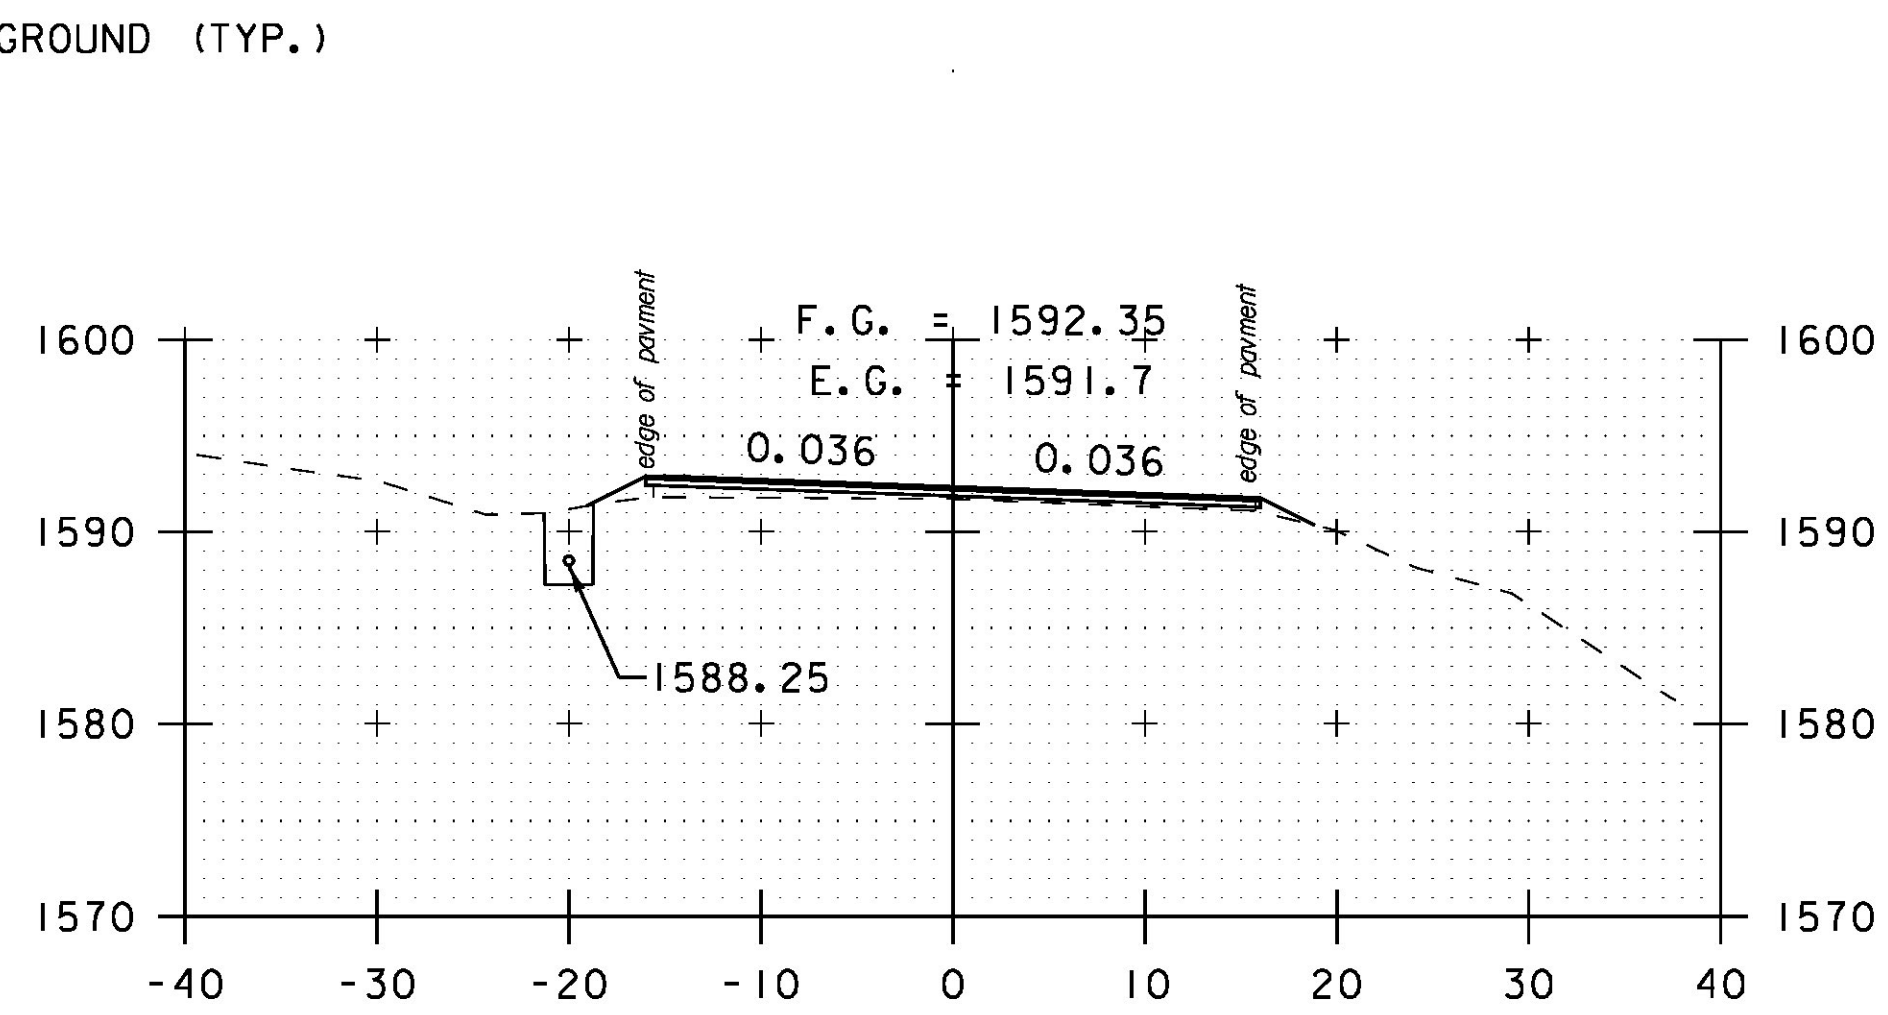


116+50

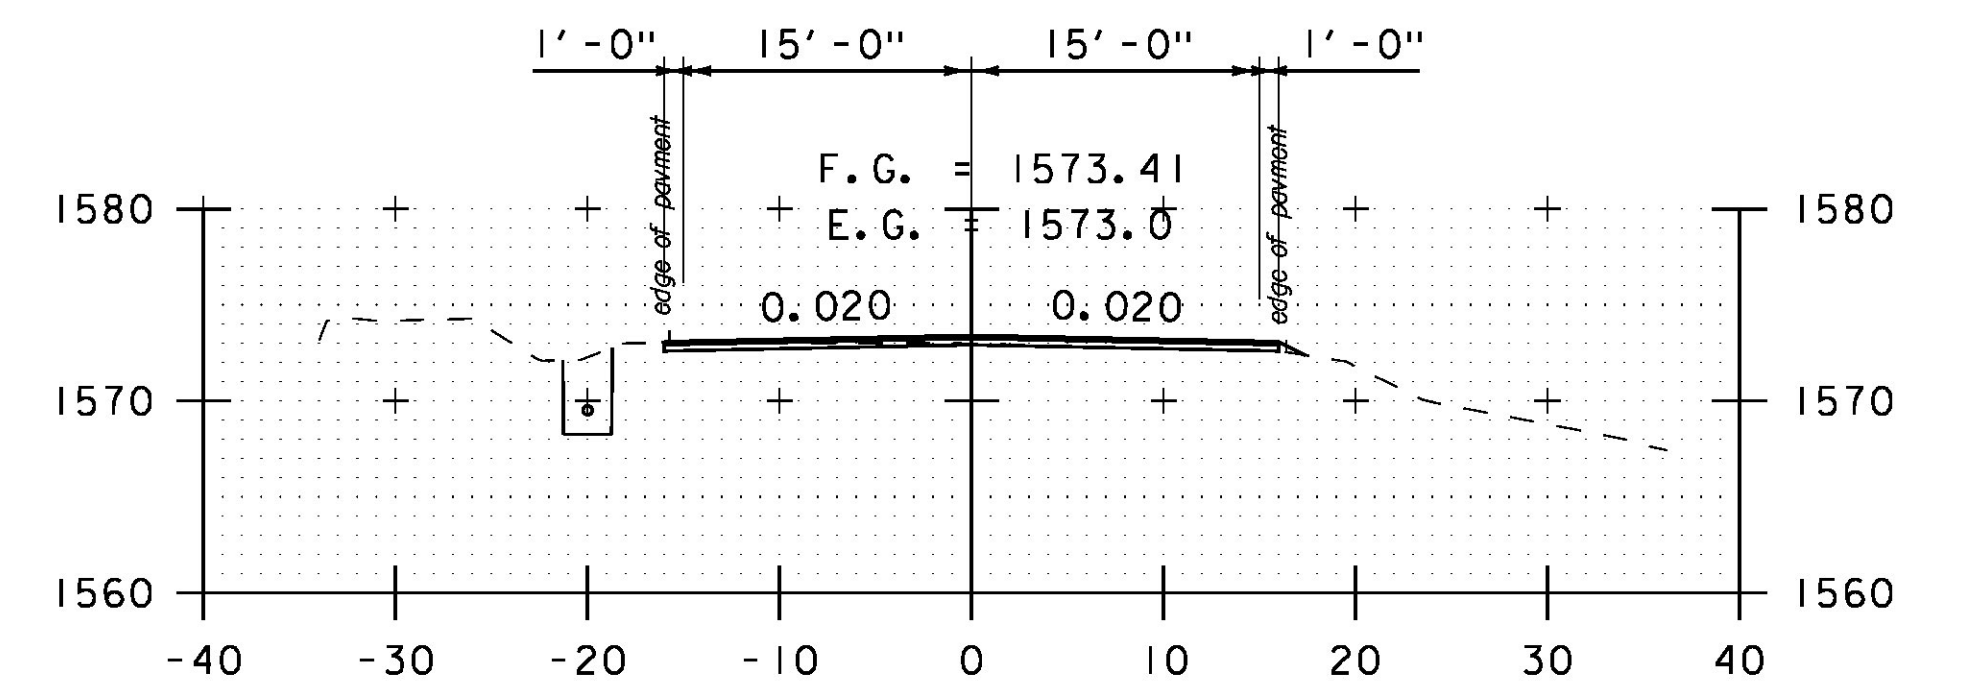


118+50

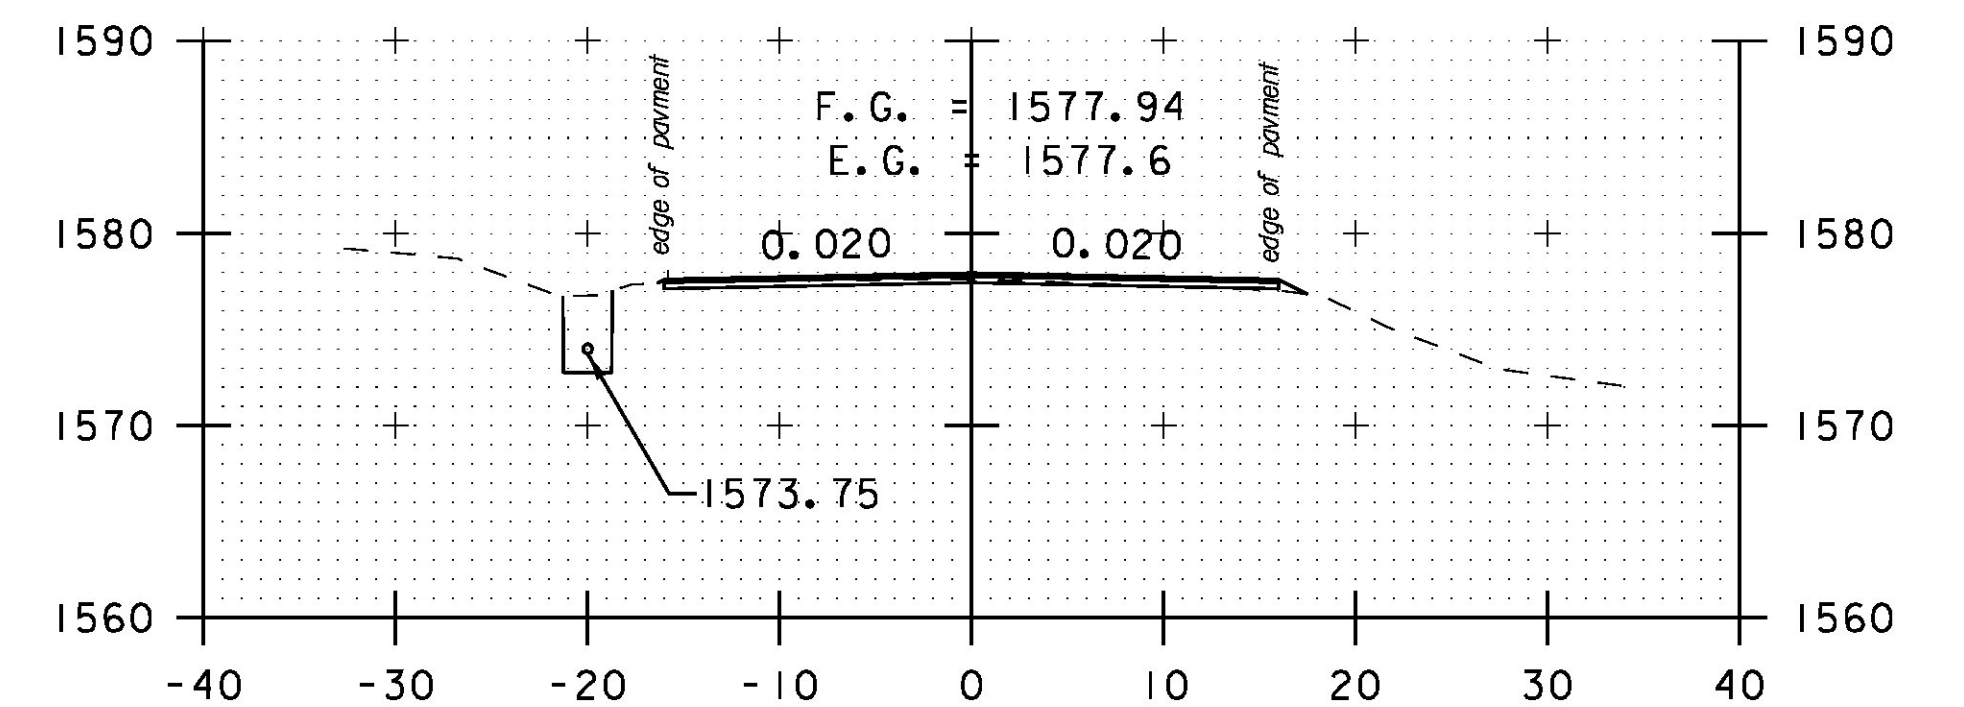


118+00

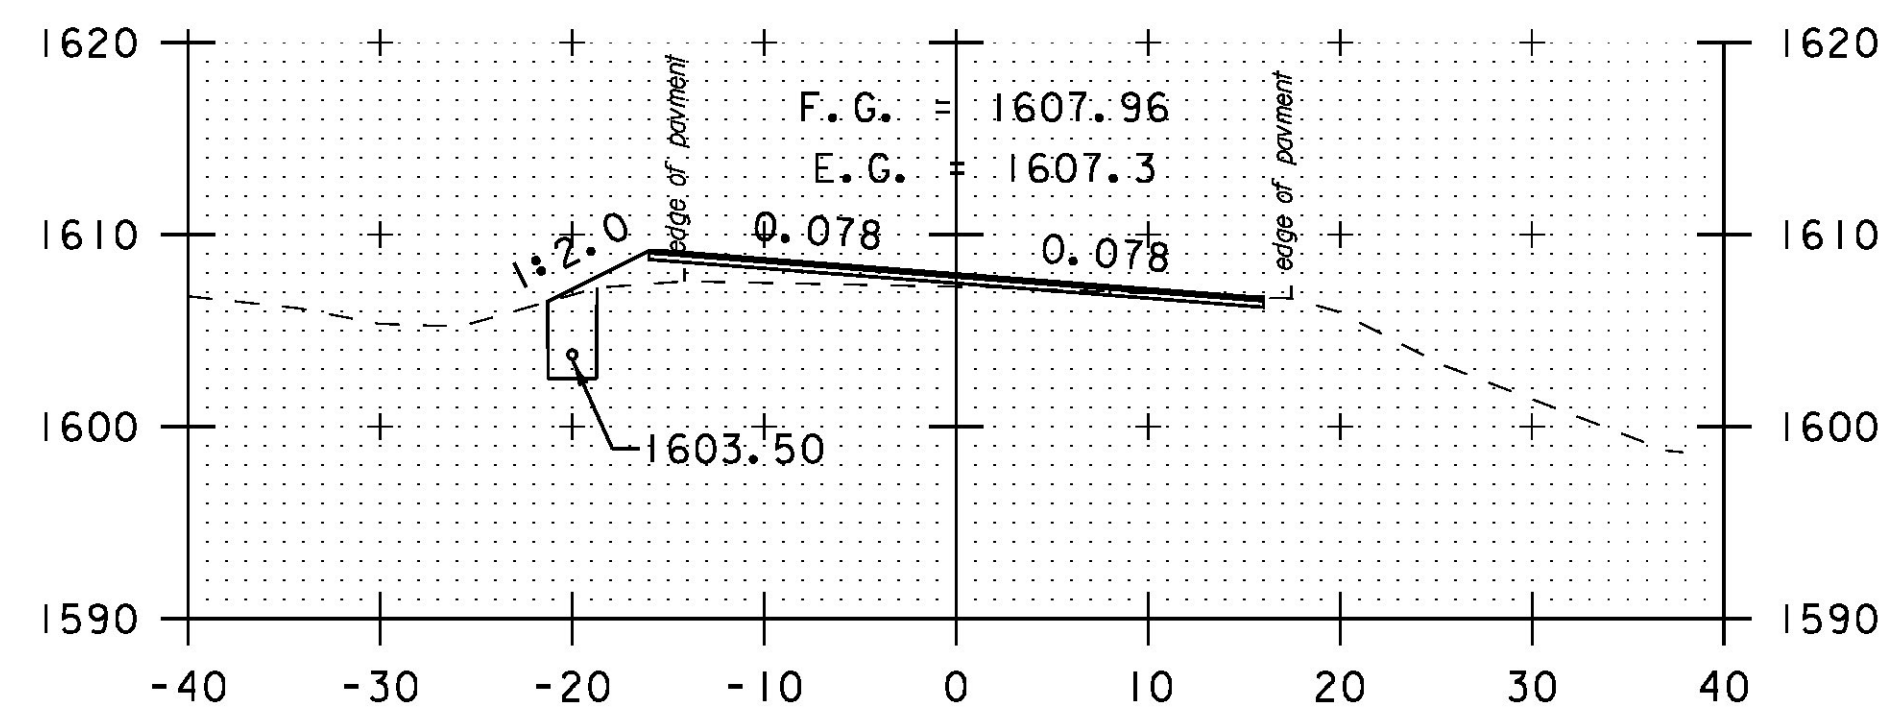


115+00

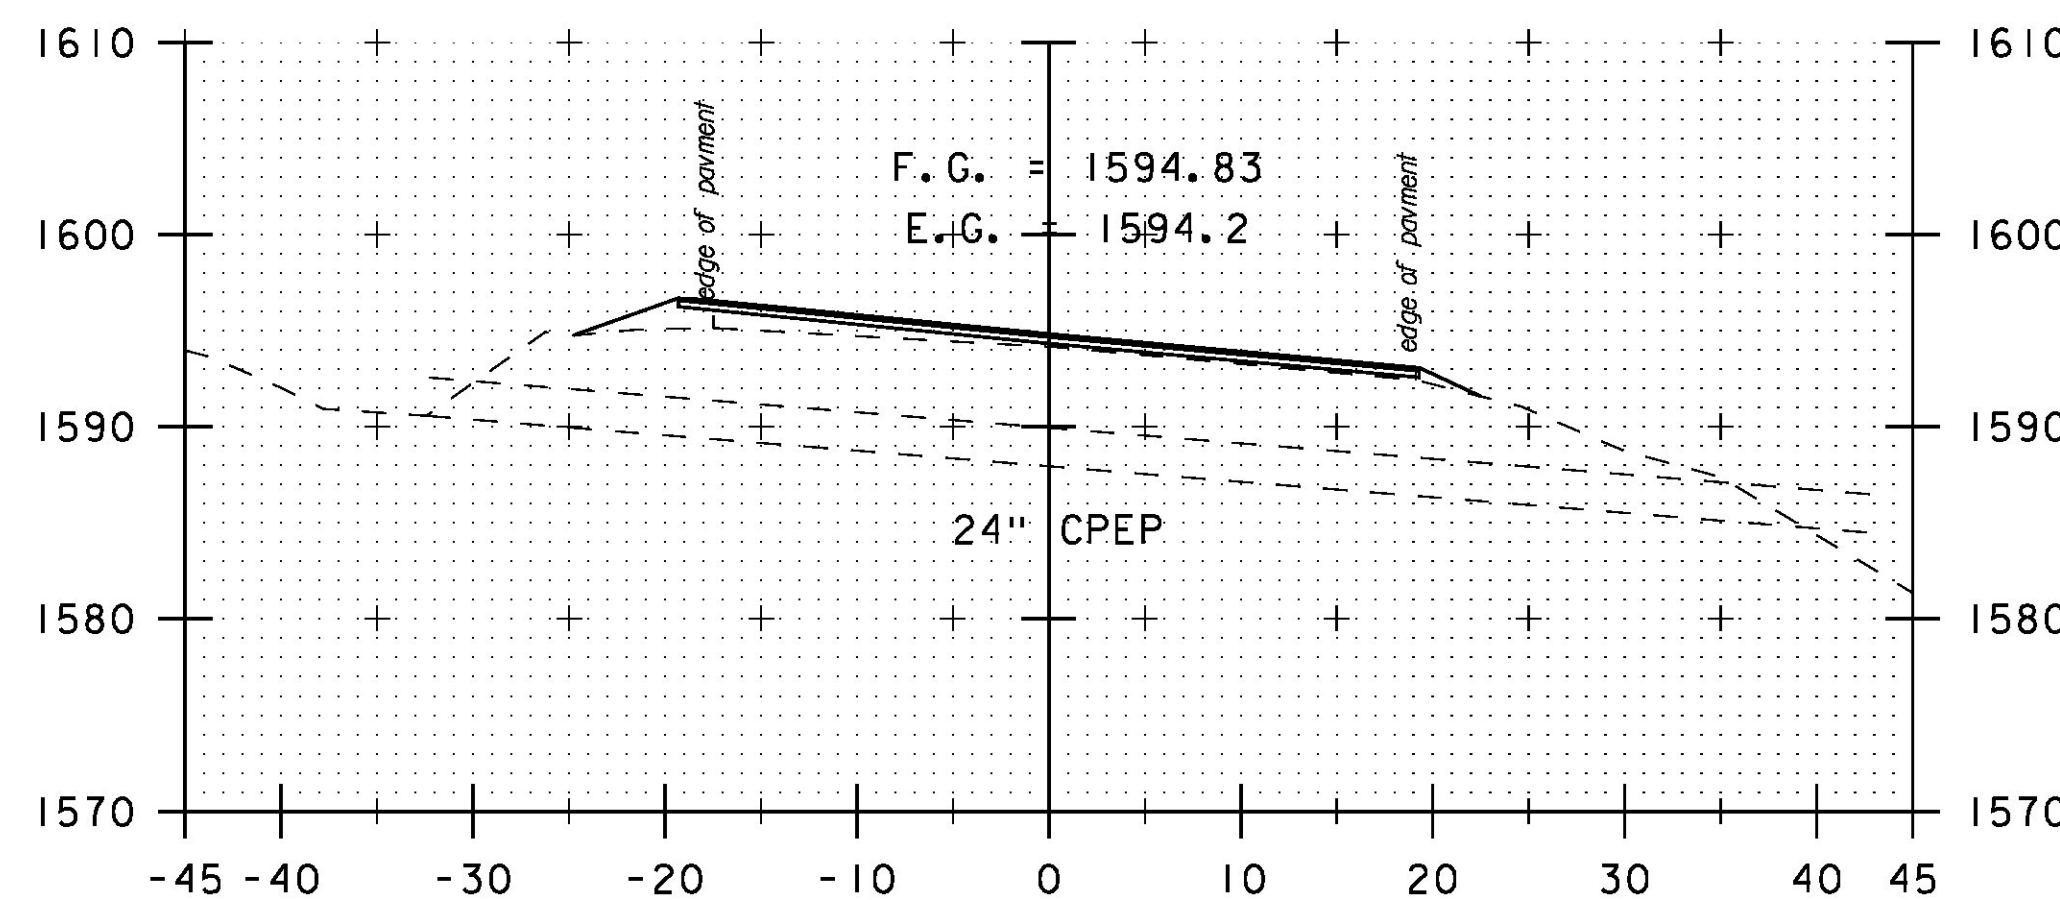


116+25

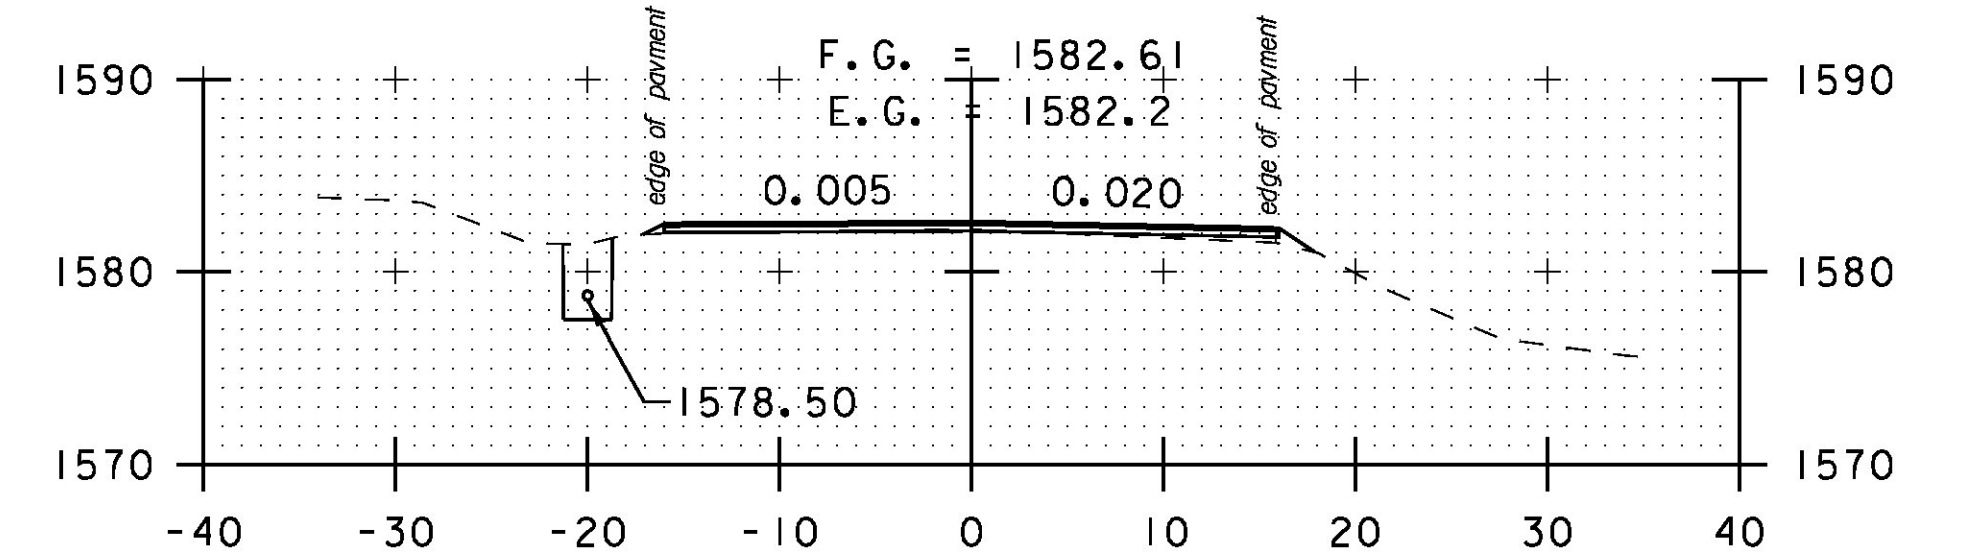


117+50

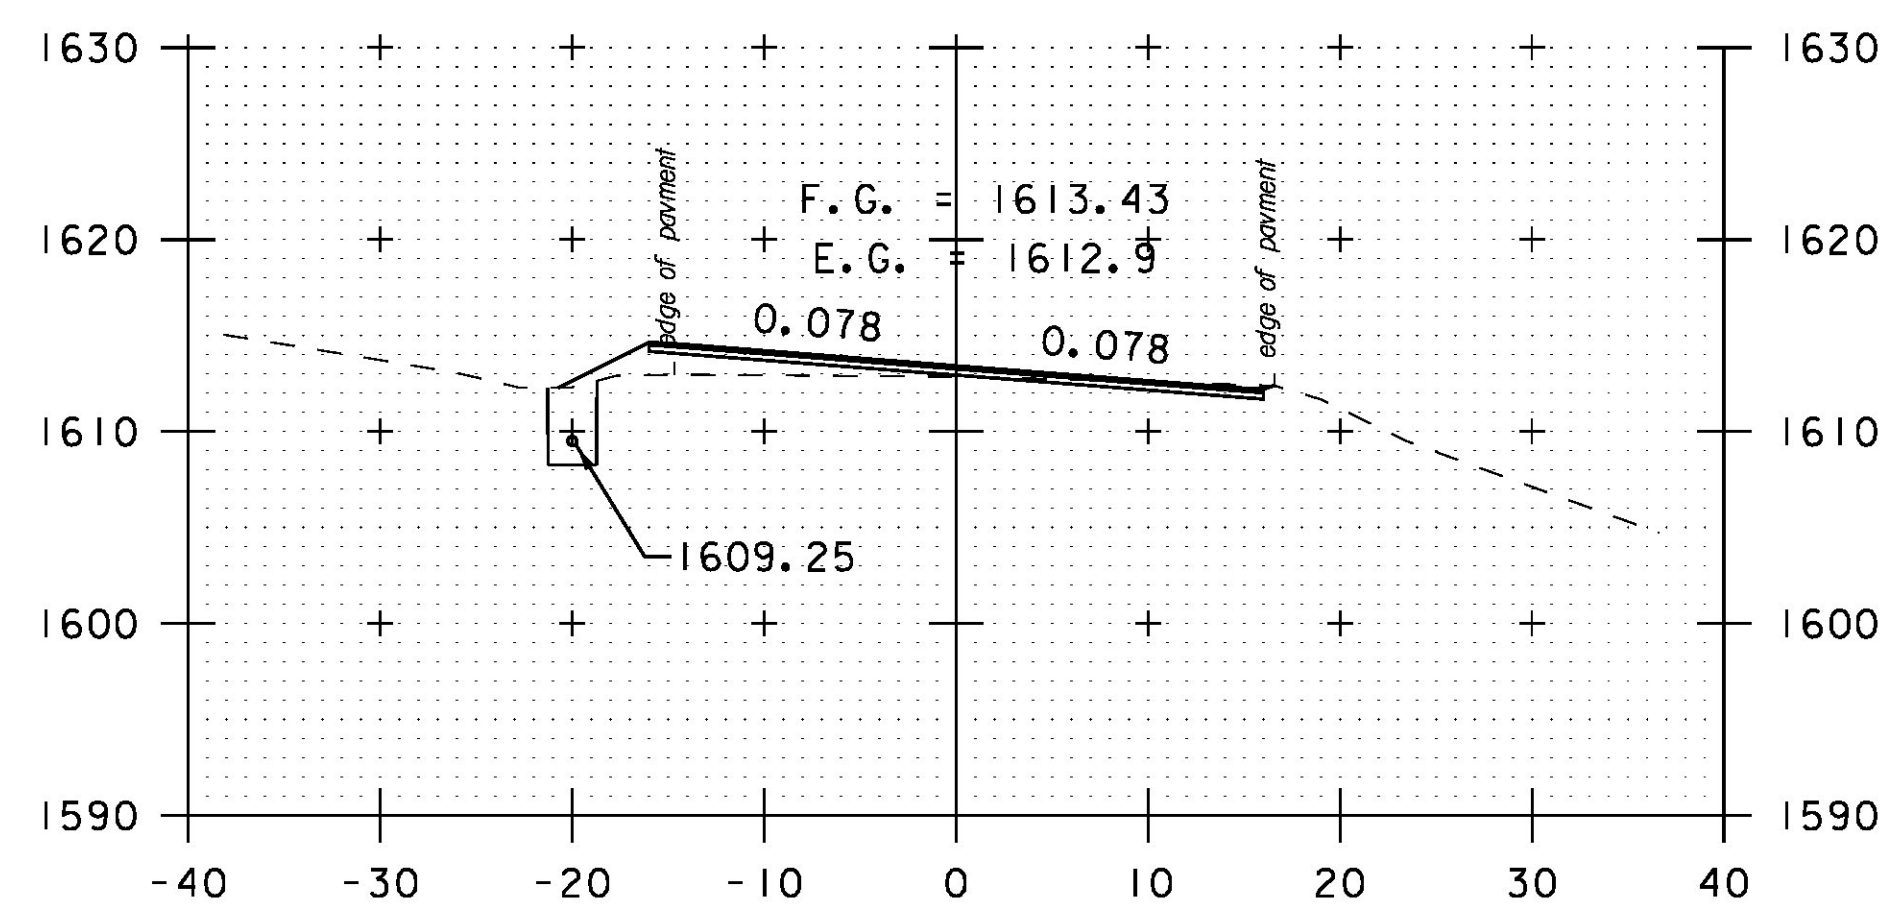

114+50

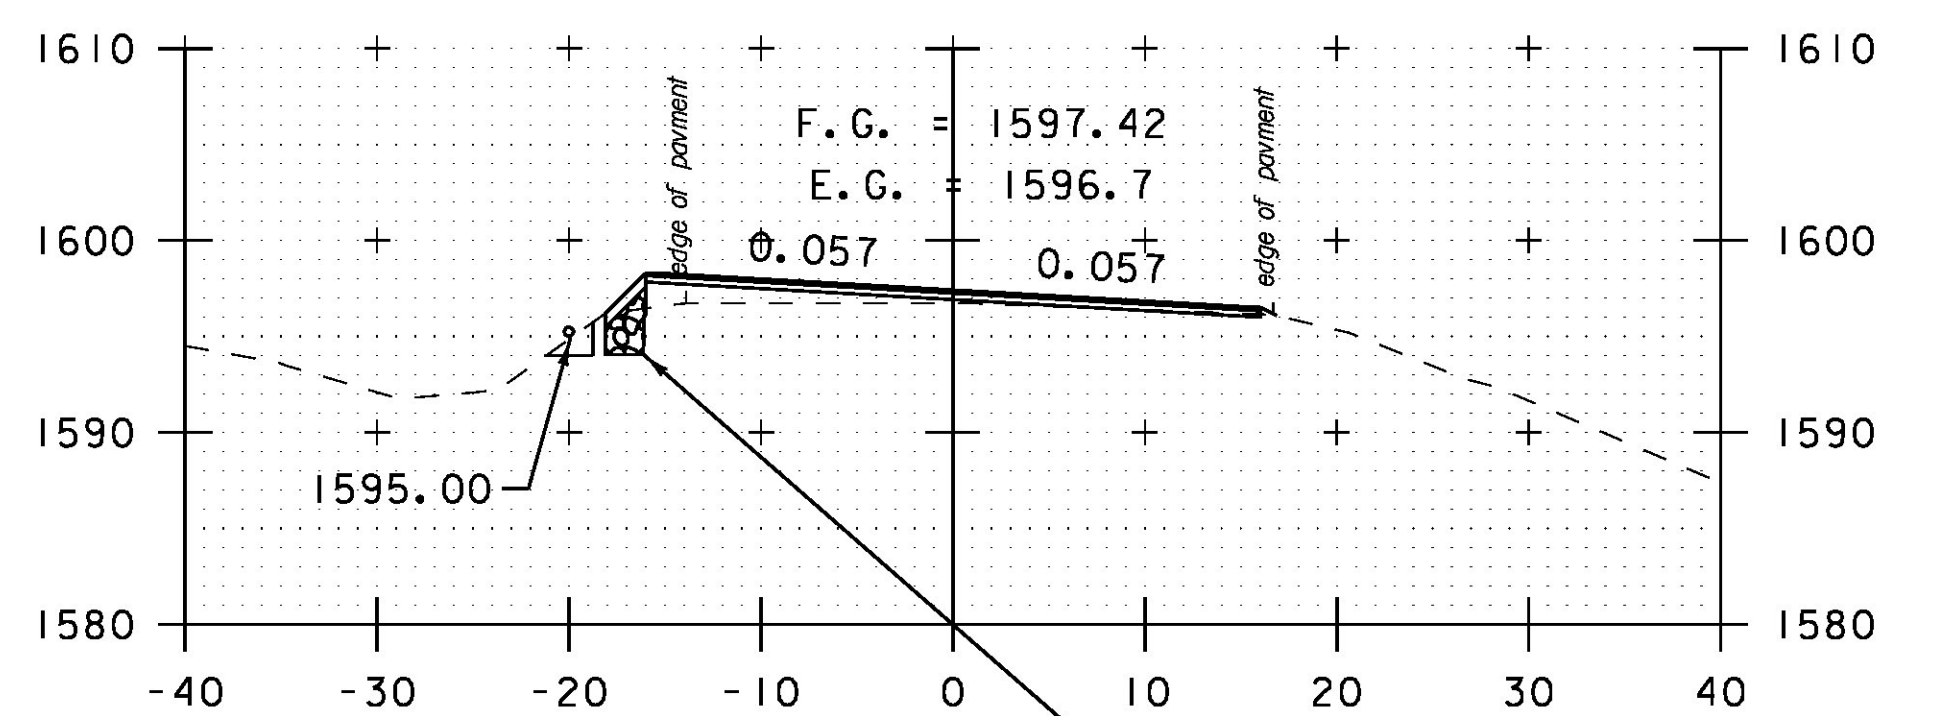

116+00

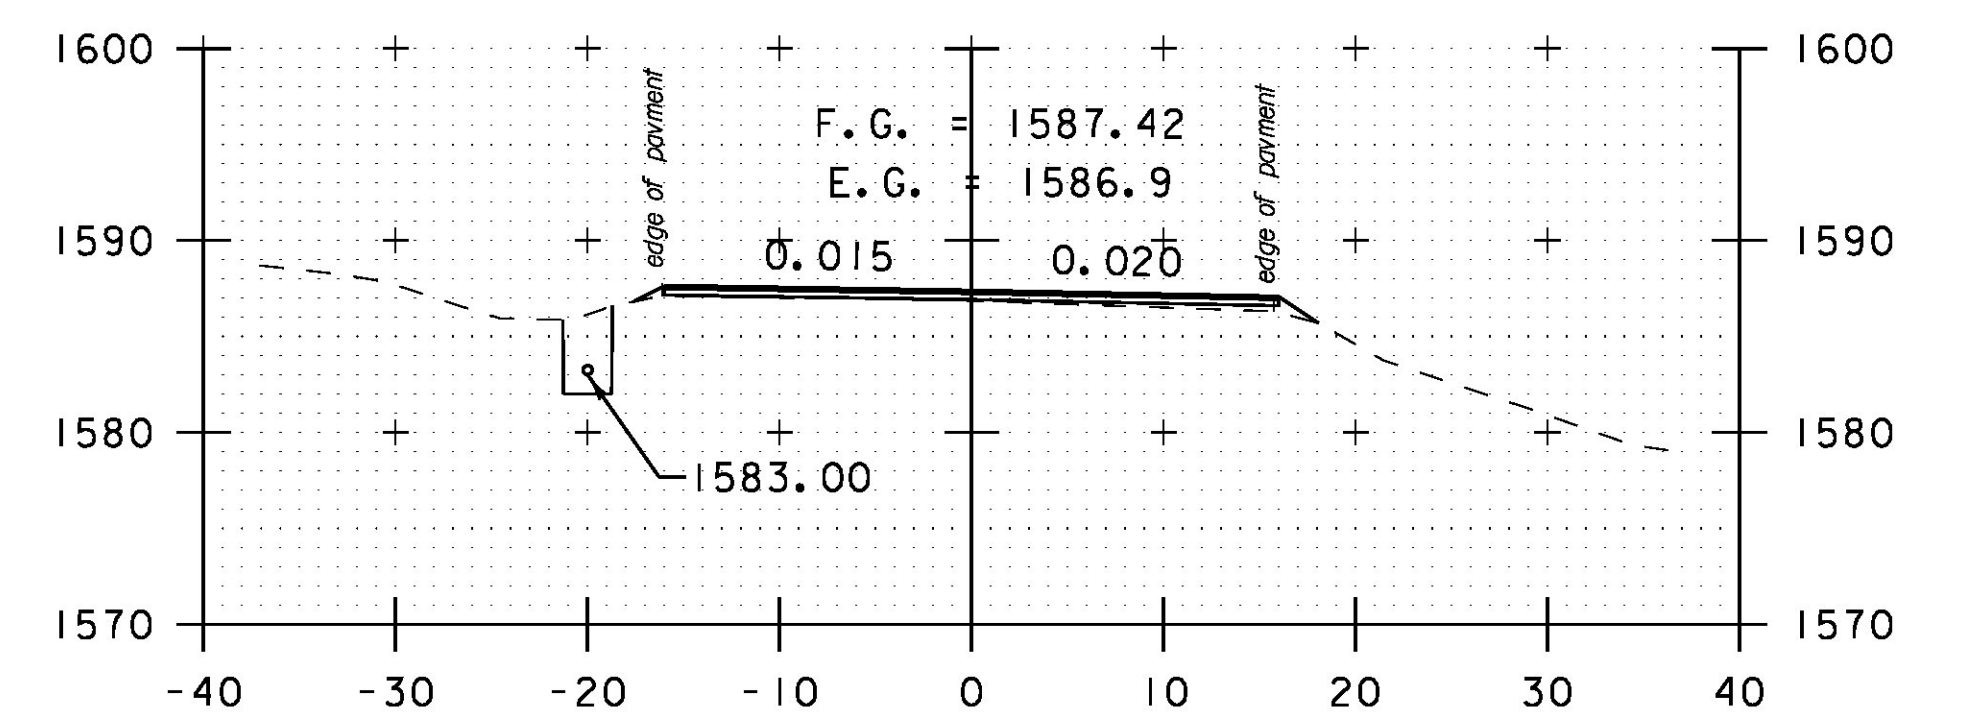

117+00

12" STONE FILL, TYPE I (TYP.)  
GRUBBING MATERIAL (6") (TYP.)



PROJECT NAME: HANCOCK	
PROJECT NUMBER: STP 2923 (1)	
FILE NAME: z10c252xs.dgn	PLOT DATE: 3/18/2015
PROJECT LEADER: C. LATHROP	DRAWN BY: B. MARTIN
DESIGNED BY: B. MARTIN	CHECKED BY: C. LATHROP
CROSS SECTION SHEET 17	SHEET 144 OF 207