




124+50

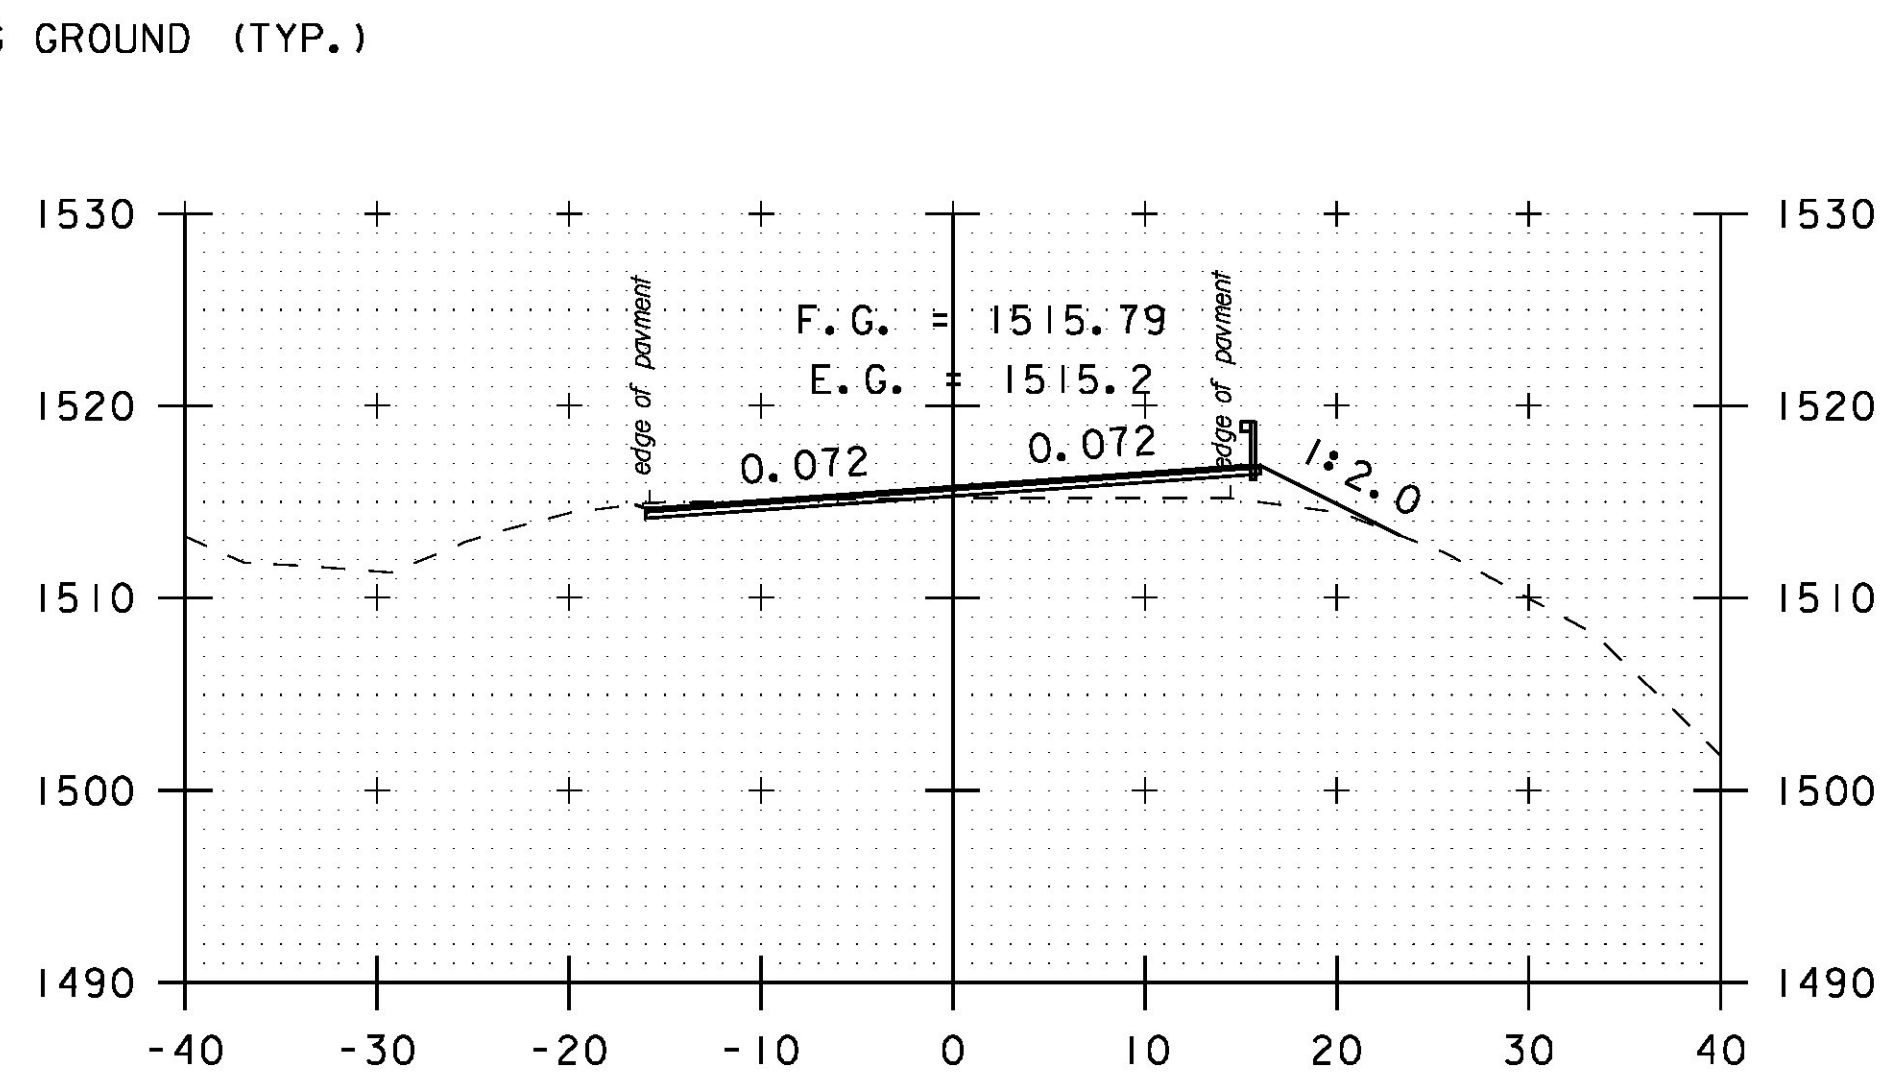


125+50

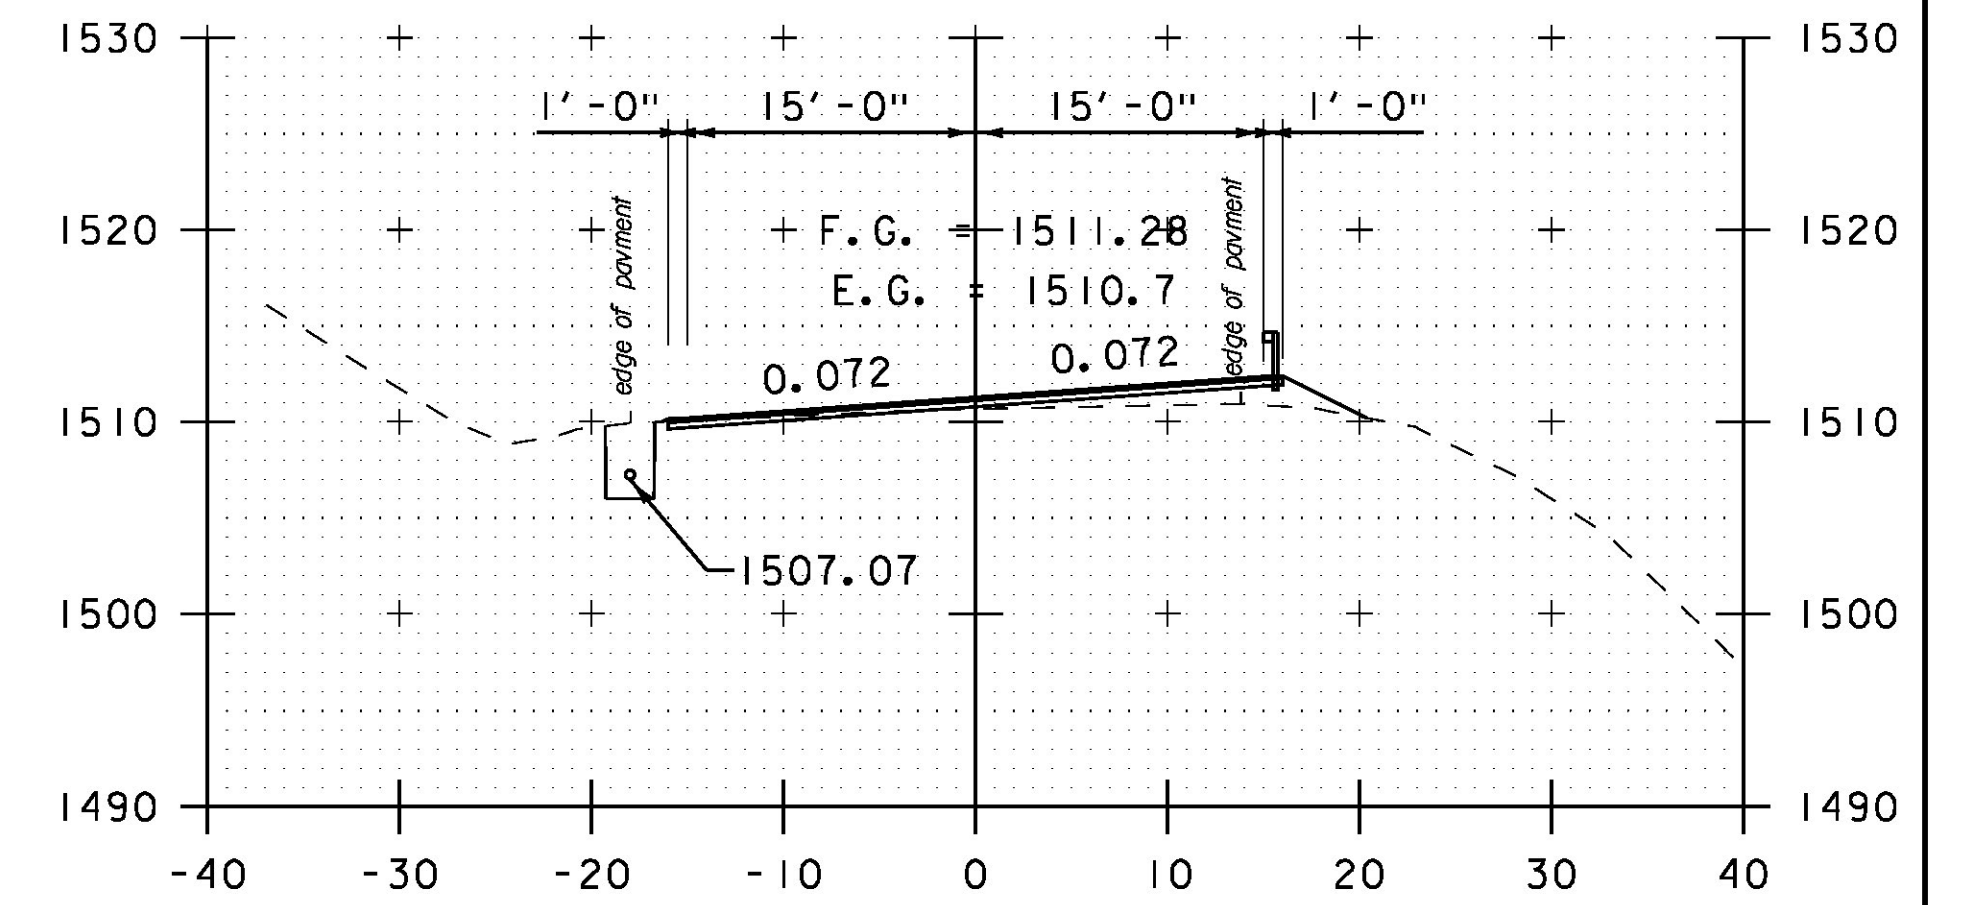


127+00

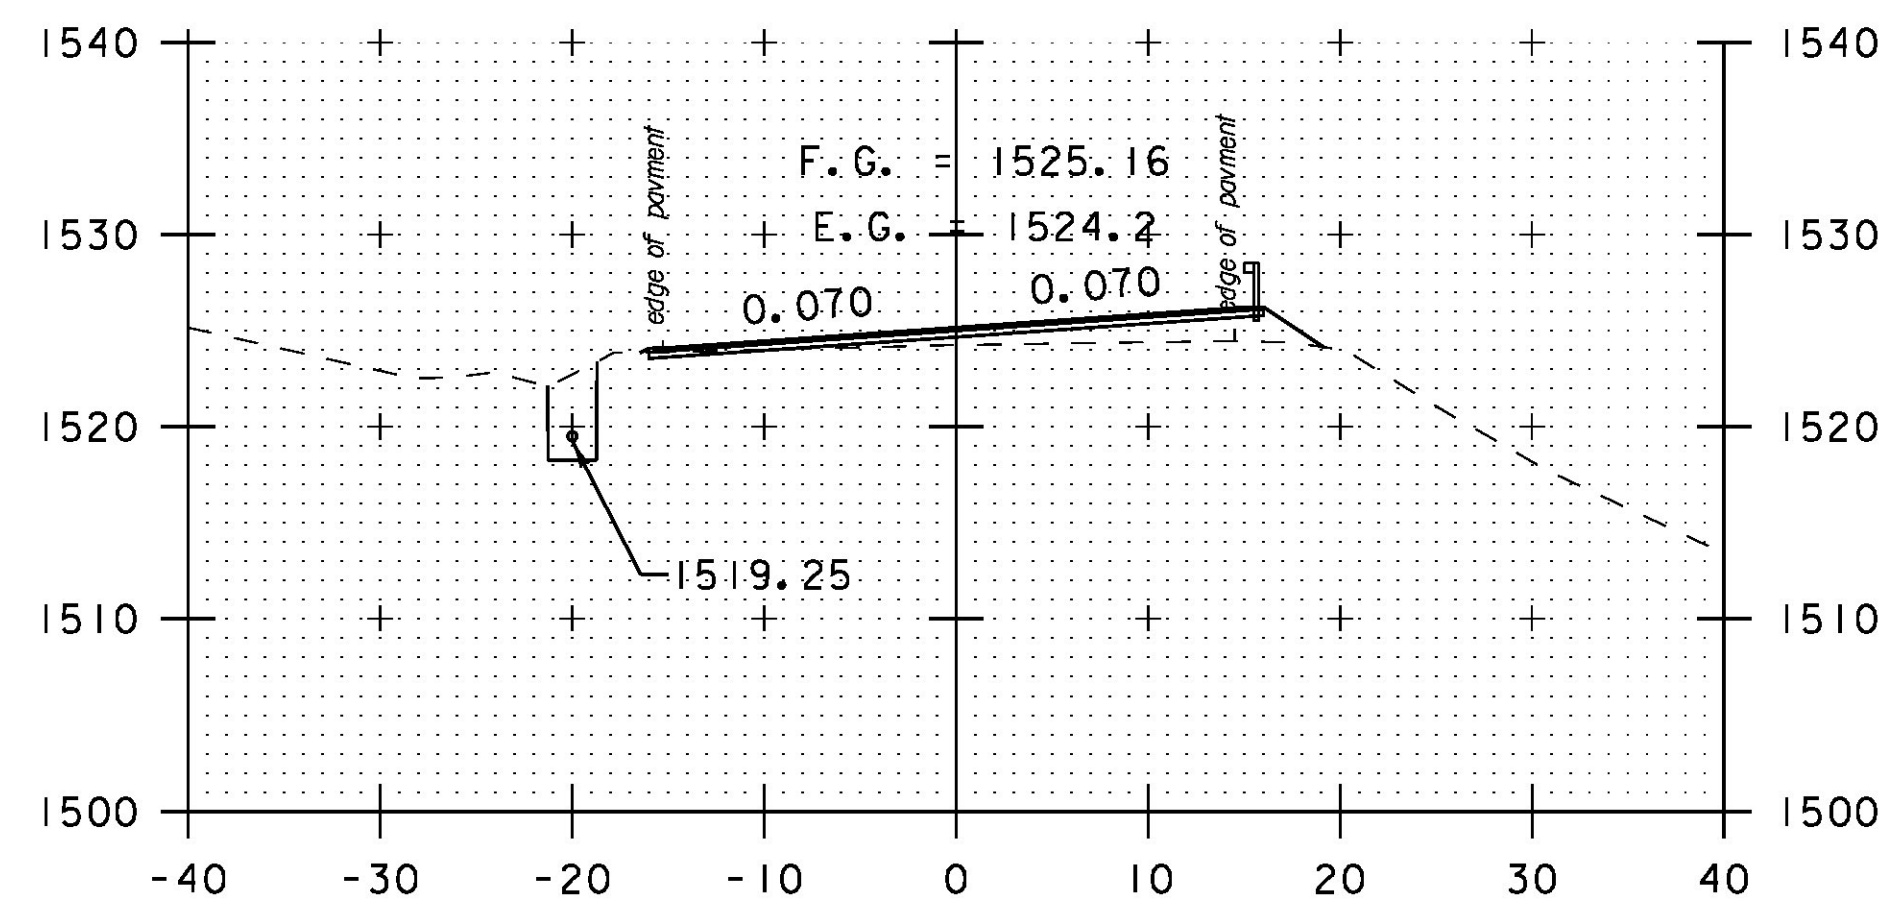


124+00

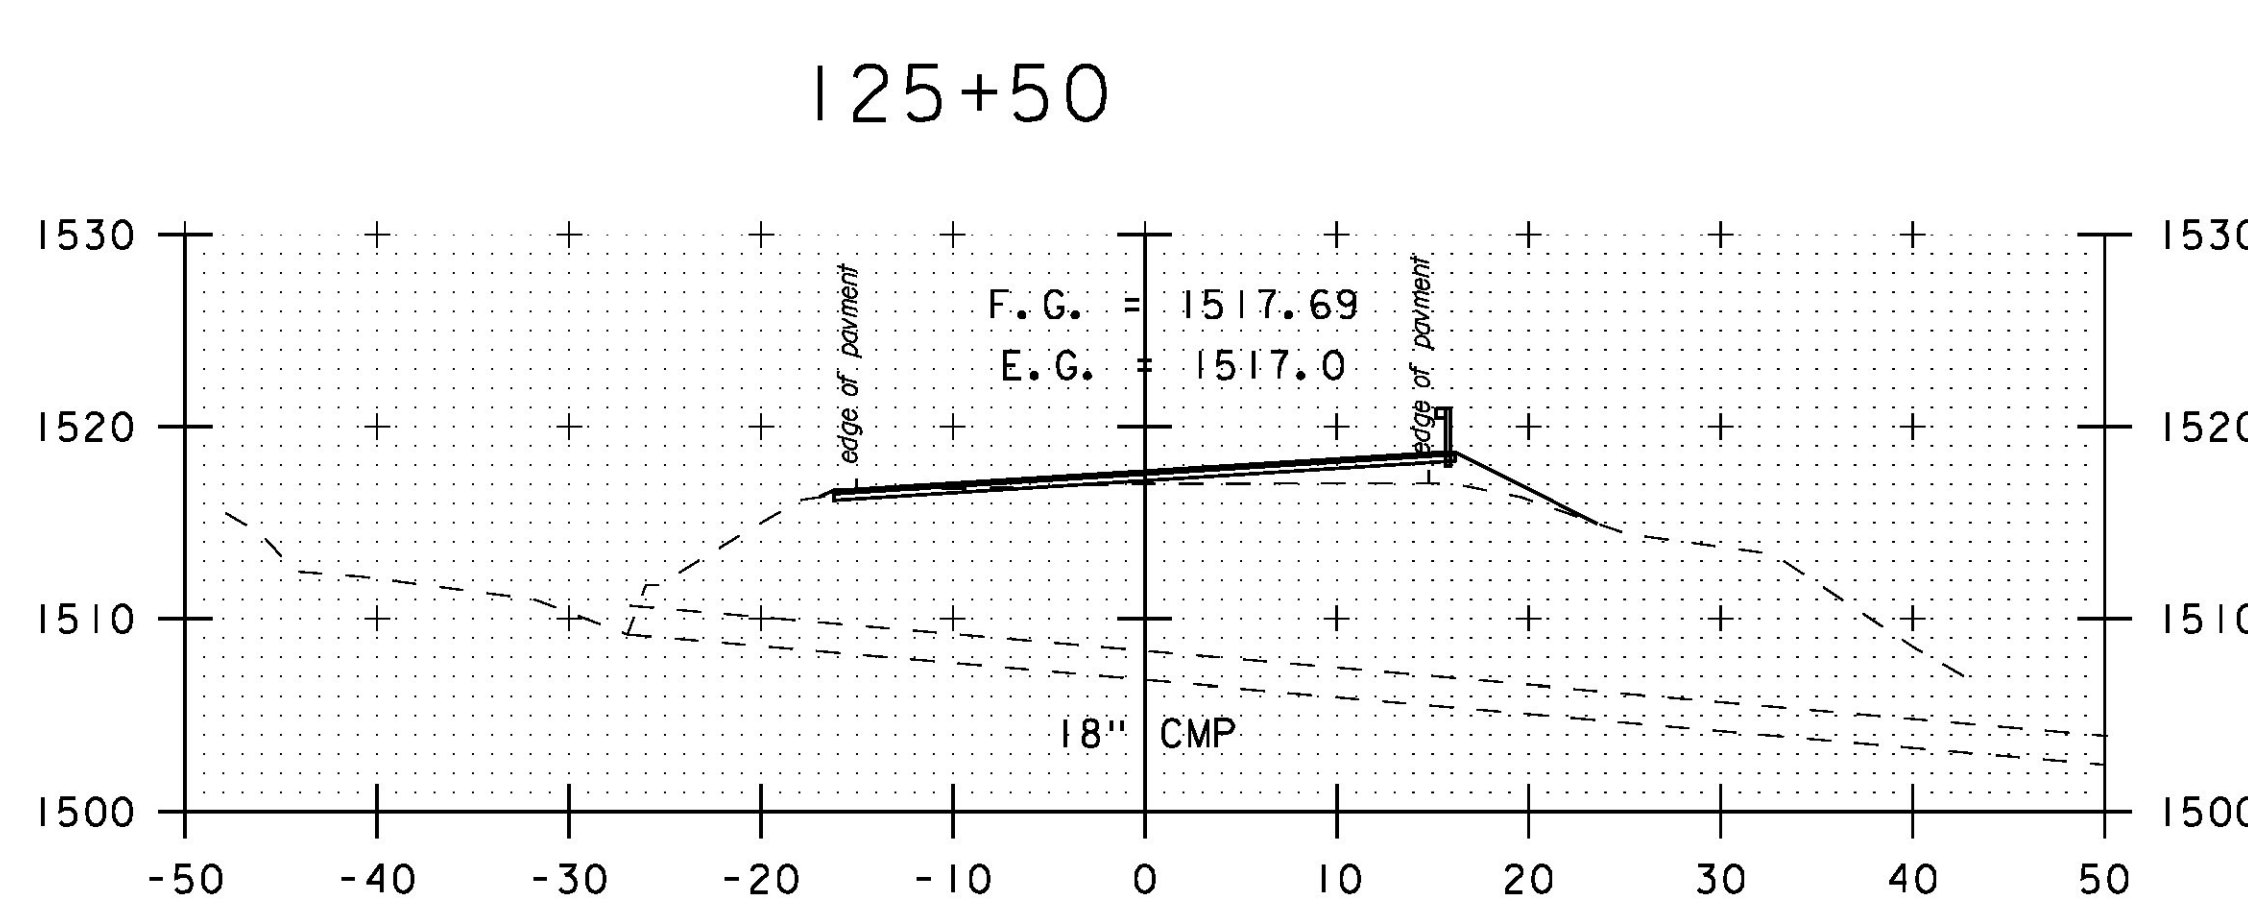


125+12

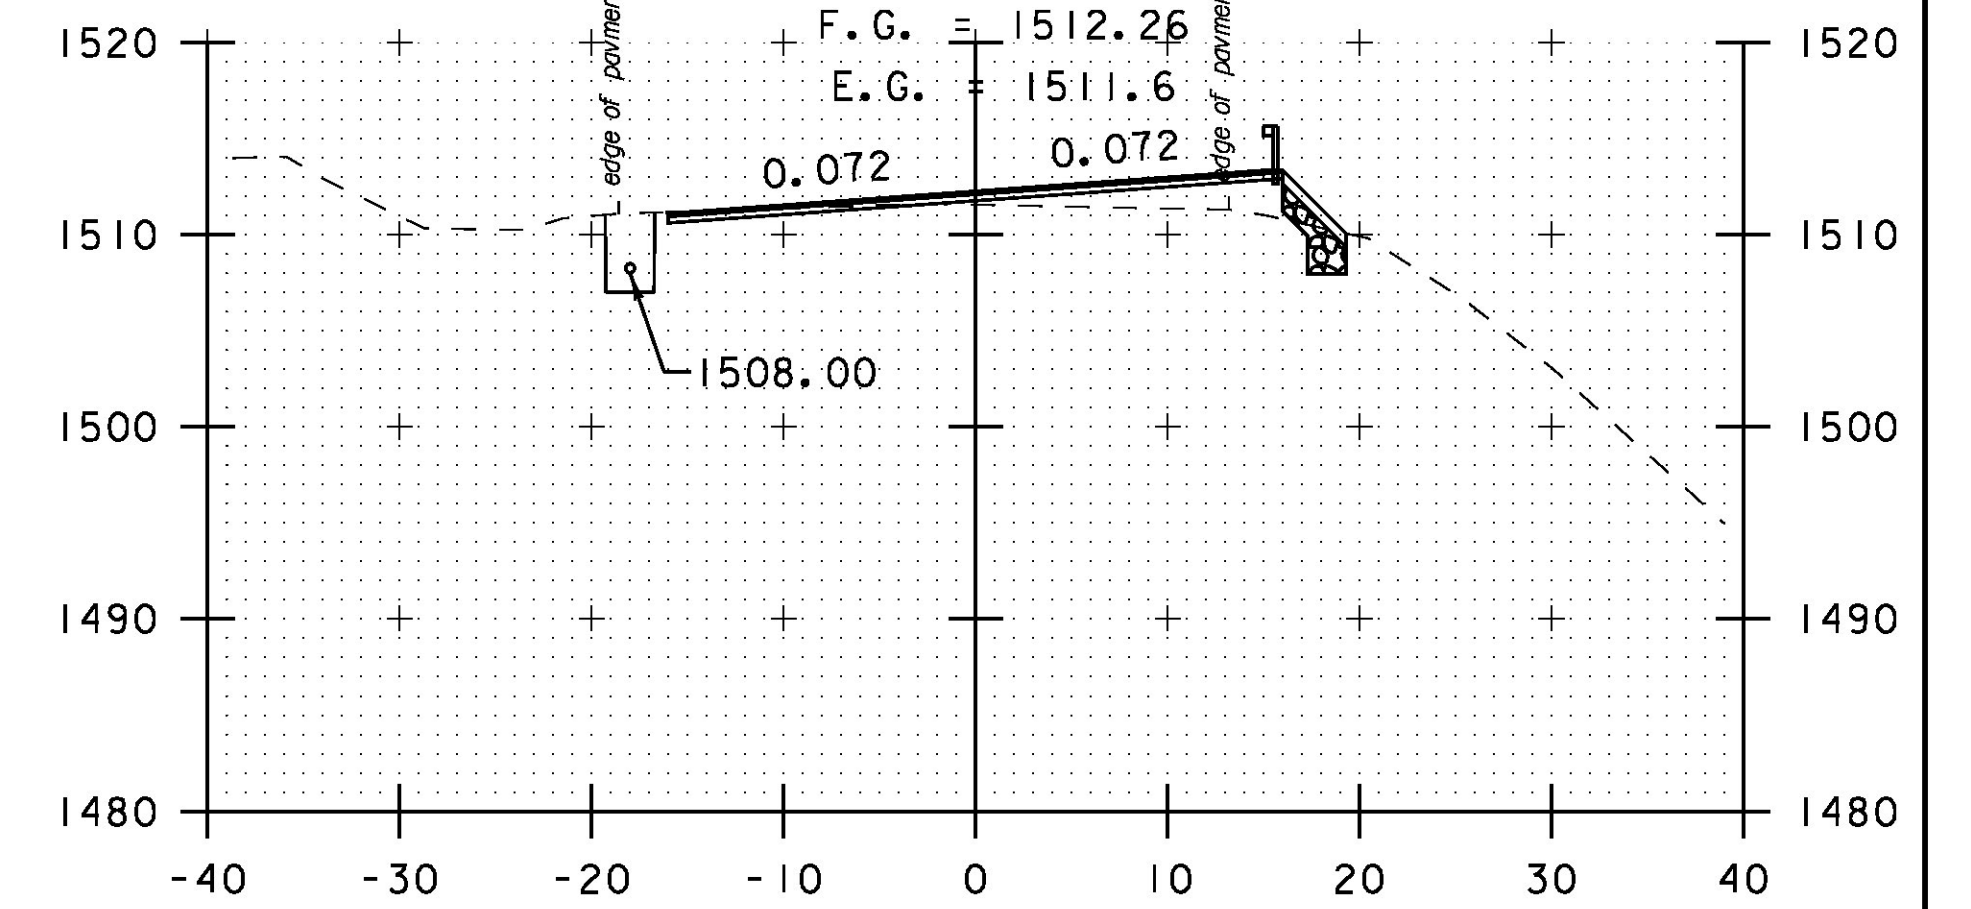


126+50

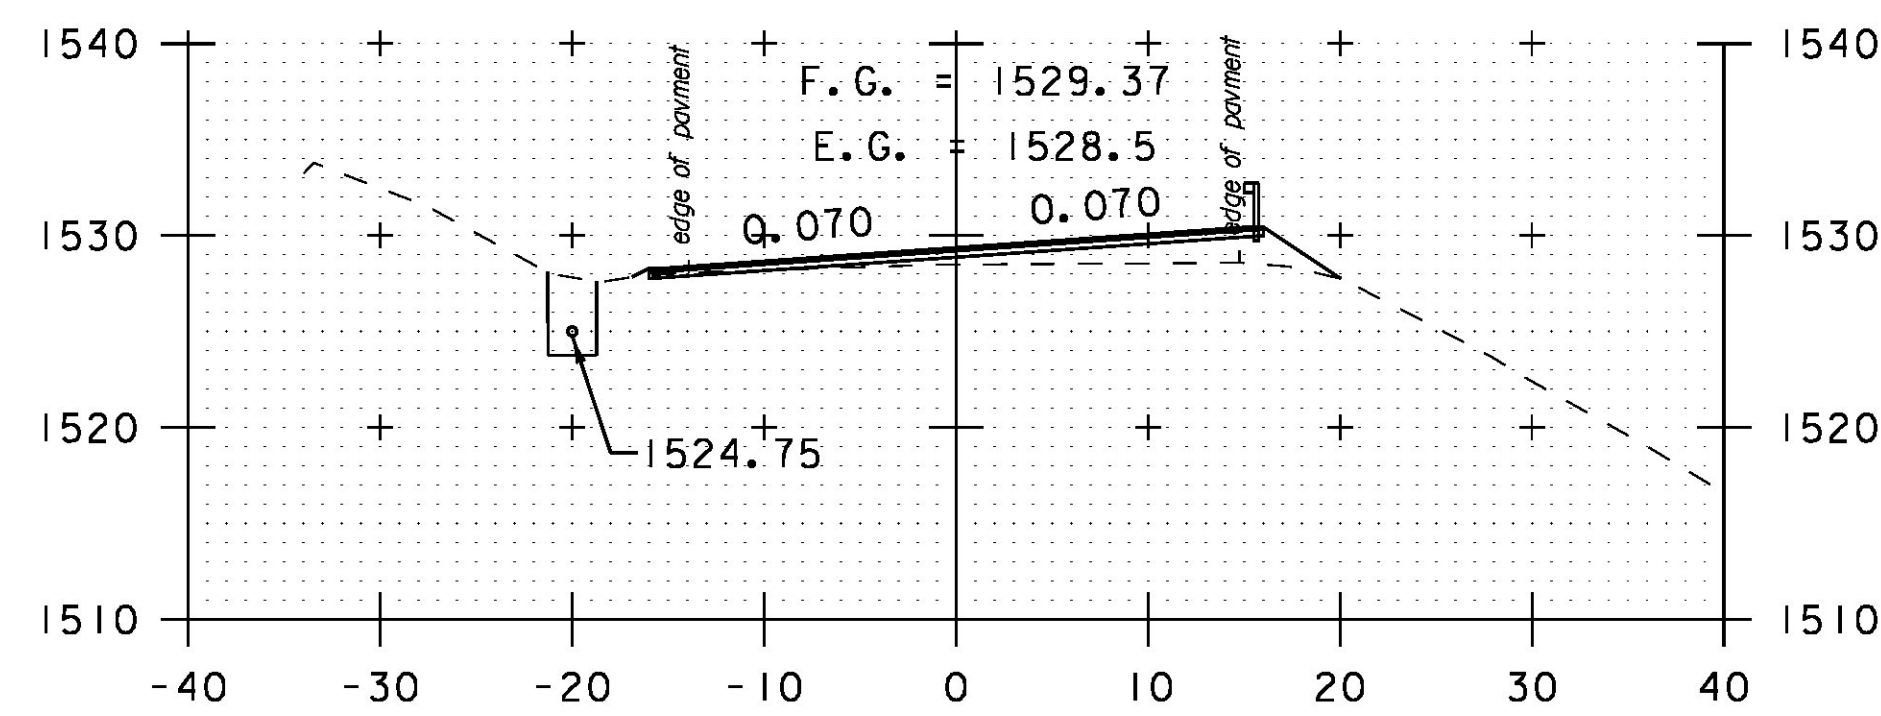


123+50

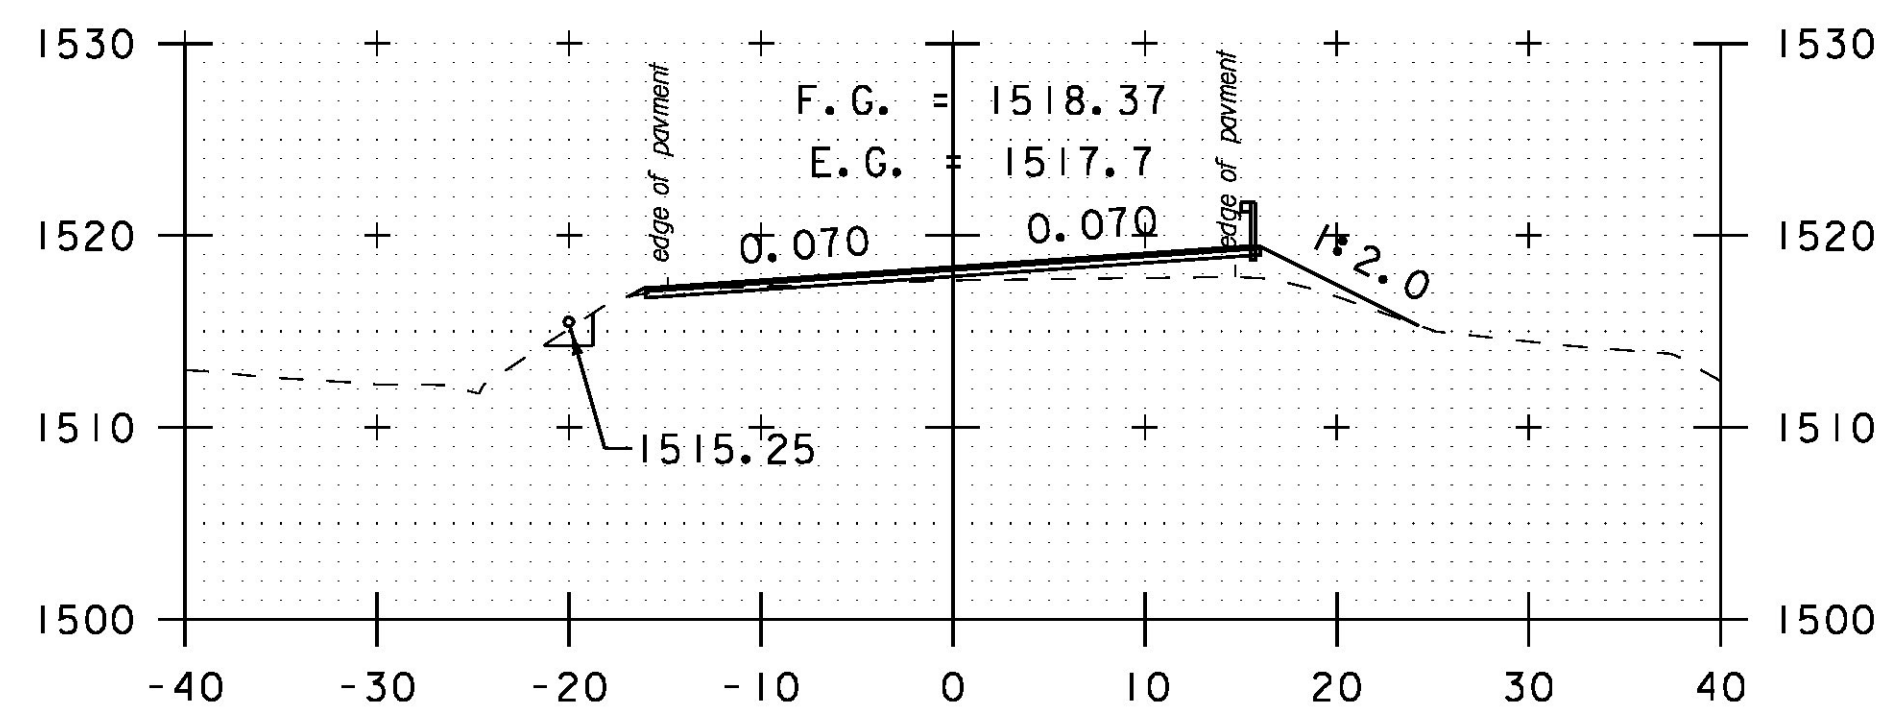

125+00

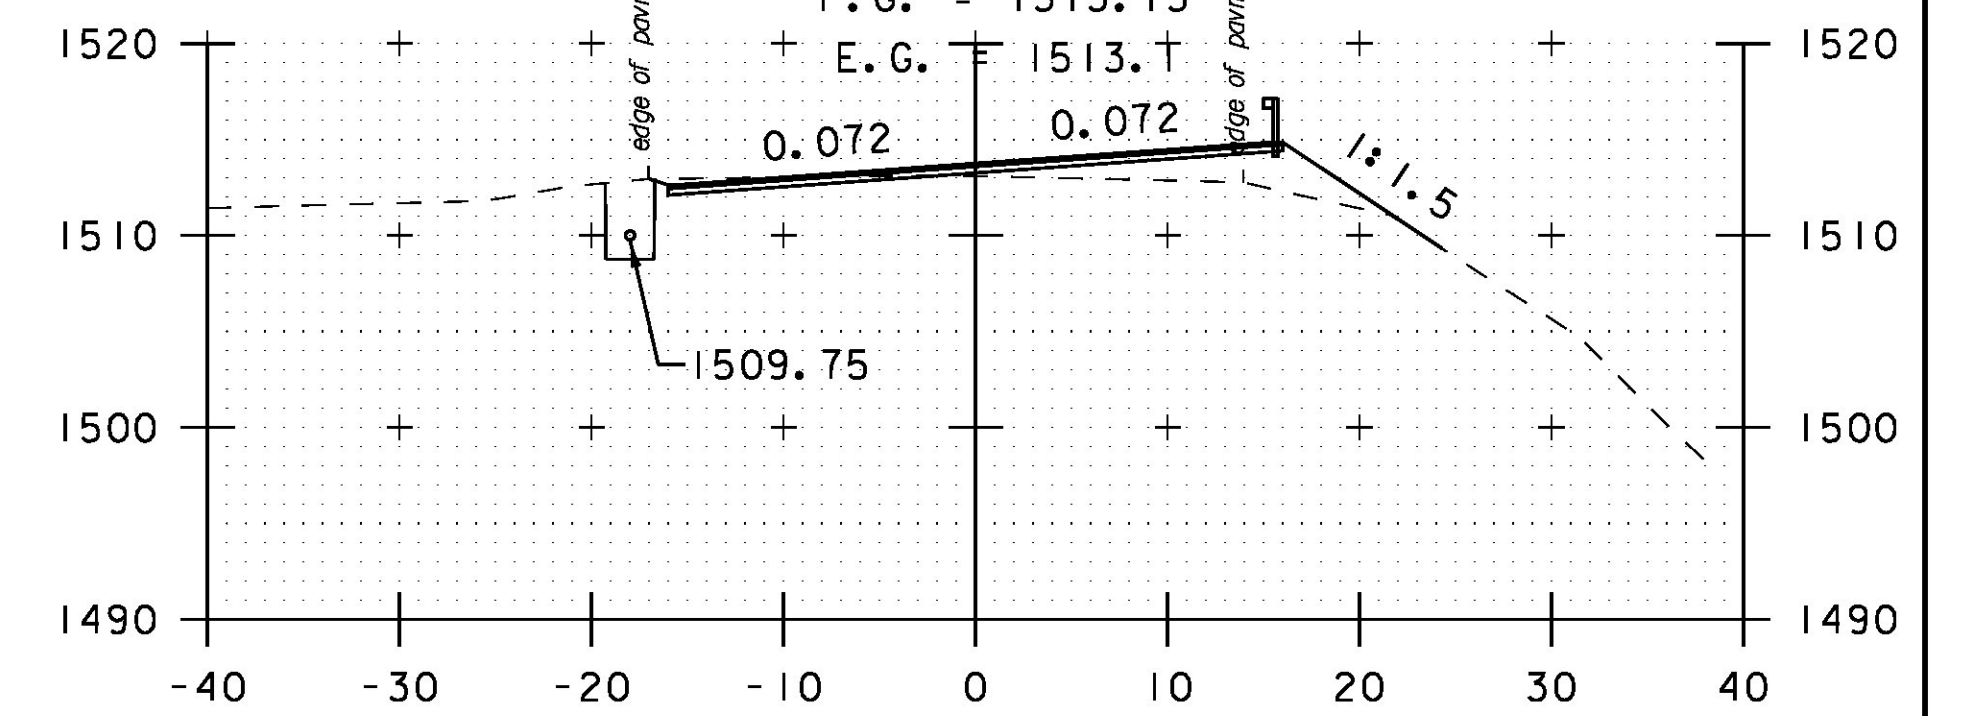

126+00

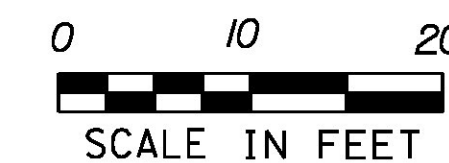

PROJECT NAME: HANCOCK	PLOT DATE: 3/18/2015
PROJECT NUMBER: STP 2923 (1)	DRAWN BY: B. MARTIN
FILE NAME: z10c252xs.dgn	CHECKED BY: C. LATHROP
PROJECT LEADER: C. LATHROP	SHEET 146 OF 207
DESIGNED BY: B. MARTIN	
CROSS SECTION SHEET 19	