




128+50

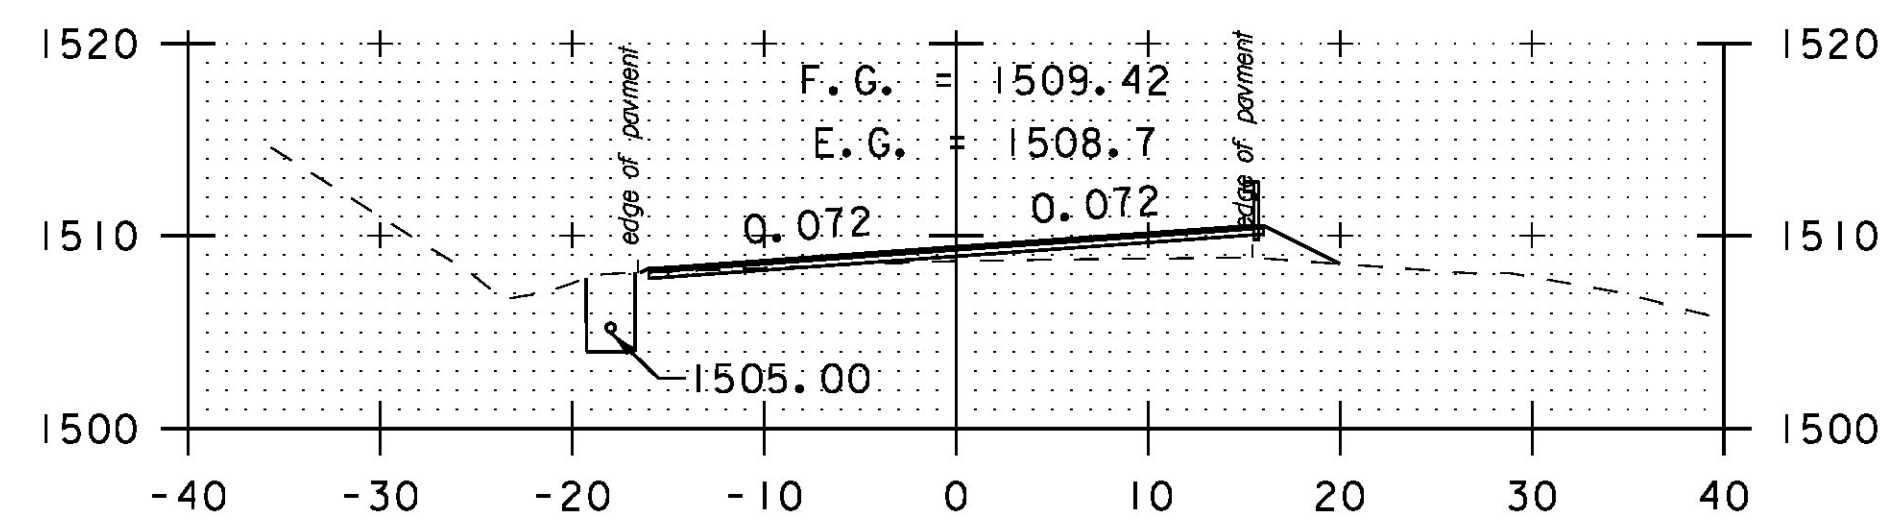


128+00

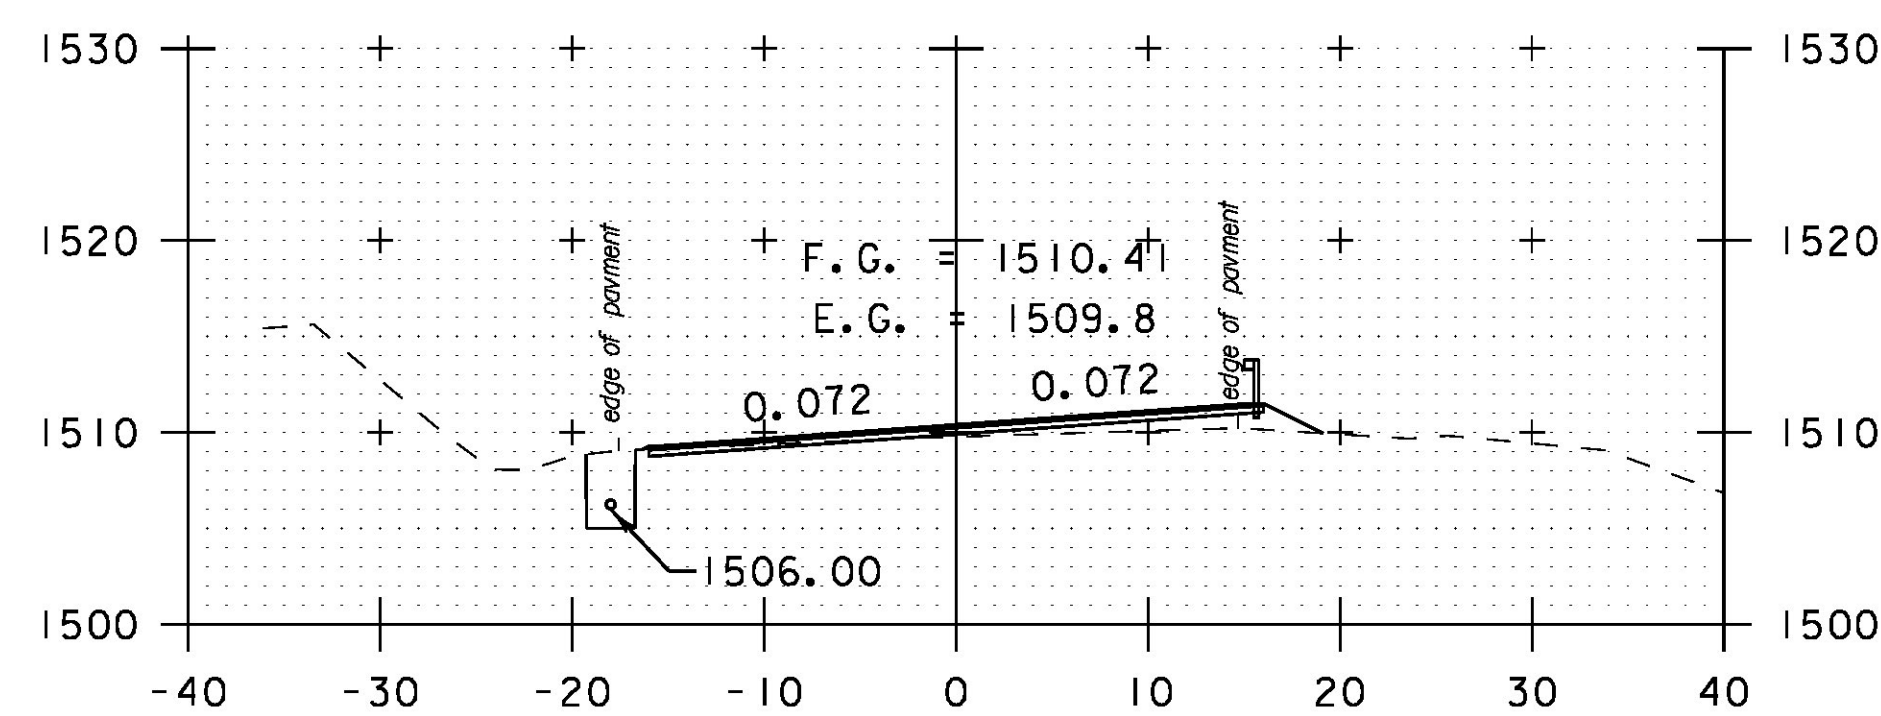


127+50

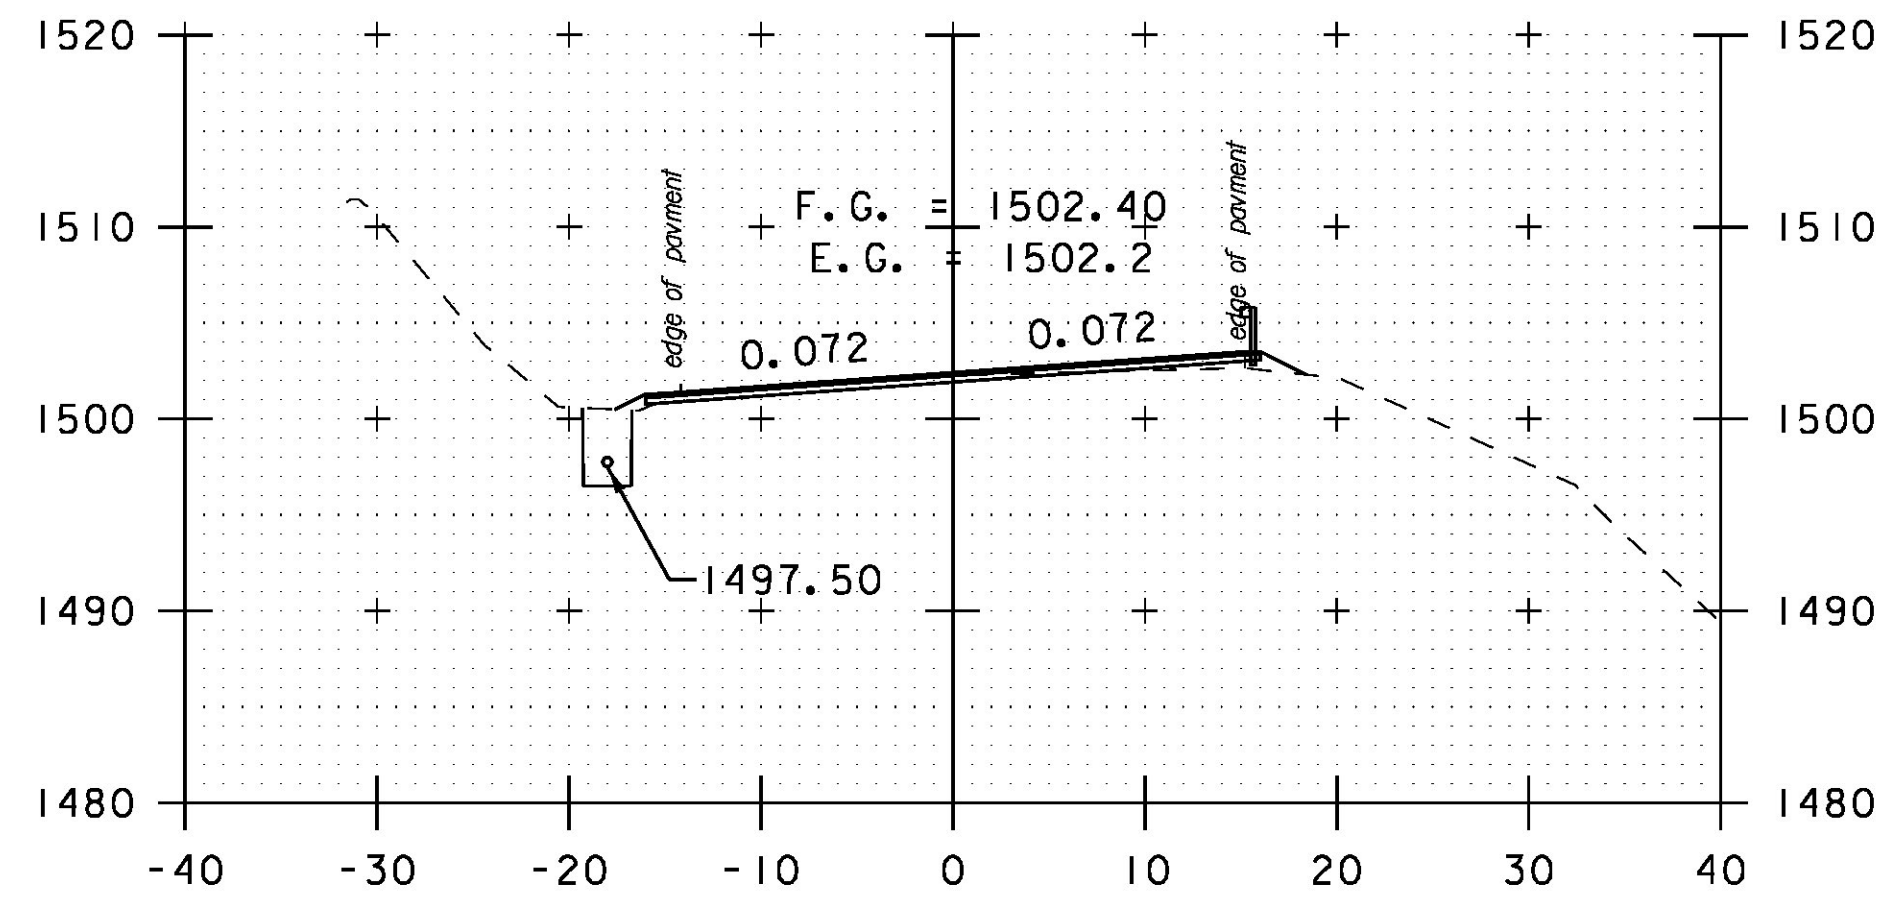


130+00

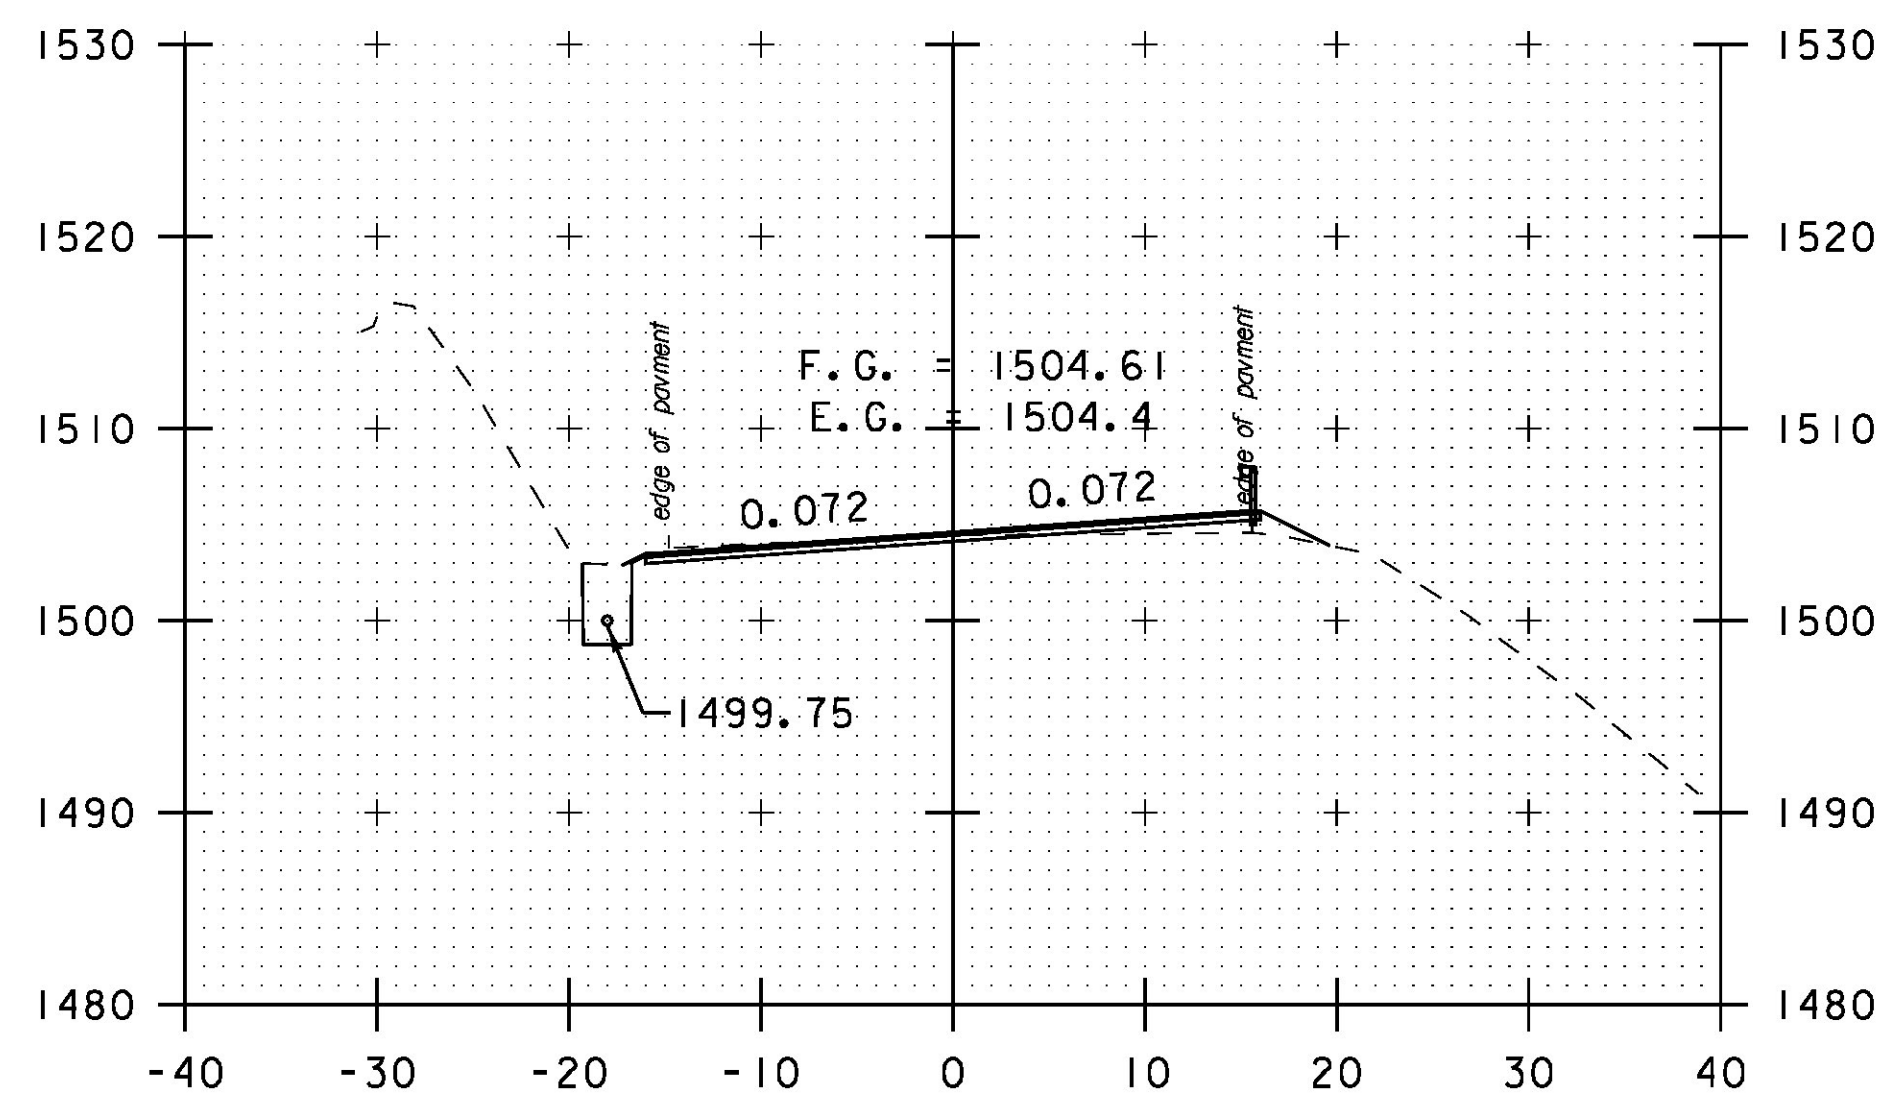


129+50

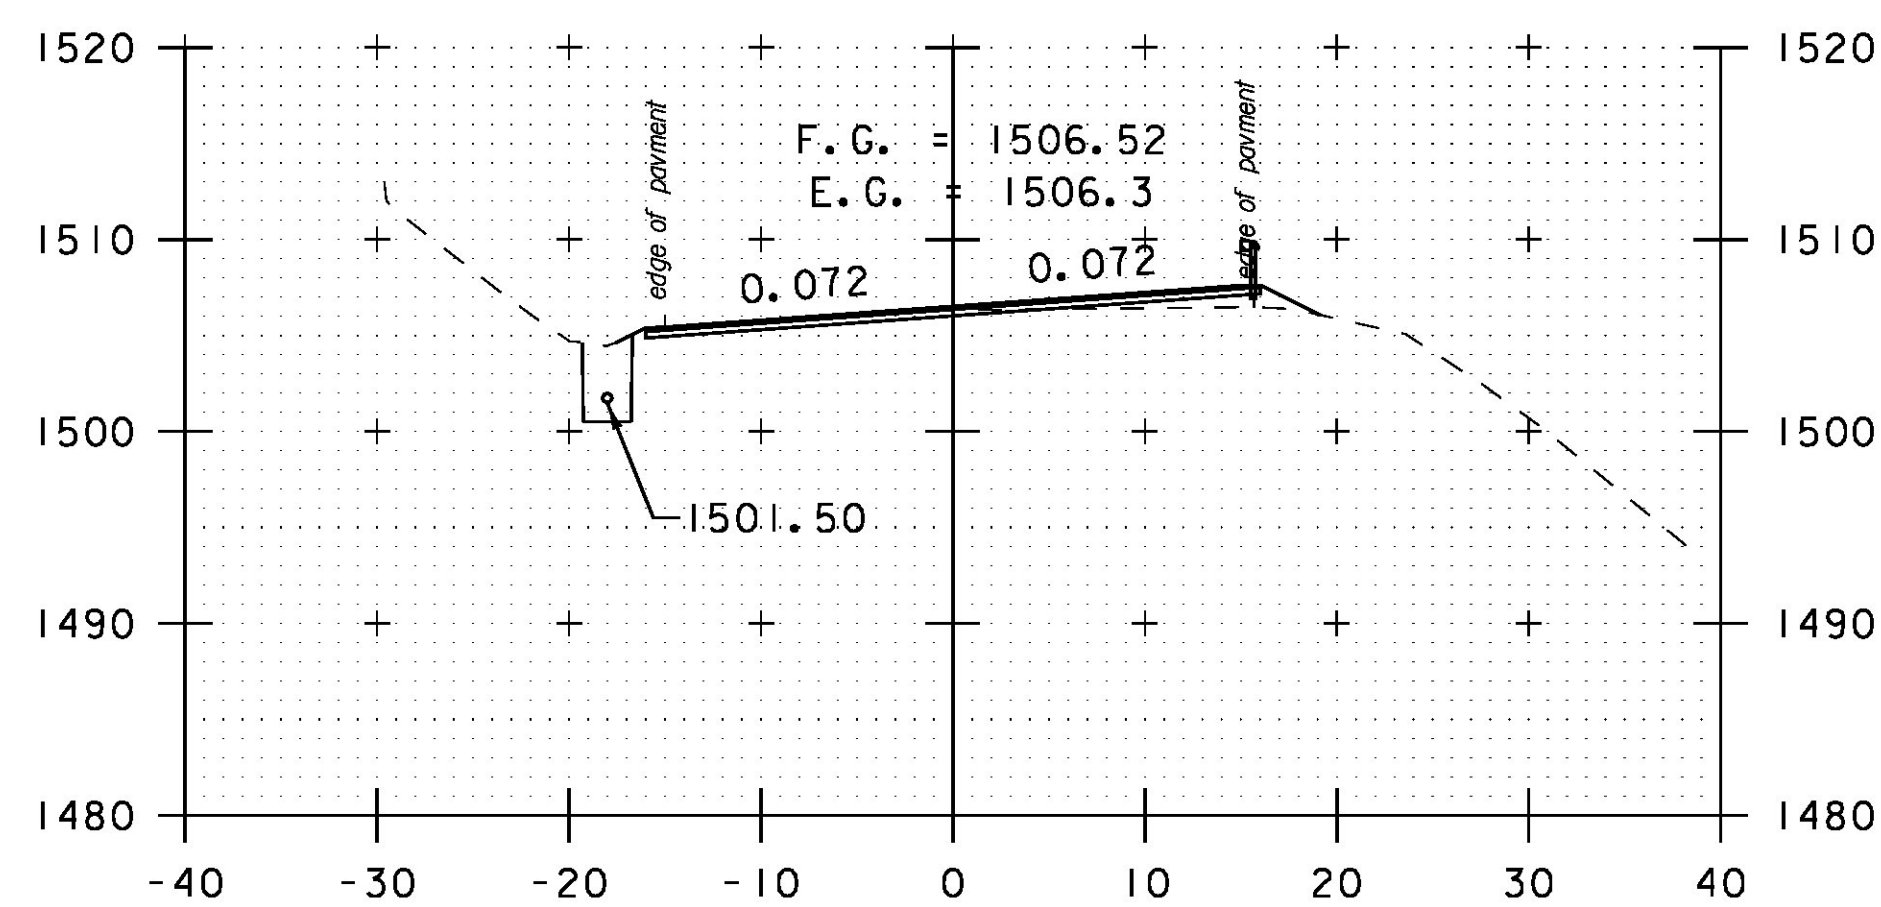

129+00

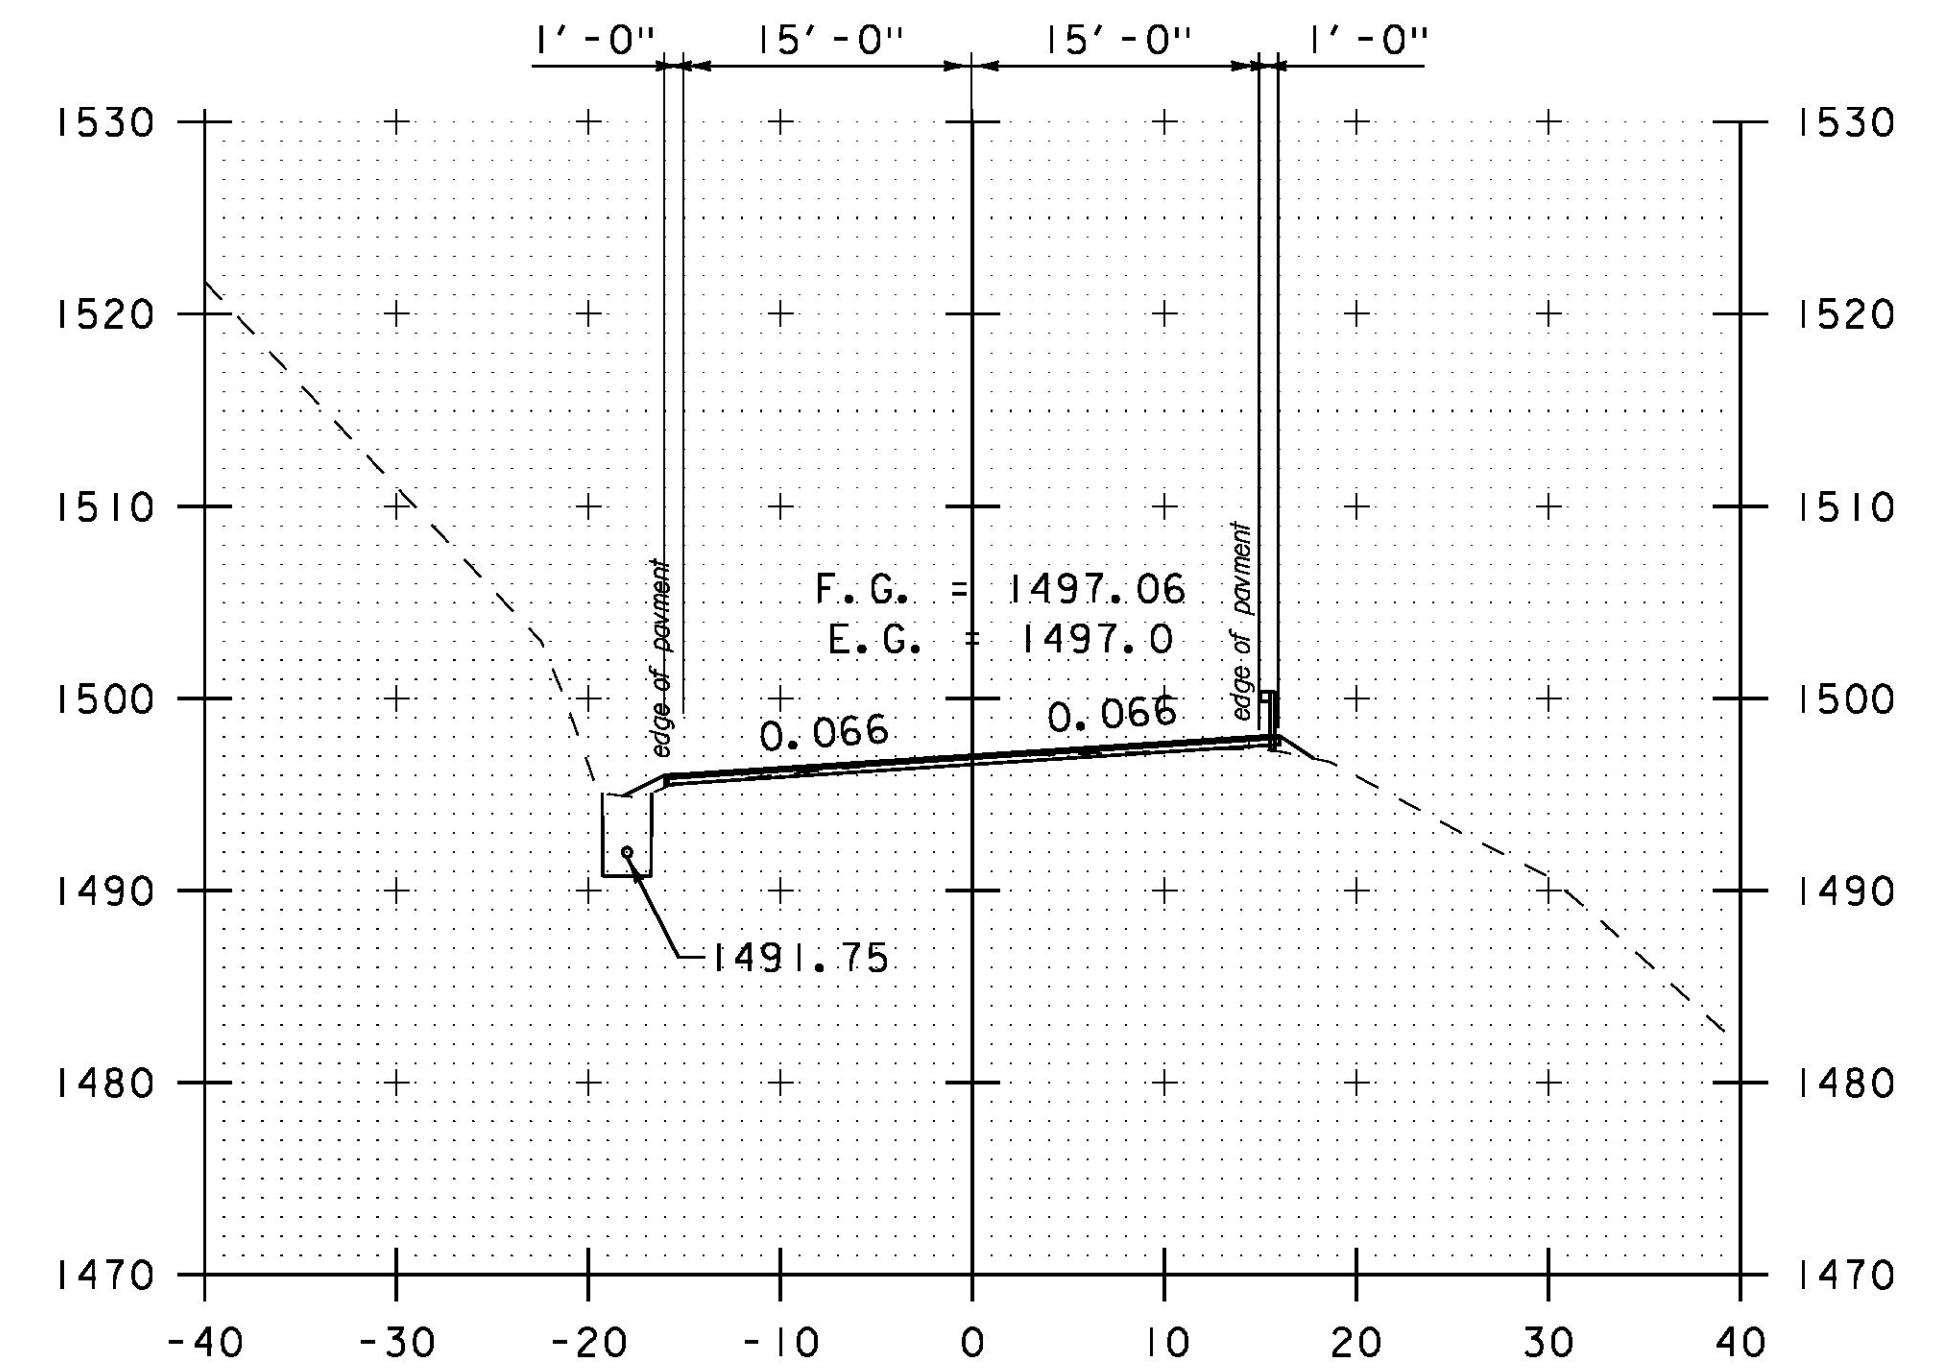

131+00

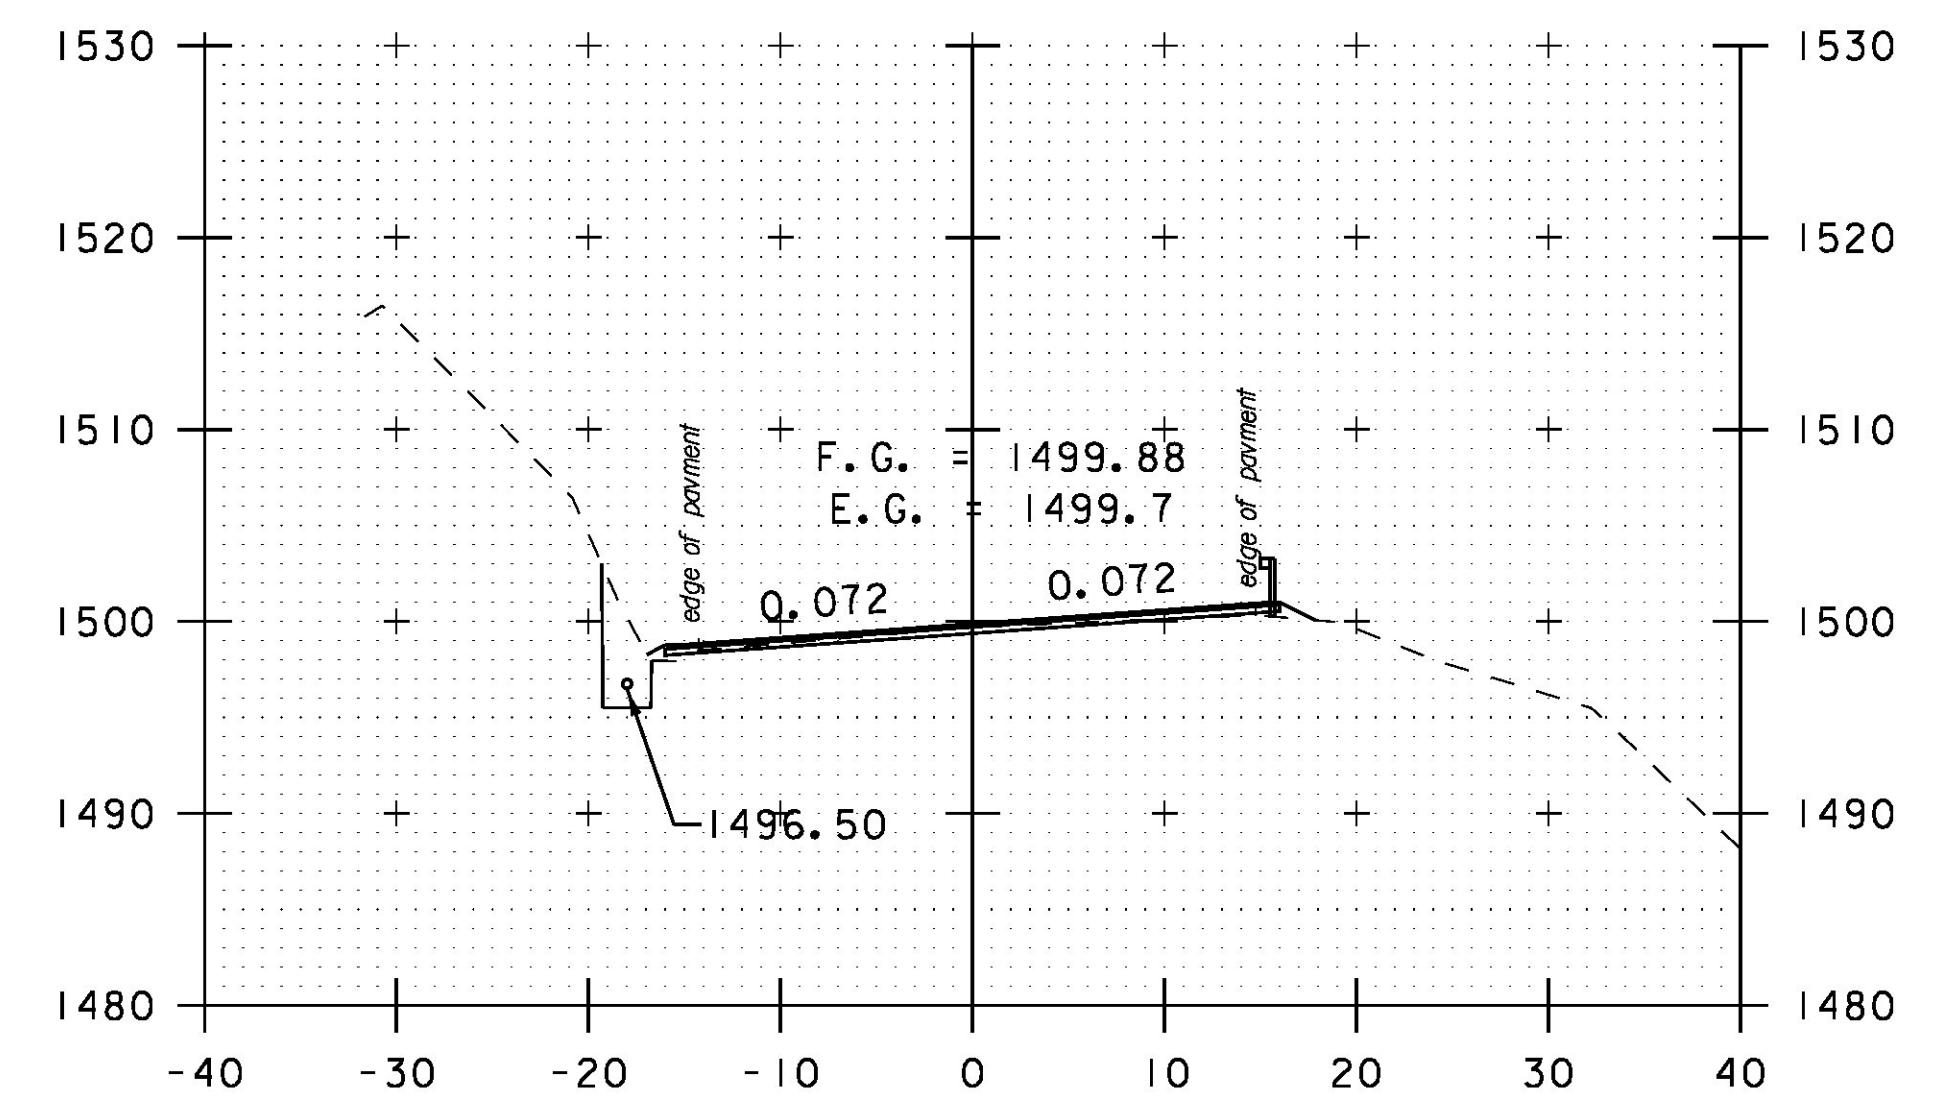

130+50



PROJECT NAME: HANCOCK	PLOT DATE: 3/18/2015
PROJECT NUMBER: STP 2923 (1)	DRAWN BY: B. MARTIN
FILE NAME: z10c252xs.dgn	DESIGNED BY: B. MARTIN
PROJECT LEADER: C. LATHROP	CHECKED BY: C. LATHROP
CROSS SECTION SHEET 20	SHEET 147 OF 207