




136+00

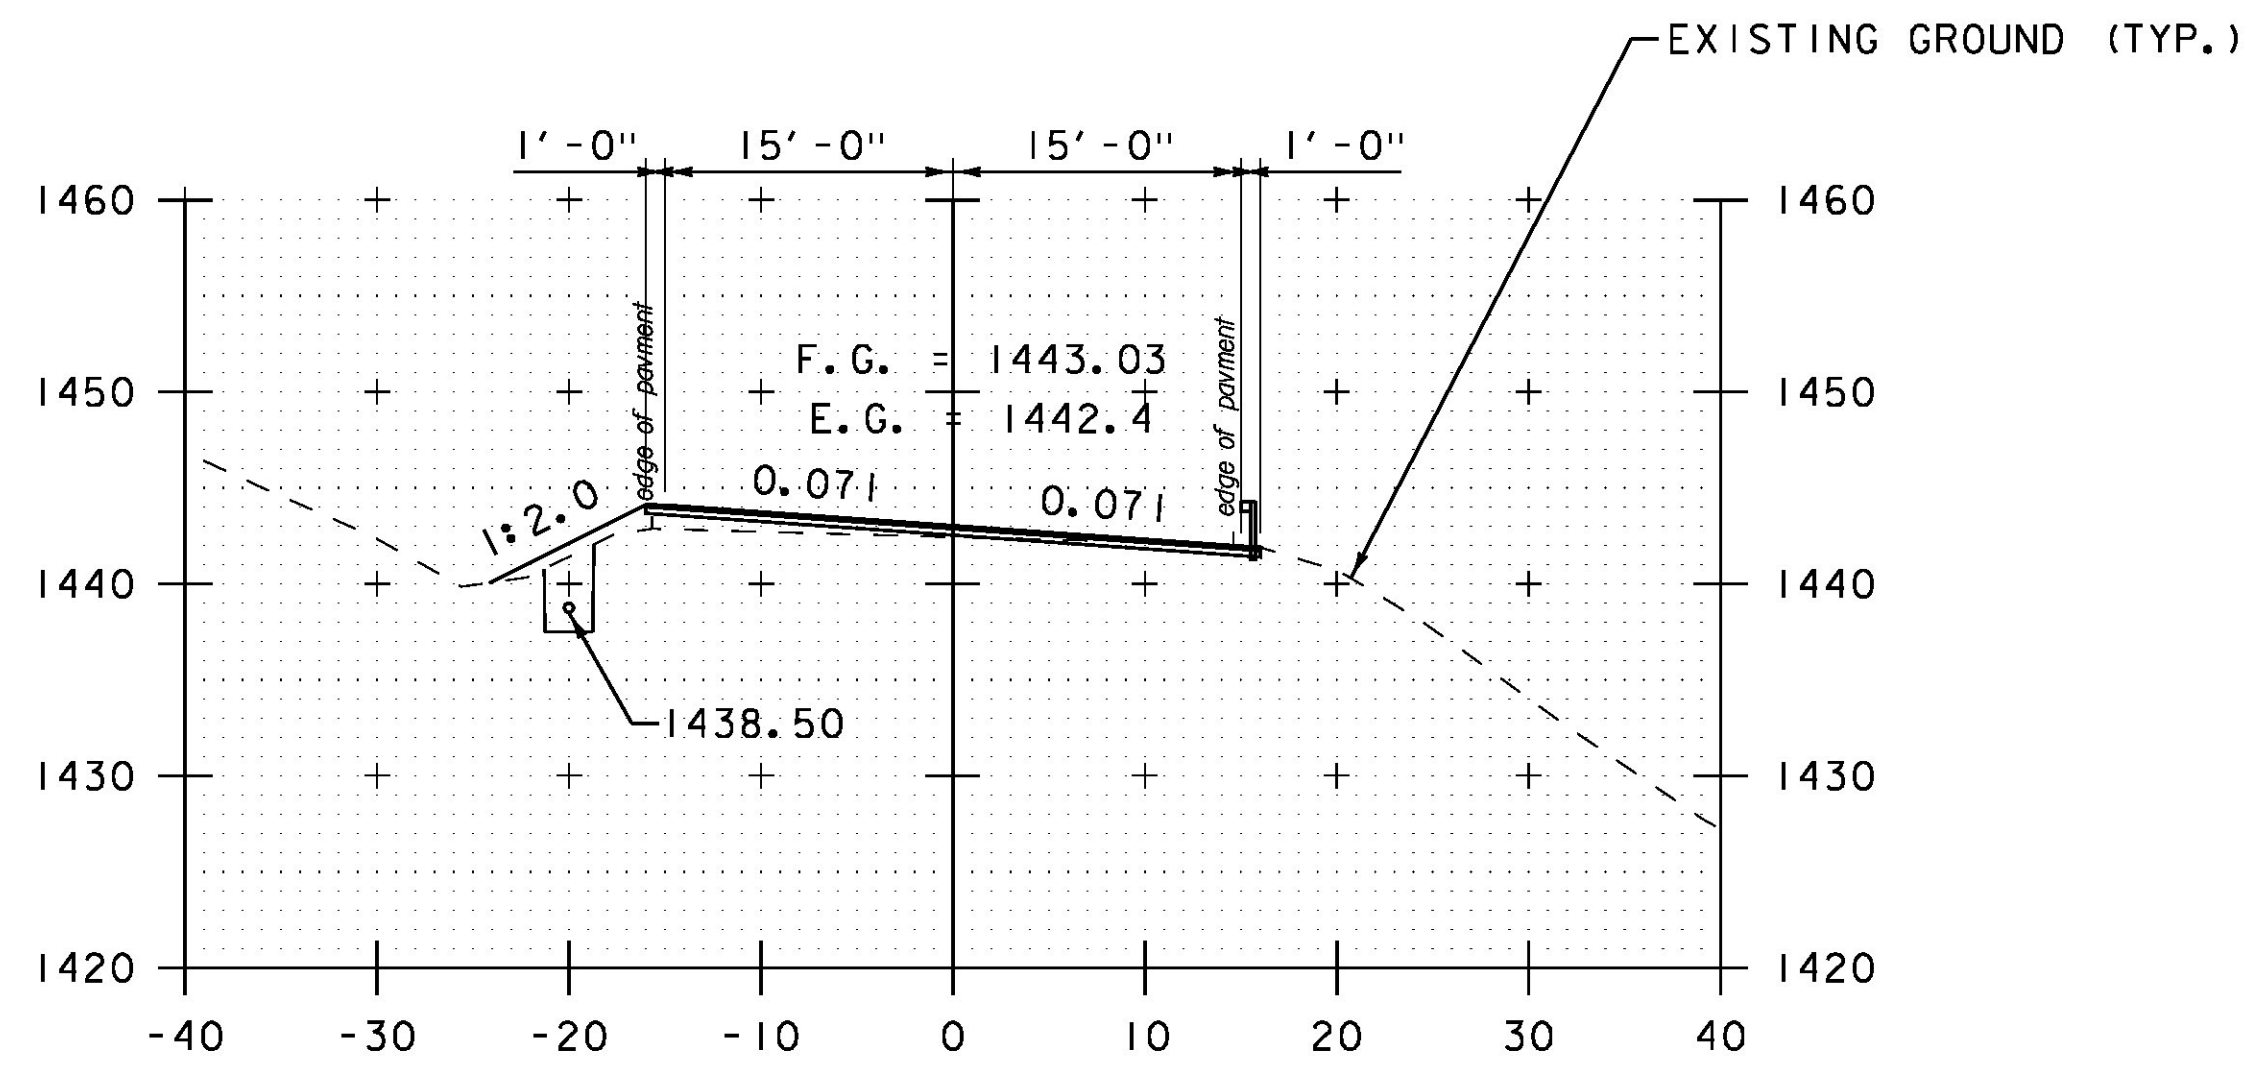


137+00

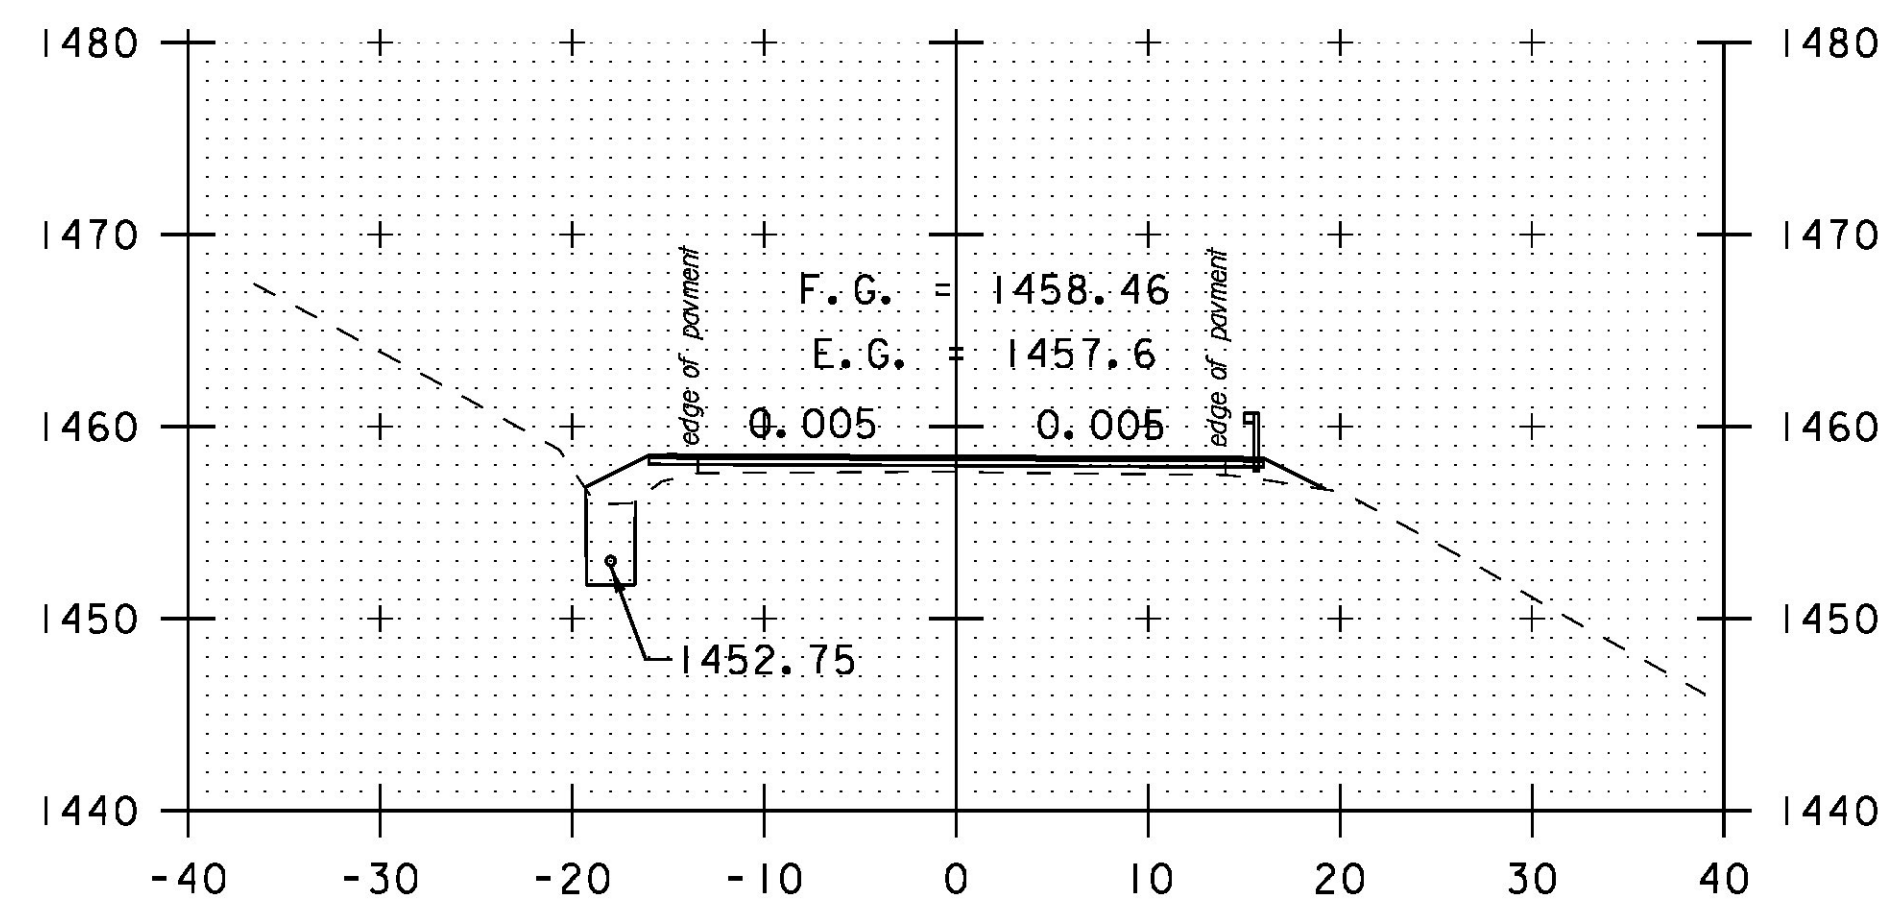


135+50

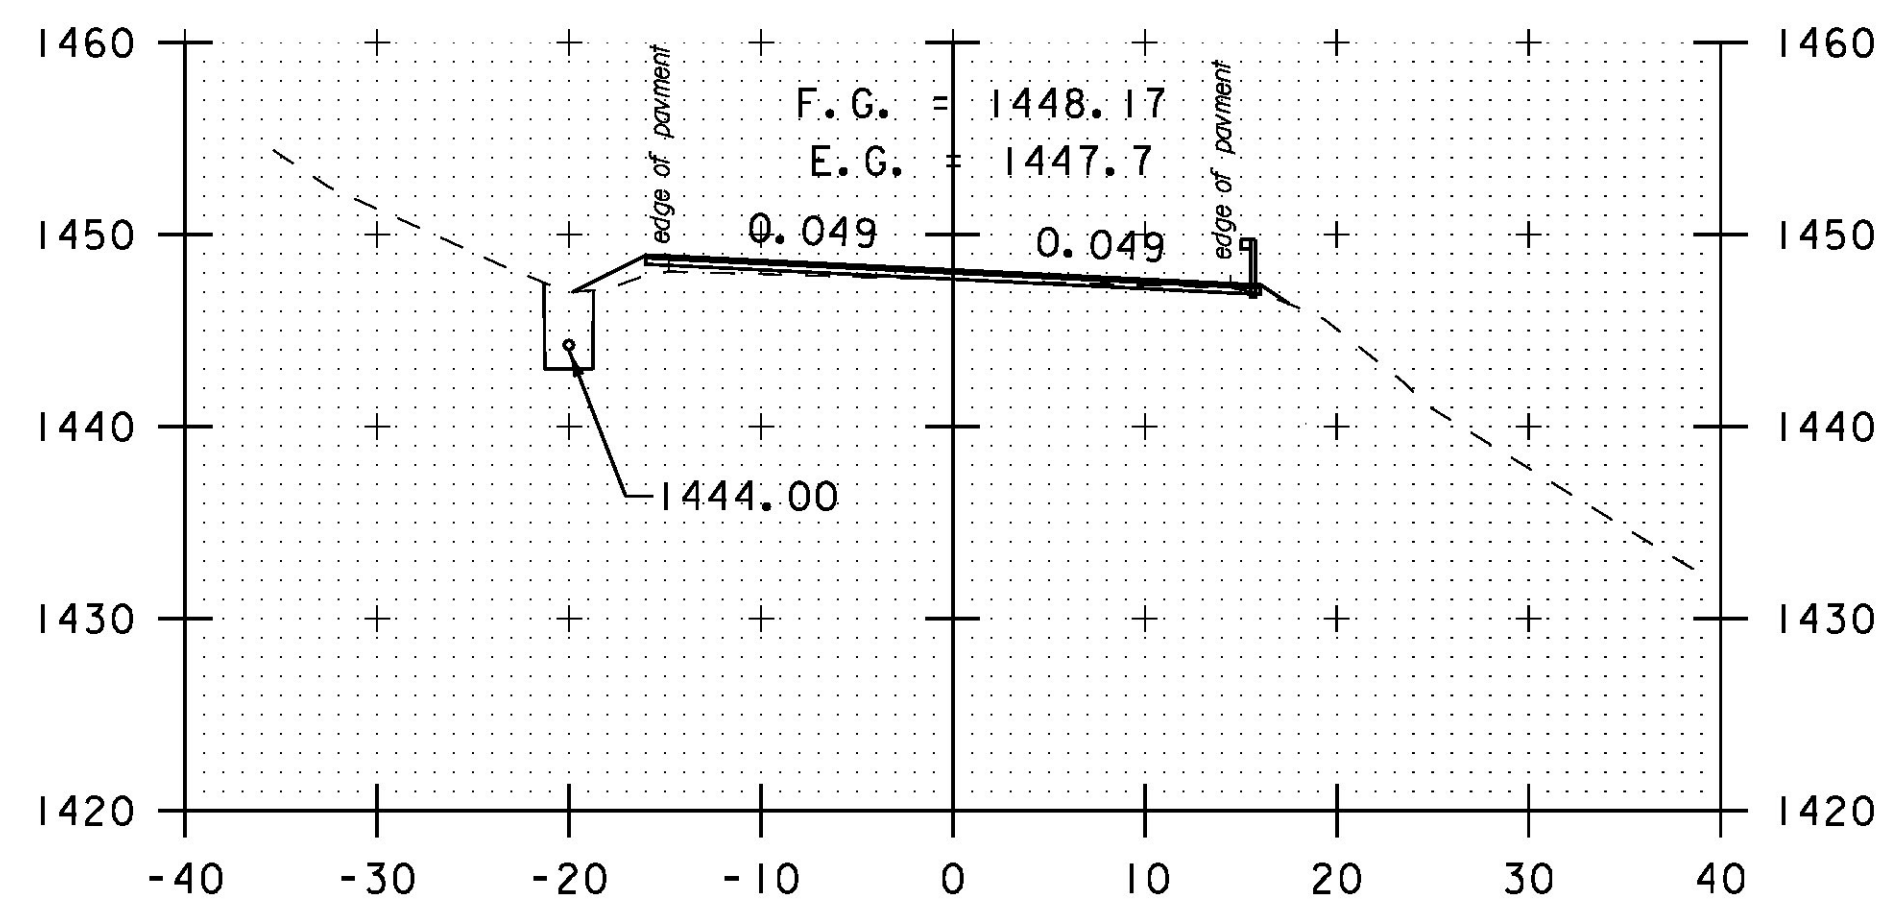


136+50

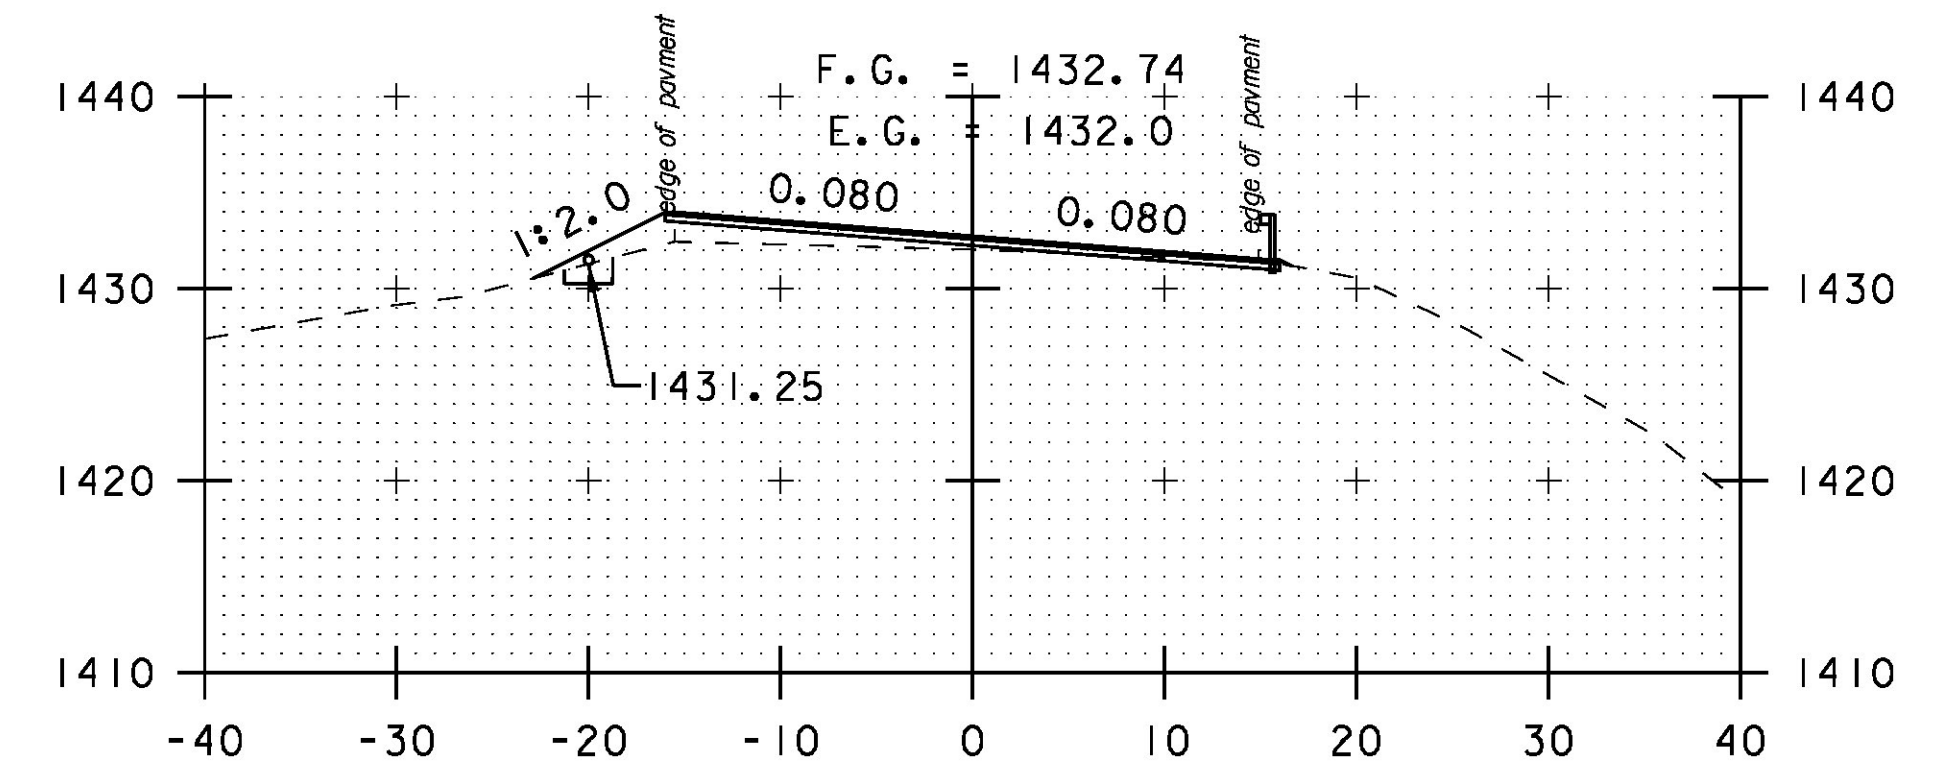


138+00

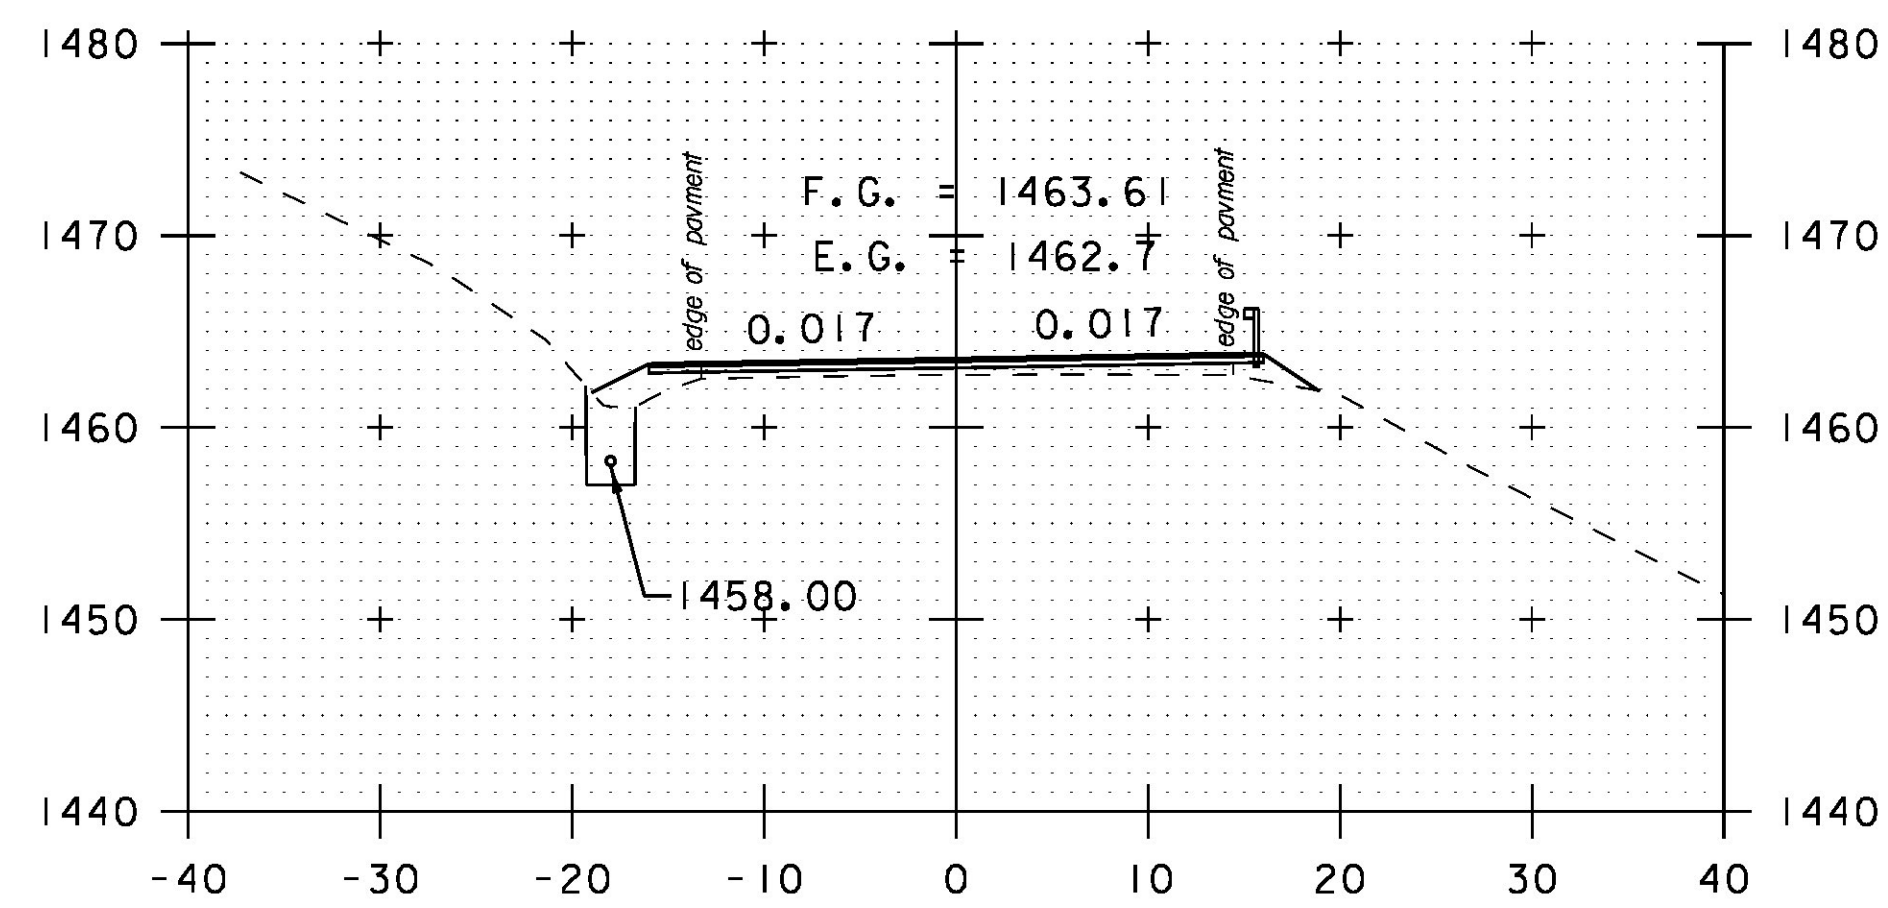


135+00

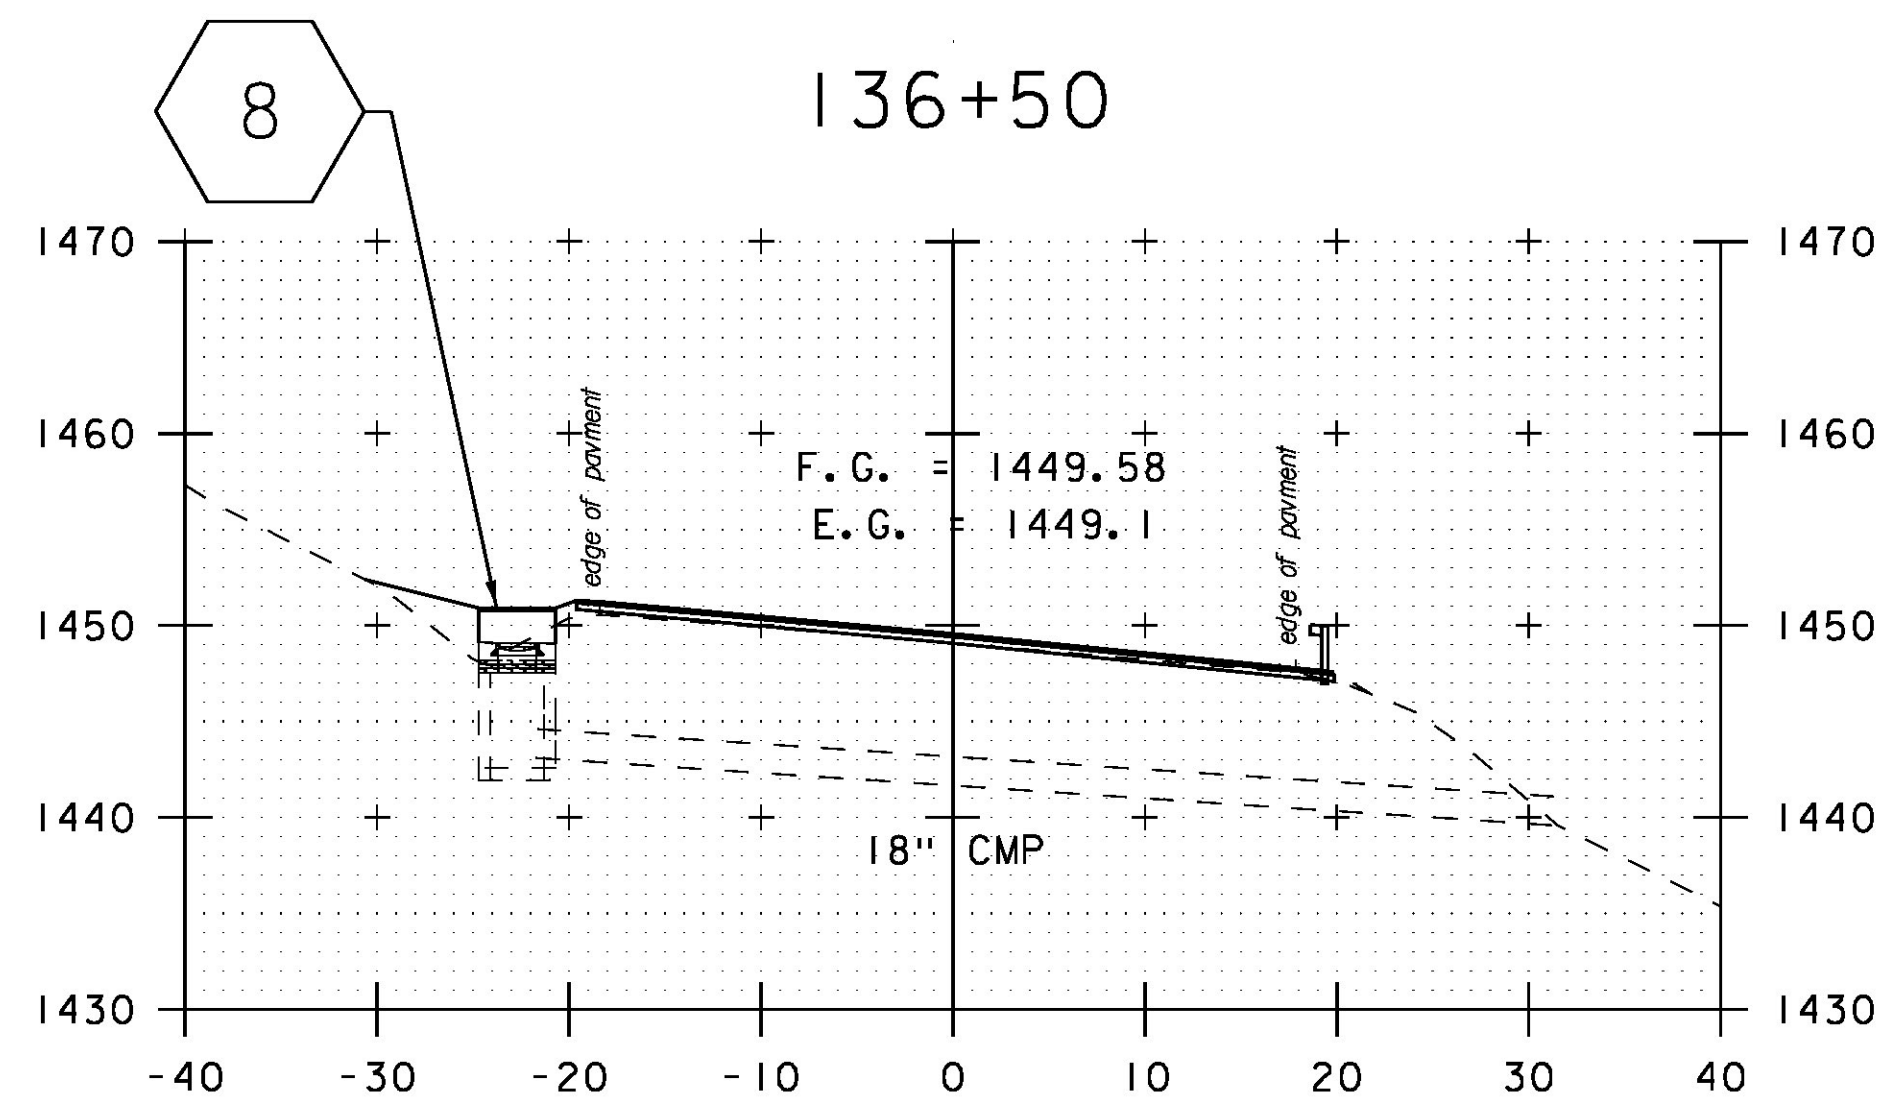


136+36  
SKEWED

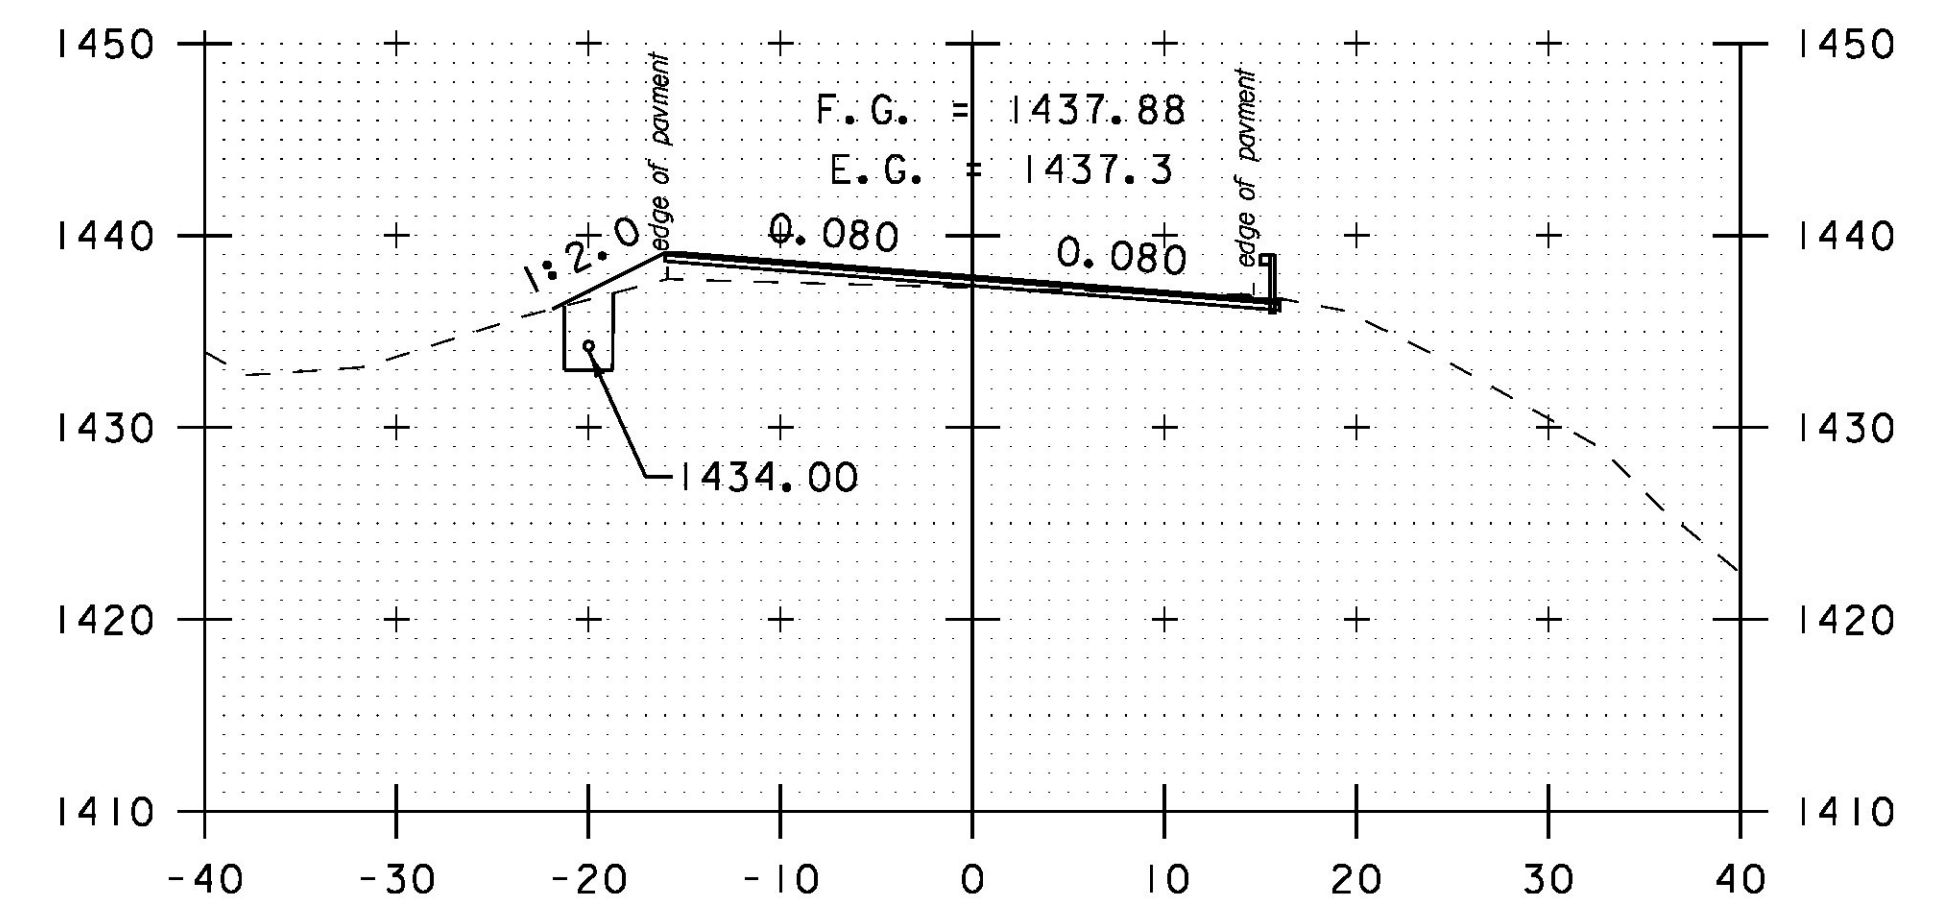

137+50

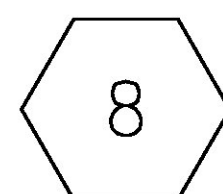

STA. 136+23.83 LT 19.29'  
PROJECT ADJUST CATCH BASIN  
TO TG = 1450.90

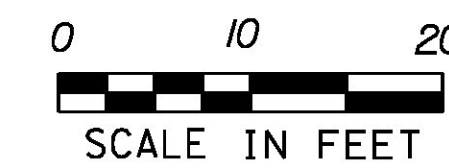

PROJECT NAME:	HANCOCK	PLOT DATE:	3/18/2015
PROJECT NUMBER:	STP 2923 (1)	DRAWN BY:	B. MARTIN
FILE NAME:	z10c252xs.dgn	CHECKED BY:	C. LATHROP
PROJECT LEADER:	C. LATHROP	SHEET	149 OF 207
DESIGNED BY:	B. MARTIN		
CROSS SECTION SHEET	22		