




139+00

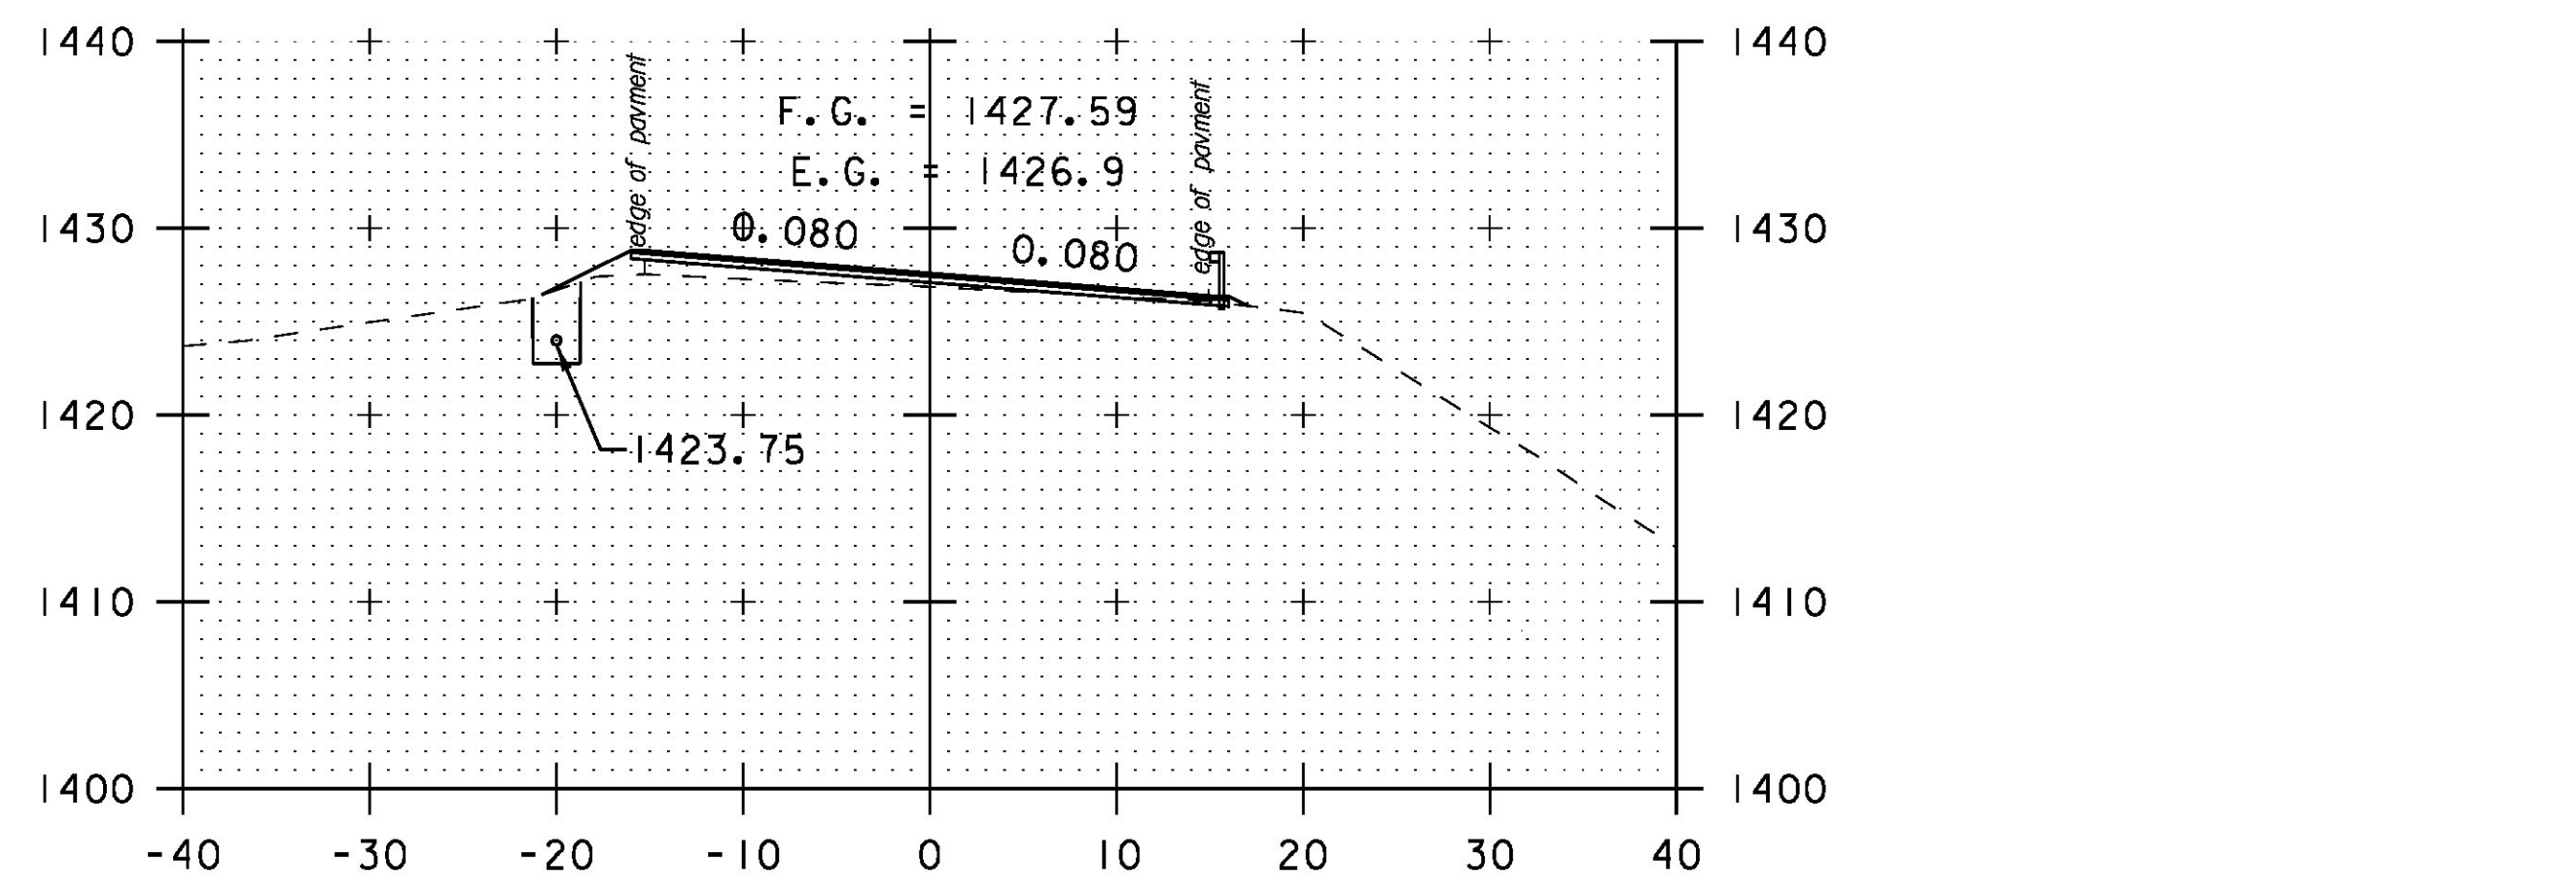


138+50

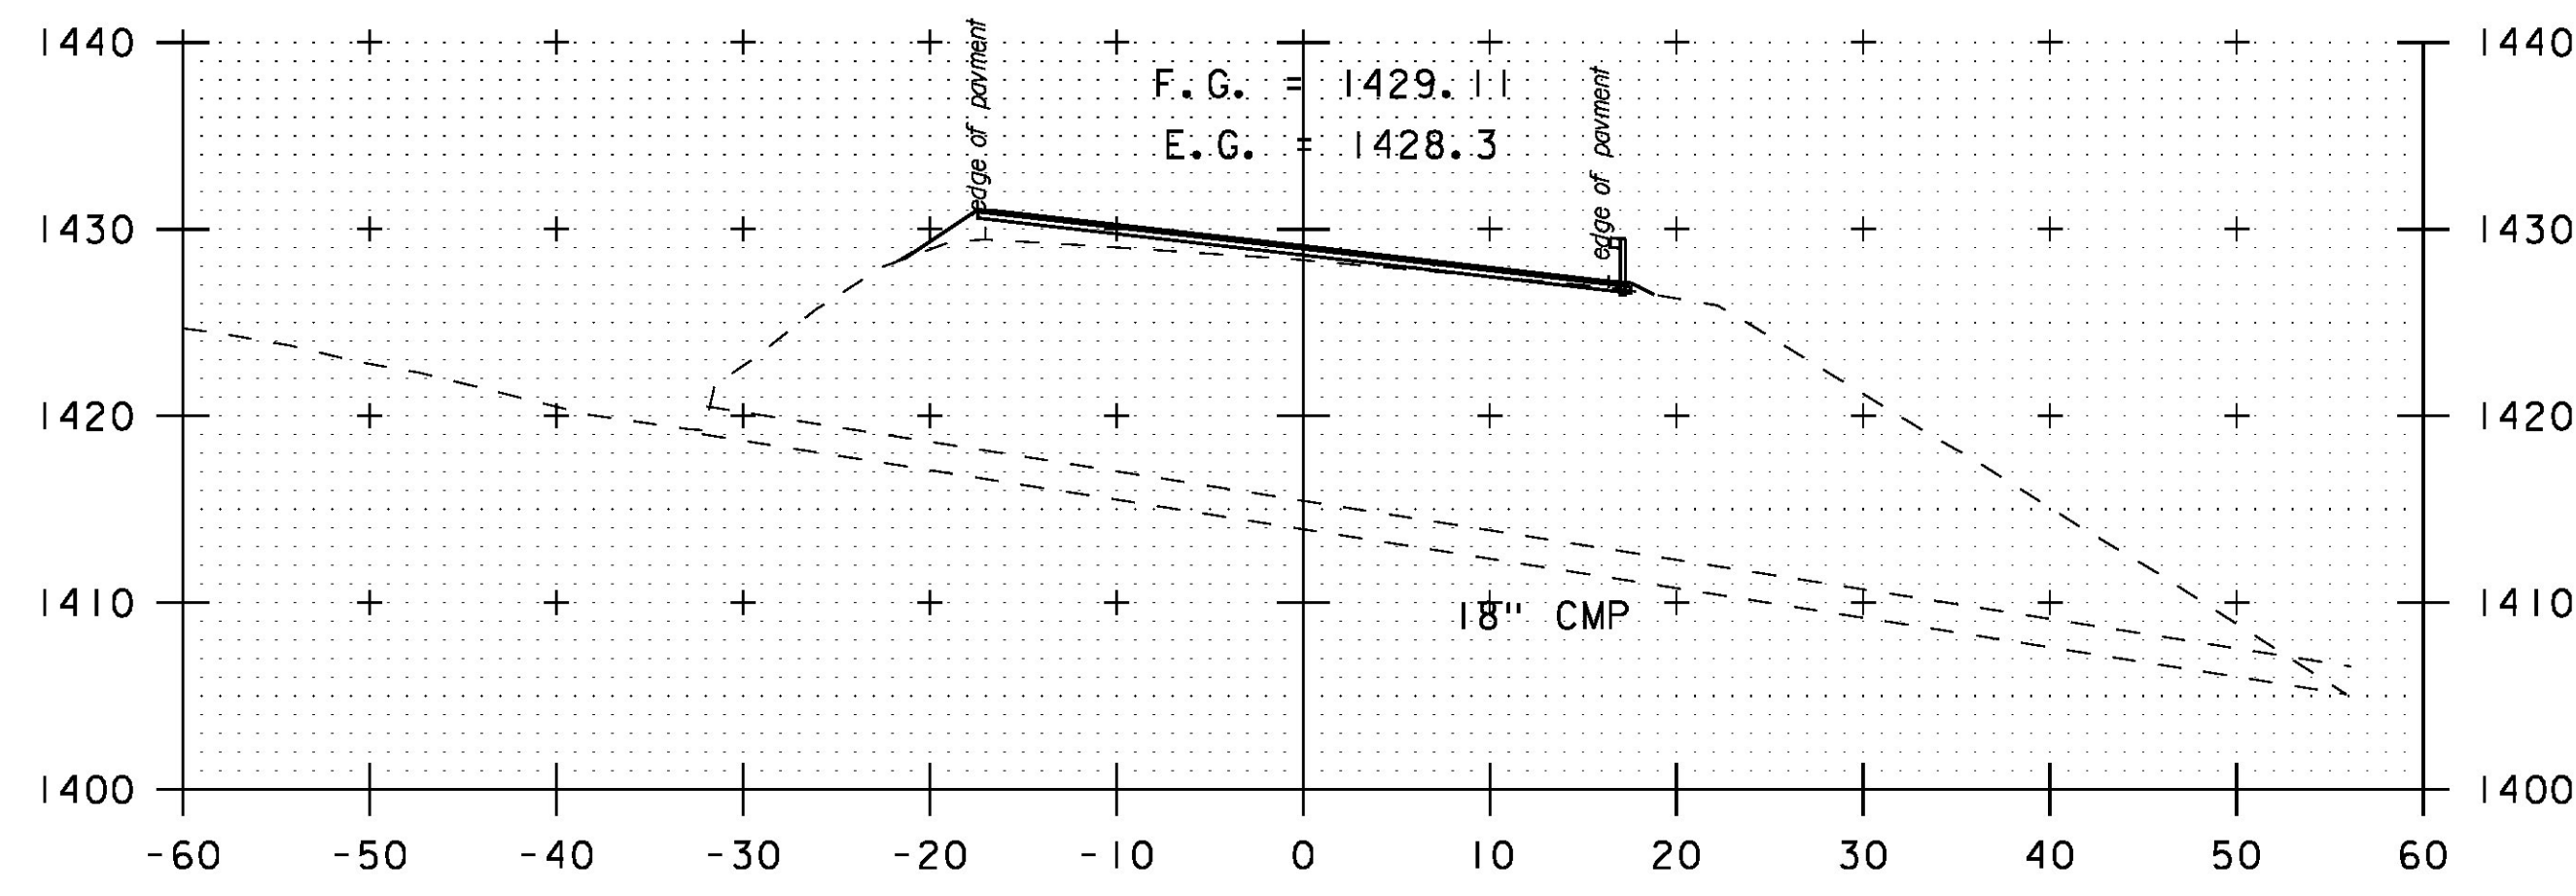


138+35
SKEWED

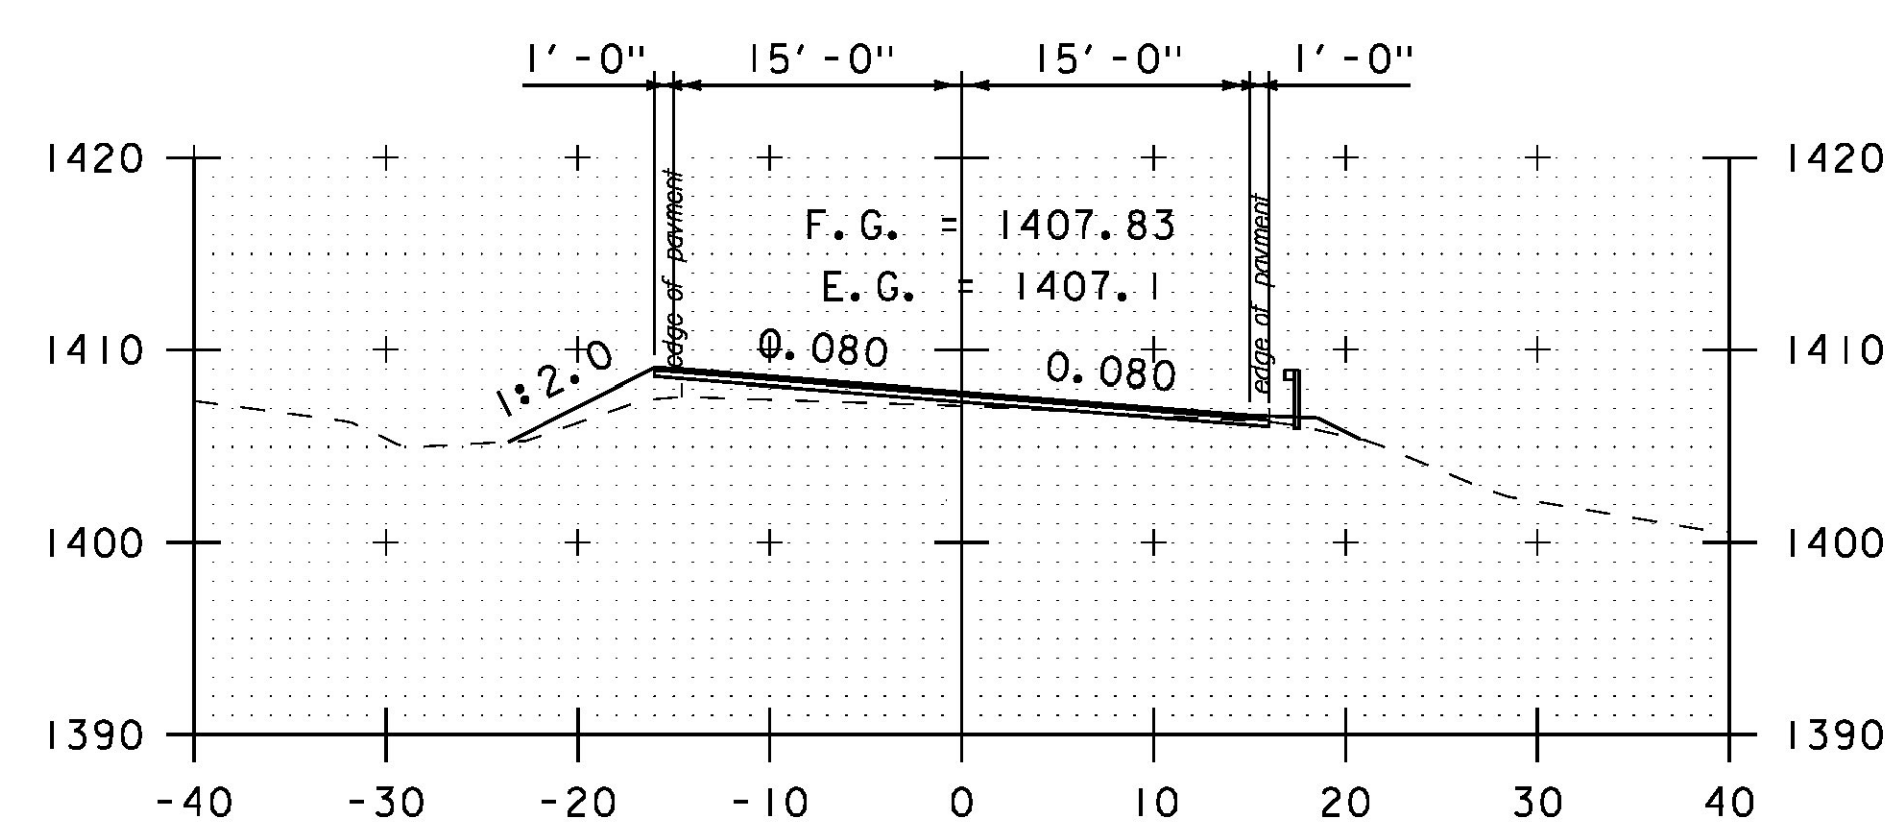

140+50

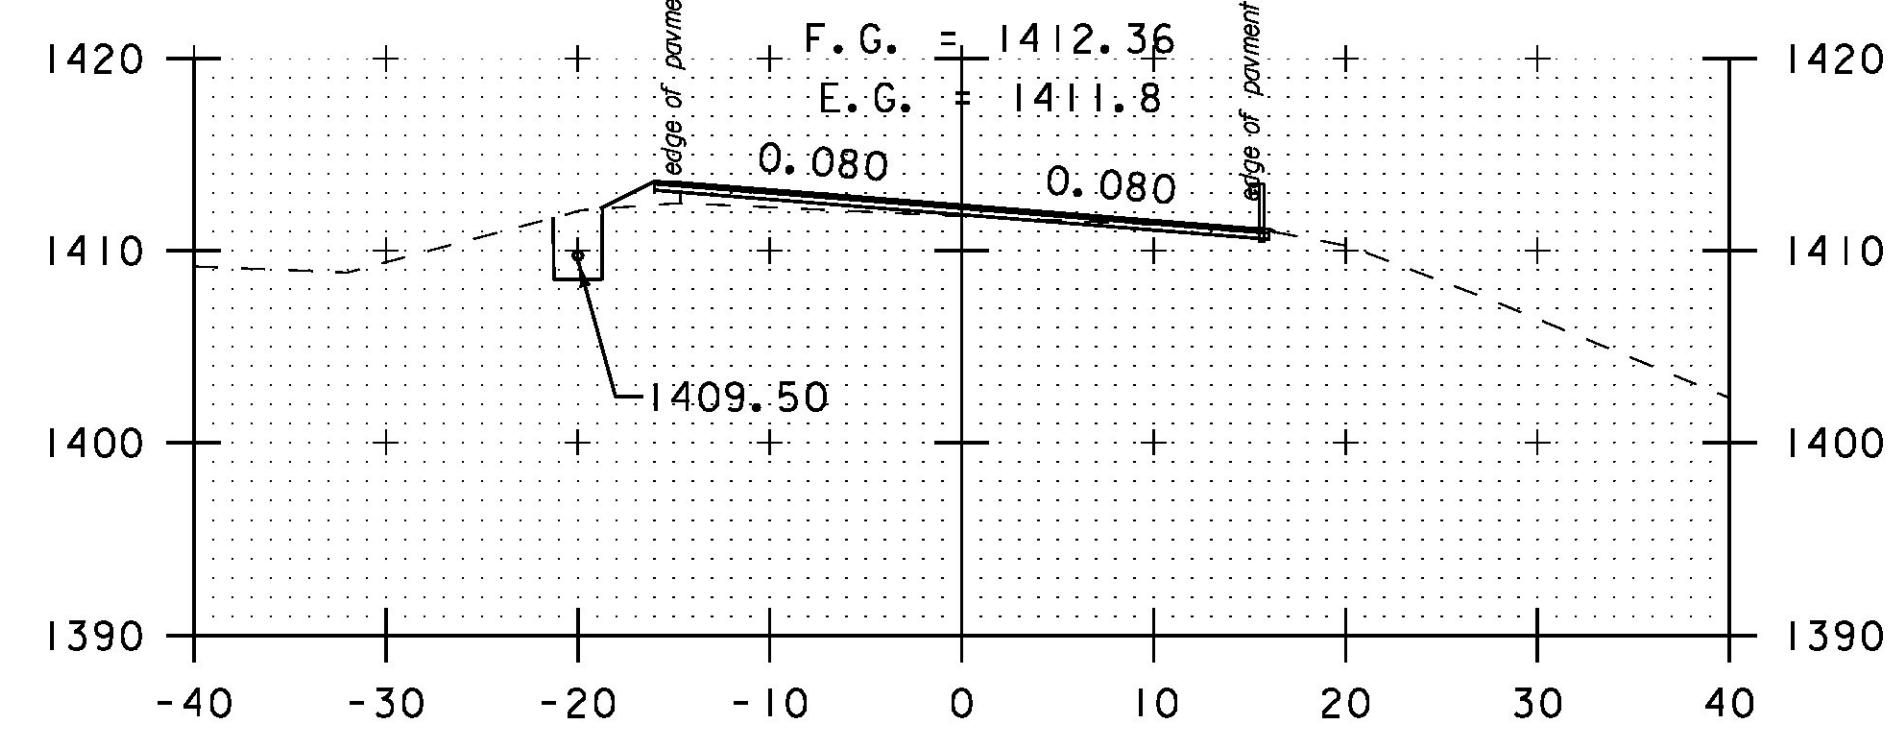

140+00

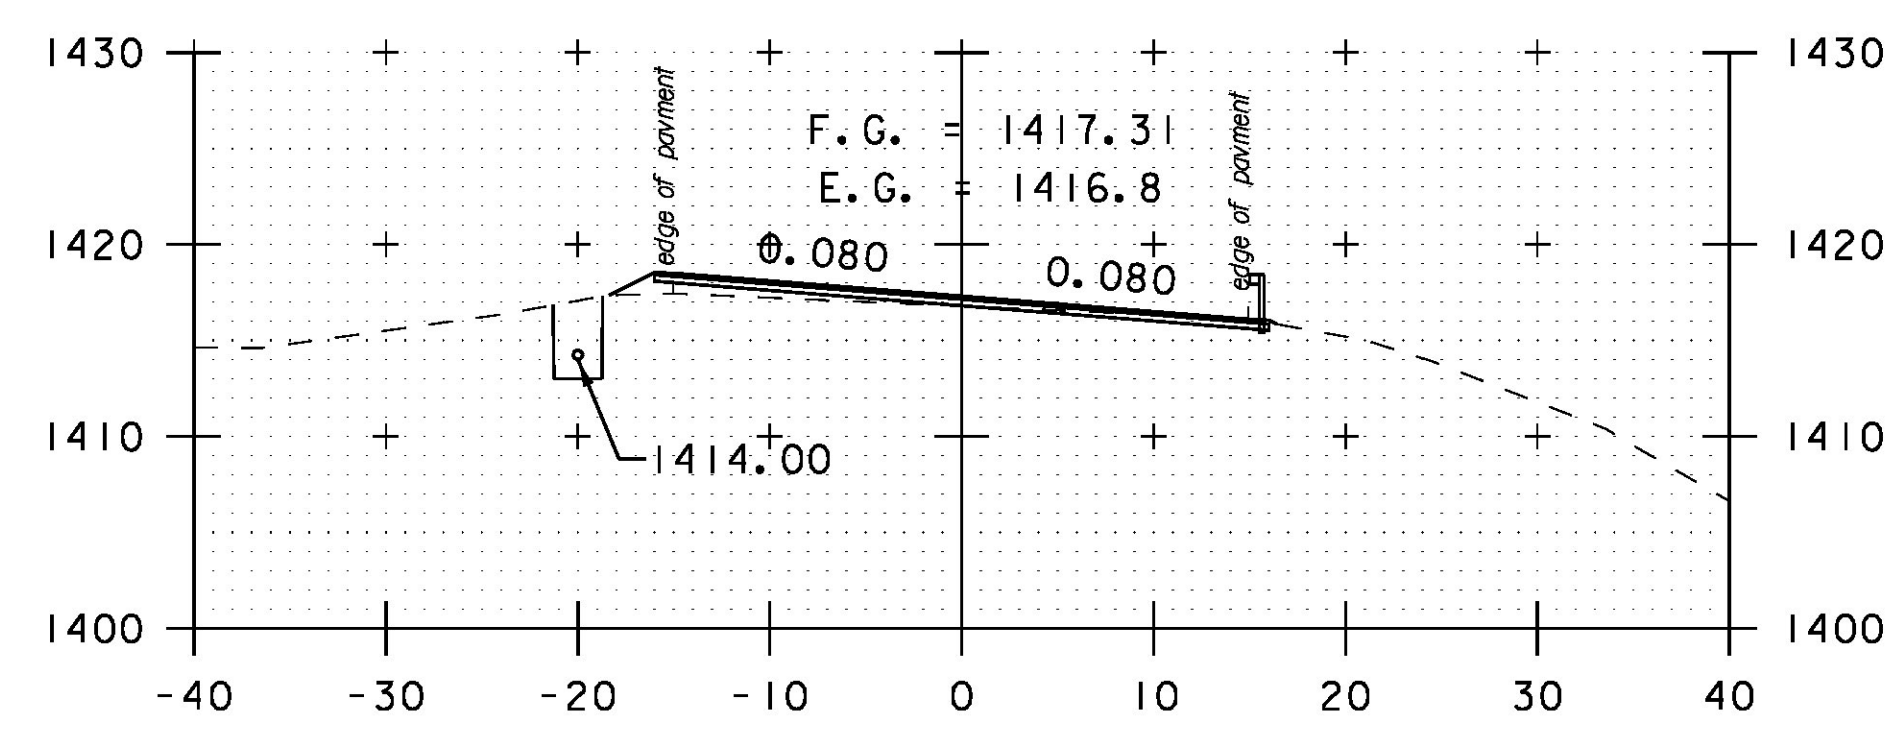

139+50



PROJECT NAME: HANCOCK	PLOT DATE: 3/18/2015
PROJECT NUMBER: STP 2923 (1)	DRAWN BY: B. MARTIN
FILE NAME: z10c252xs.dgn	CHECKED BY: C. LATHROP
PROJECT LEADER: C. LATHROP	SHEET 150 OF 207
DESIGNED BY: B. MARTIN	
CROSS SECTION SHEET 23	