




142+00
WOODS DRIVE LT

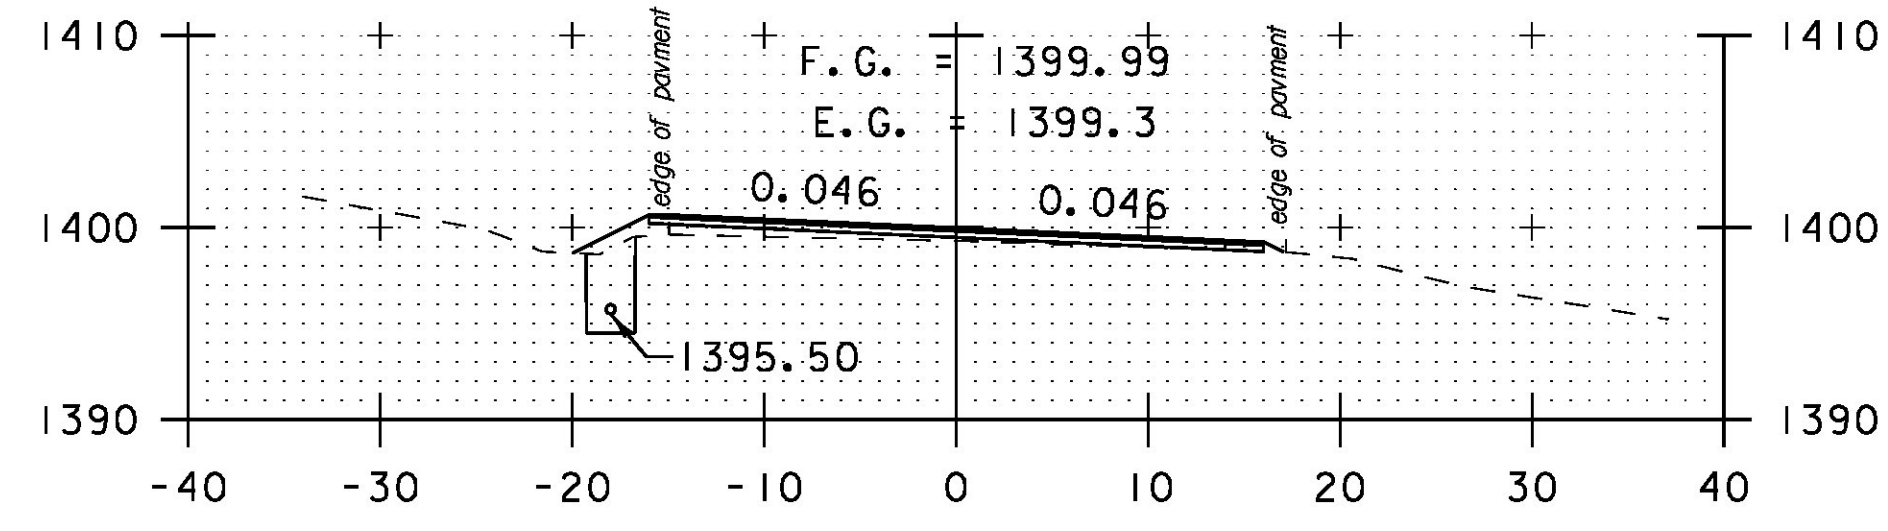

141+50

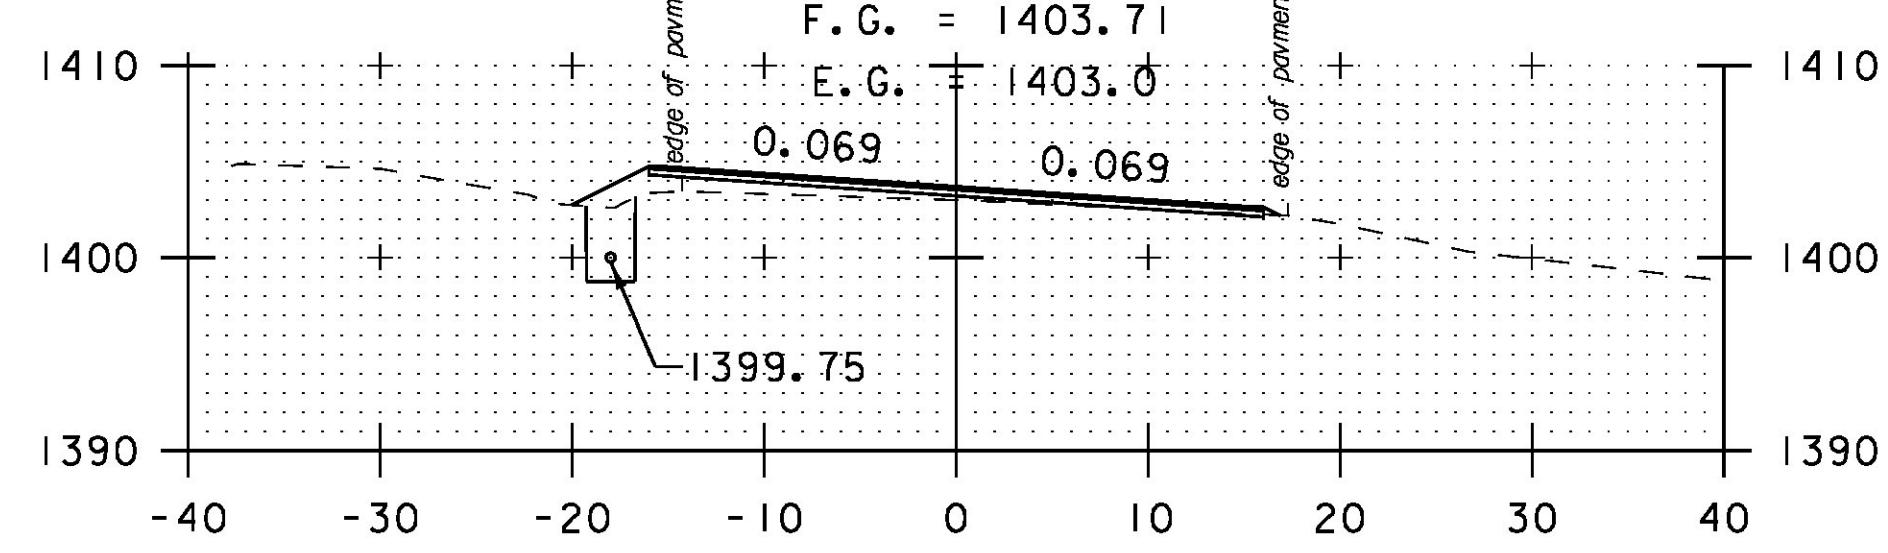


141+00

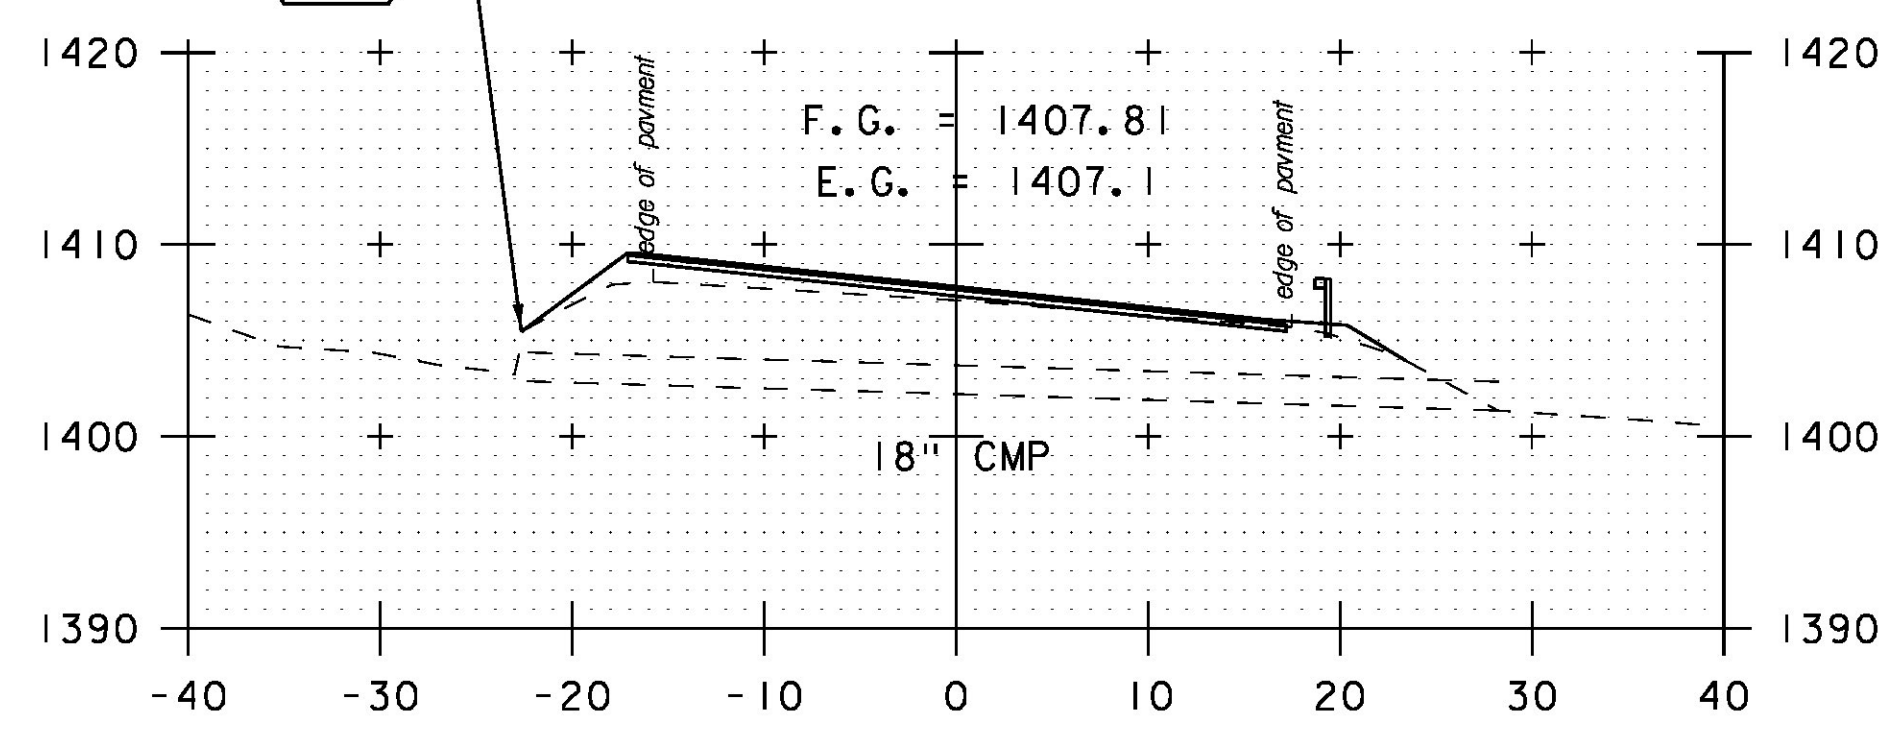


140+50
SKEWED


9 STA. 140+44.00 LT 21.2'
REPAIR EXISTING HEADWALL

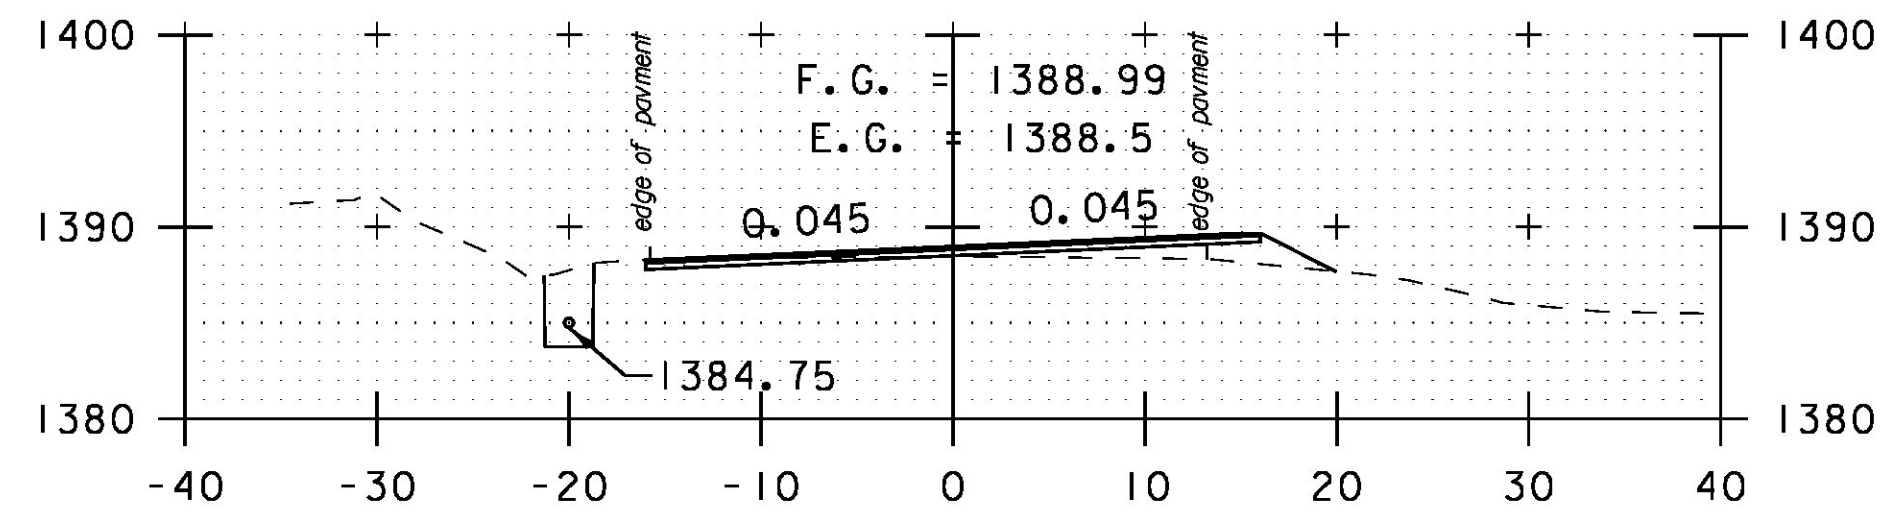


143+50

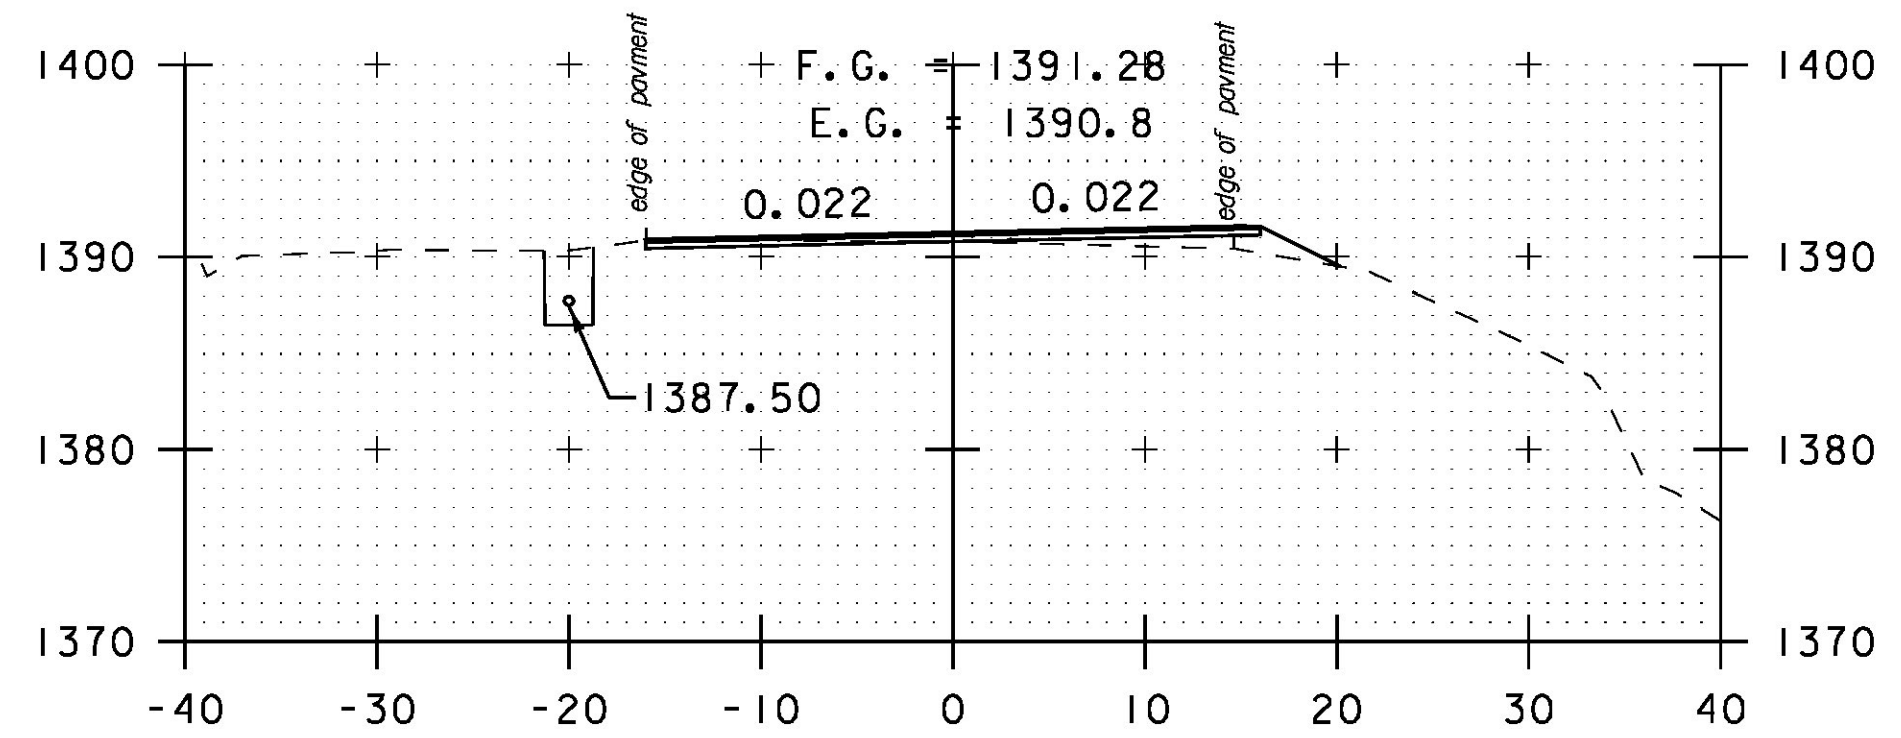

143+00

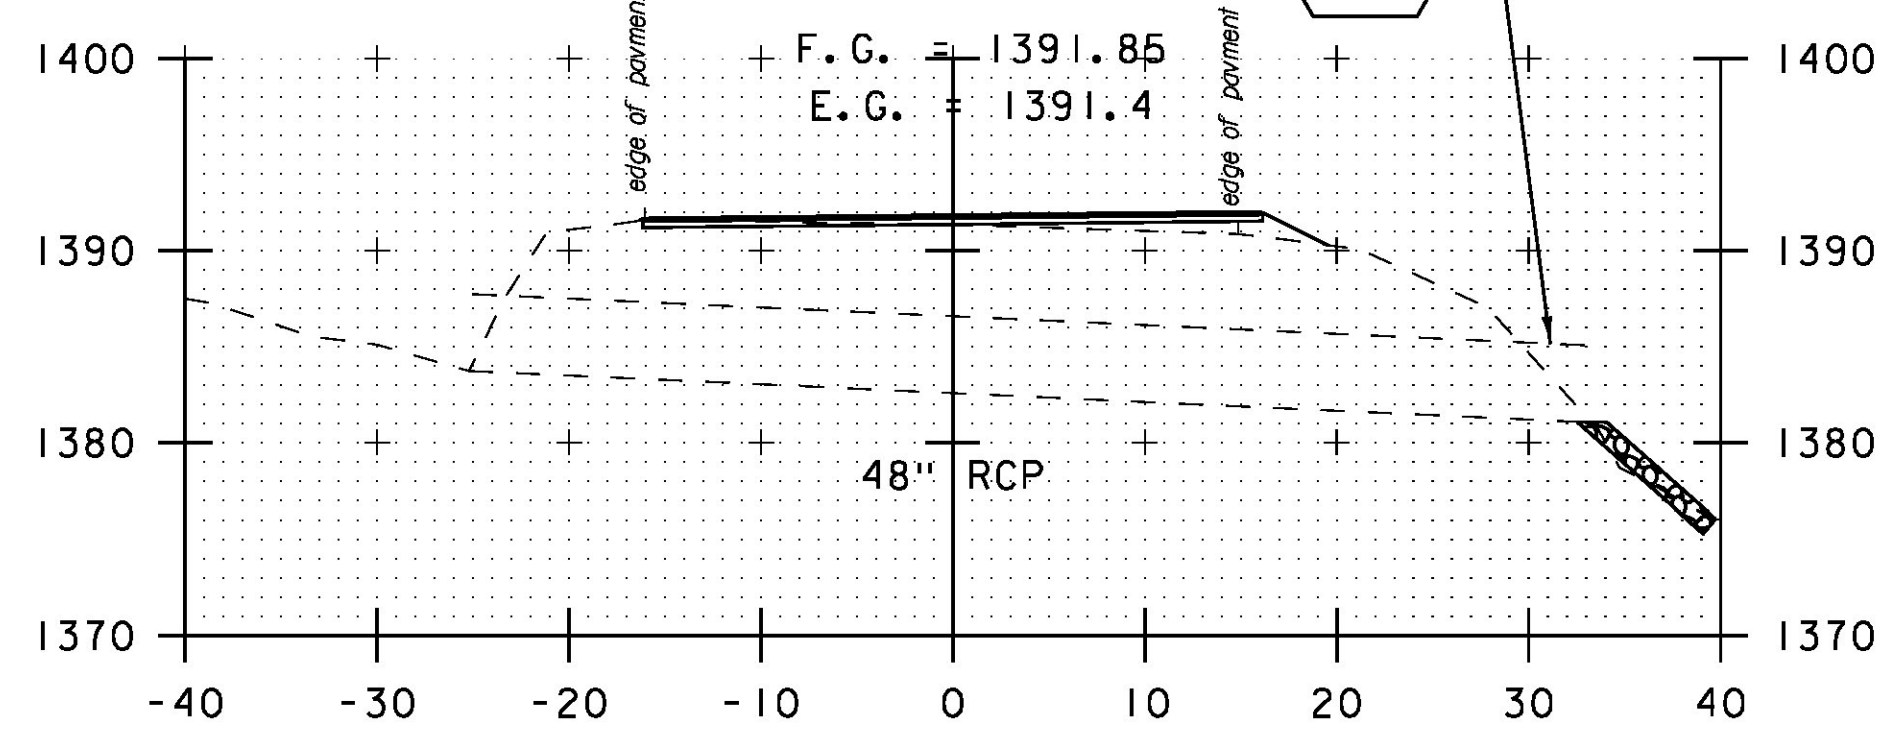


142+88
SKEWED

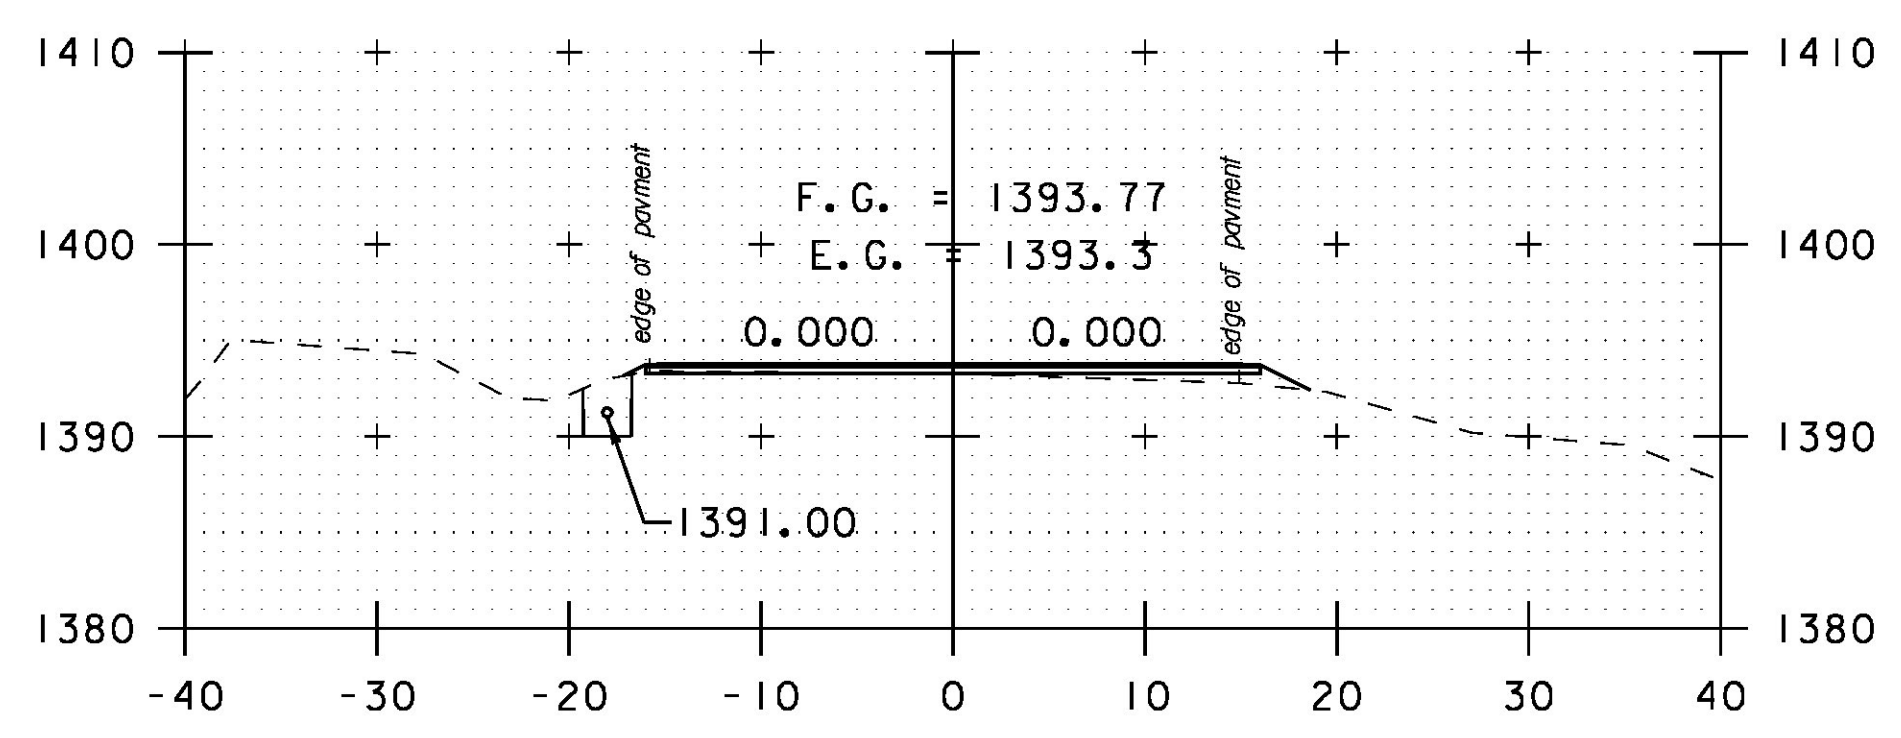


142+50


10 STA. 142+92.10 RT 33.15'
RESET OUTLET SECTION OF
48" RCP, STONE FILL AT
OUTLET

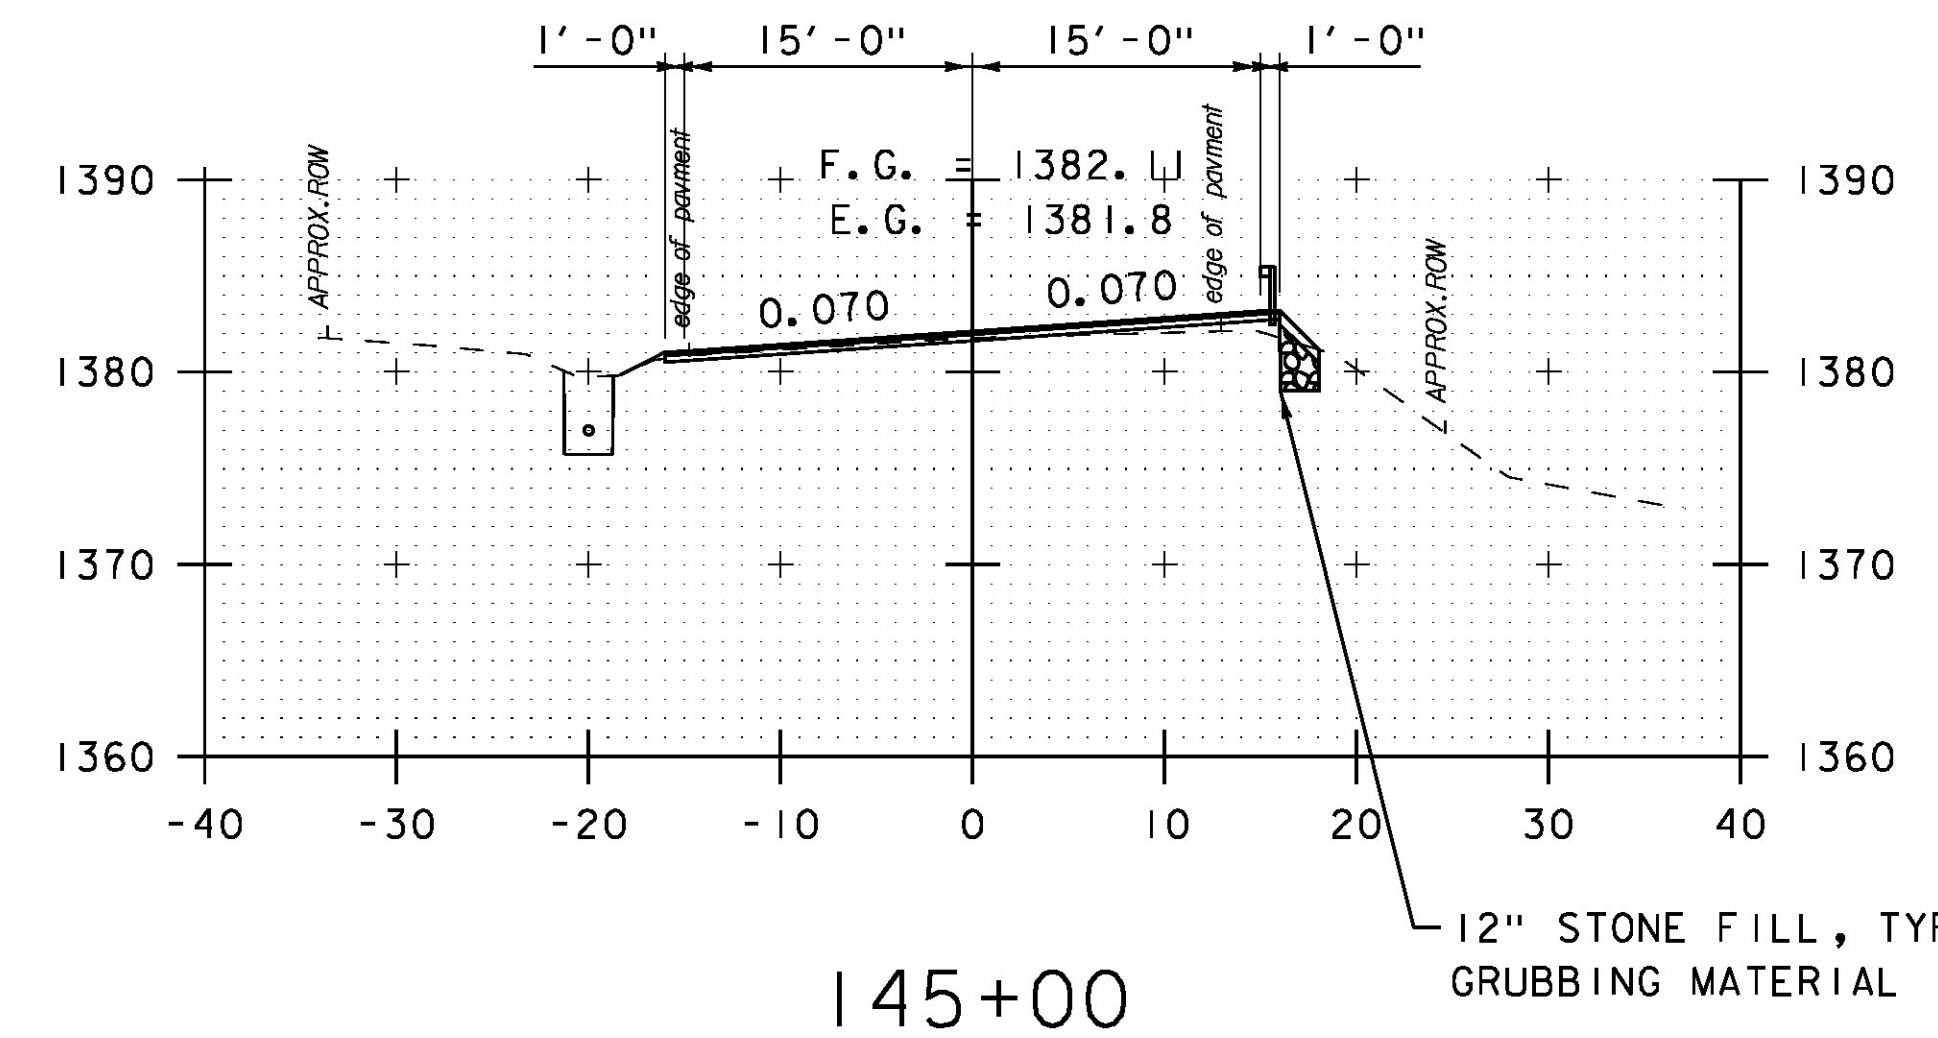


145+00

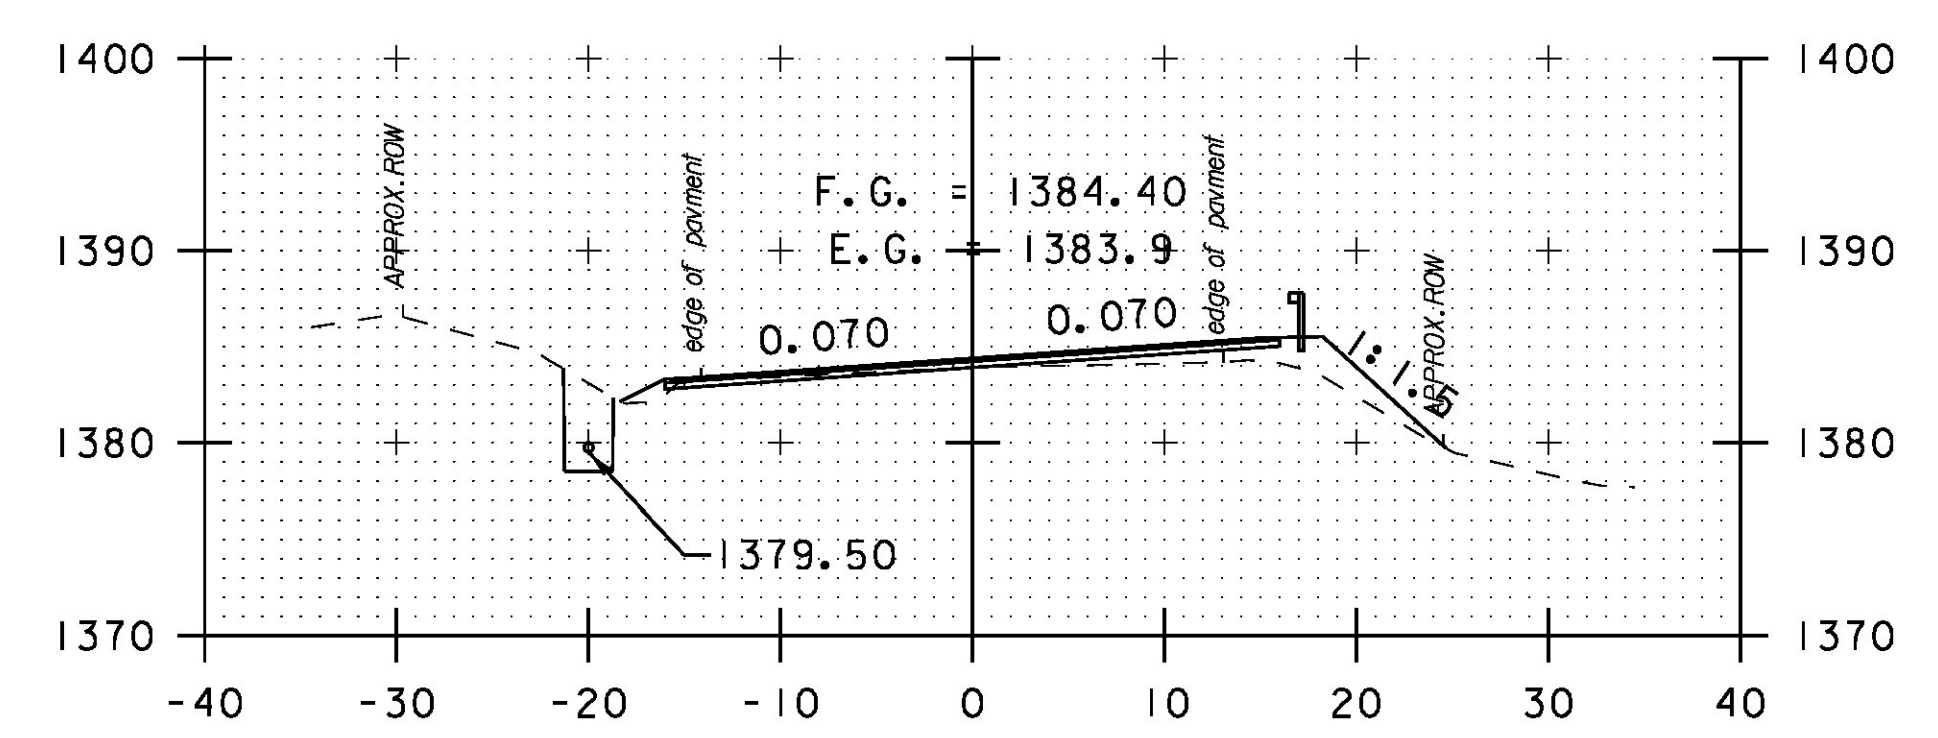

144+50

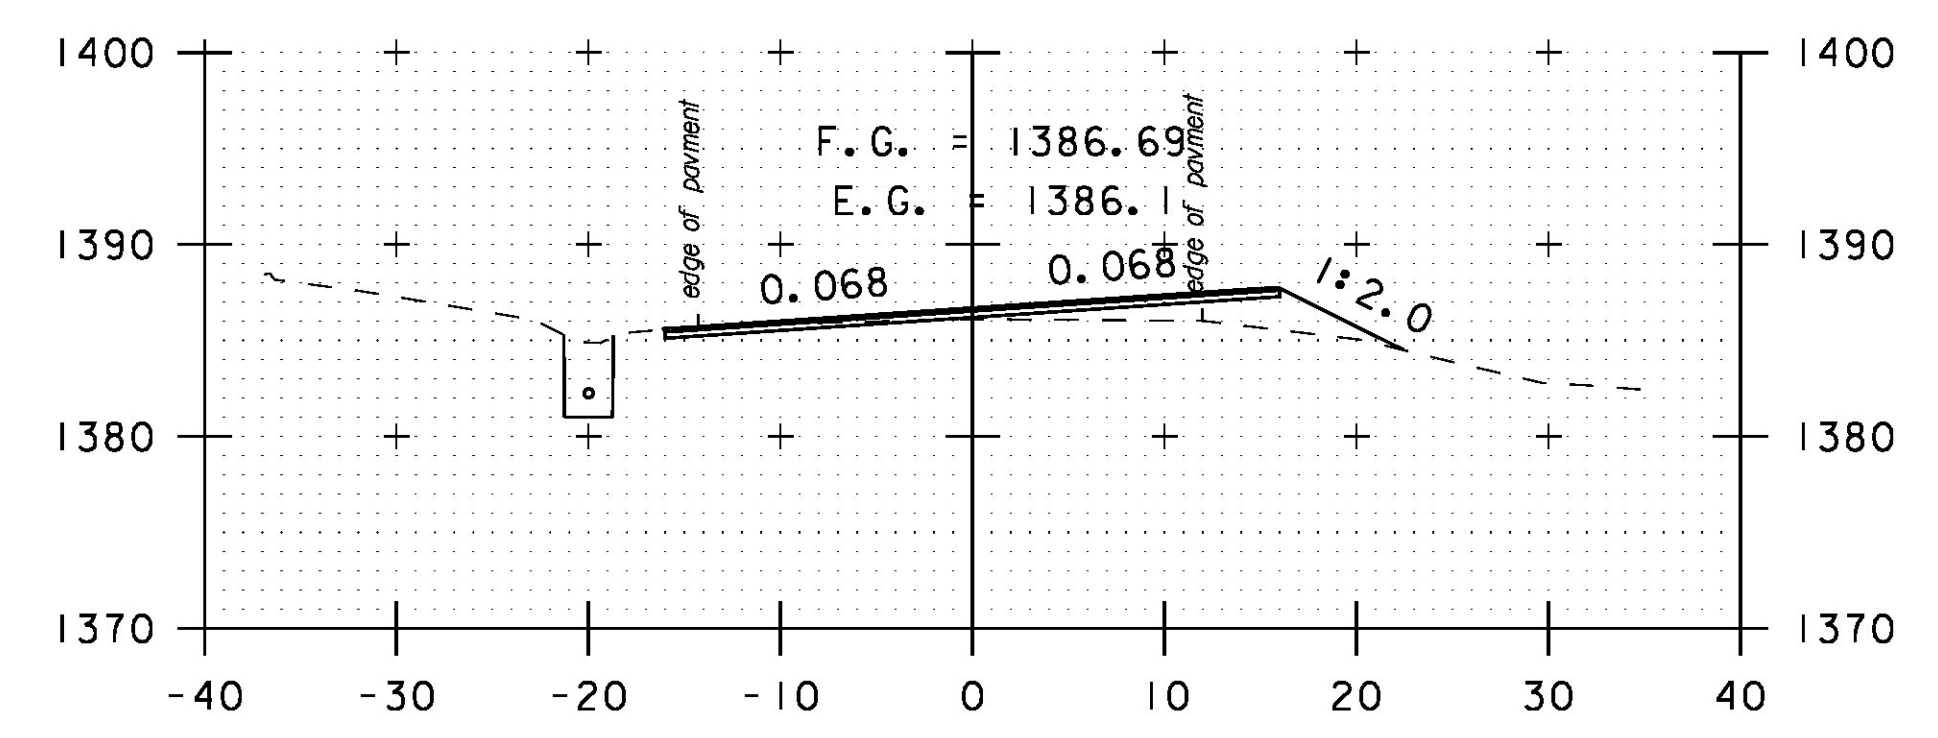

144+00
WOODS DRIVE LT

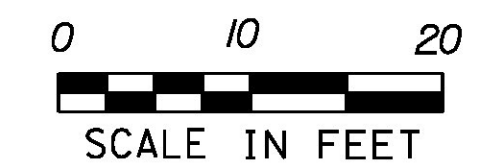

PROJECT NAME:	HANCOCK	PLOT DATE:	3/18/2015
PROJECT NUMBER:	STP 2923 (1)	DRAWN BY:	B. MARTIN
FILE NAME:	z10c252xs.dgn	CHECKED BY:	C. LATHROP
PROJECT LEADER:	C. LATHROP	CROSS SECTION SHEET	24
DESIGNED BY:	B. MARTIN	SHEET	151 OF 207