




146+50

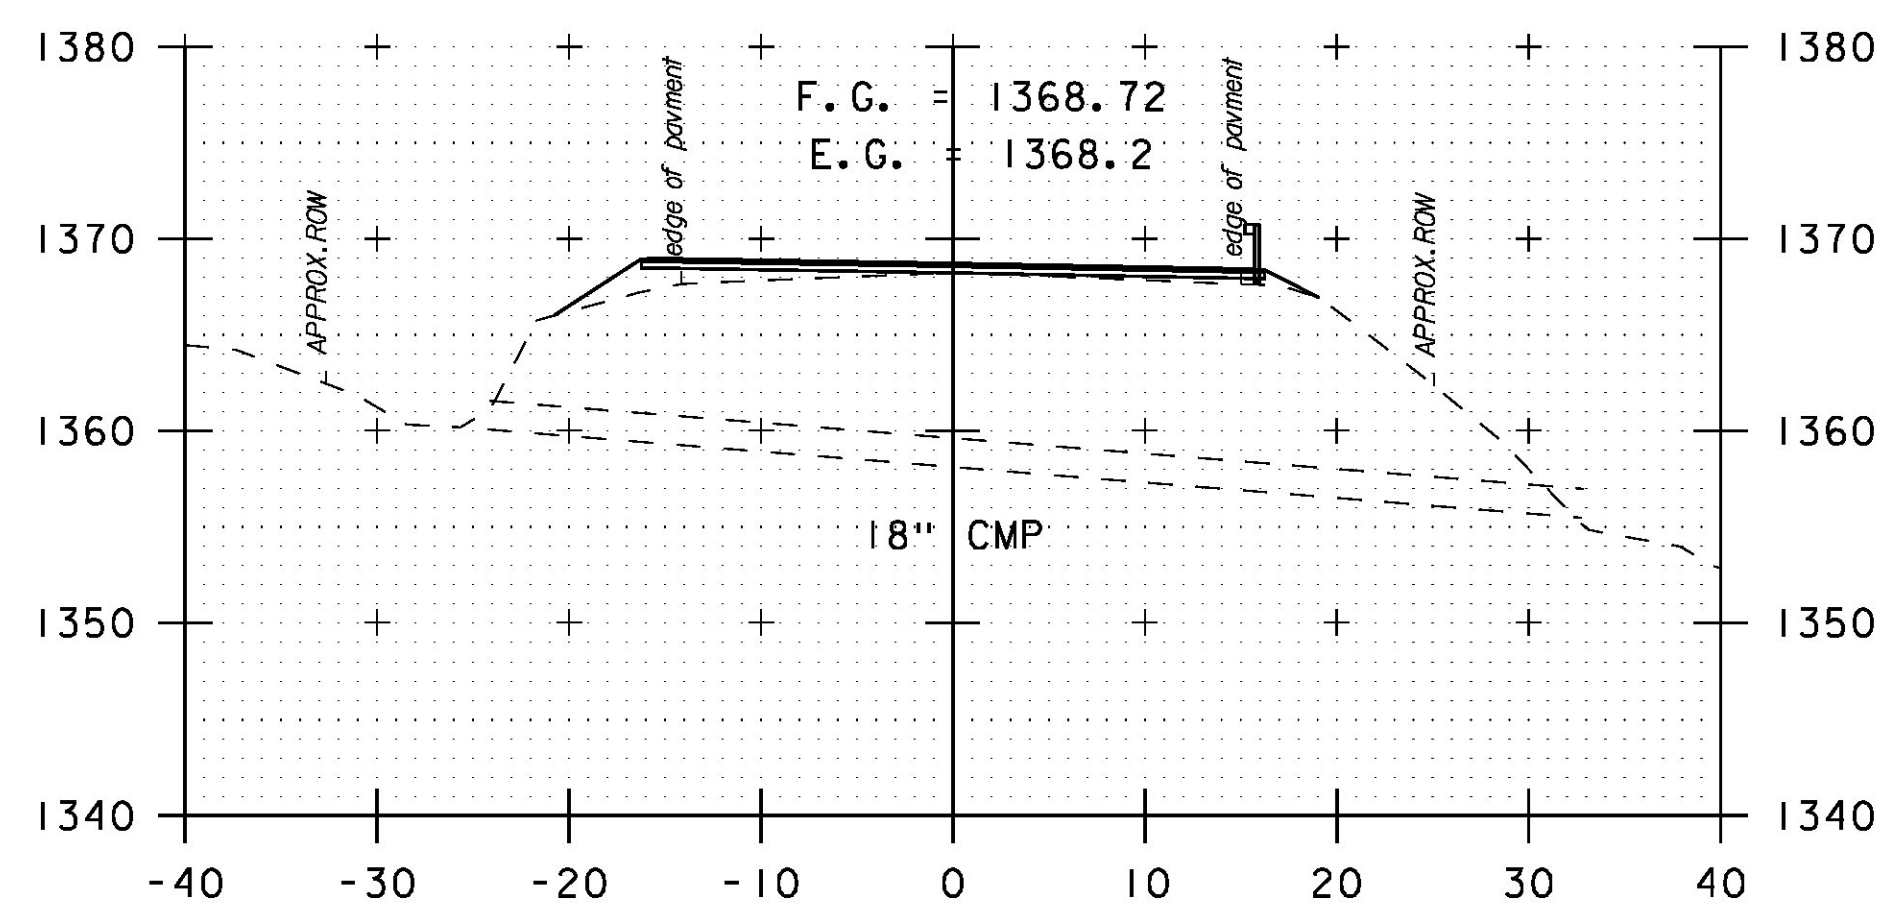


147+55  
SKEWED

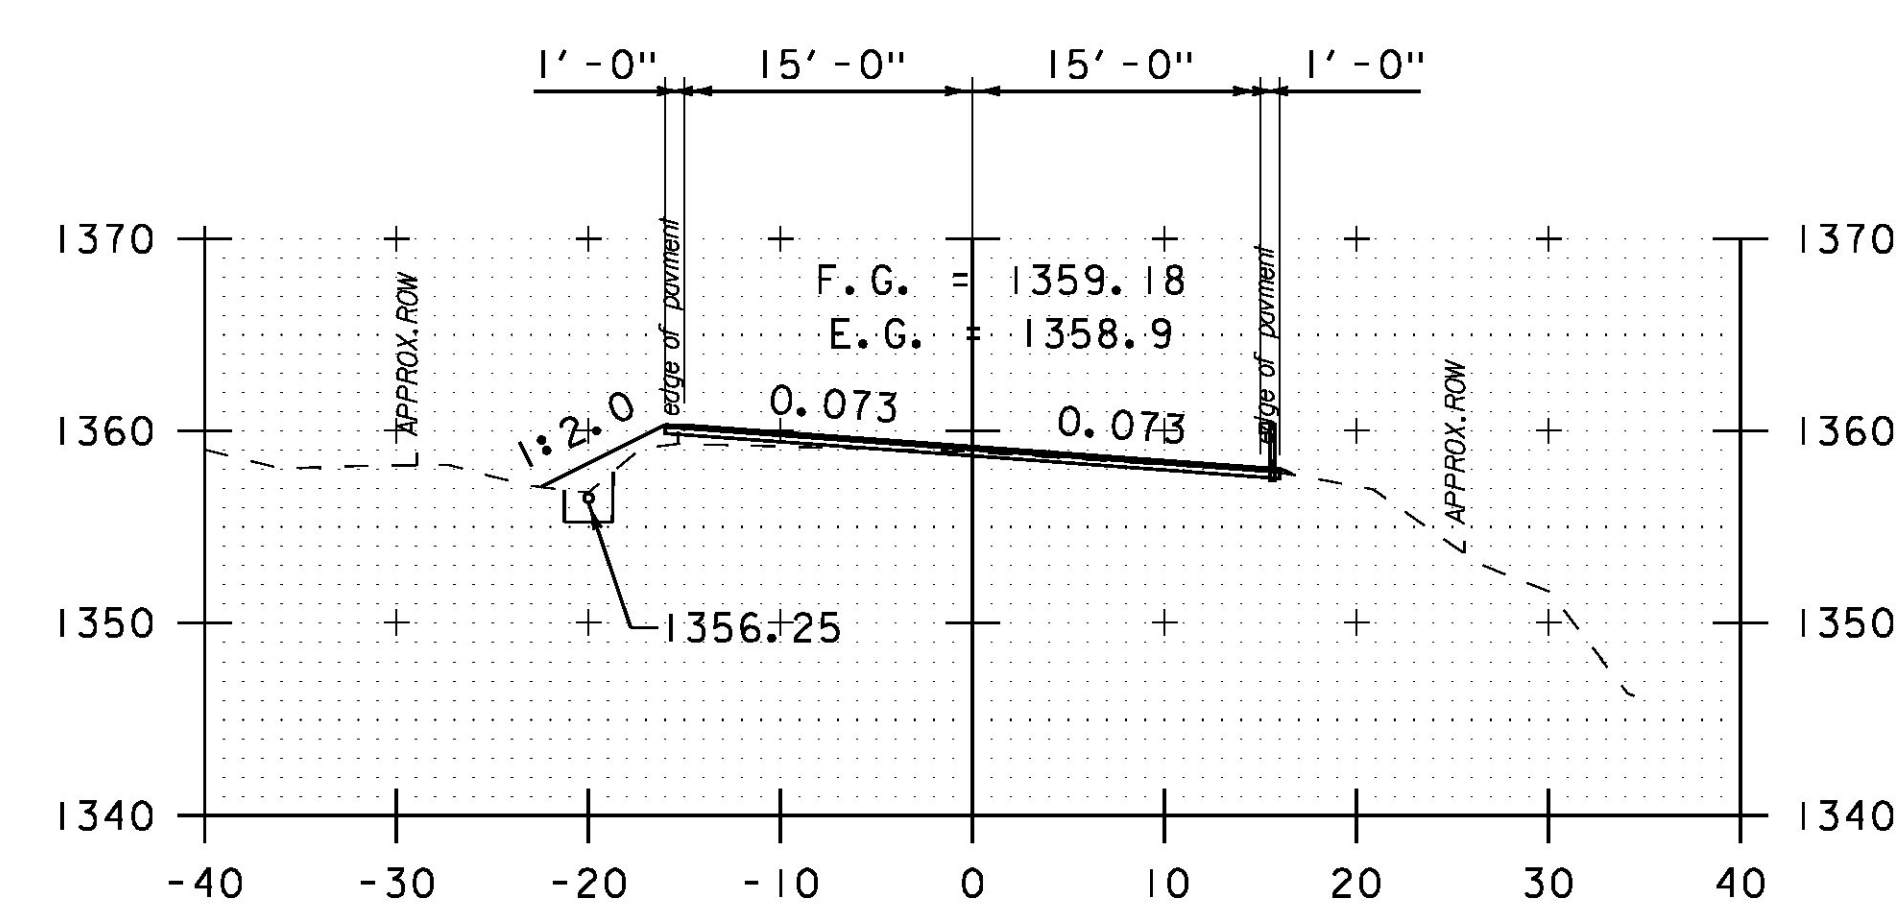


149+00

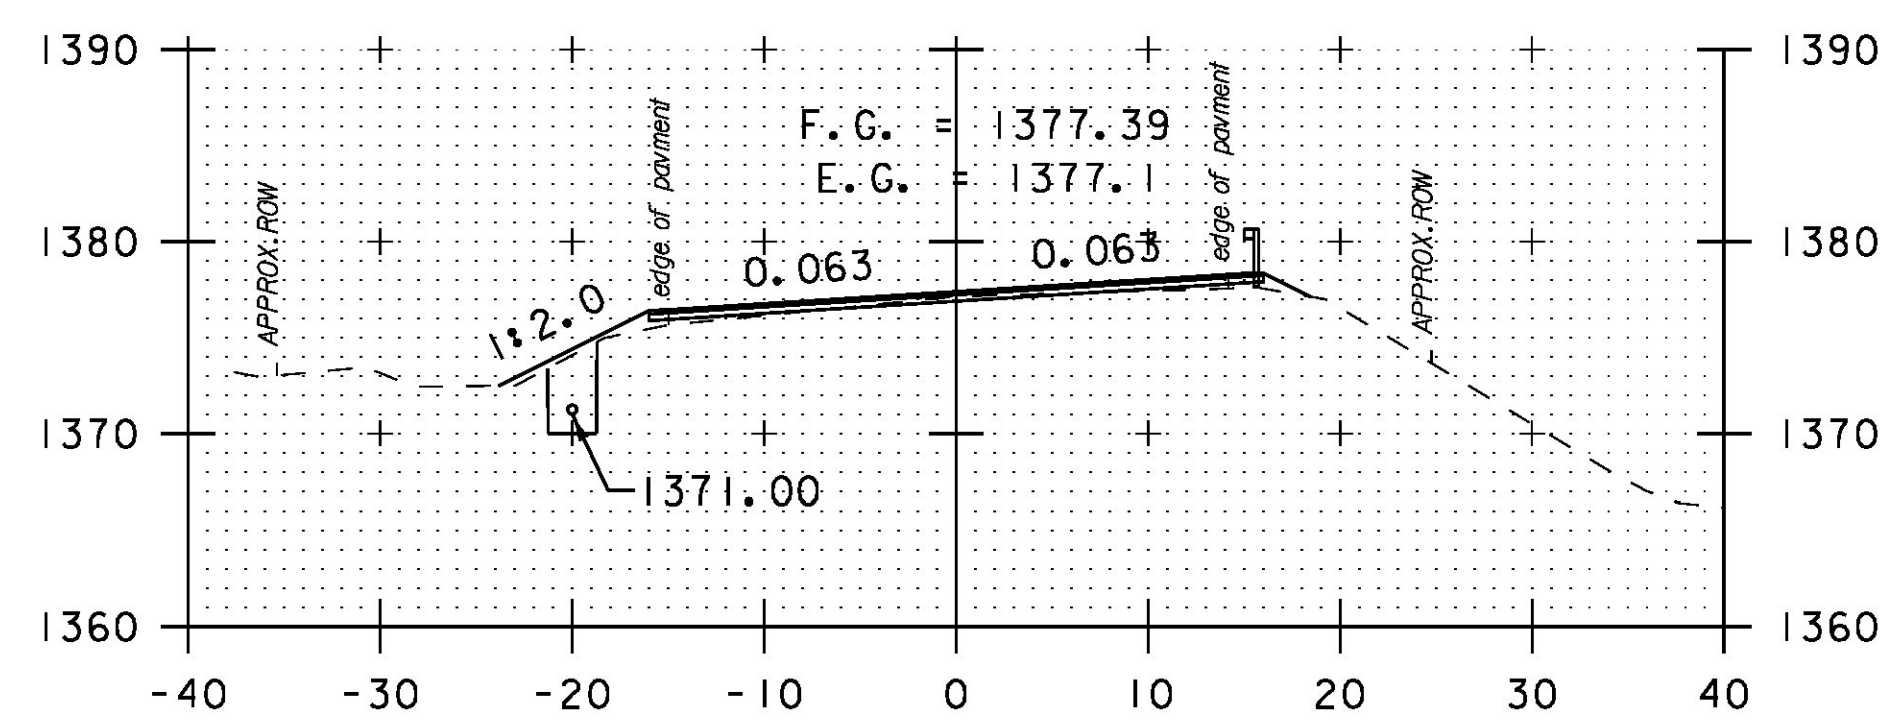


146+00

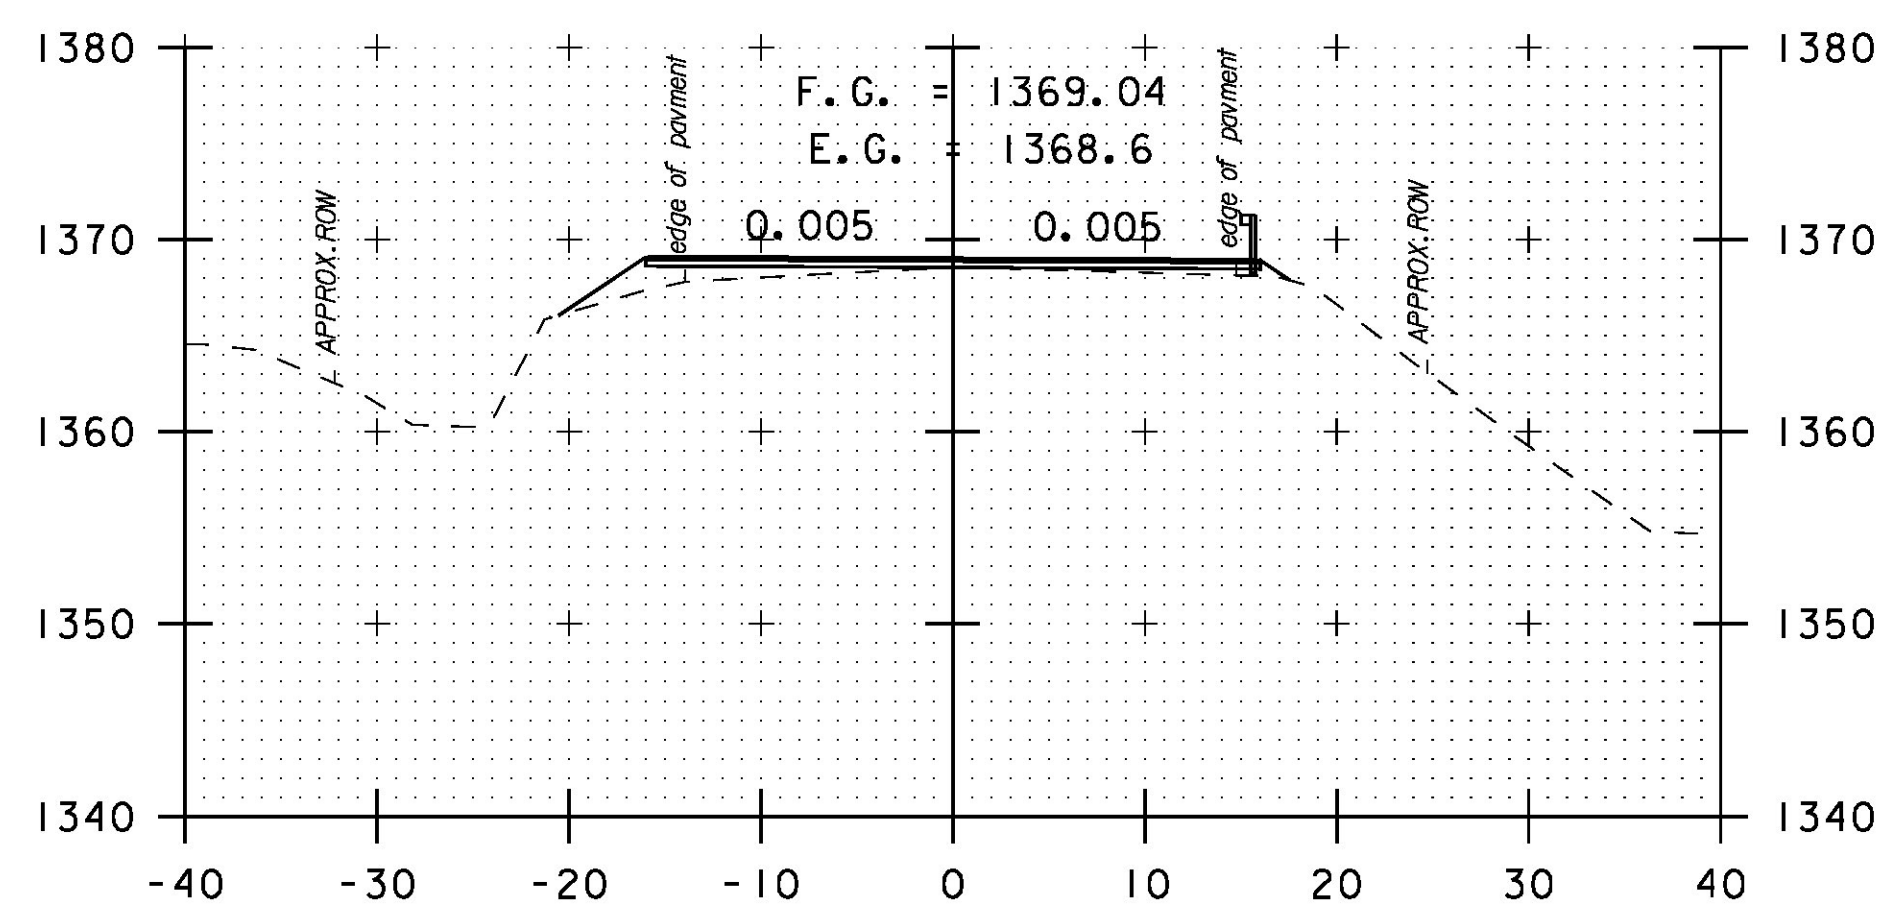


147+50

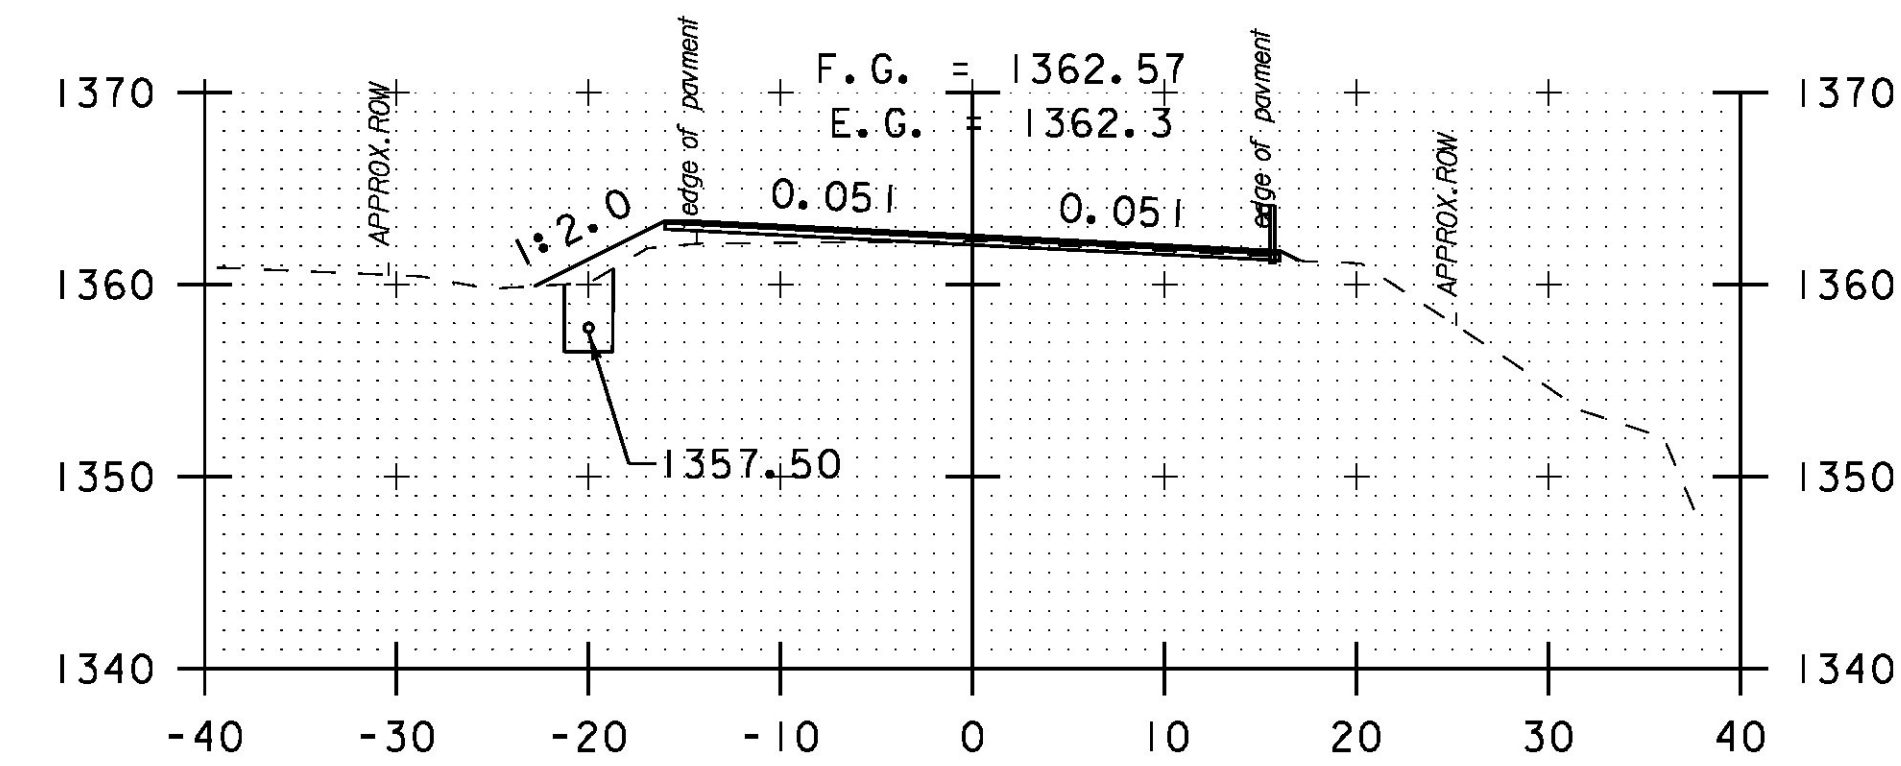


148+50

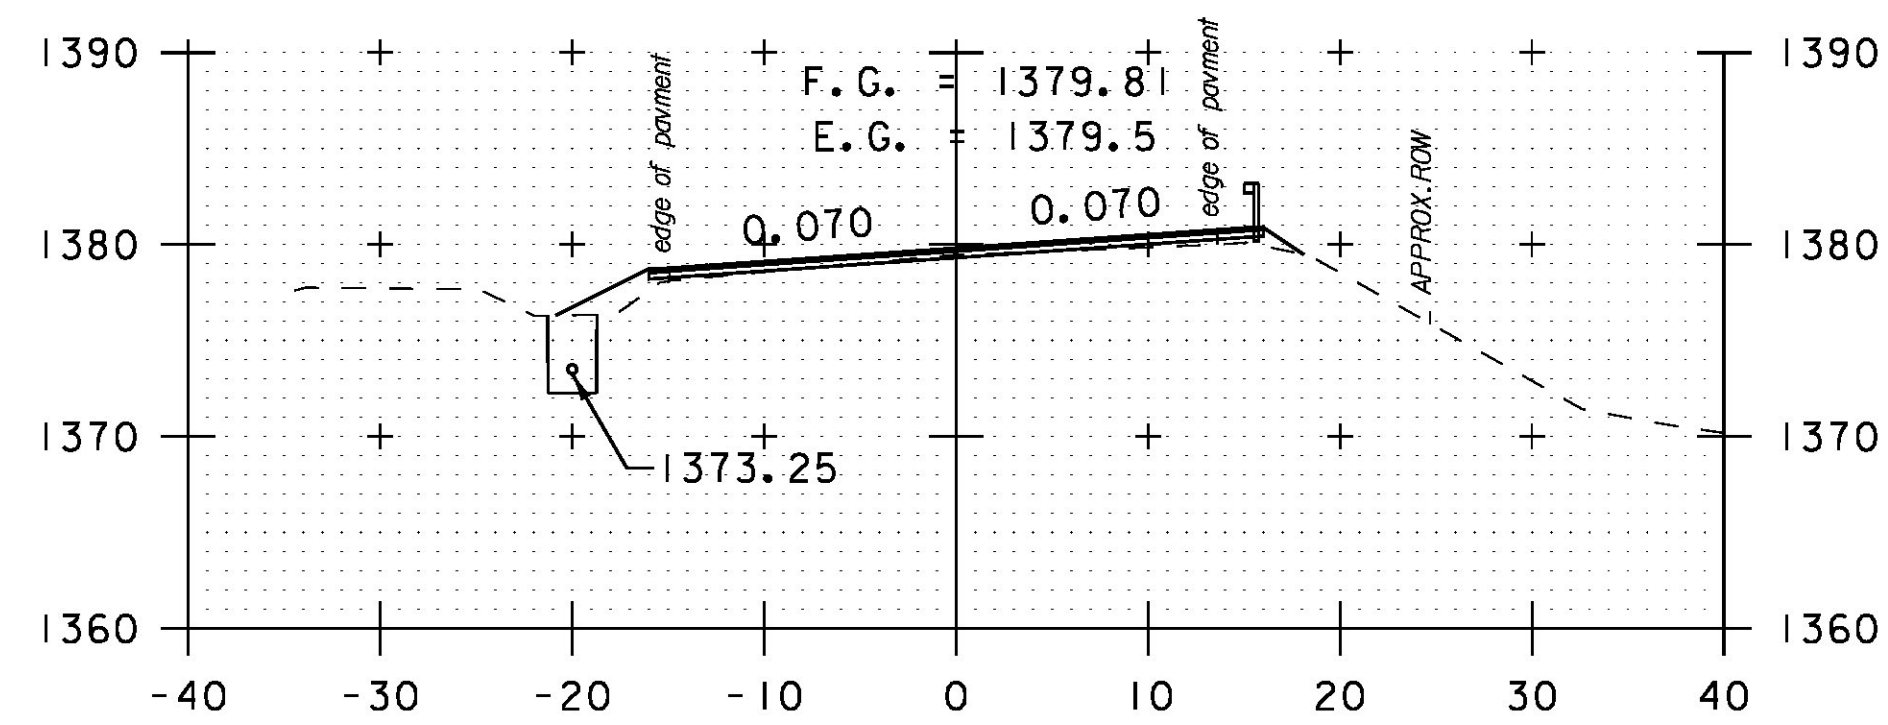

145+50

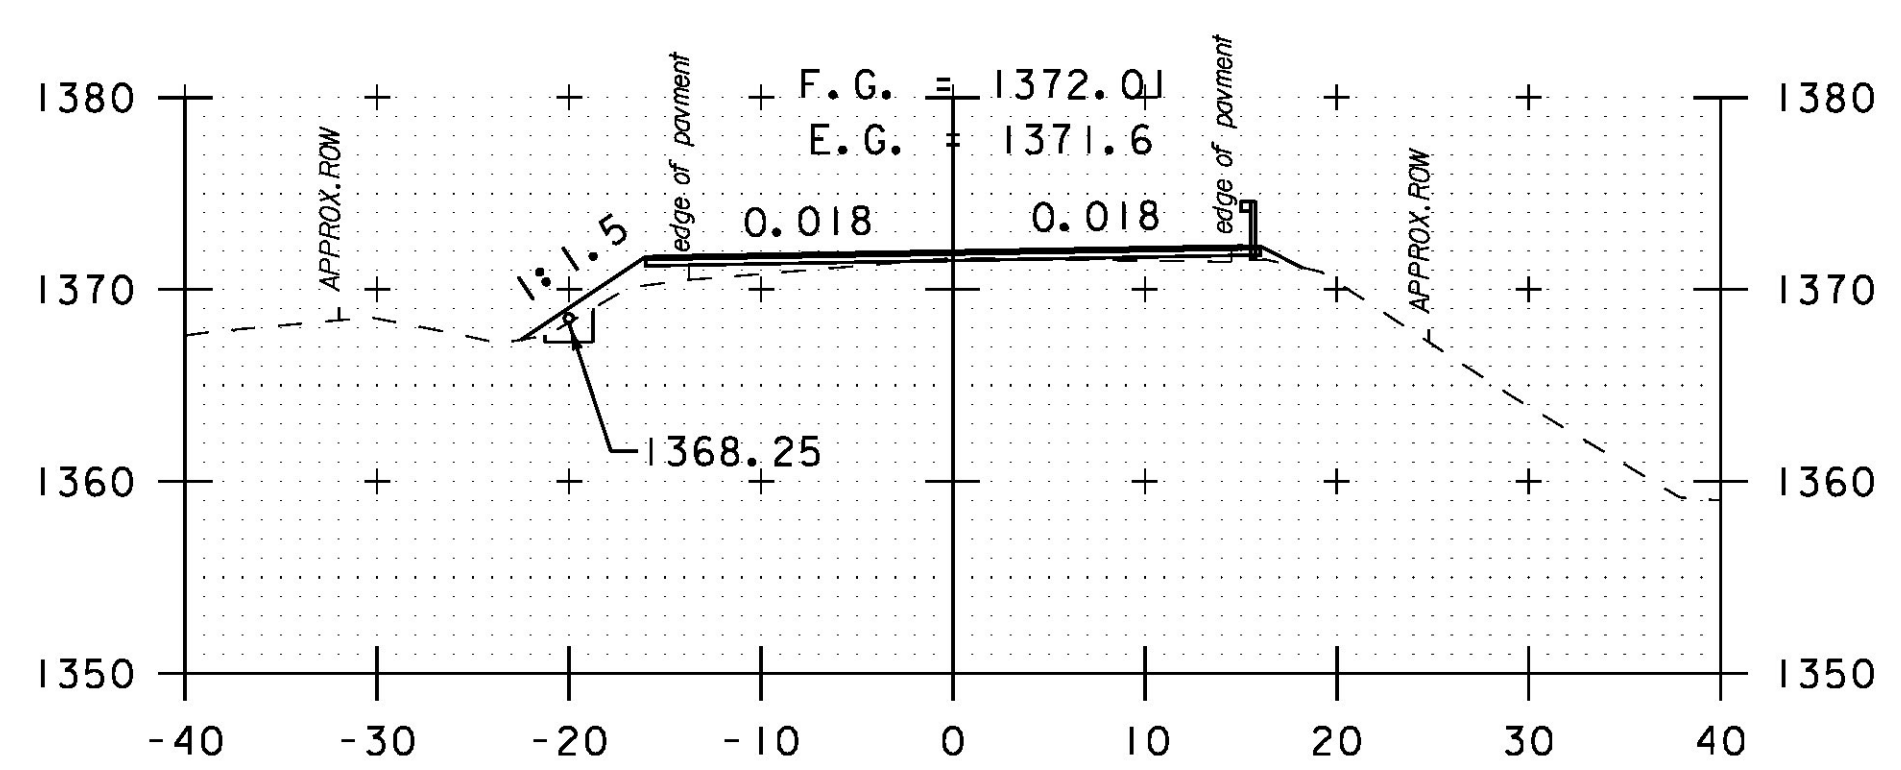

147+00

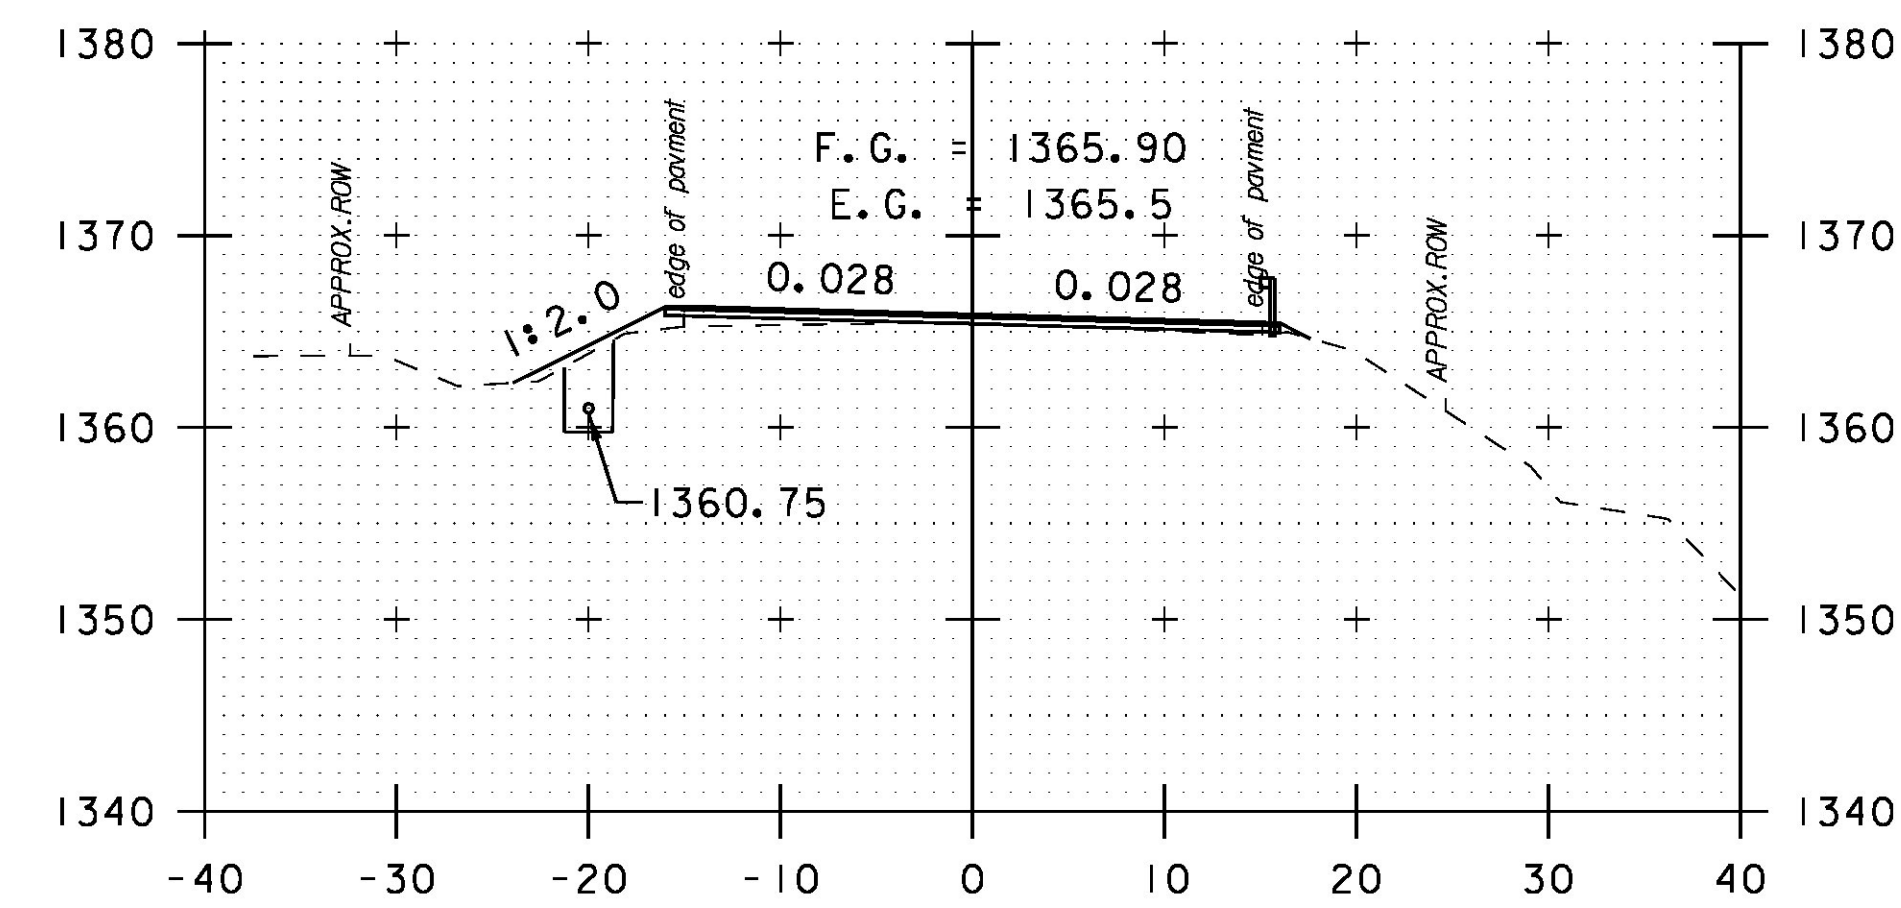

148+00



PROJECT NAME:	HANCOCK	PLOT DATE:	3/18/2015
PROJECT NUMBER:	STP 2923 (1)	DRAWN BY:	B. MARTIN
FILE NAME:	z10c252x.s.dgn	CHECKED BY:	C. LATHROP
PROJECT LEADER:	C. LATHROP	CROSS SECTION SHEET	25
DESIGNED BY:	B. MARTIN	SHEET	152 OF 207