




150+00

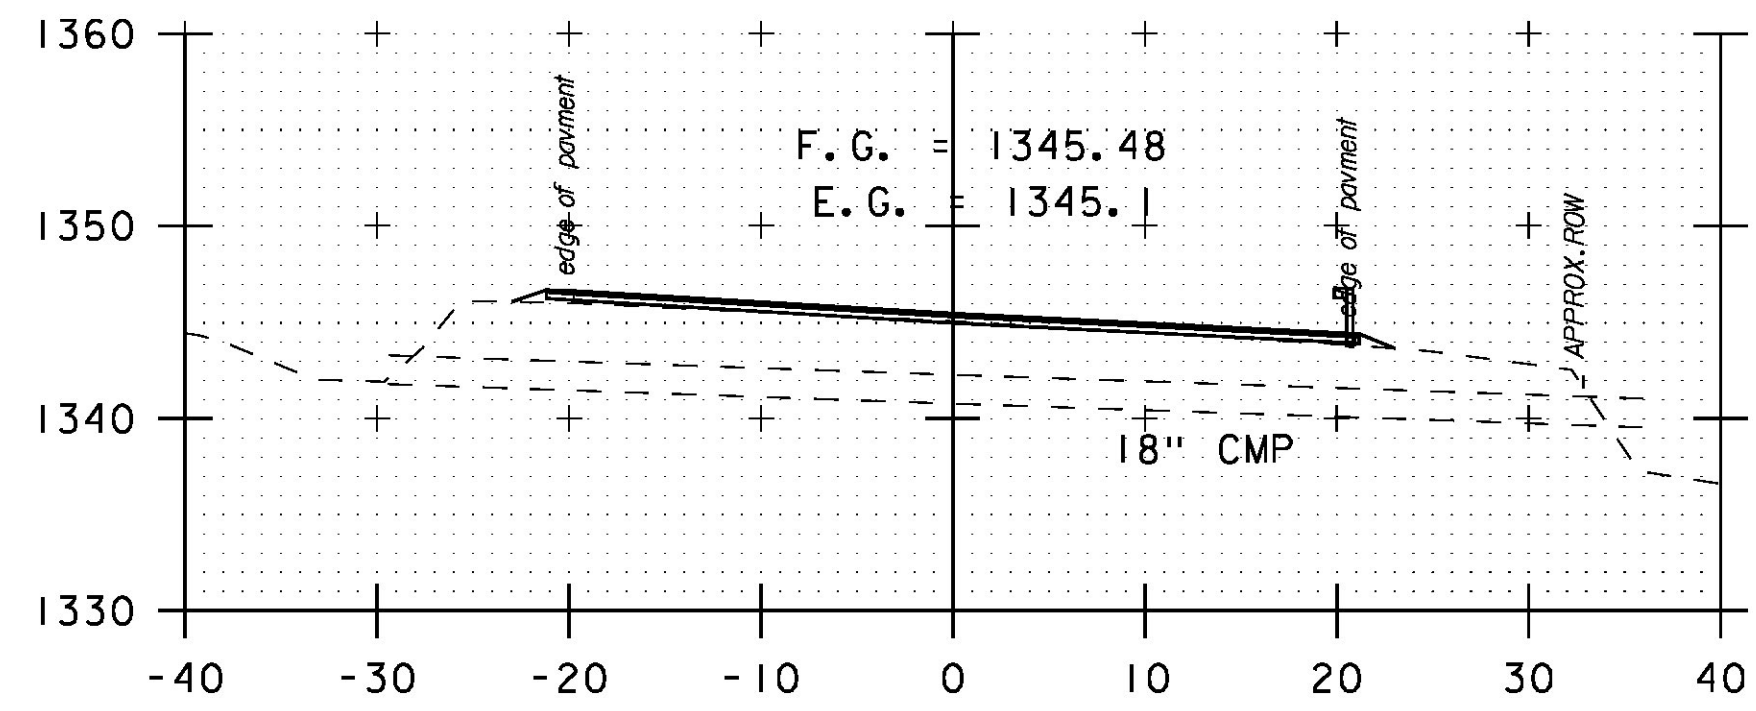


151+25
SKEWED

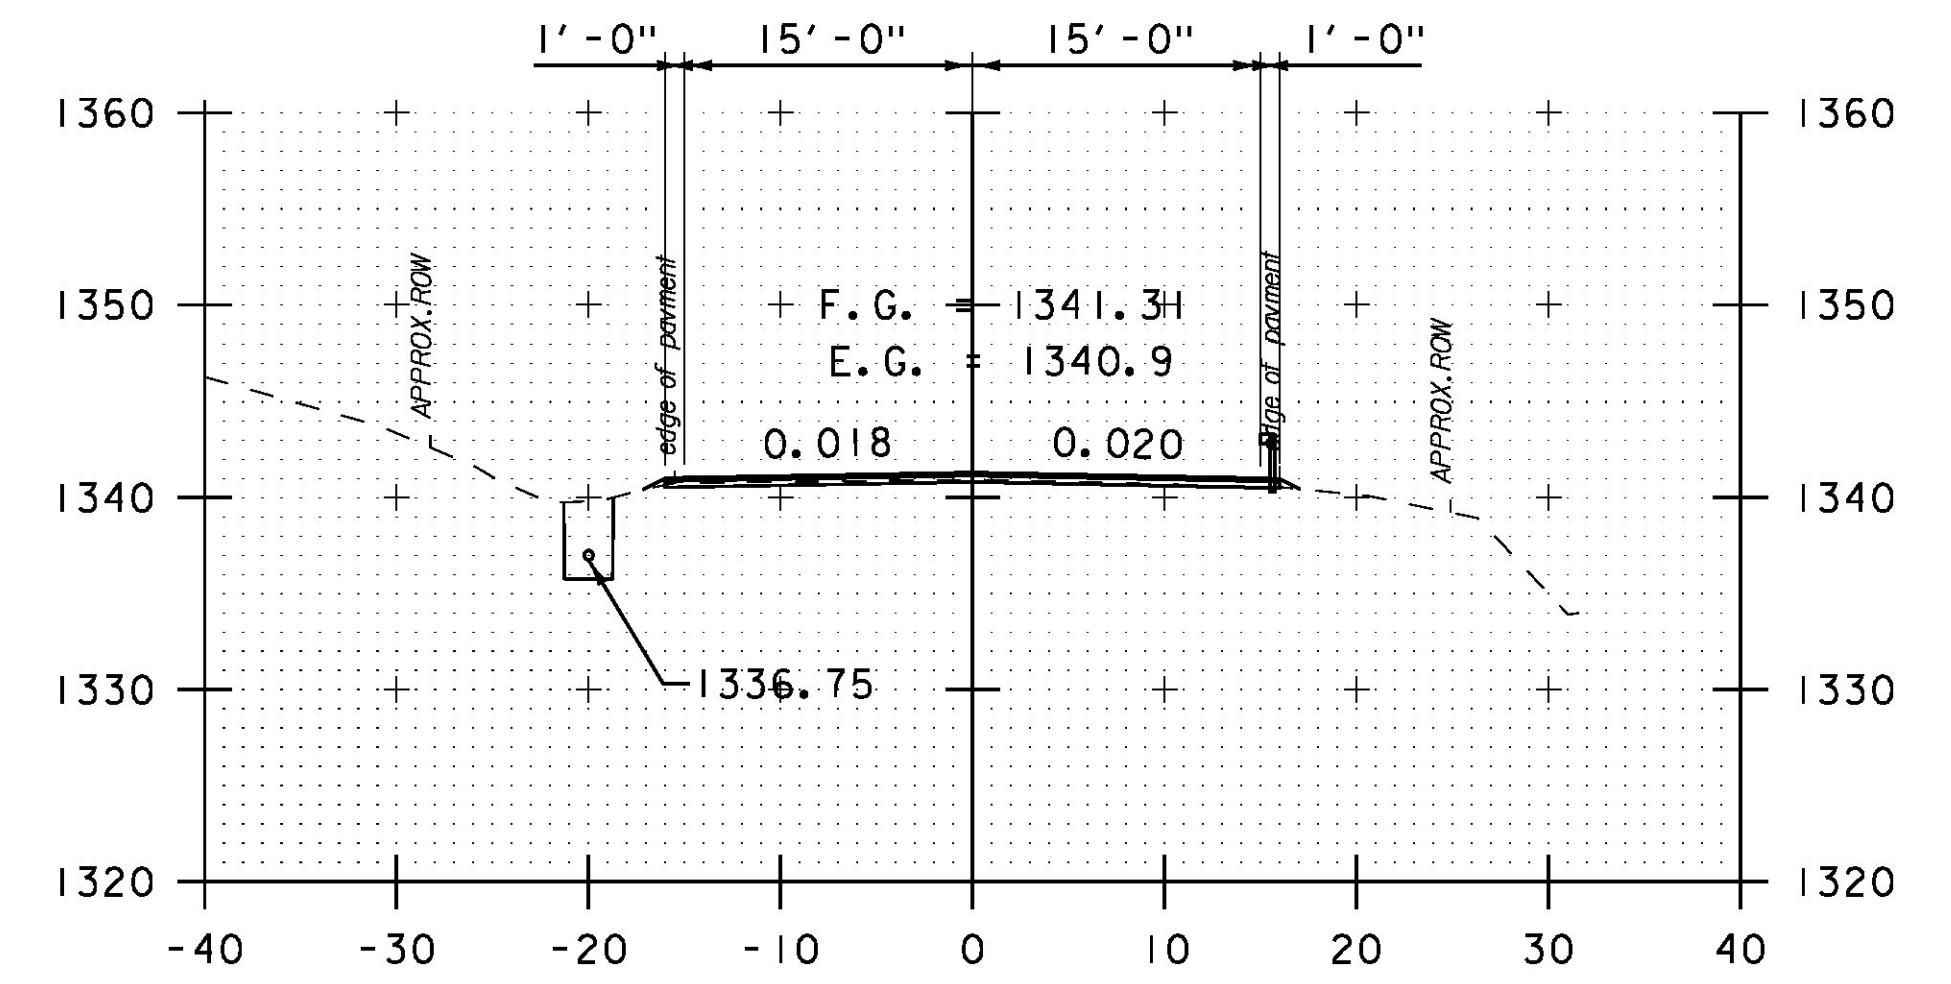


152+50

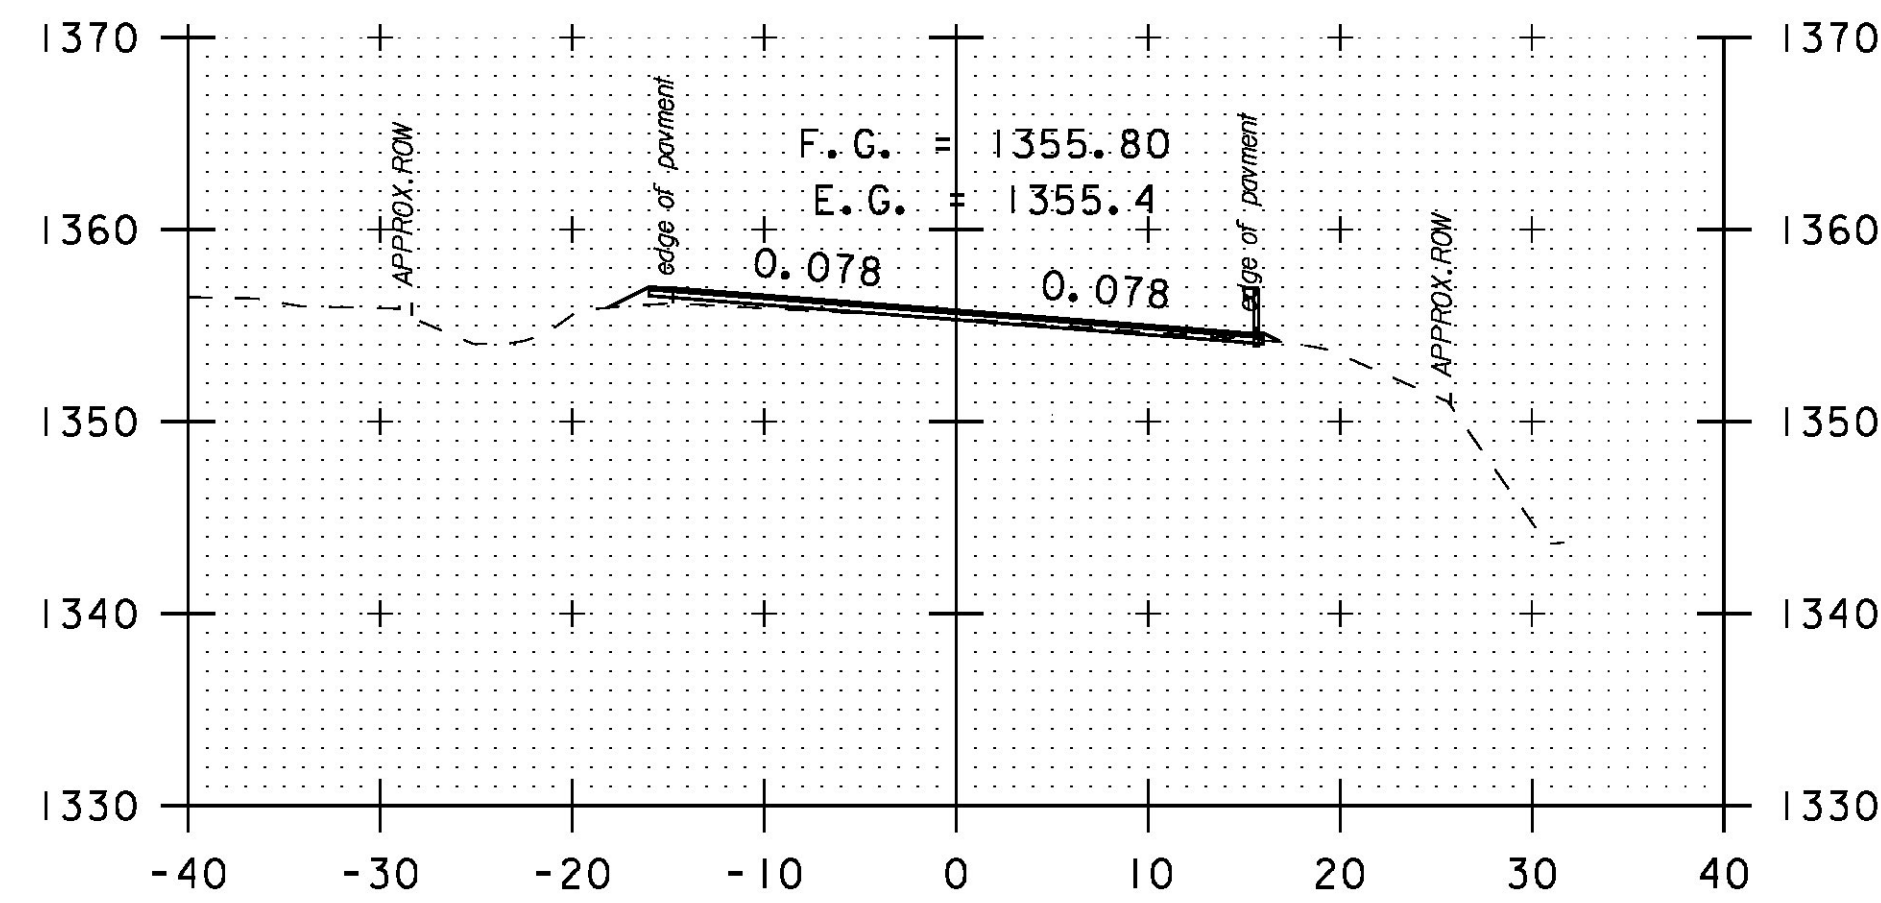


149+50

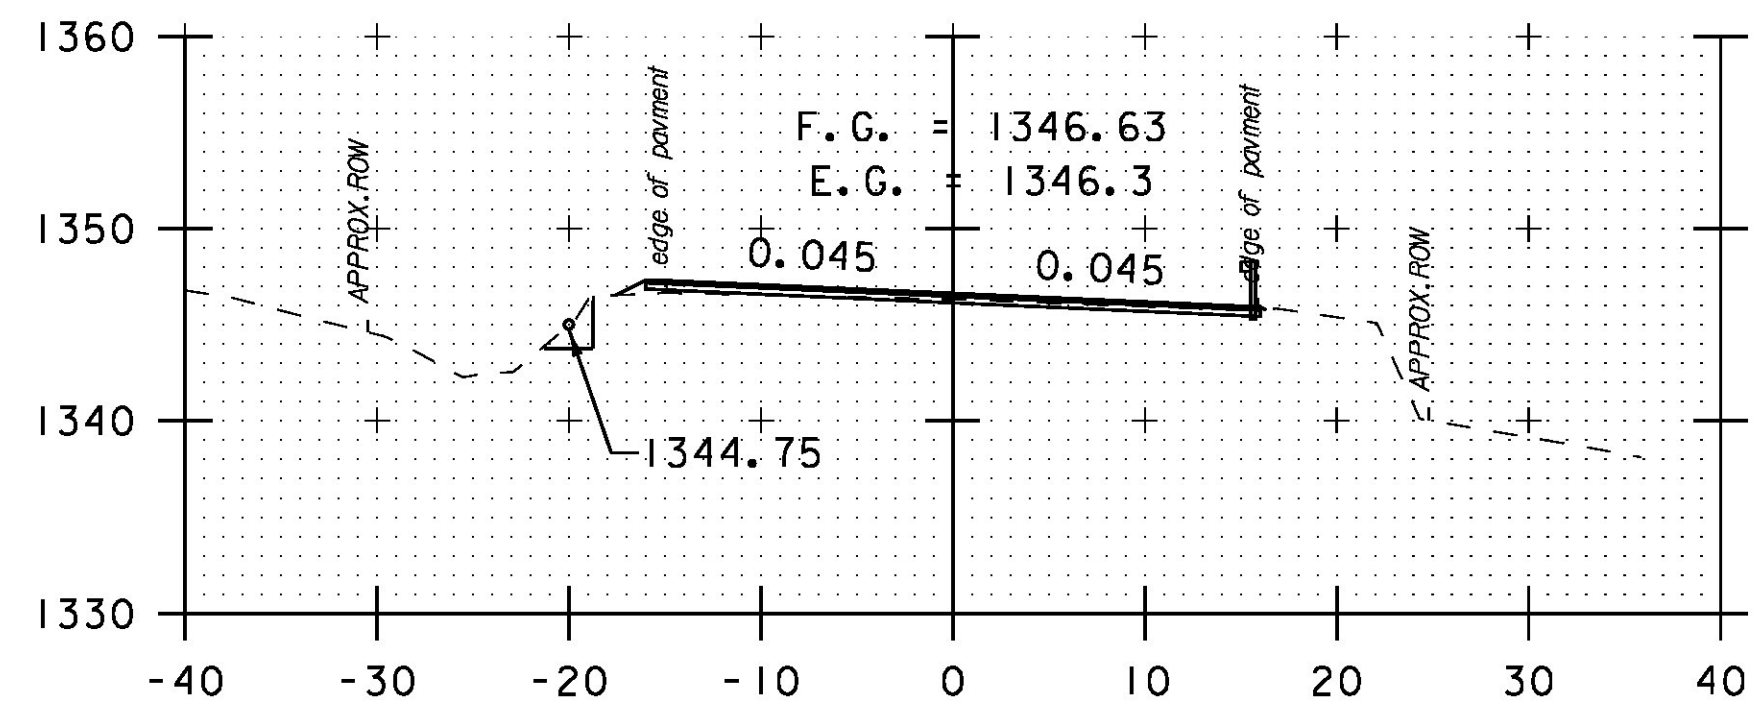


151+00

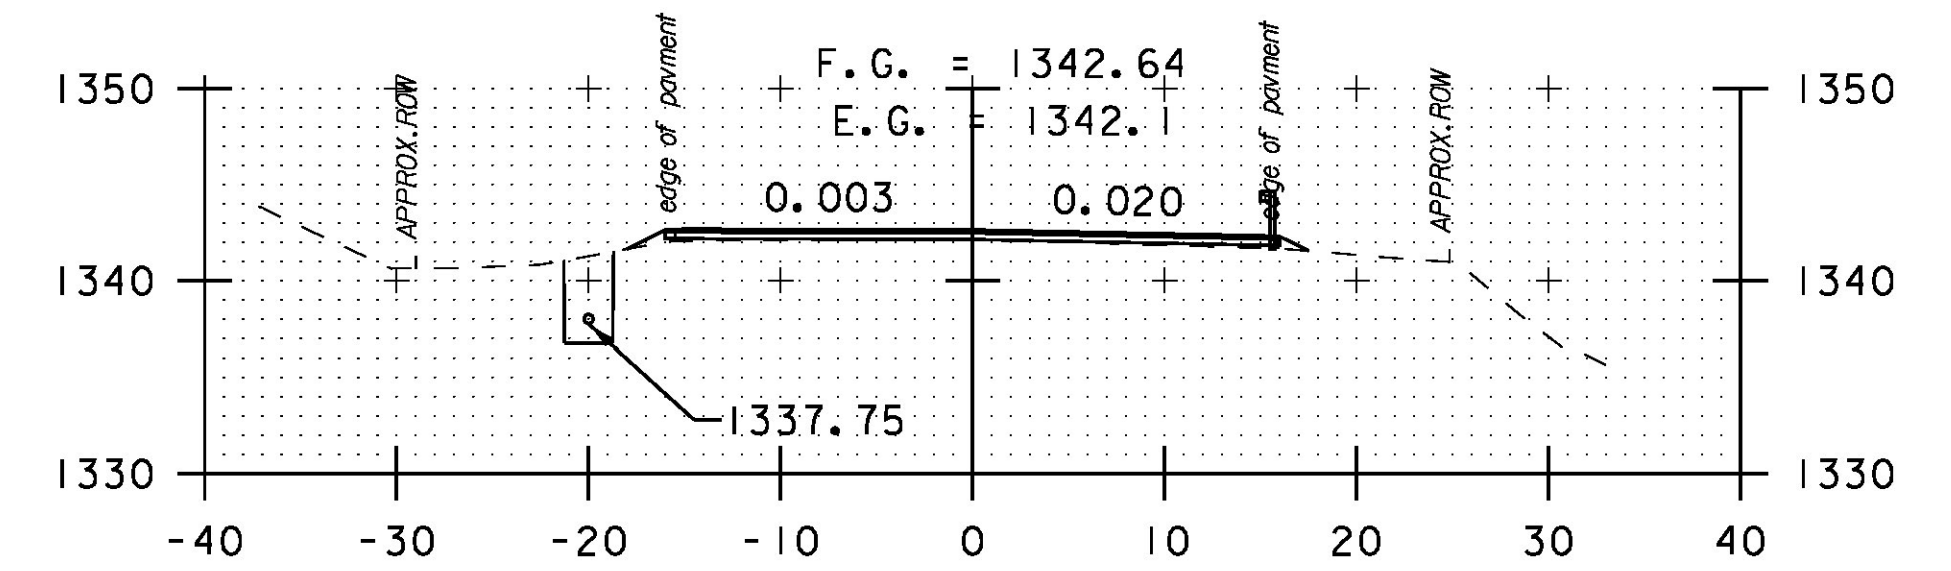


152+00

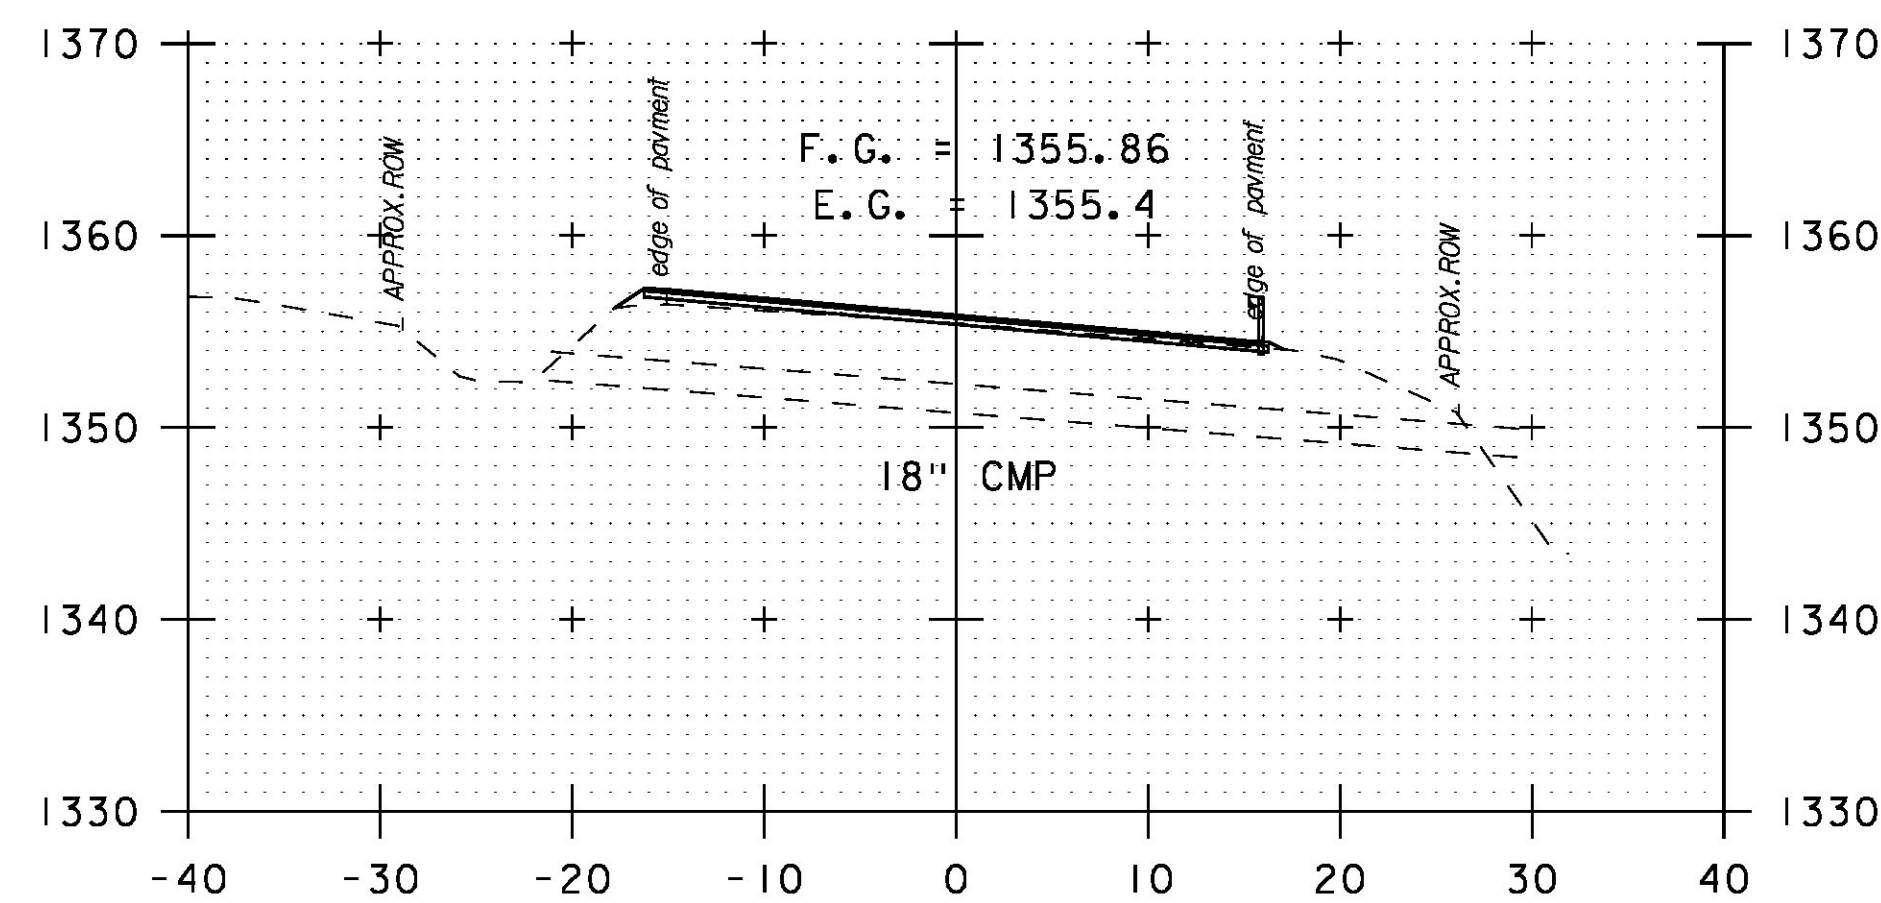

149+49
SKEWED

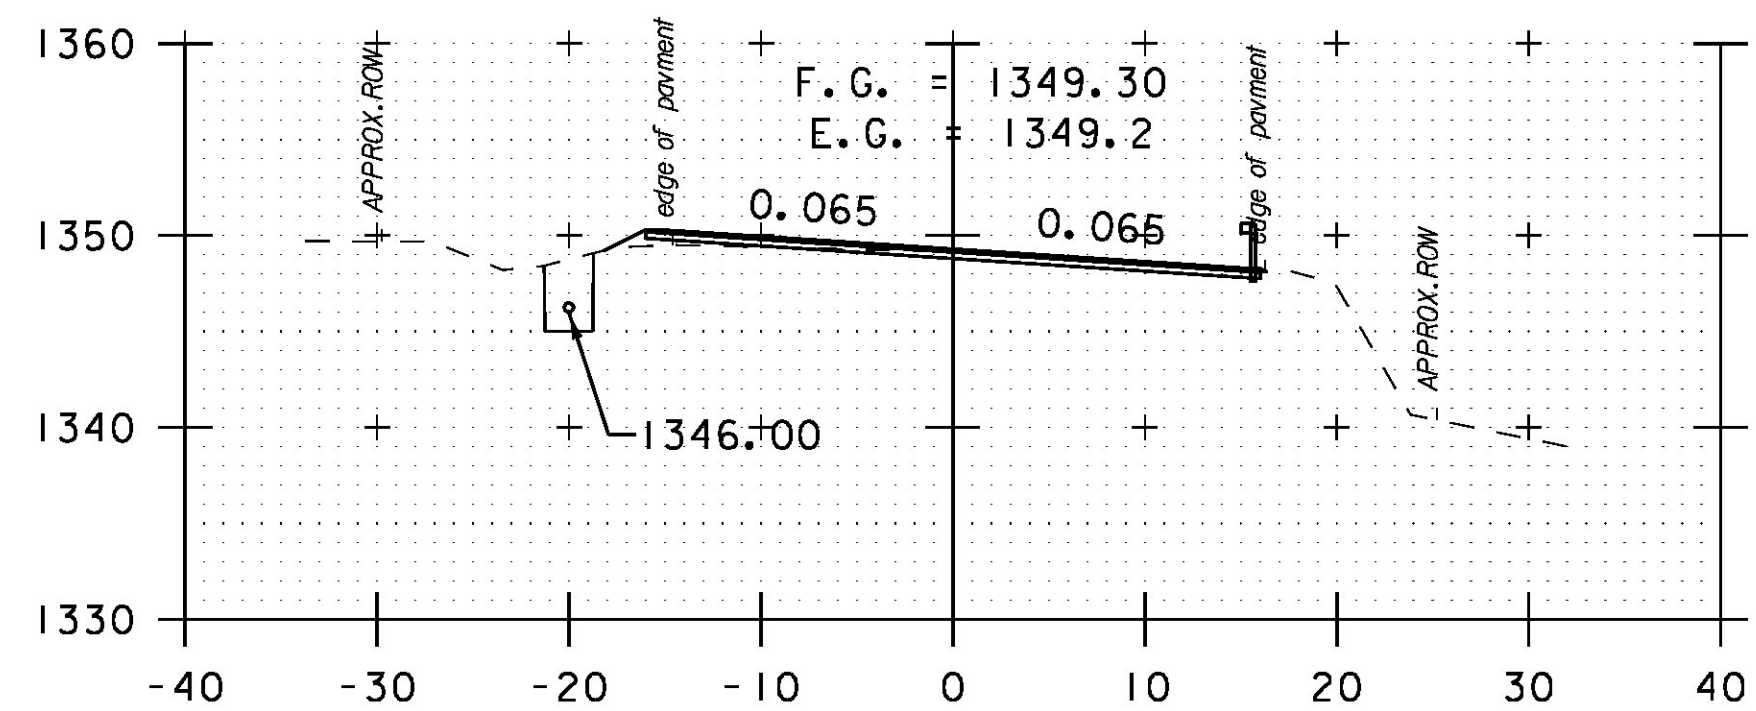

150+50

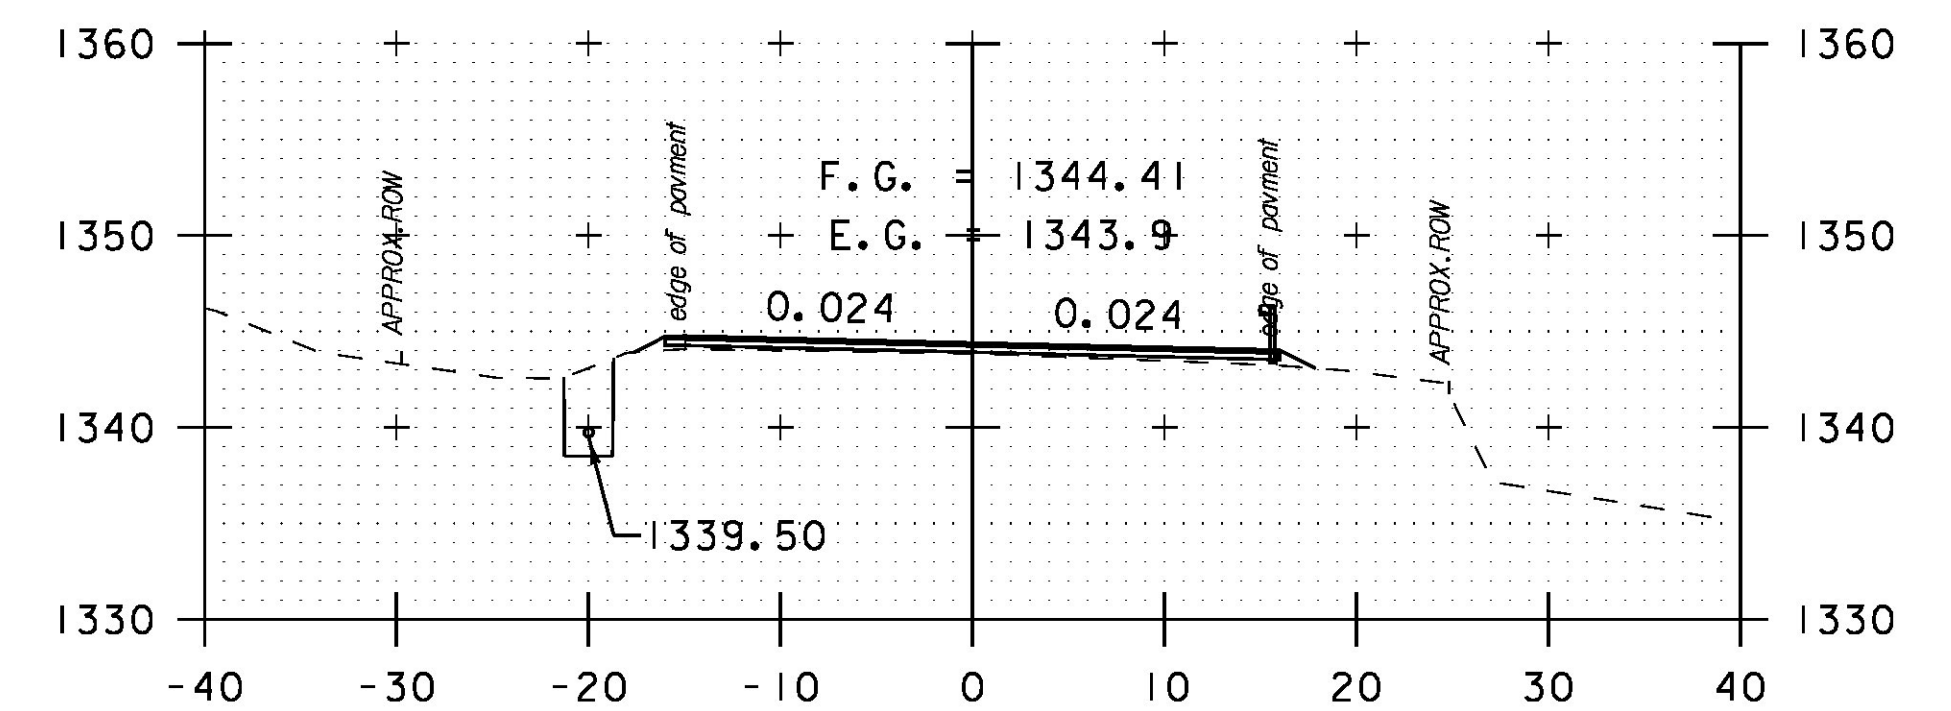

151+50



PROJECT NAME:	HANCOCK	PLOT DATE:	3/18/2015
PROJECT NUMBER:	STP 2923 (1)	DRAWN BY:	B. MARTIN
FILE NAME:	z10c252xs.dgn	DESIGNED BY:	B. MARTIN
PROJECT LEADER:	C. LATHROP	CHECKED BY:	C. LATHROP
CROSS SECTION SHEET	26	SHEET	153 OF 207