


12" STONE FILL, TYPE I (TYP.)  
GRUBBING MATERIAL (6") (TYP.)

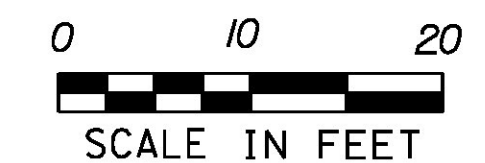

PROJECT NAME: HANCOCK	PLOT DATE: 3/18/2015
PROJECT NUMBER: STP 2923 (1)	DRAWN BY: B. MARTIN
FILE NAME: z10c252xs.dgn	CHECKED BY: C. LATHROP
PROJECT LEADER: C. LATHROP	SHEET 154 OF 207
DESIGNED BY: B. MARTIN	
CROSS SECTION SHEET 27	