




163+00

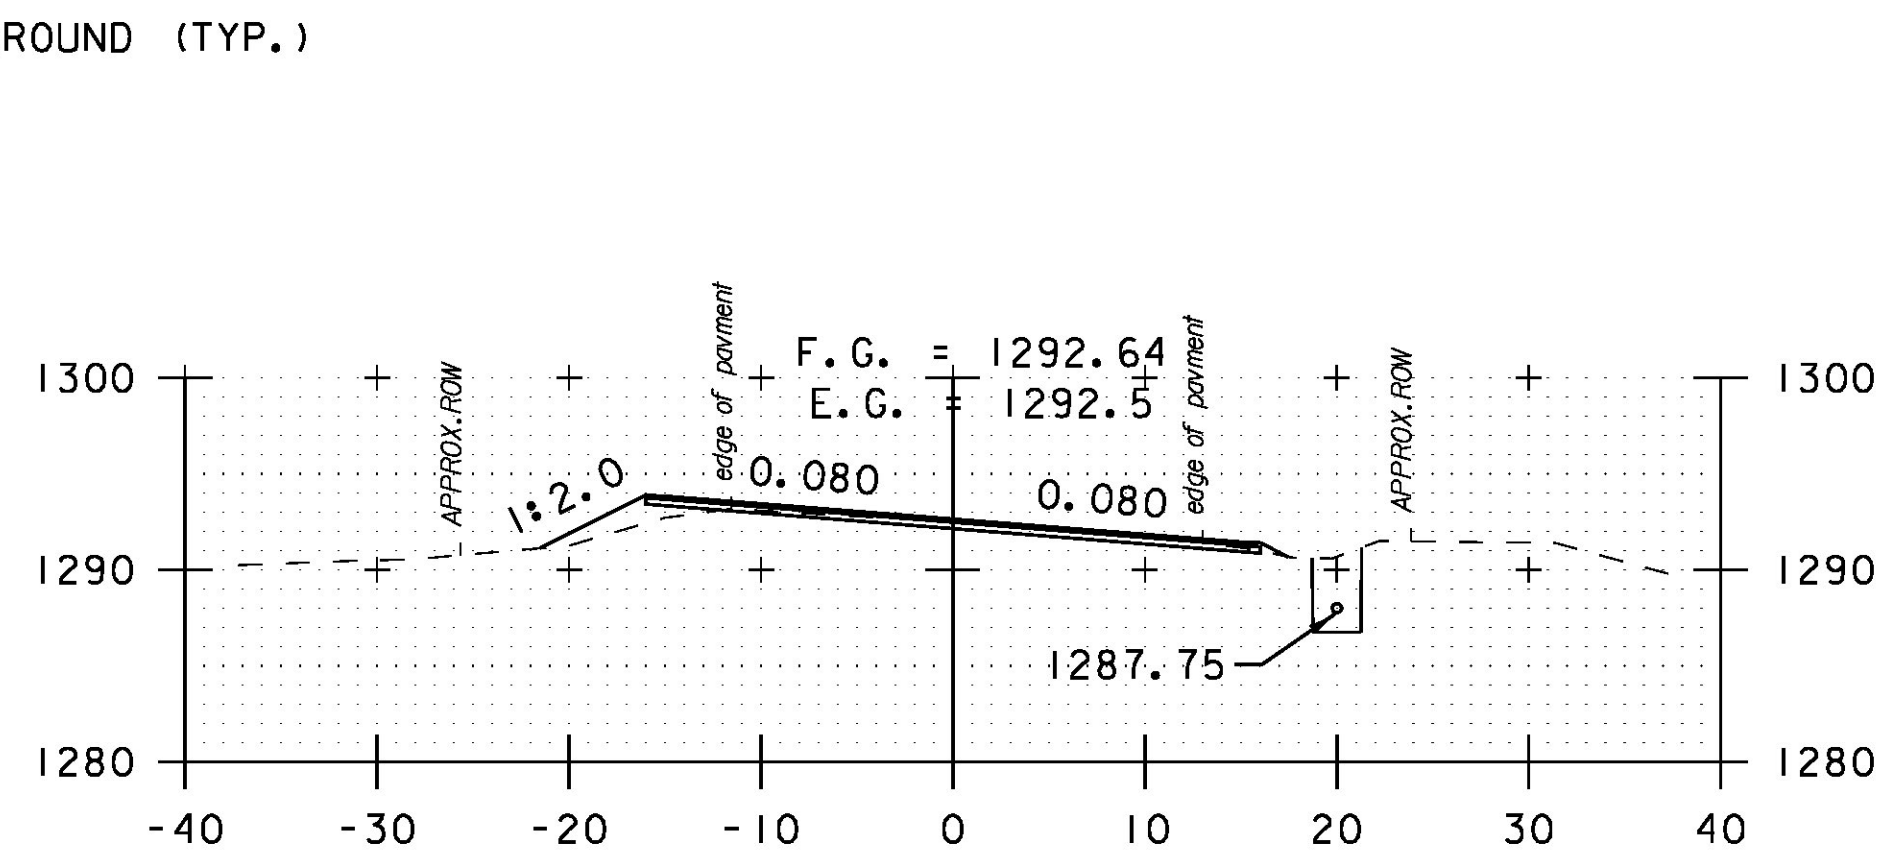


165+00

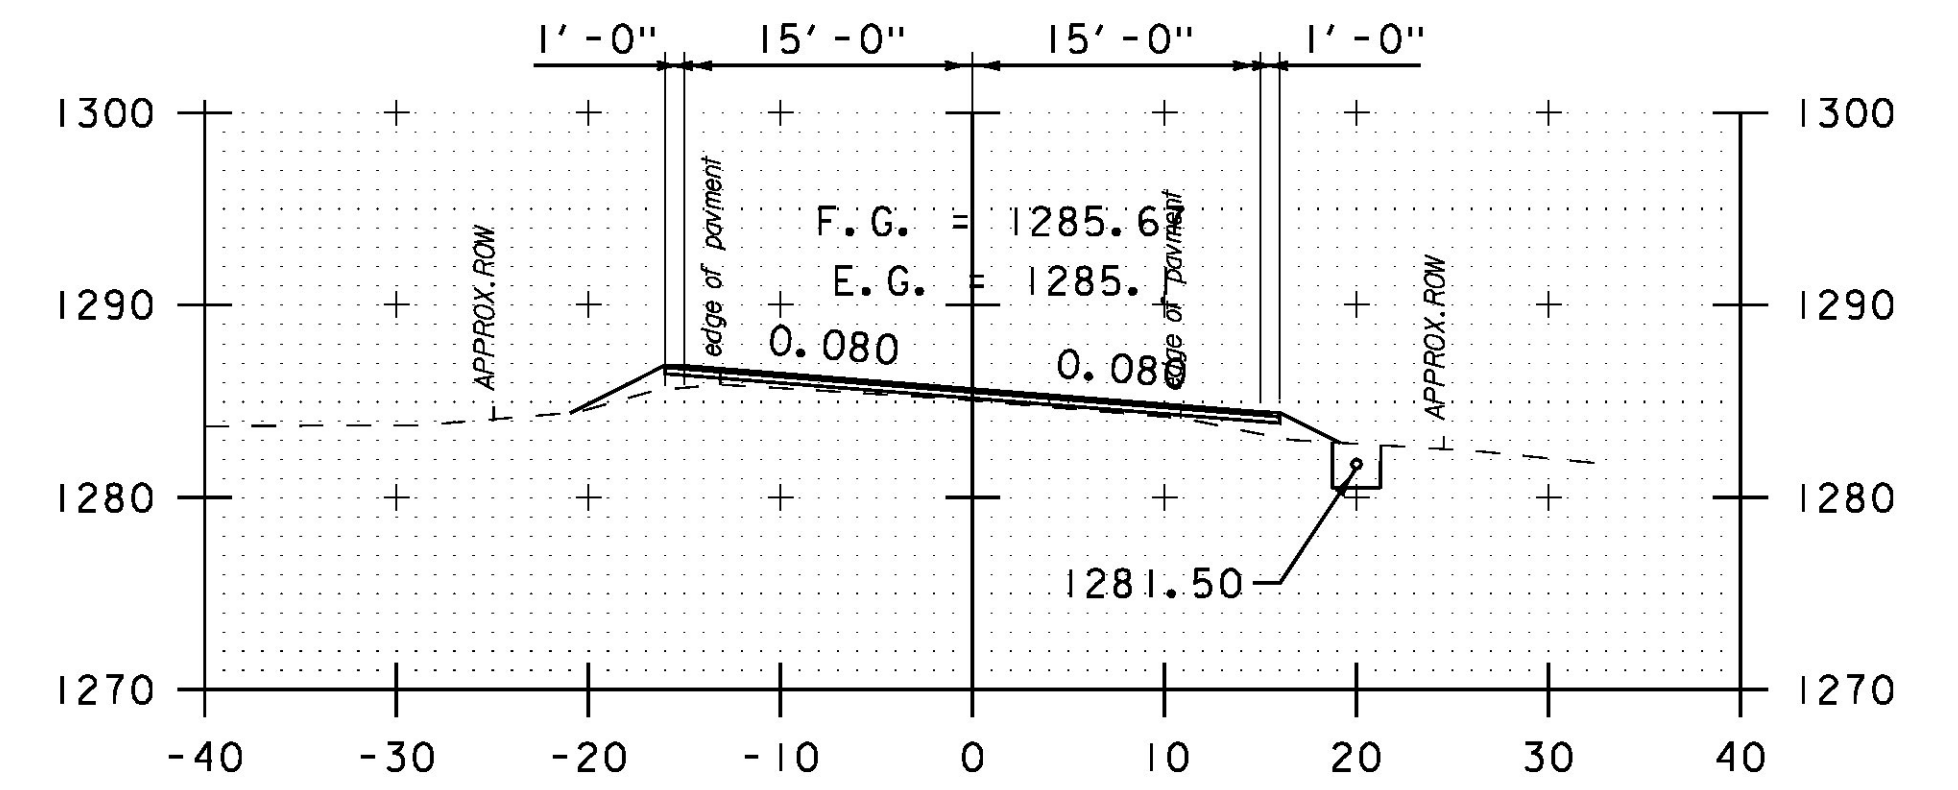


166+50

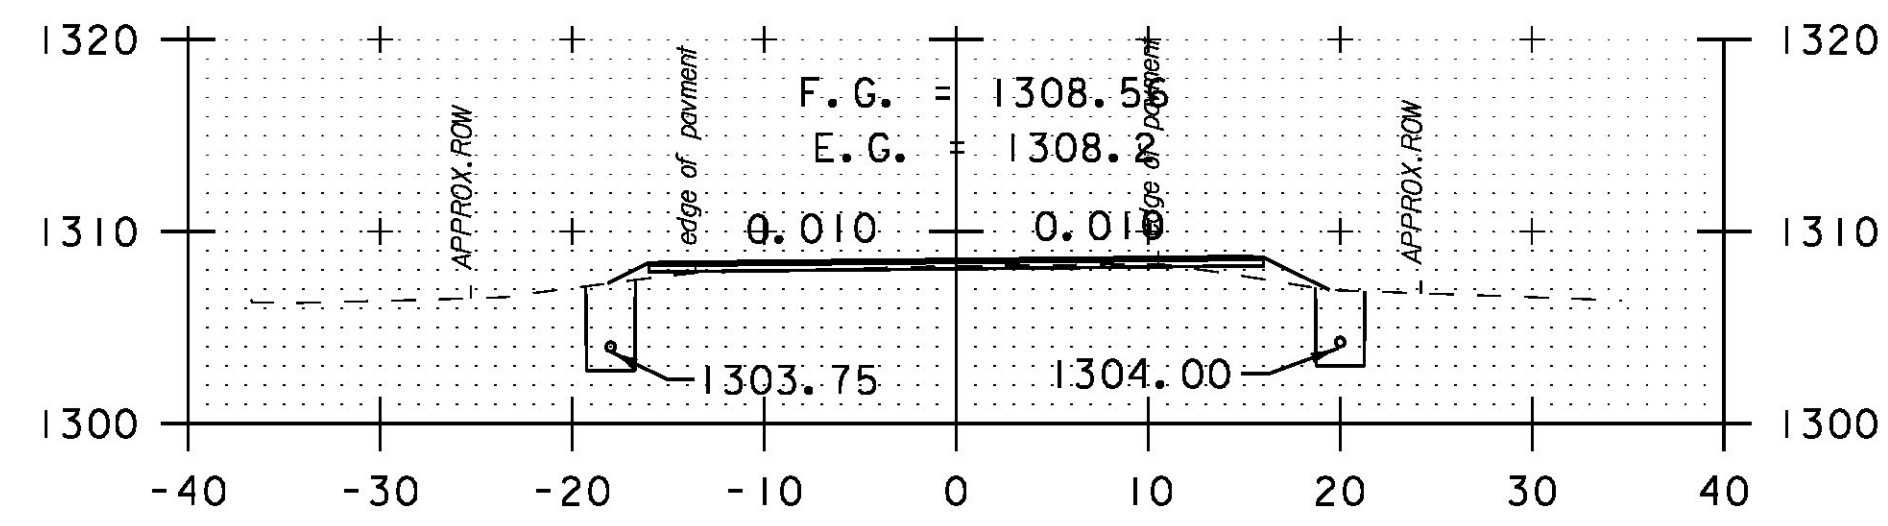


162+50

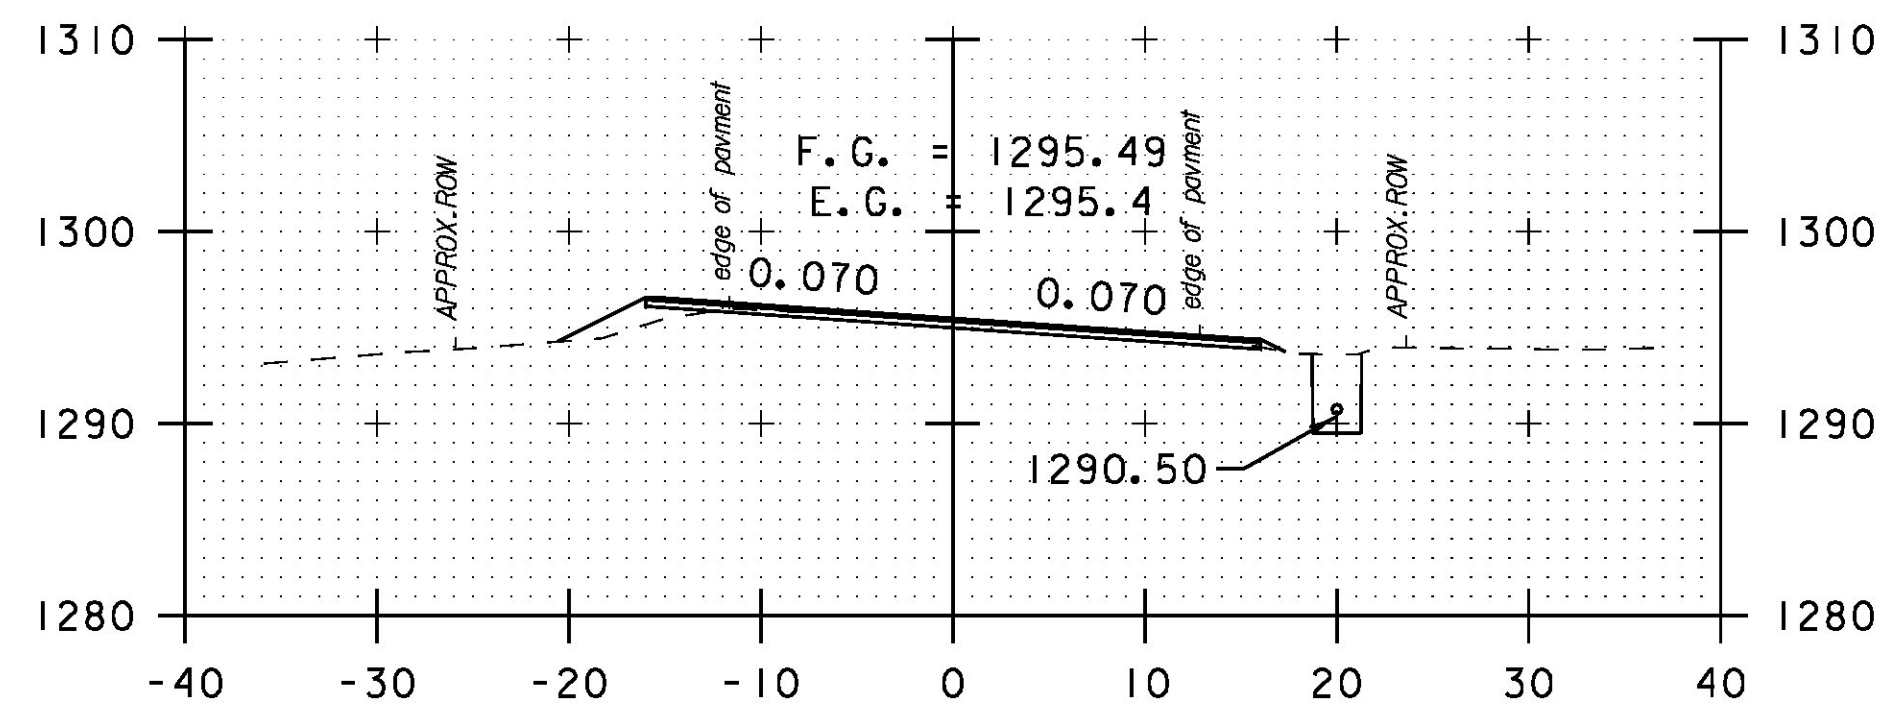


164+50

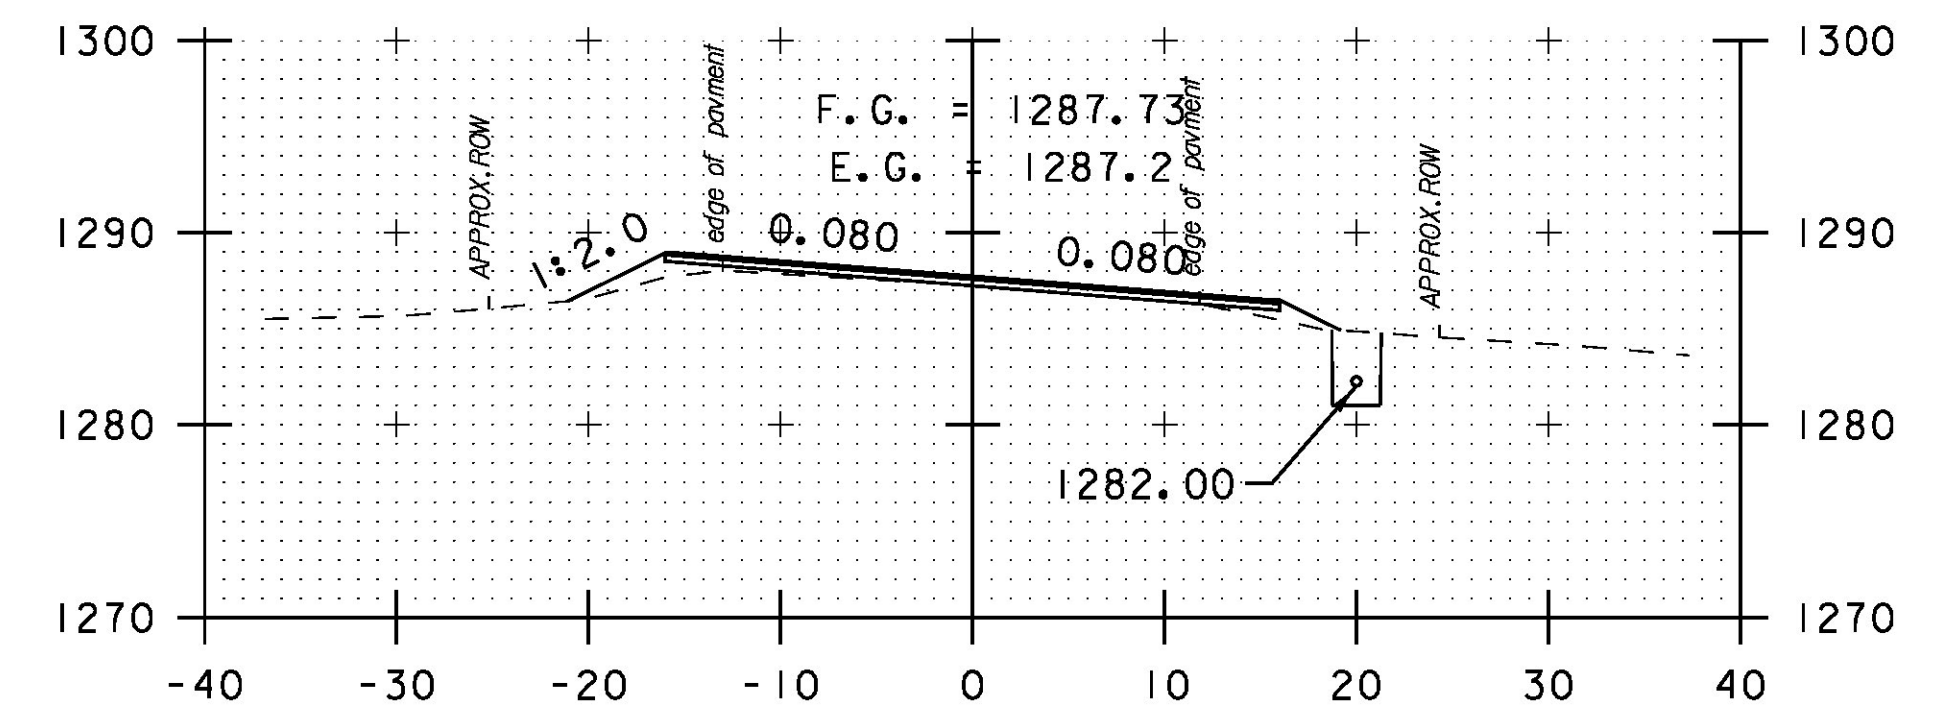


166+00

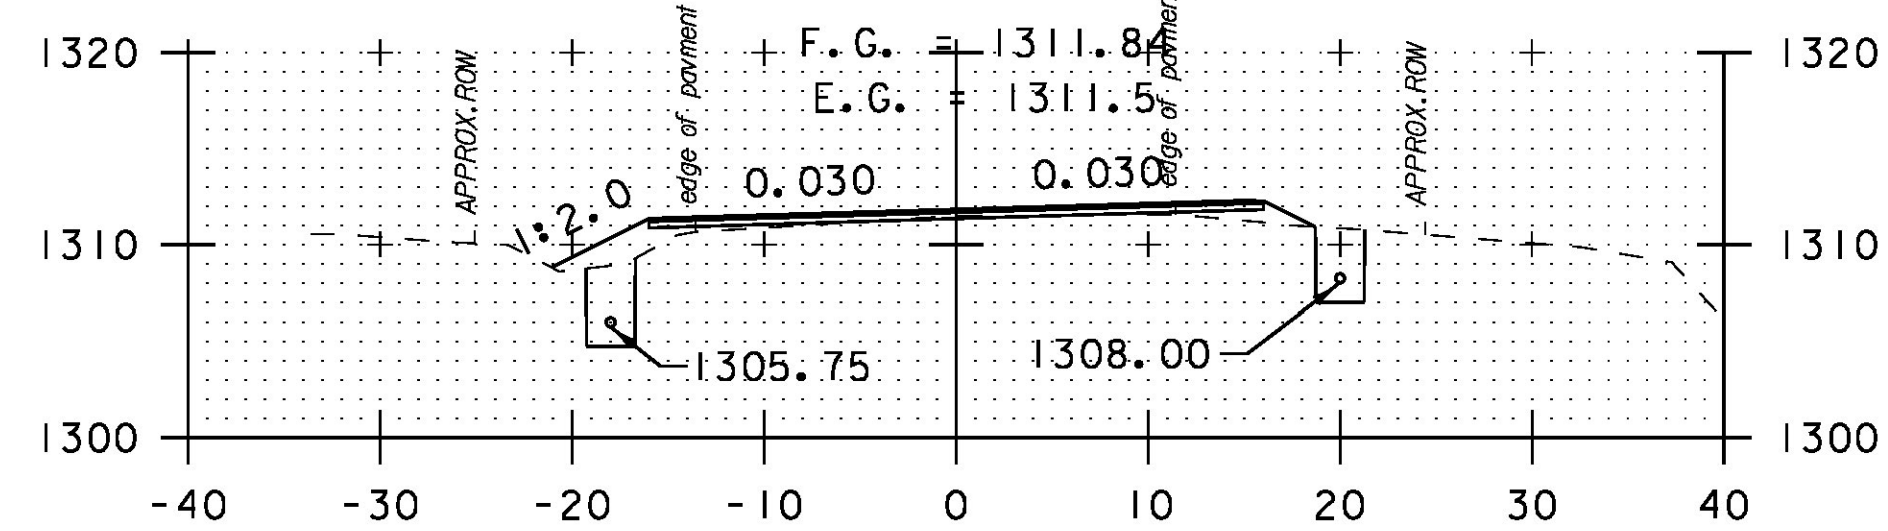


162+00

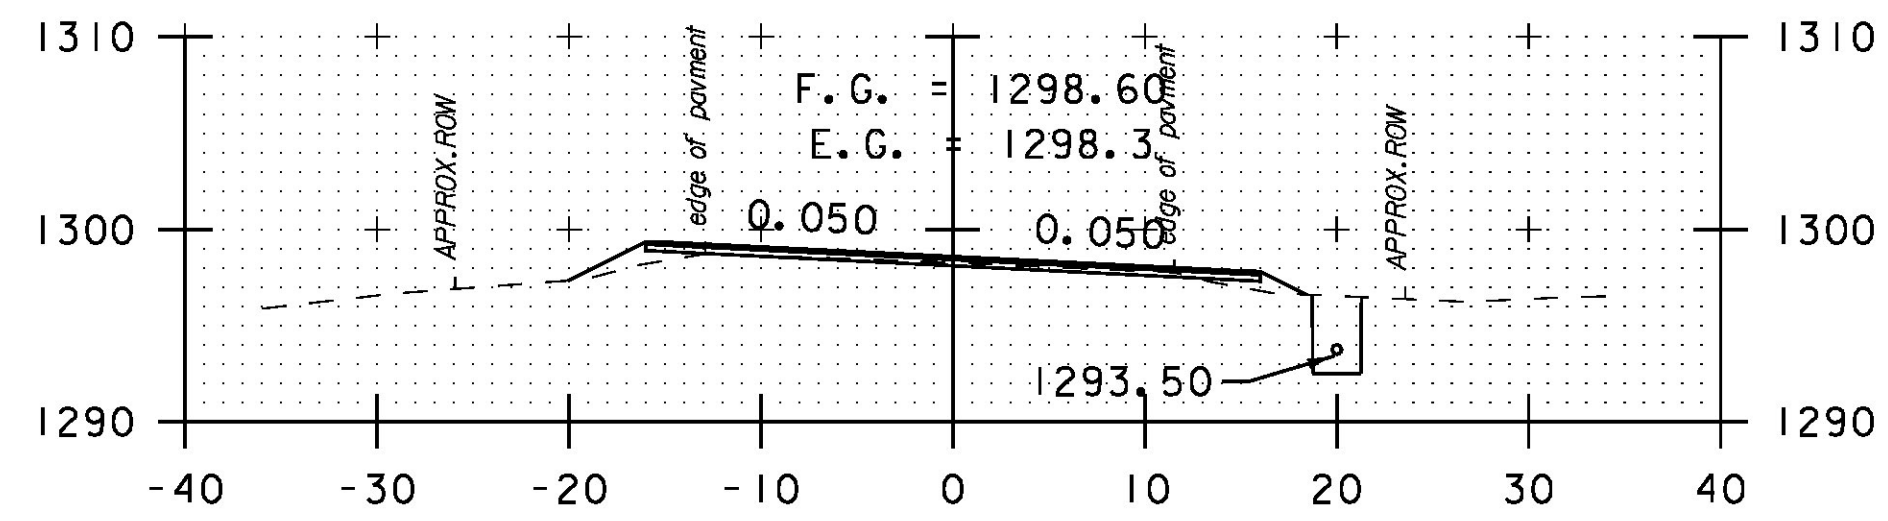


164+00

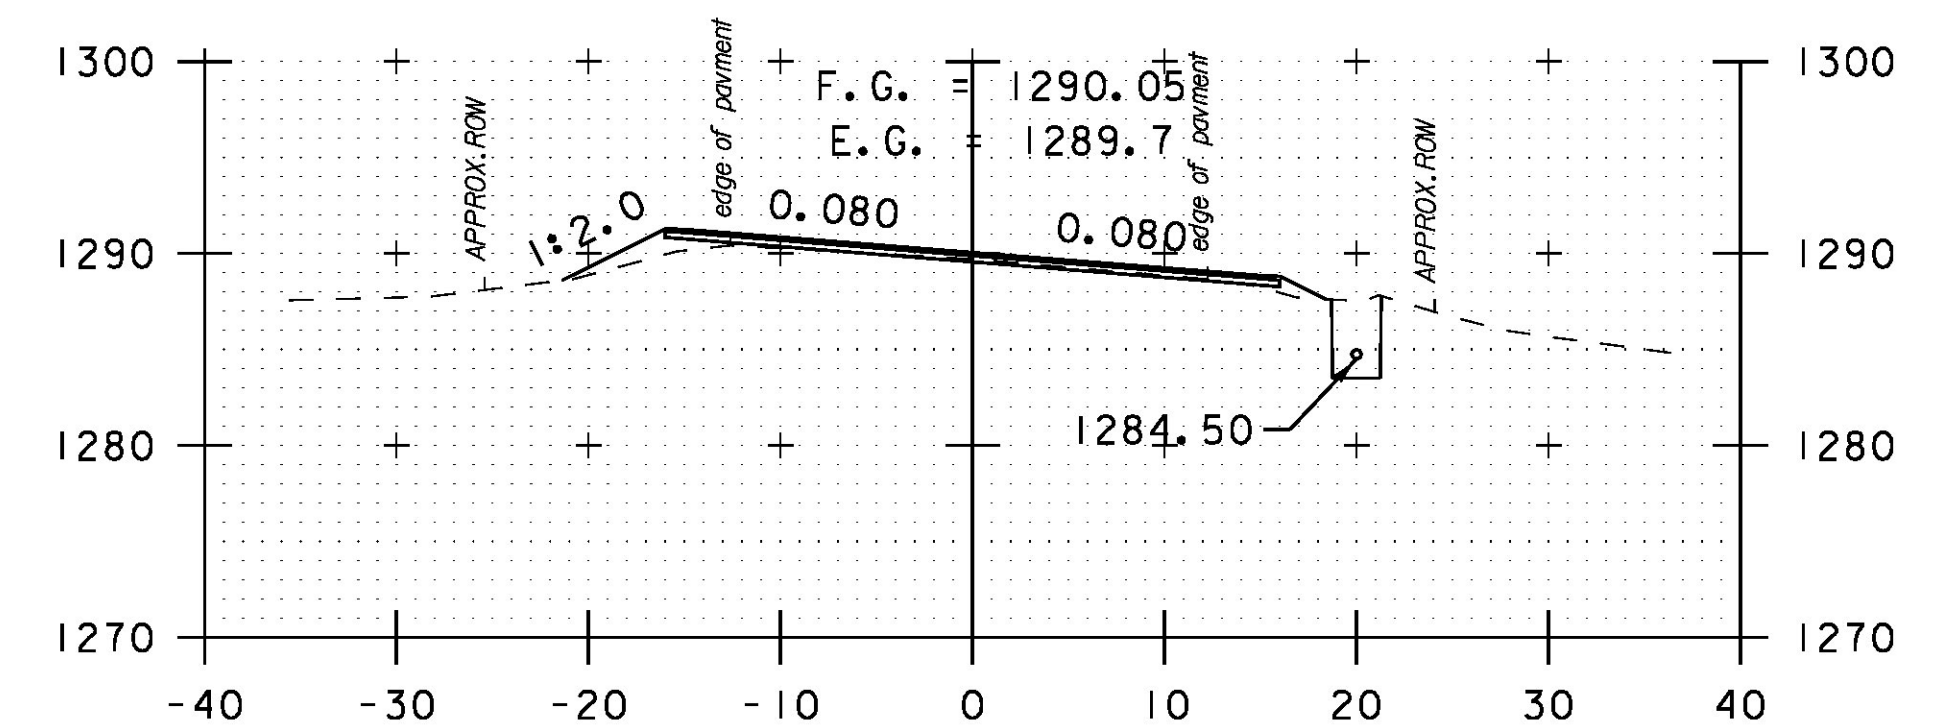

165+50

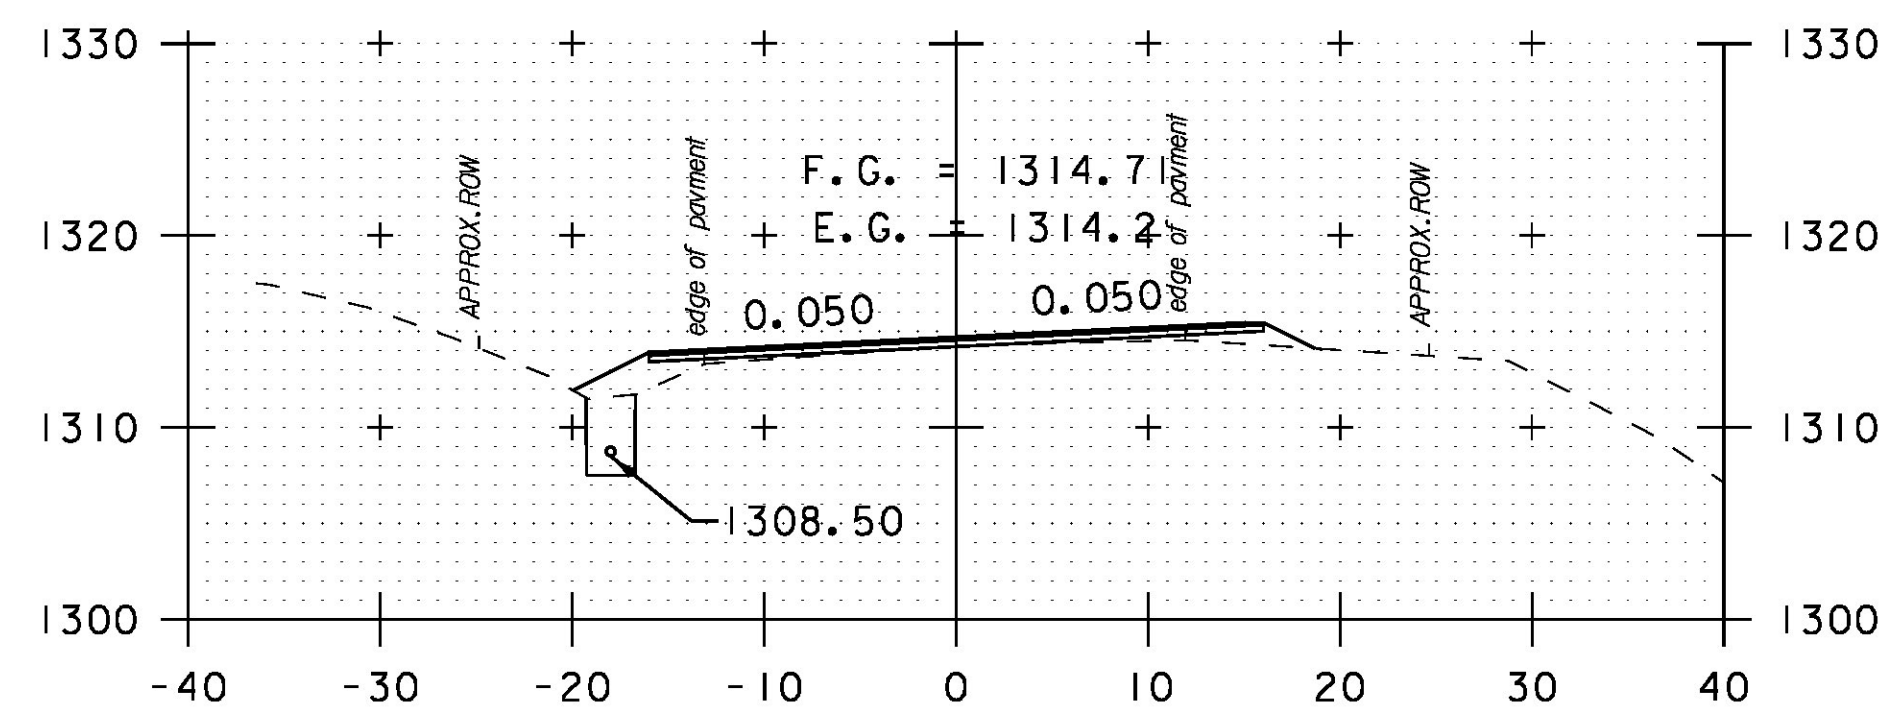

161+50

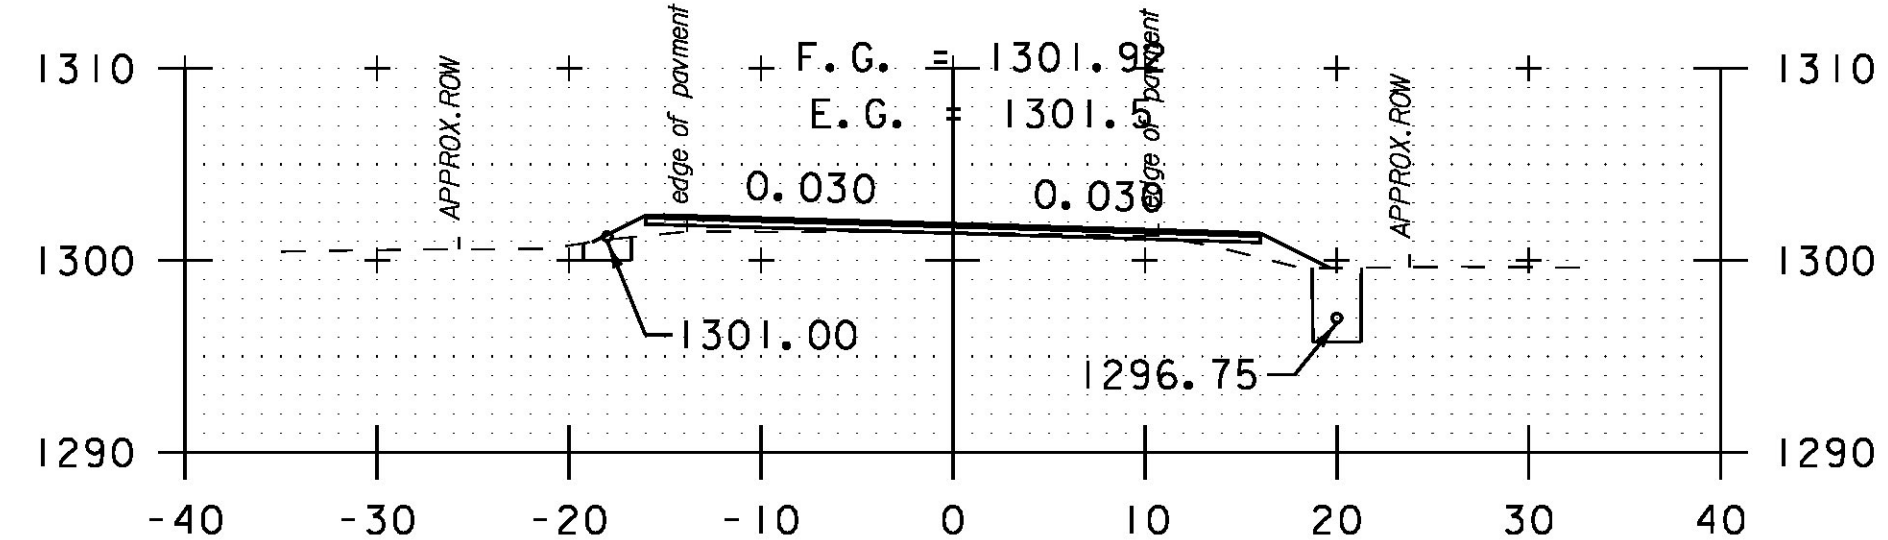

163+50



PROJECT NAME: HANCOCK
PROJECT NUMBER: STP 2923 (1)

FILE NAME: z10c252xs.dgn
PROJECT LEADER: C. LATHROP
DESIGNED BY: B. MARTIN
CROSS SECTION SHEET 29

PLOT DATE: 3/18/2015
DRAWN BY: B. MARTIN
CHECKED BY: C. LATHROP
SHEET 156 OF 207