




168+50

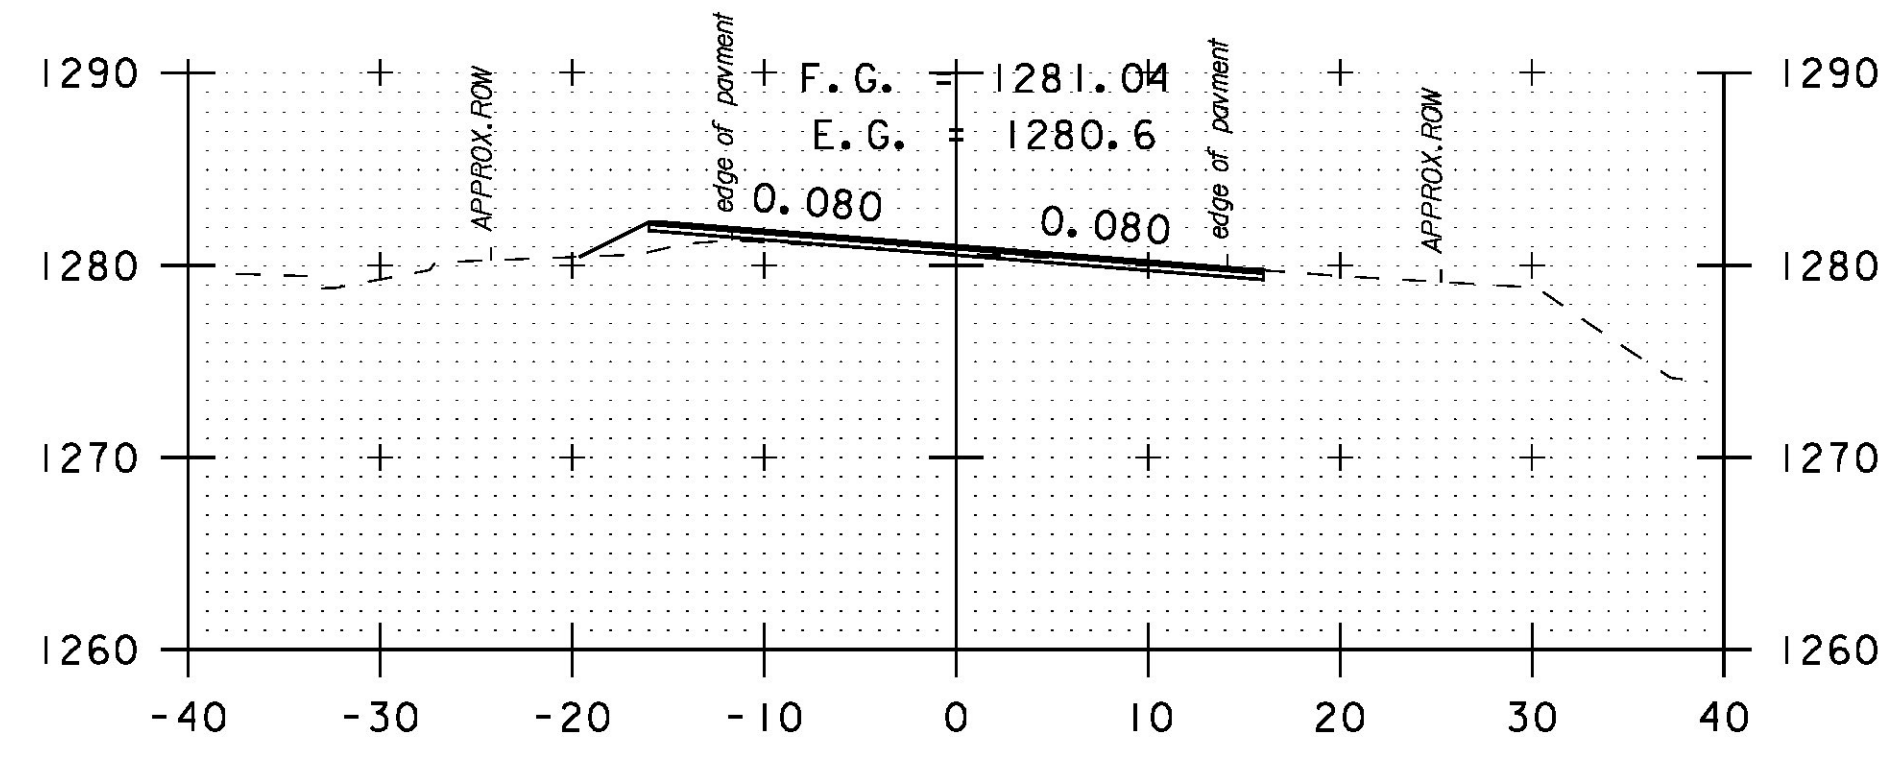


168+00

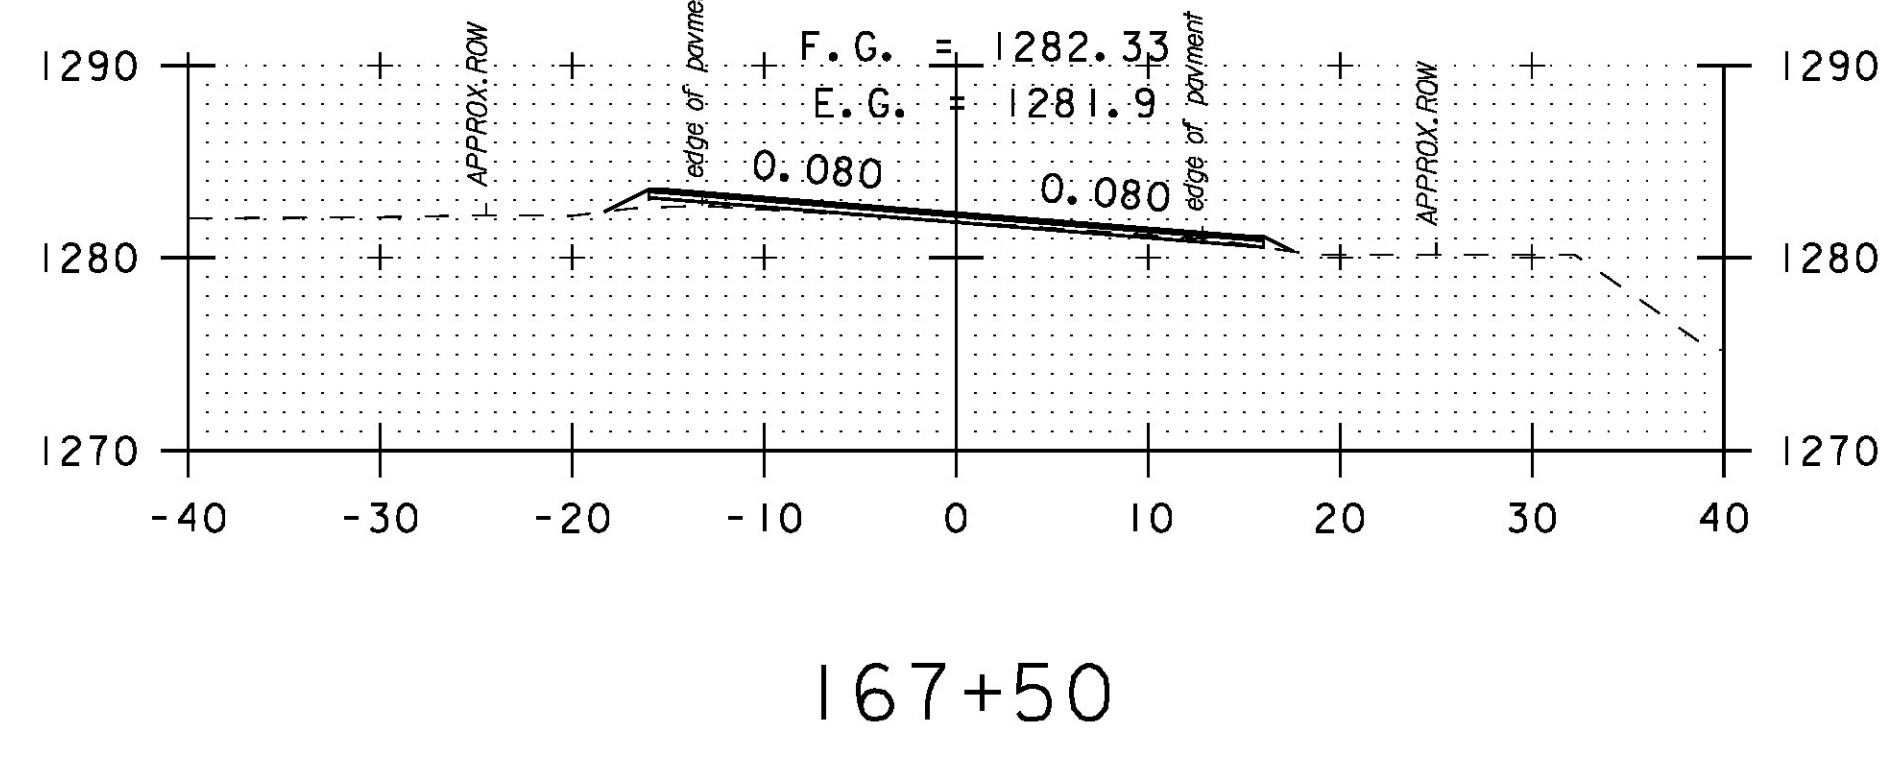


167+50

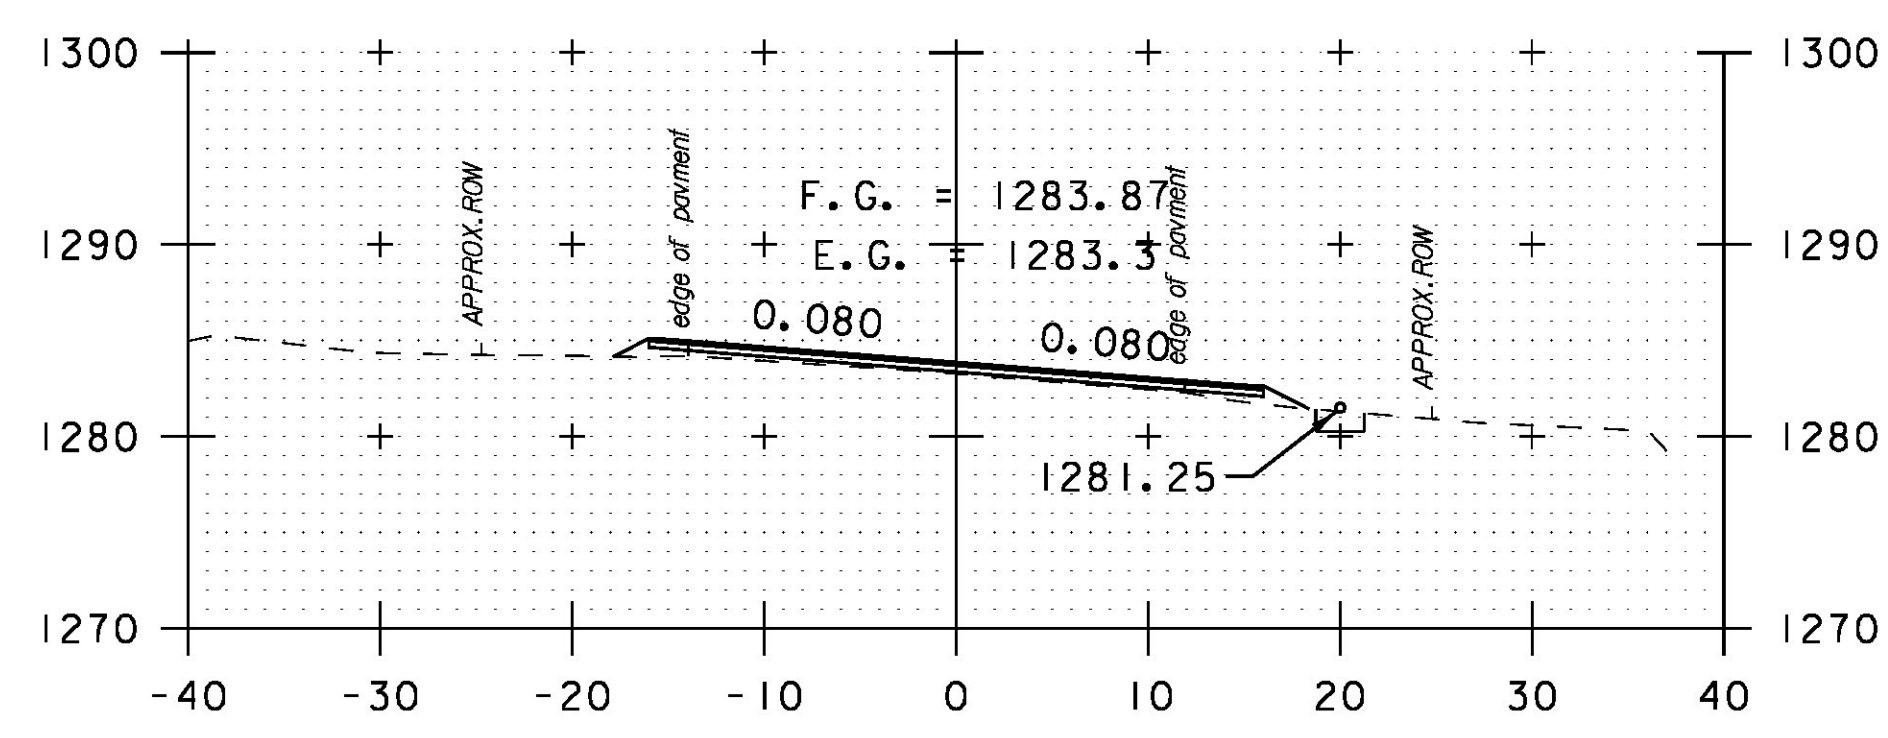


167+00
FIELD DRIVE LT

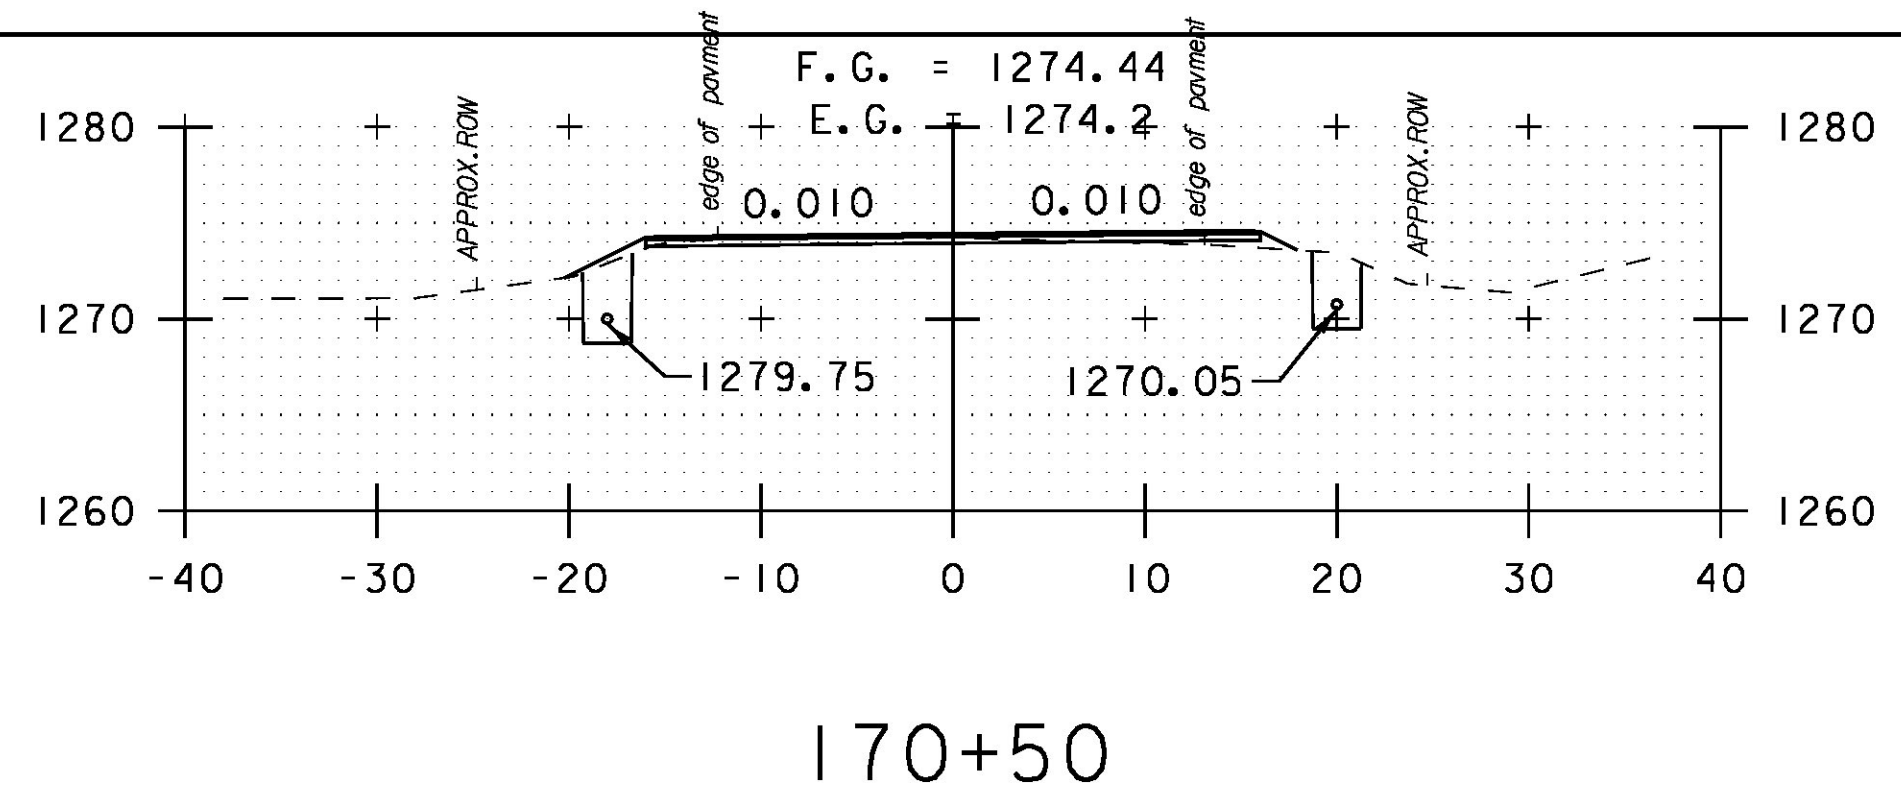


170+50

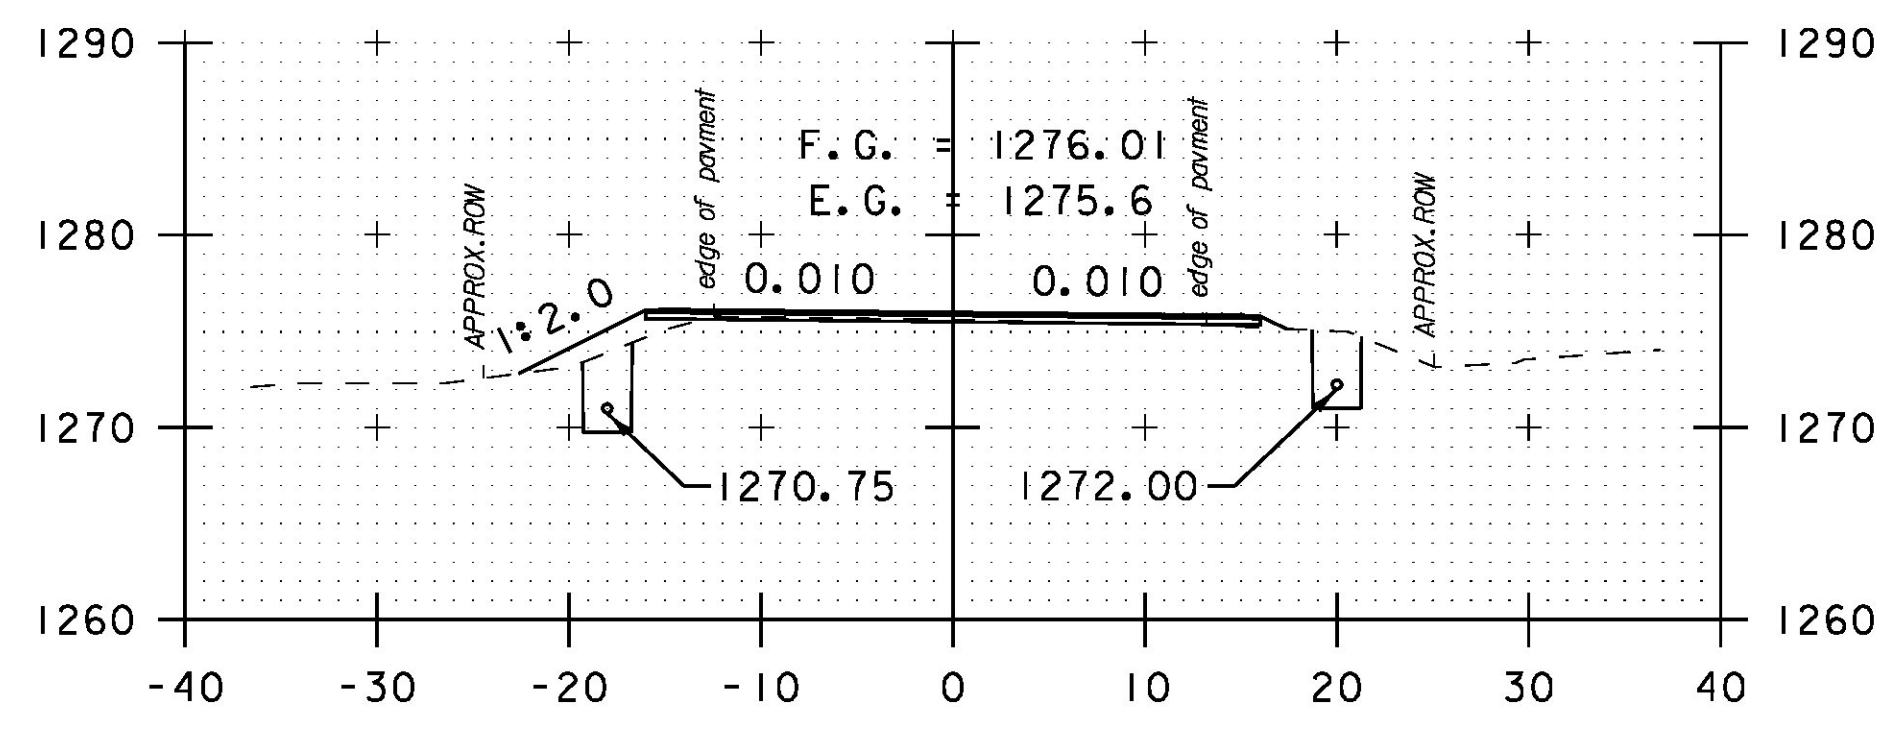


170+00

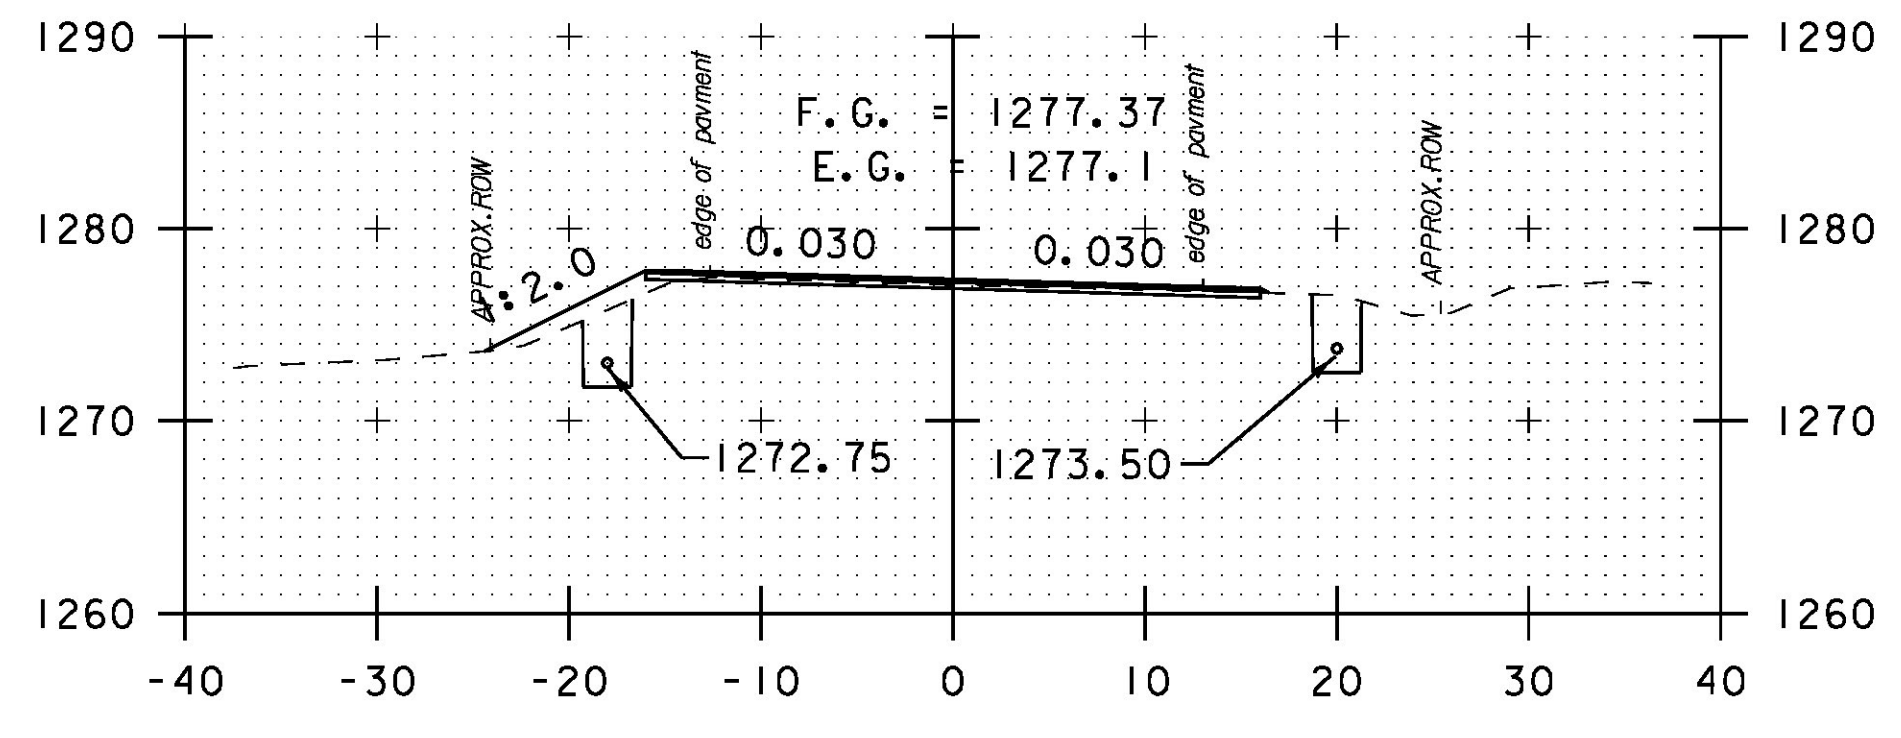


169+50

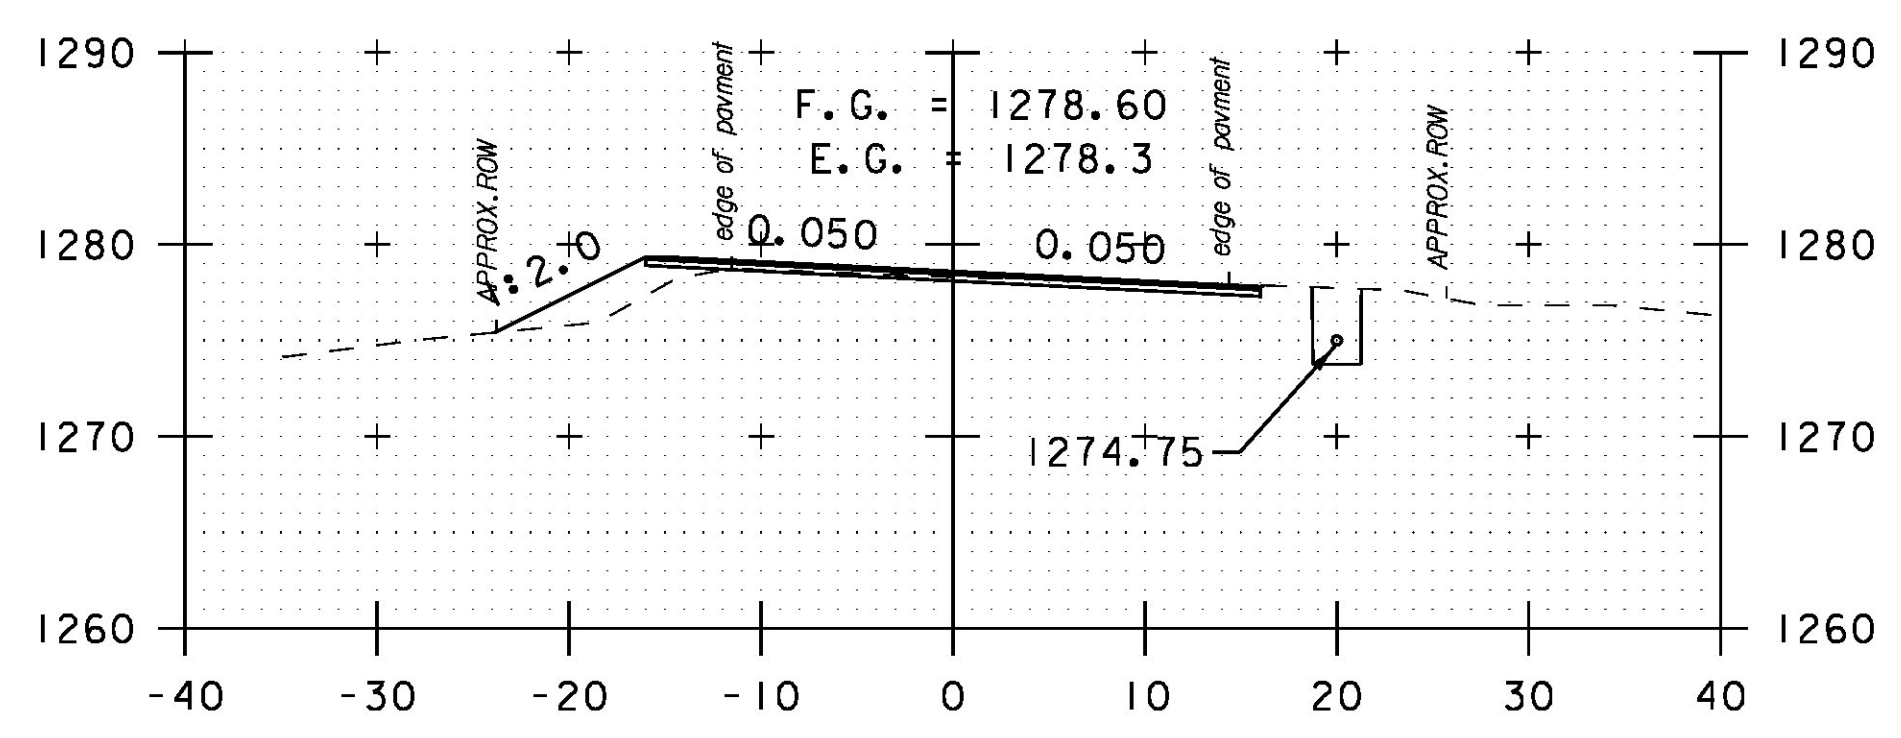


169+00

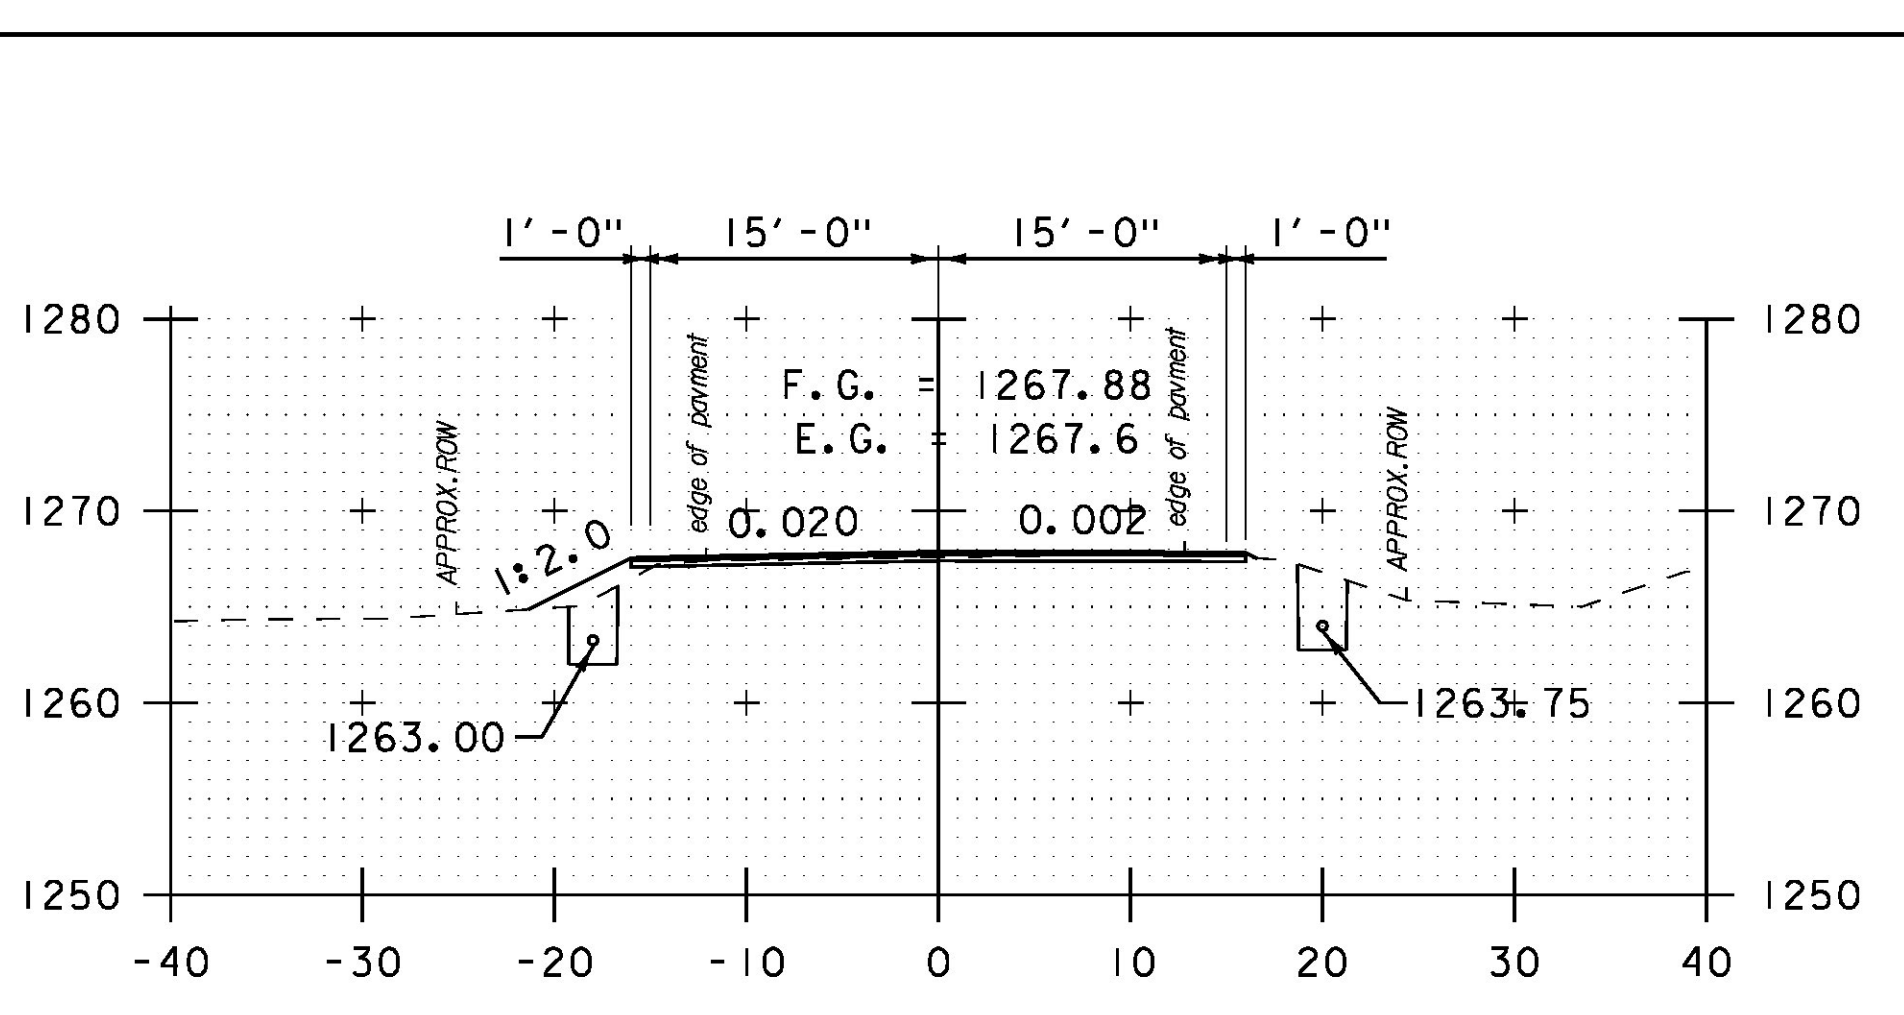


172+50

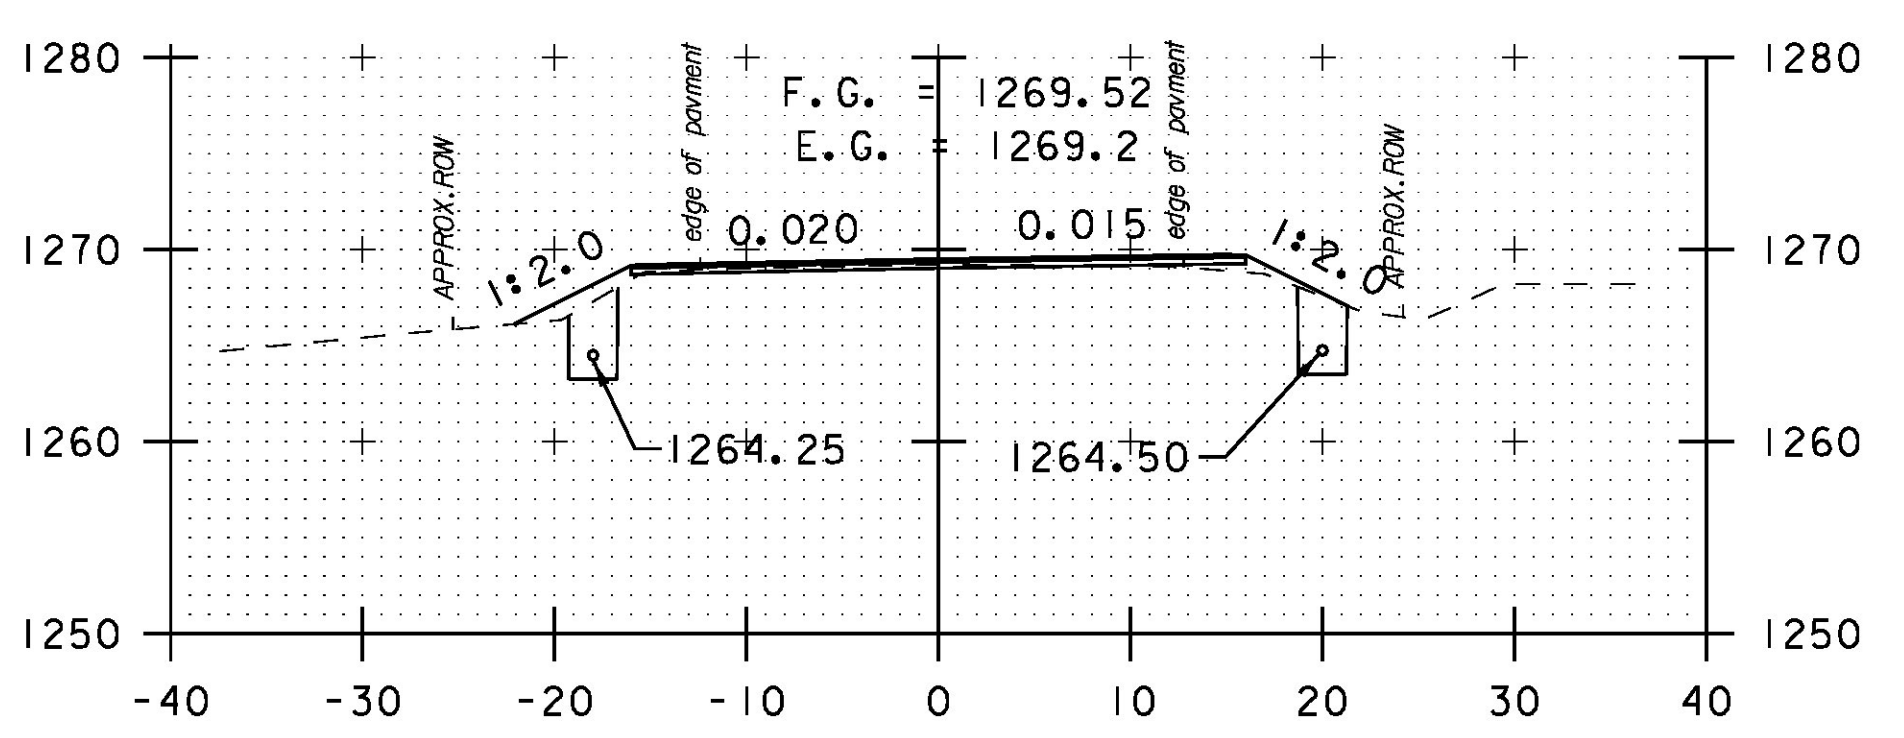

172+00

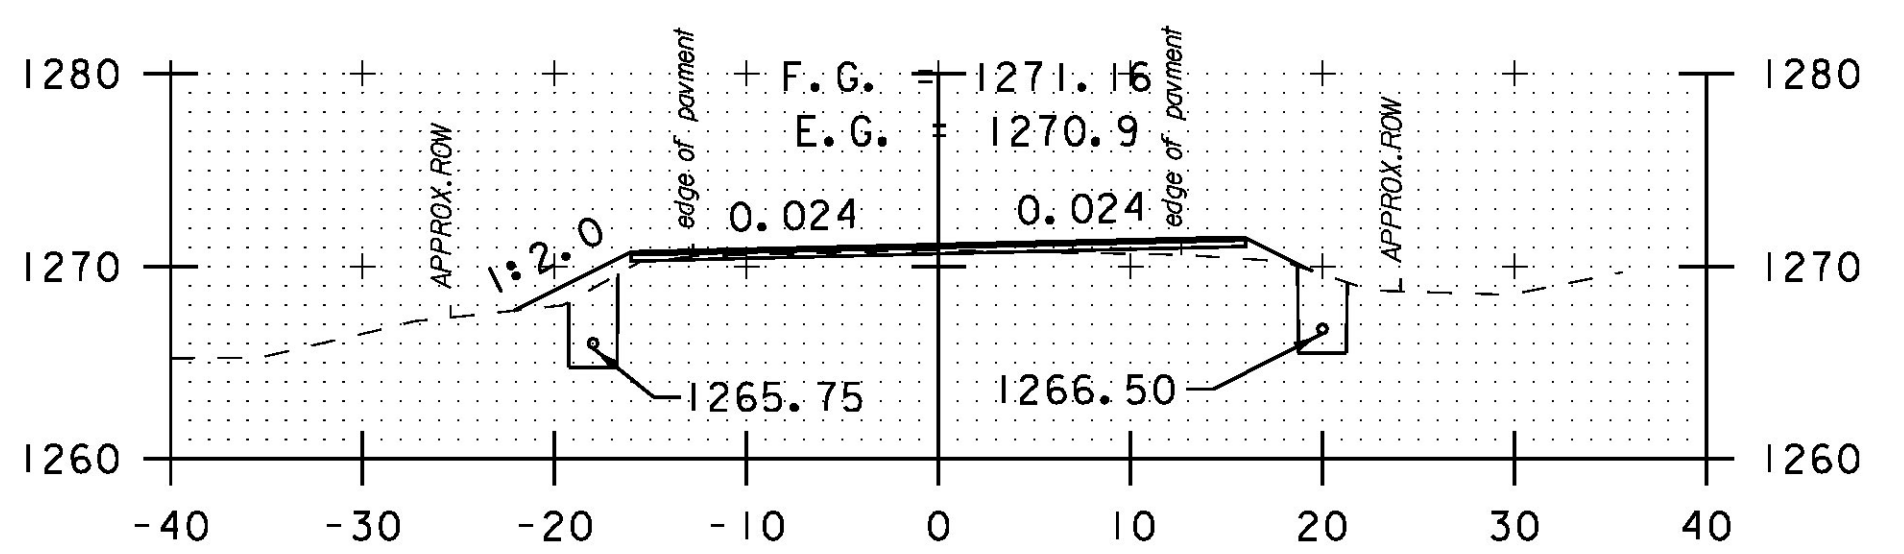

171+50

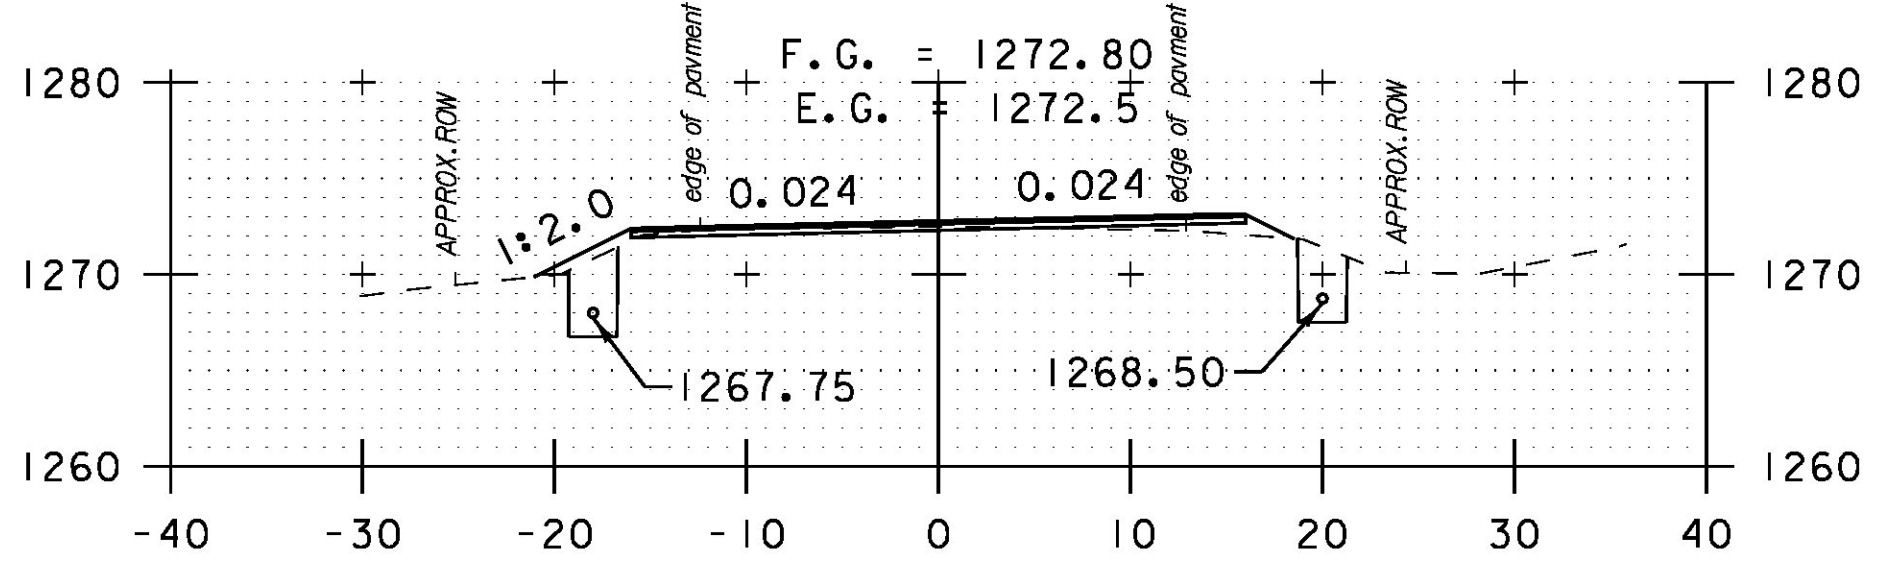

171+00



PROJECT NAME:	HANCOCK	PLOT DATE:	3/18/2015
PROJECT NUMBER:	STP 2923 (1)	DRAWN BY:	B. MARTIN
FILE NAME:	z10c252xs.dgn	CHECKED BY:	C. LATHROP
PROJECT LEADER:	C. LATHROP	CROSS SECTION SHEET	30
DESIGNED BY:	B. MARTIN	SHEET	157 OF 207