




179+00

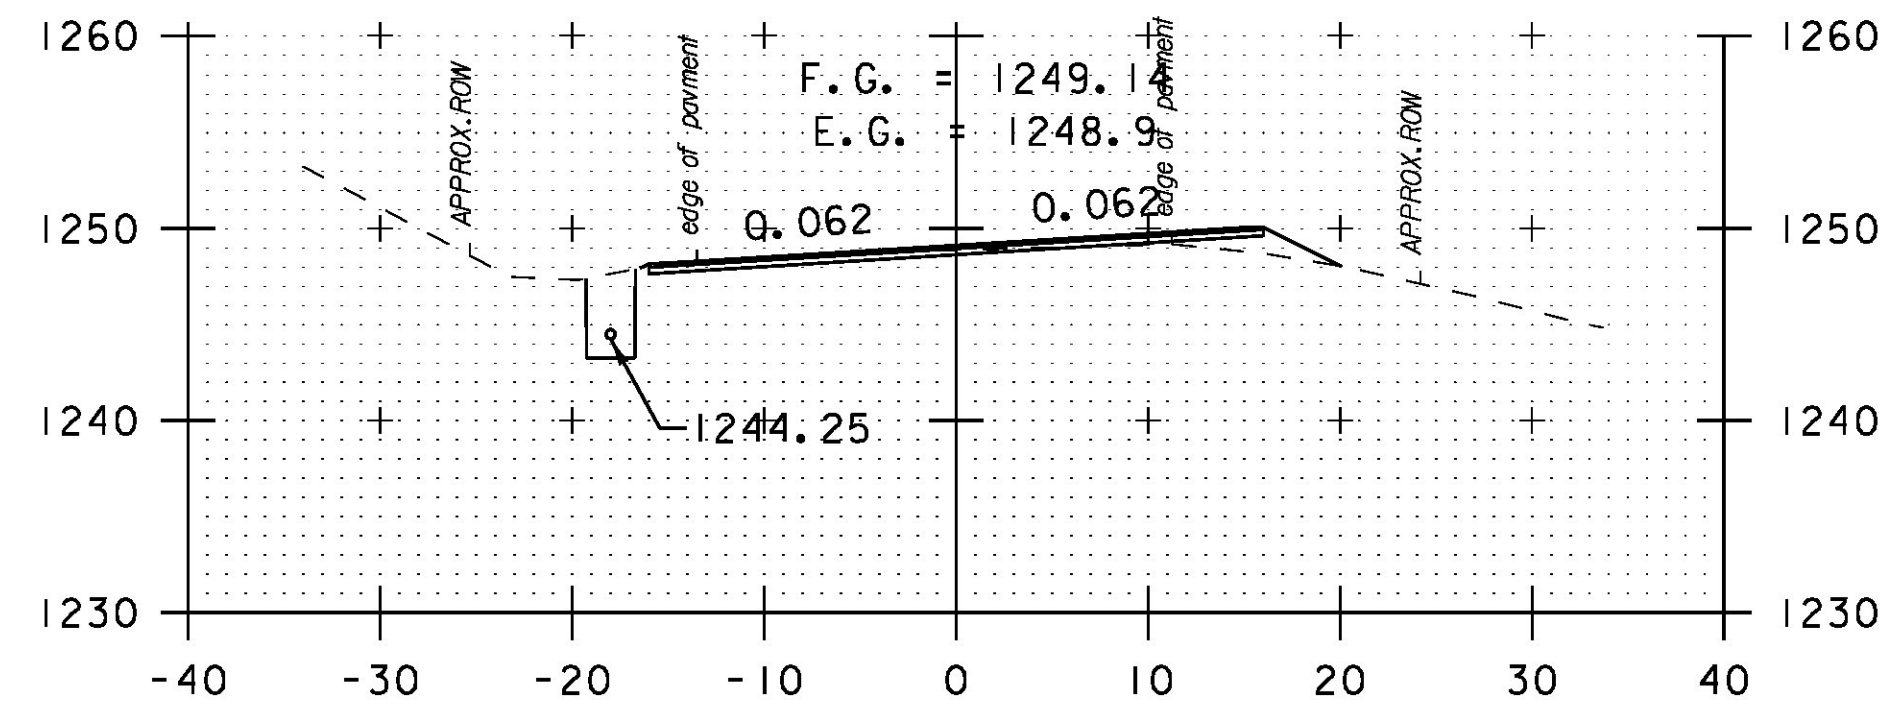


178+50

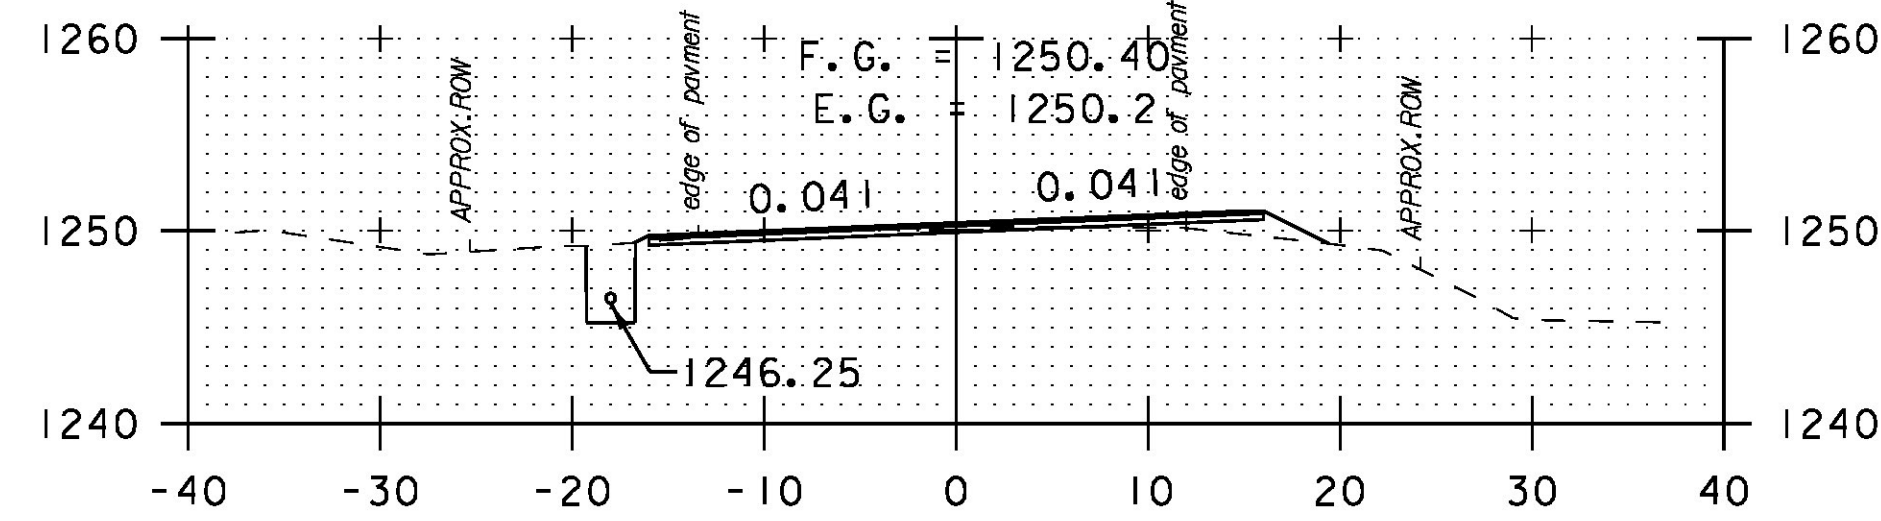


178+00

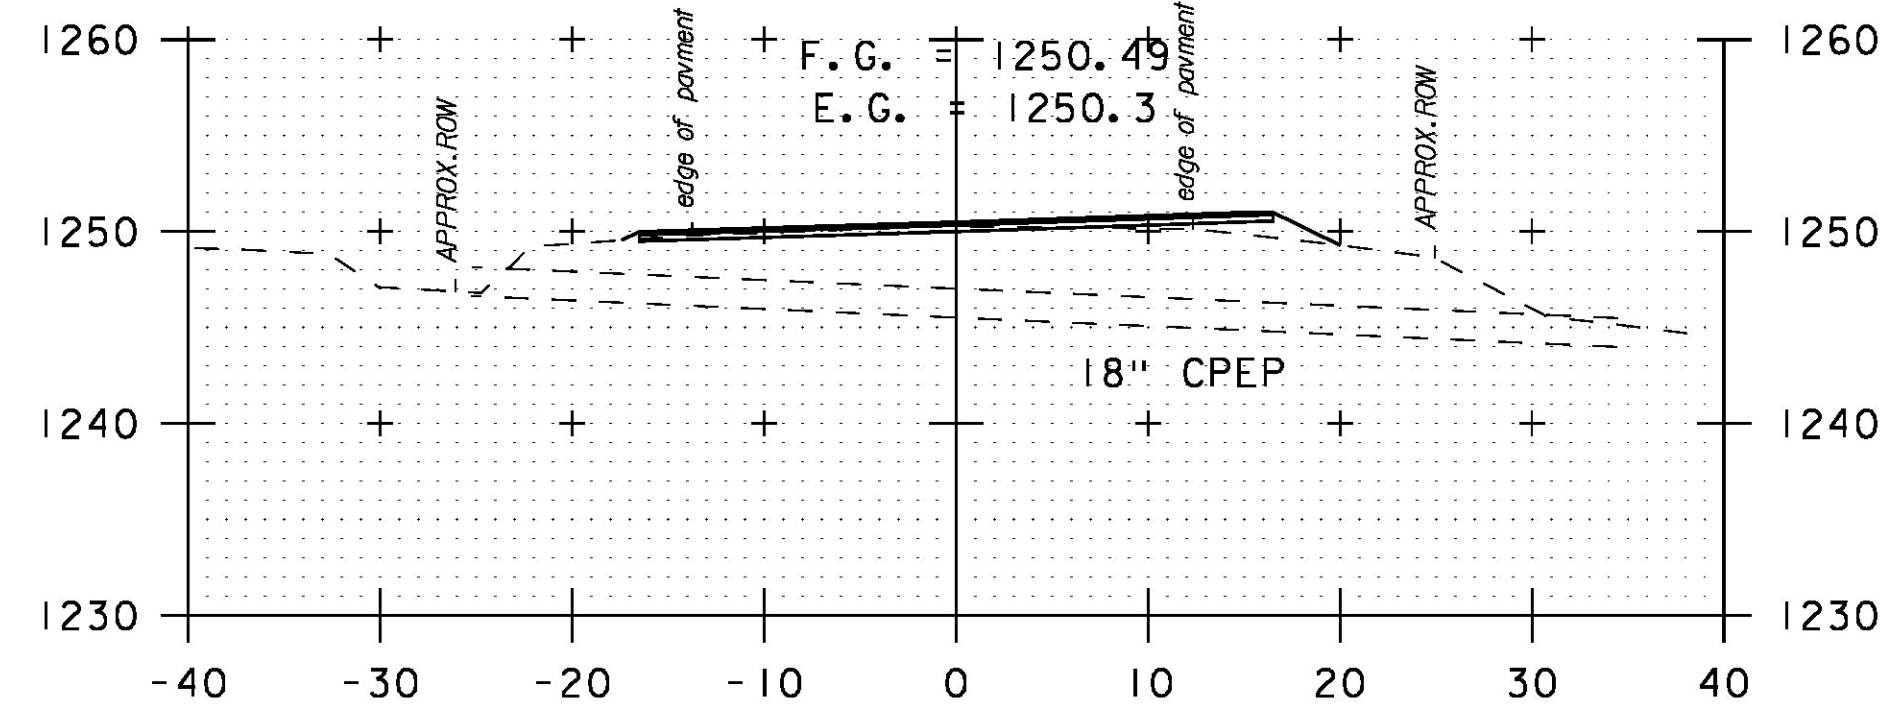


177+97
SKEWED

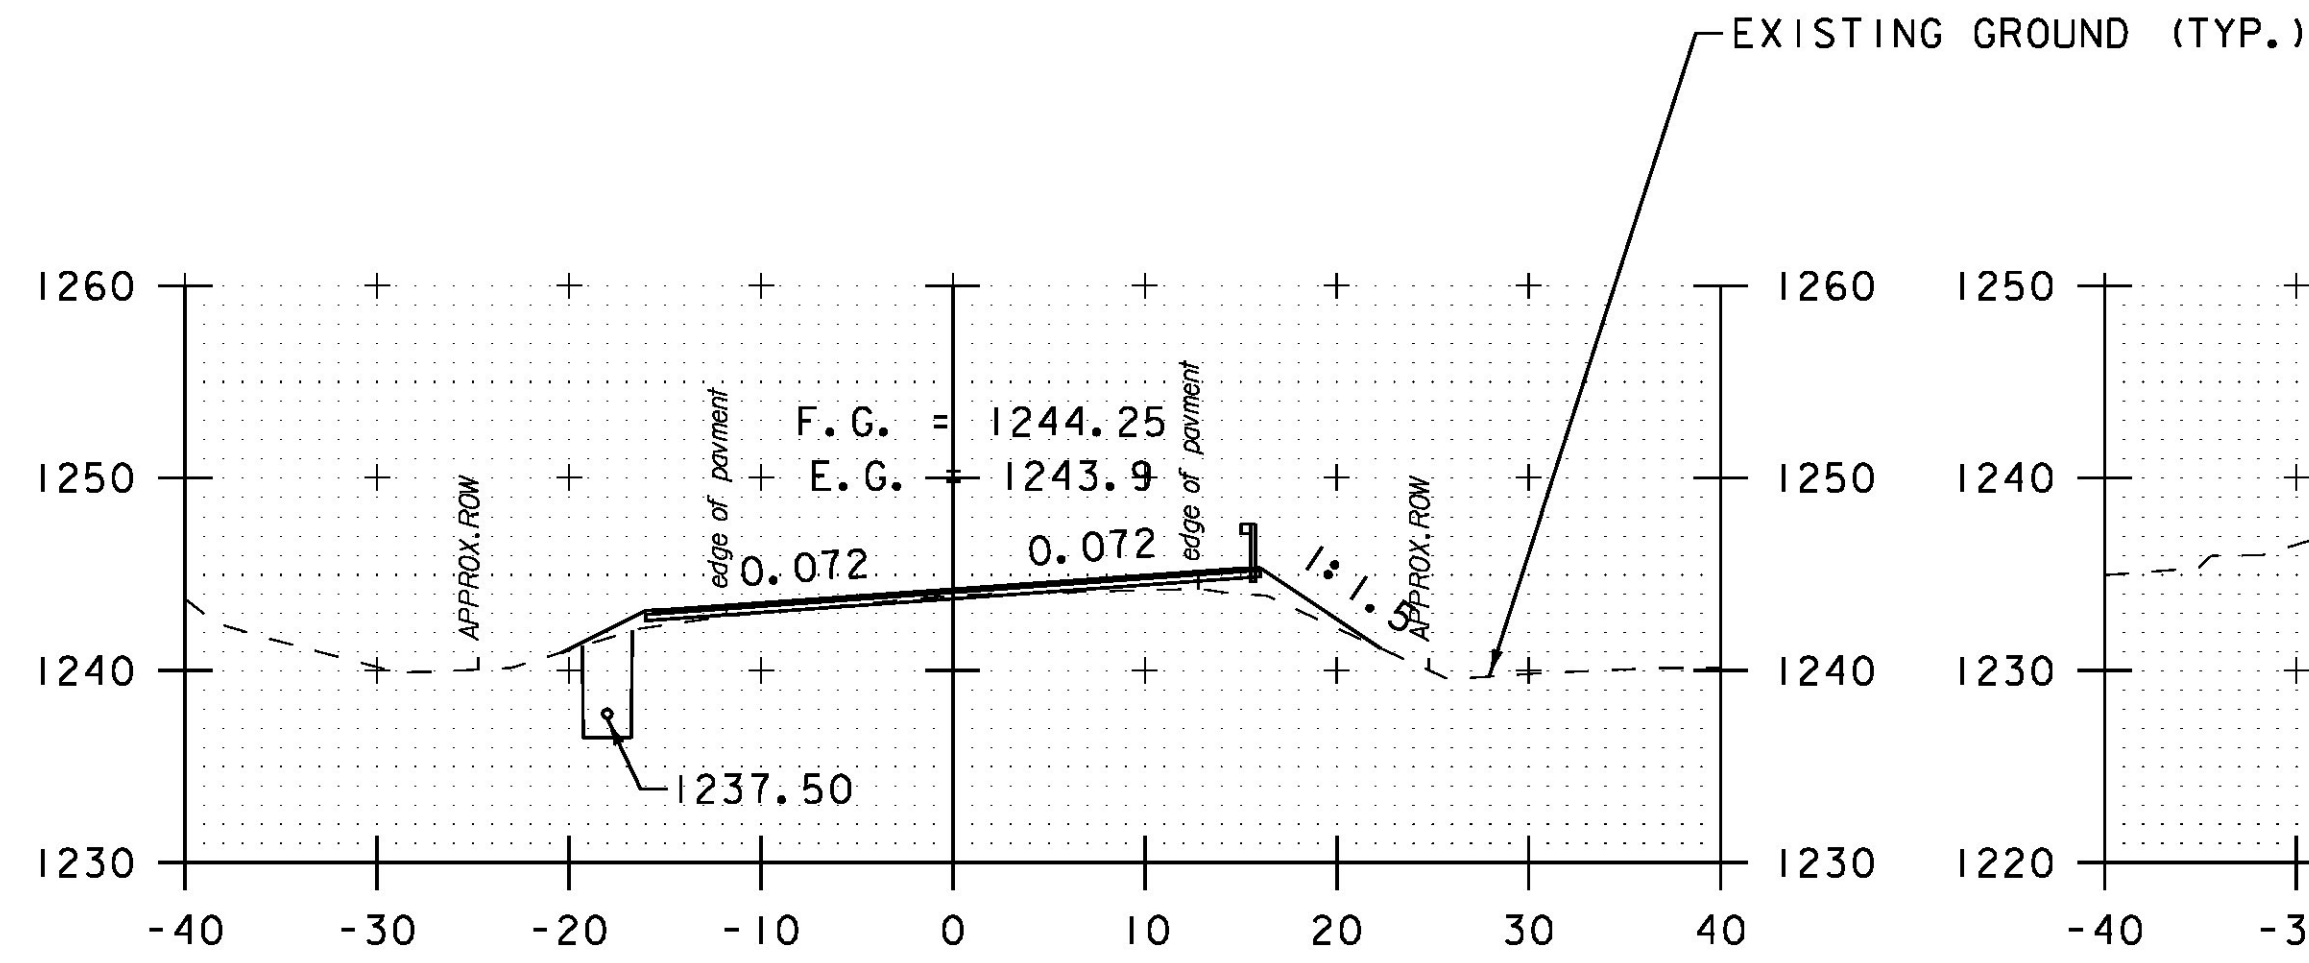


180+50

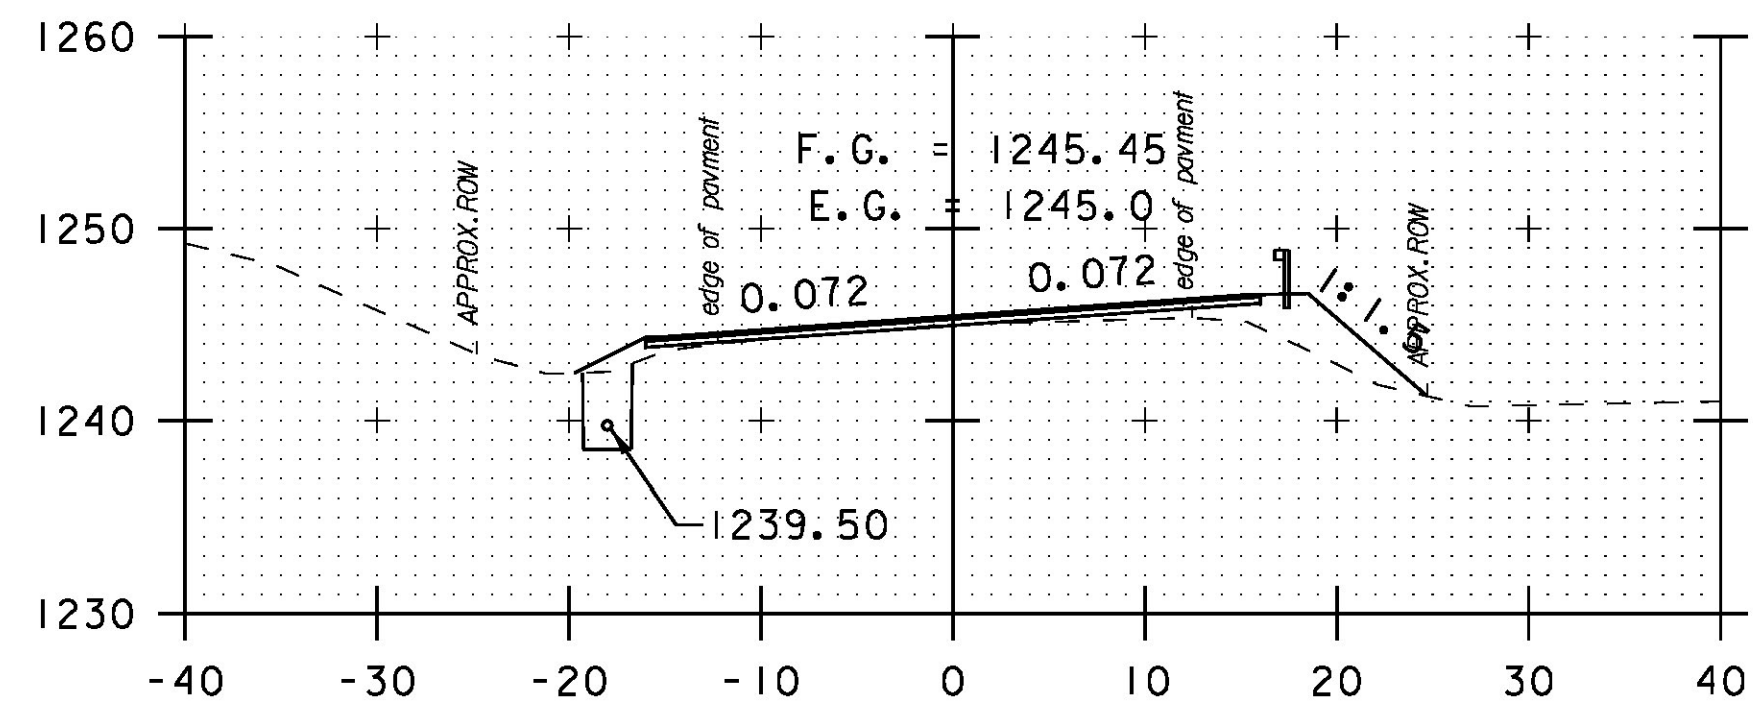


180+00

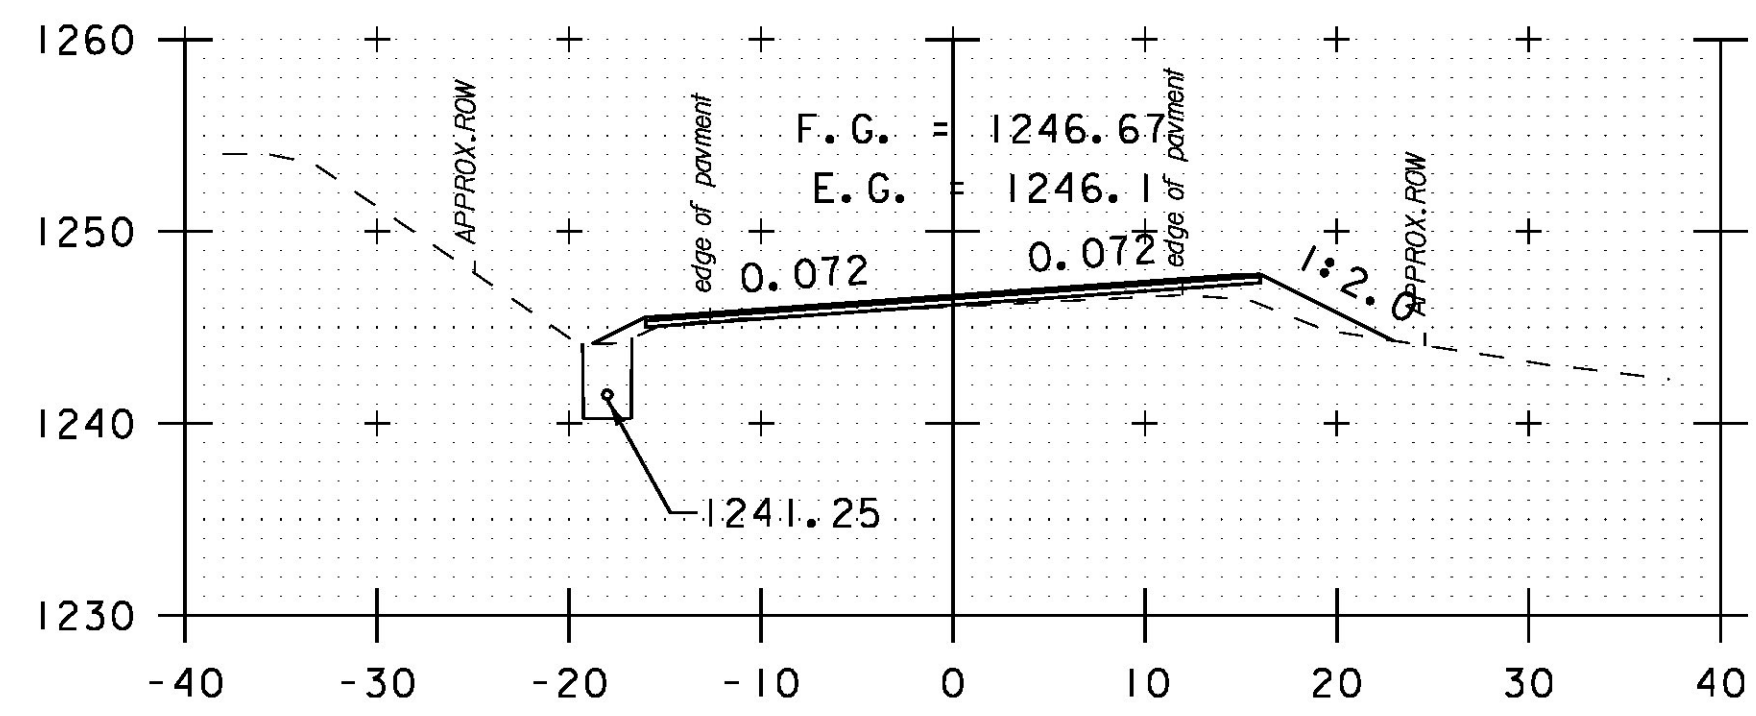

179+50

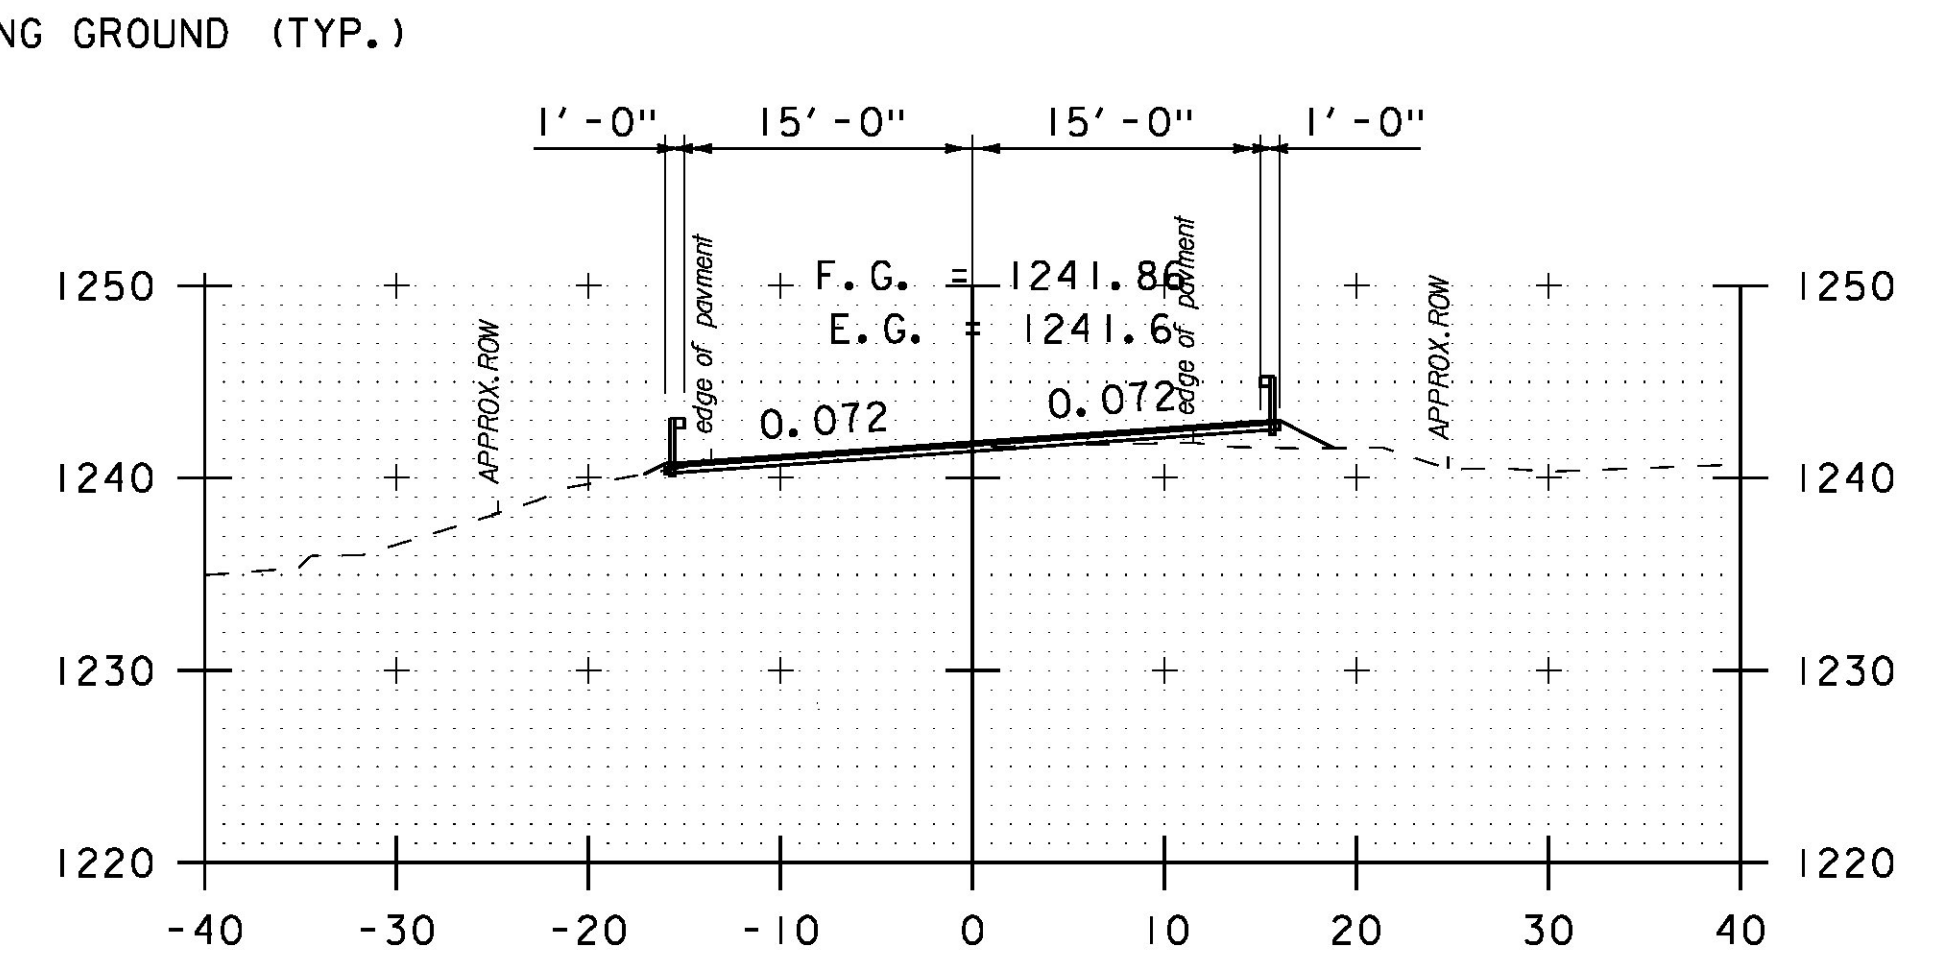


181+50

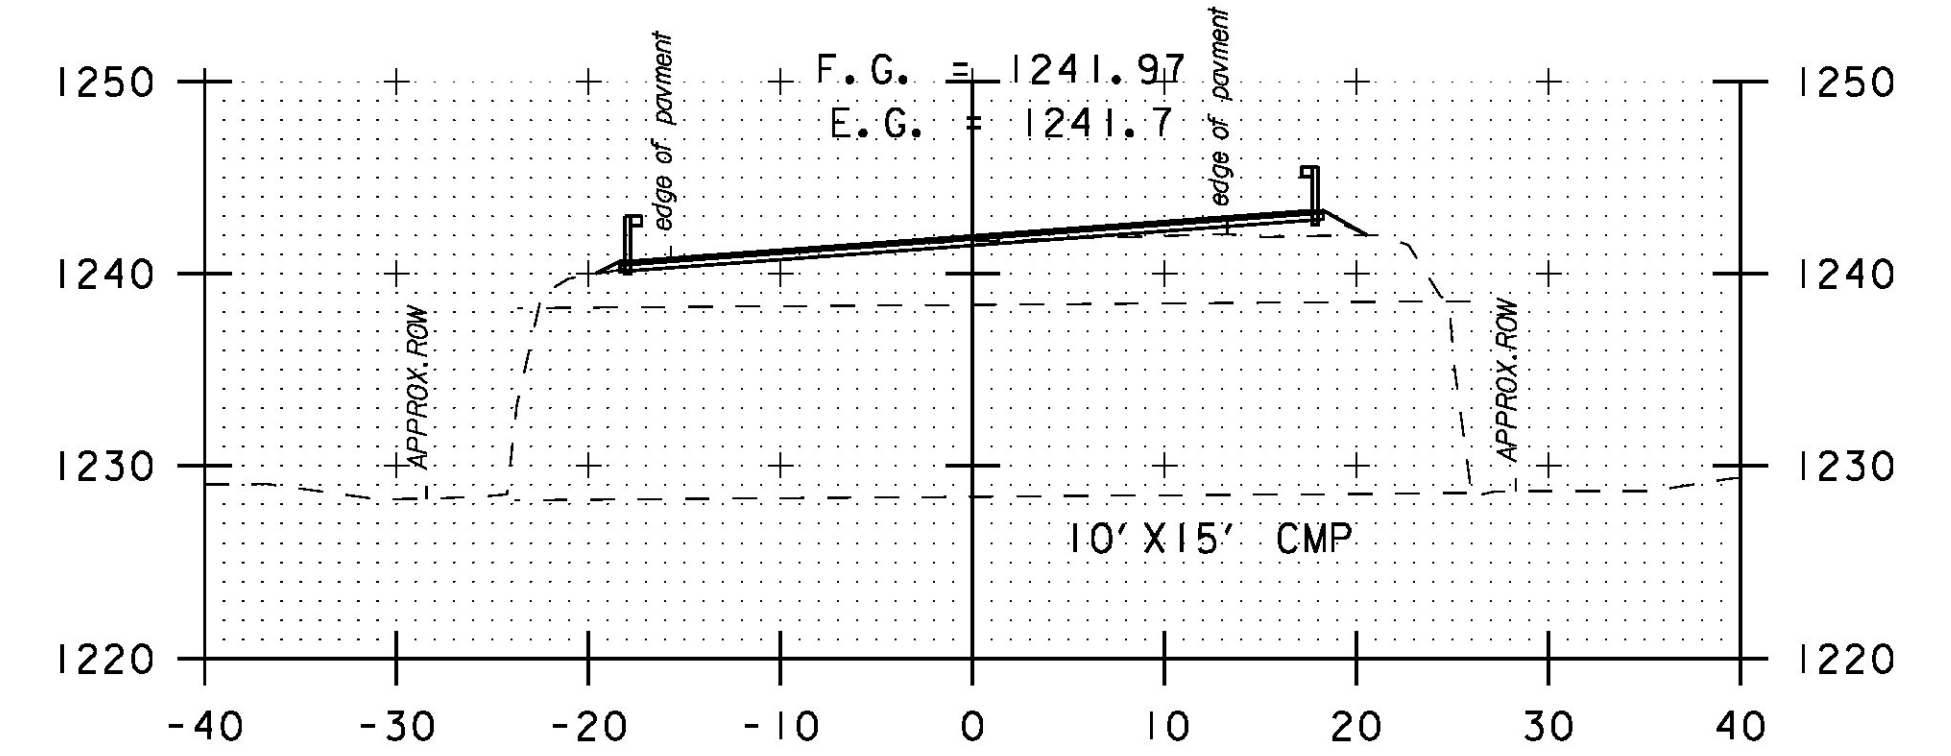


181+45

BRIDGE #20

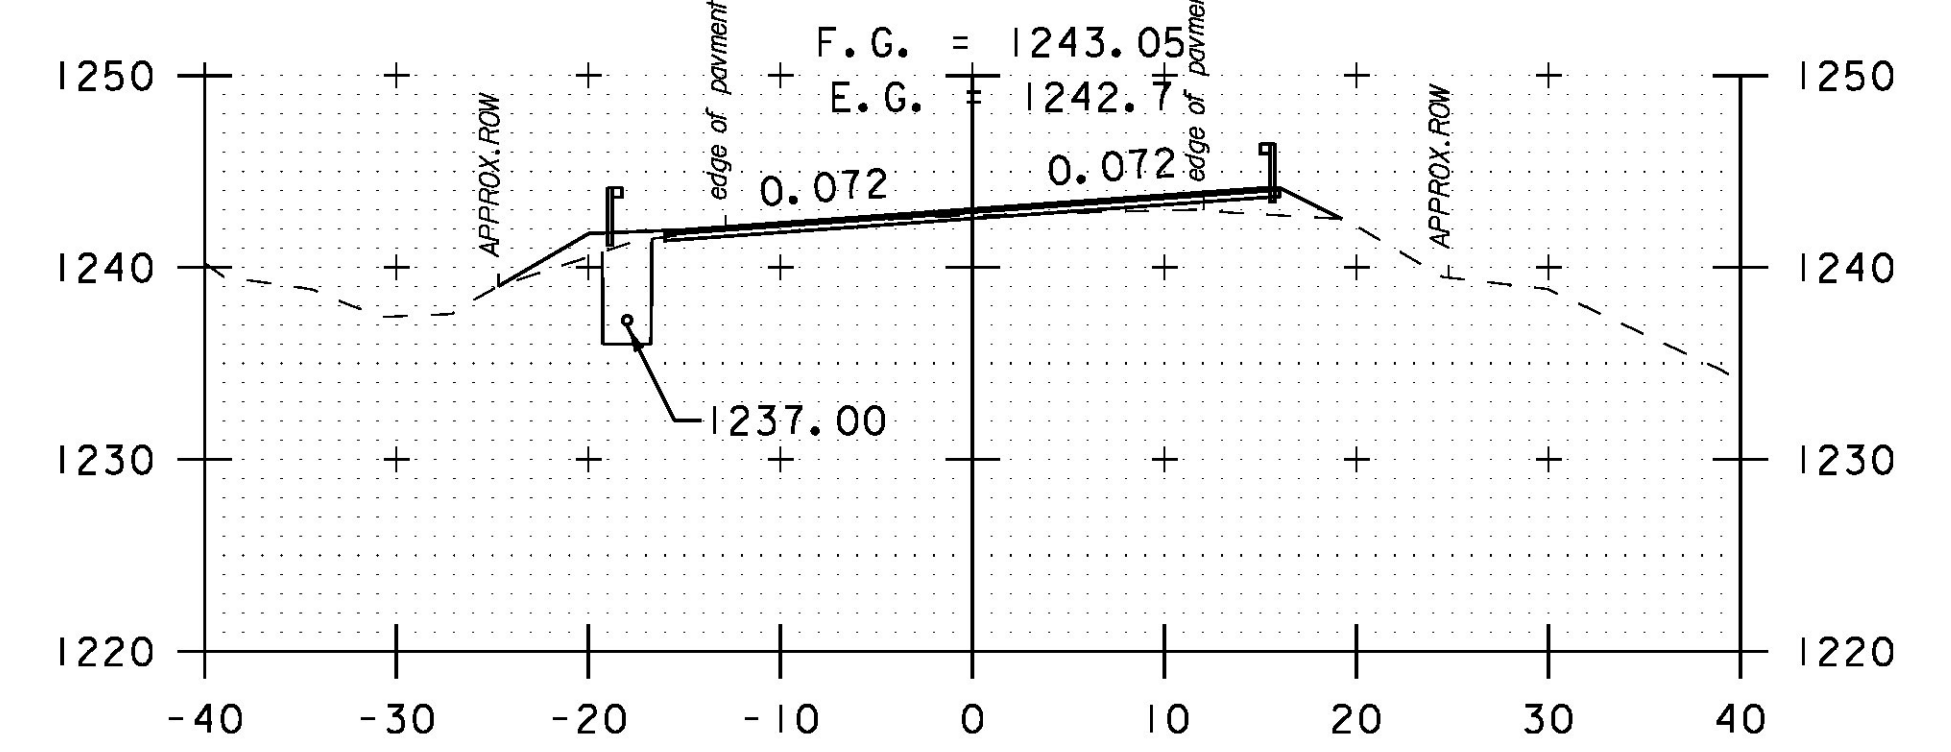

181+00

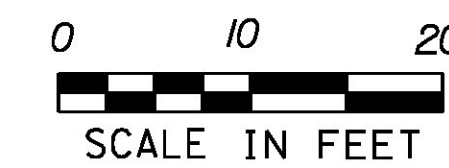

SCALE IN FEET

PROJECT NAME: HANCOCK
PROJECT NUMBER: STP 2923 (1)

FILE NAME: z10c252xs.dgn
PROJECT LEADER: C. LATHROP
DESIGNED BY: B. MARTIN
CROSS SECTION SHEET 32

PLOT DATE: 3/18/2015
DRAWN BY: B. MARTIN
CHECKED BY: C. LATHROP
SHEET 159 OF 207