




193+50

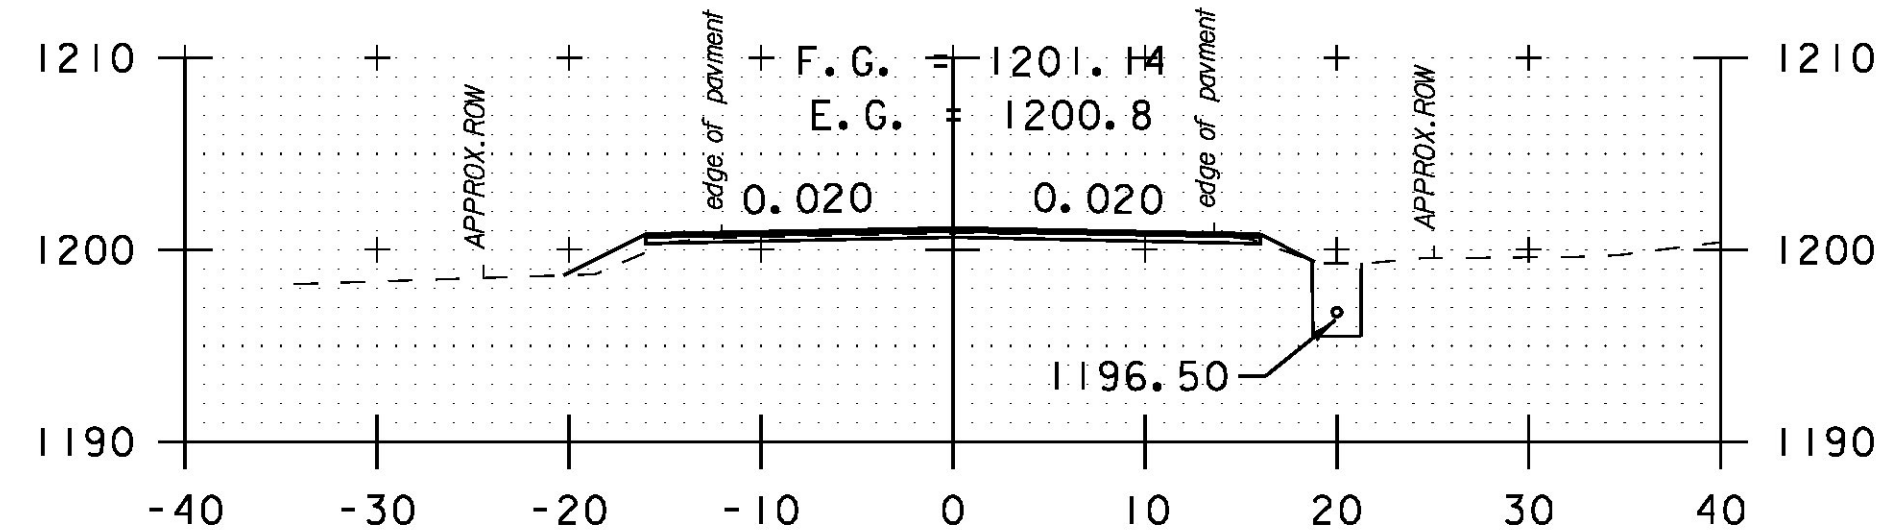


195+50

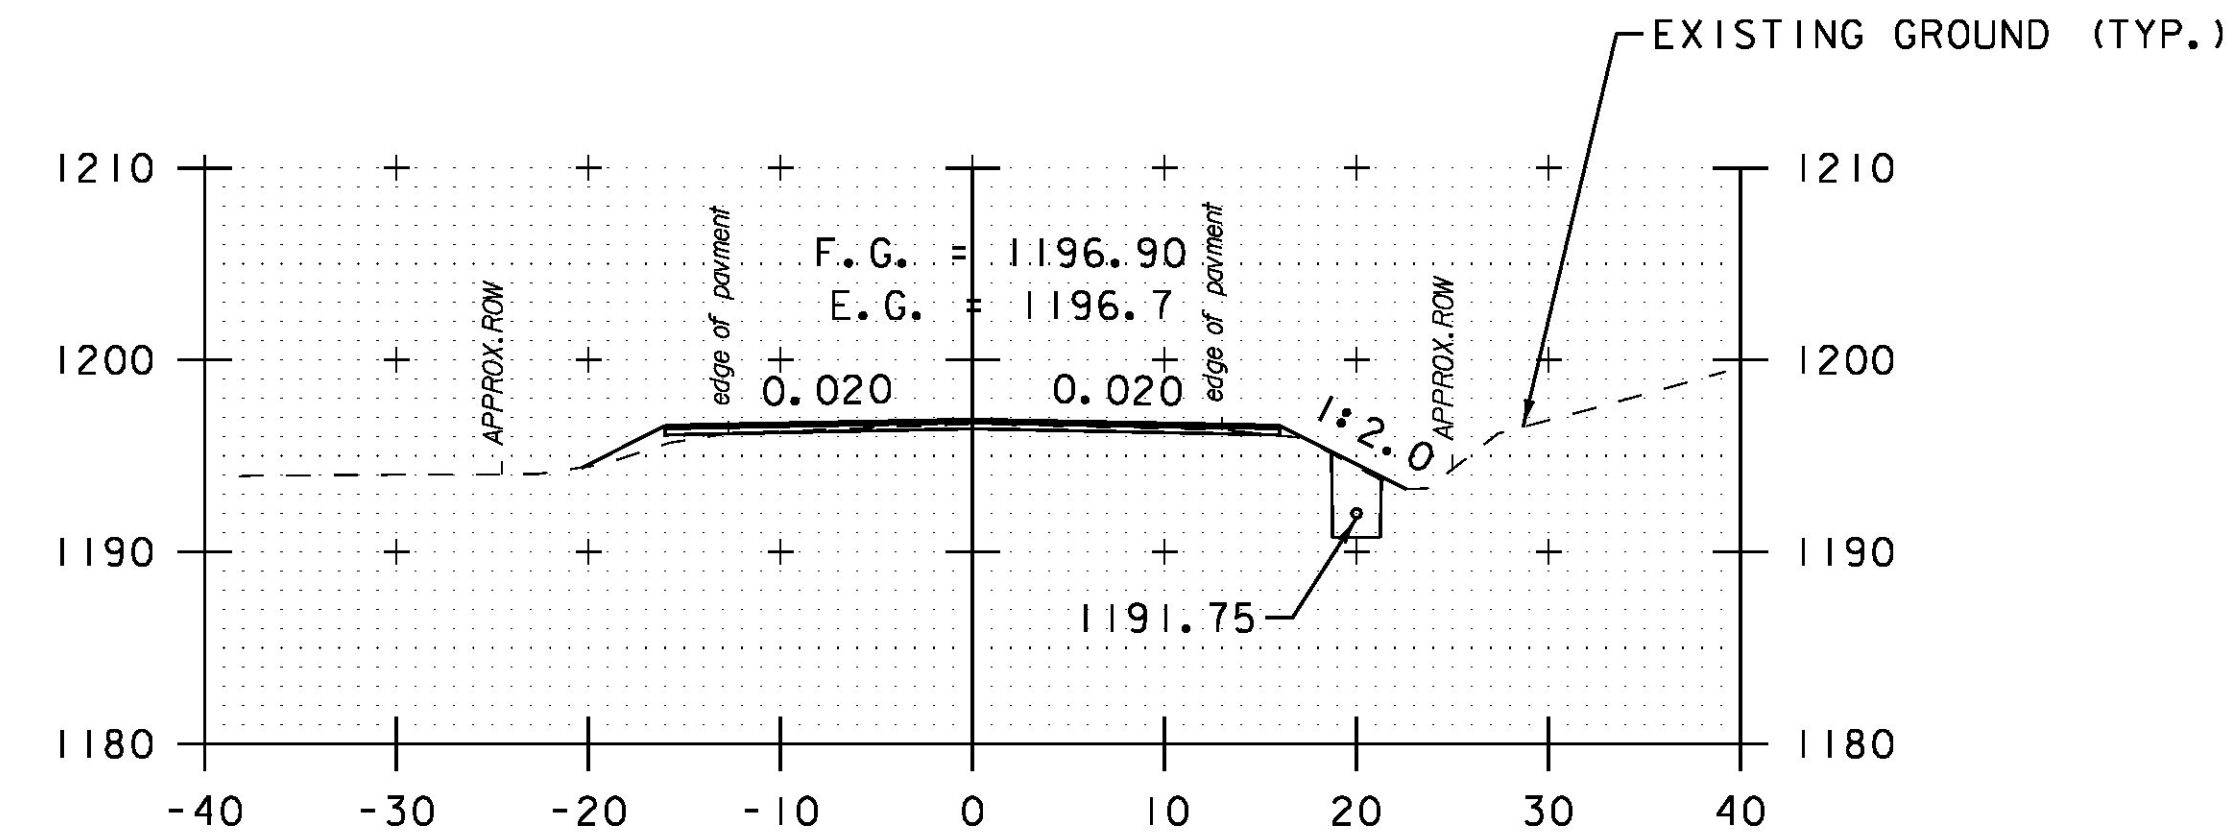


197+50

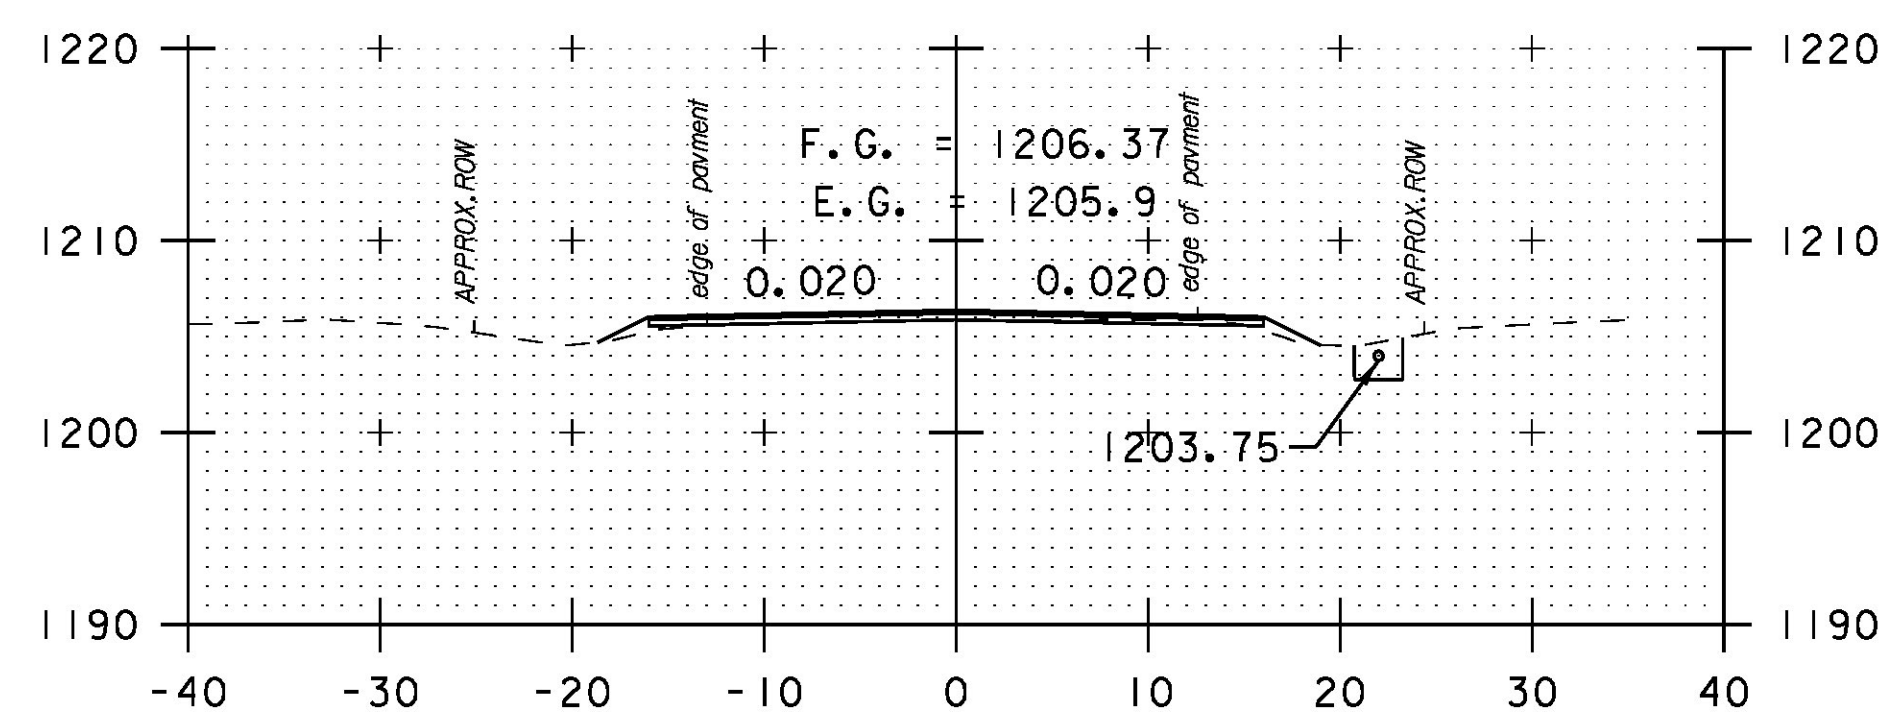


193+00

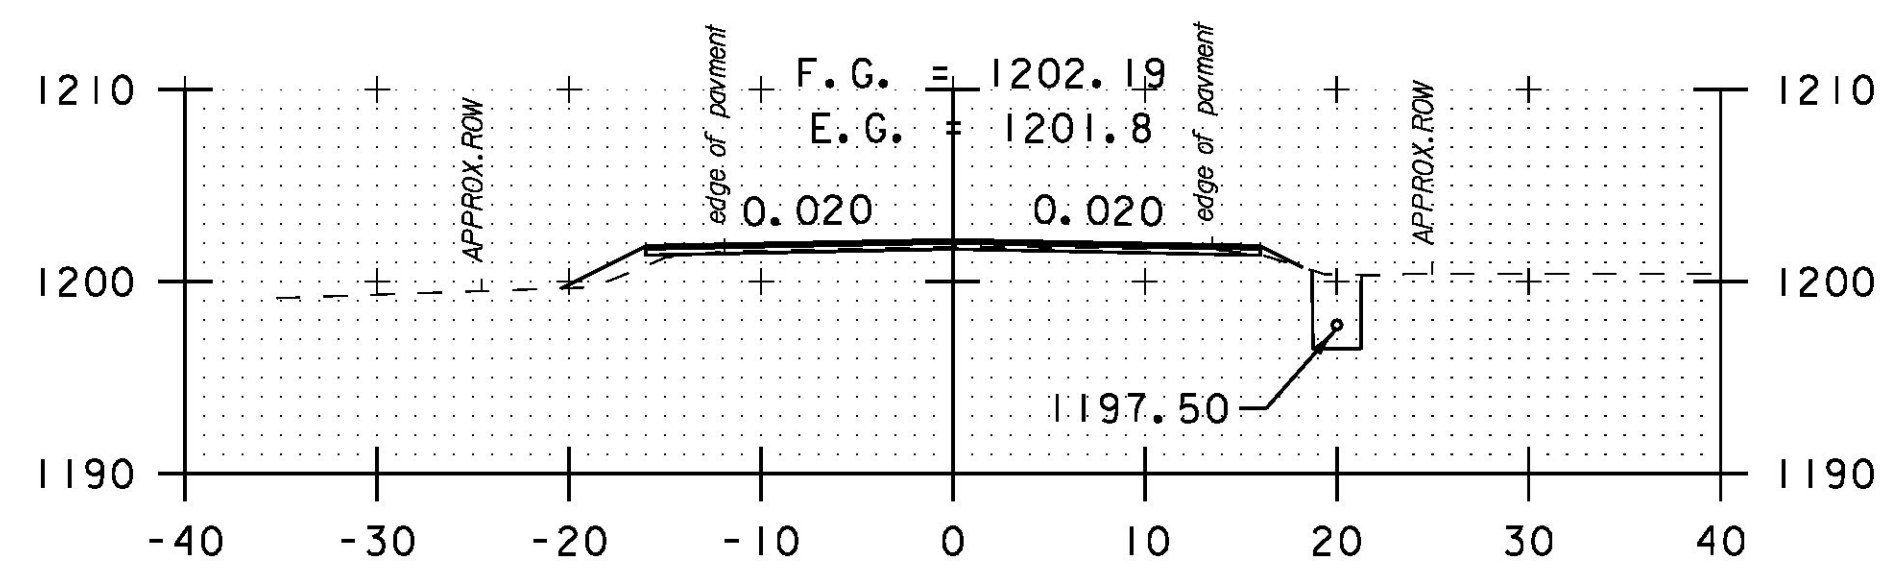


195+00

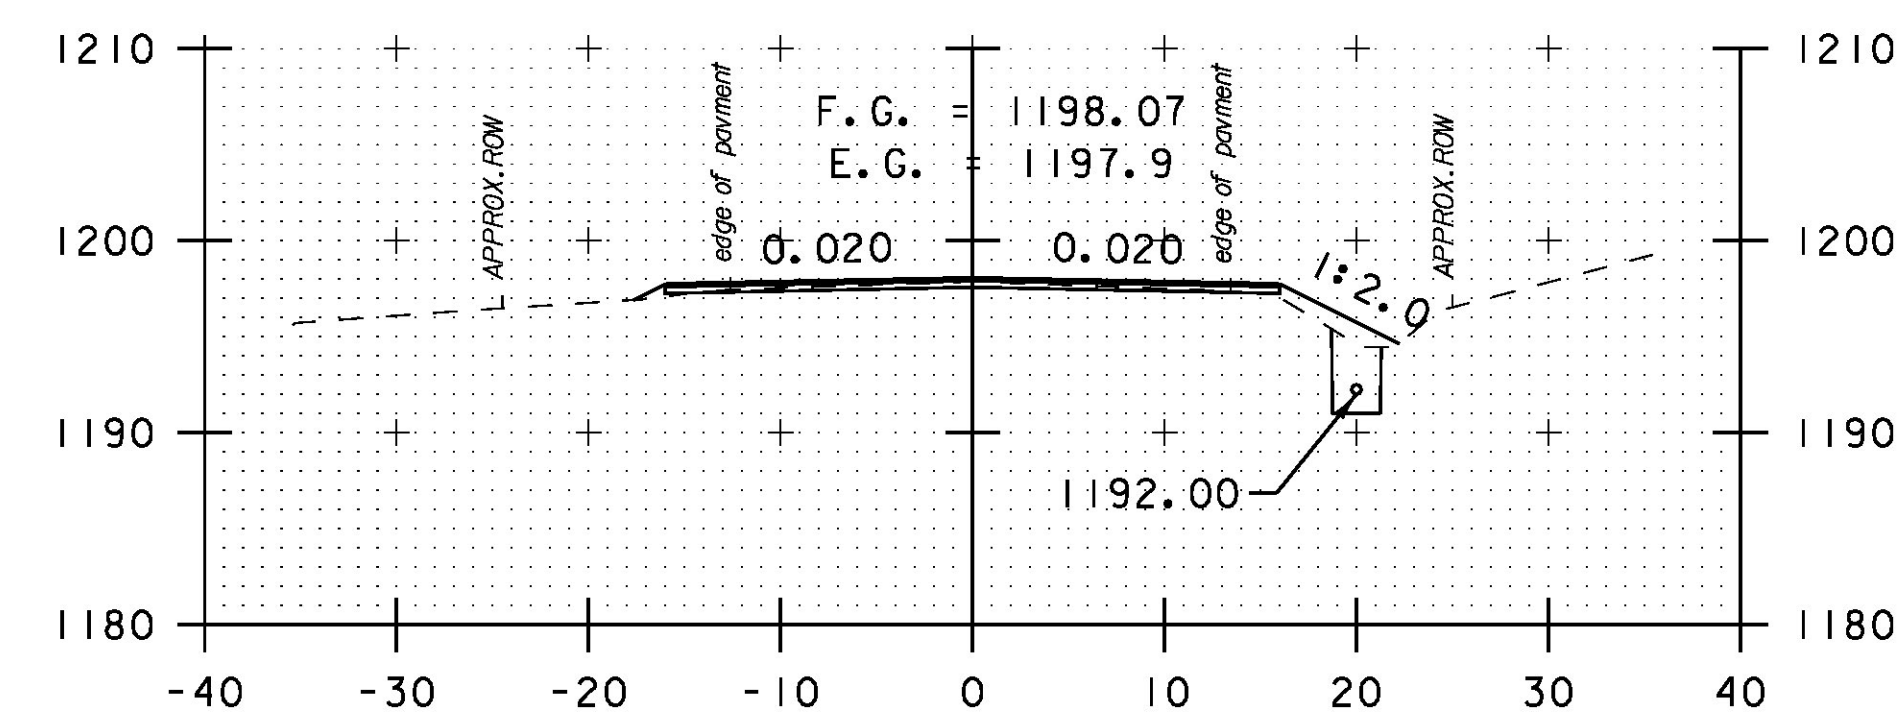


197+00

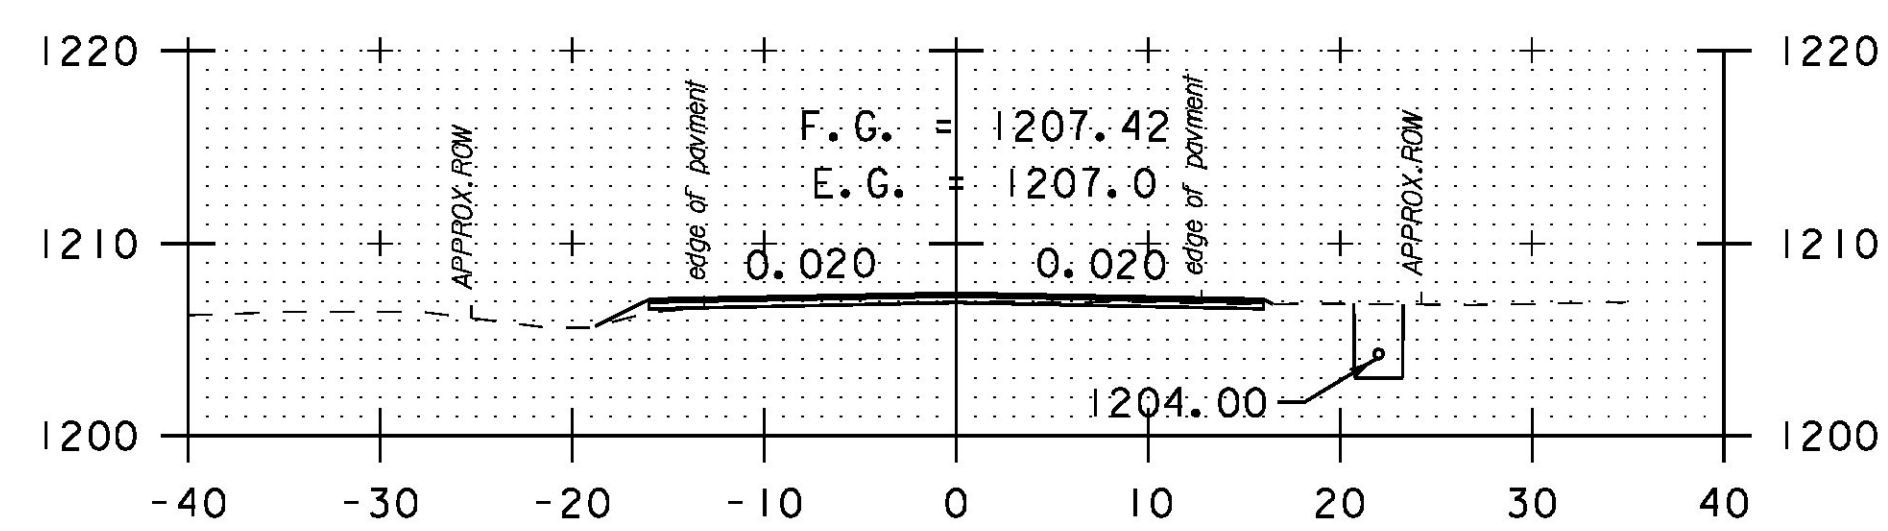


192+50
DRIVE RT

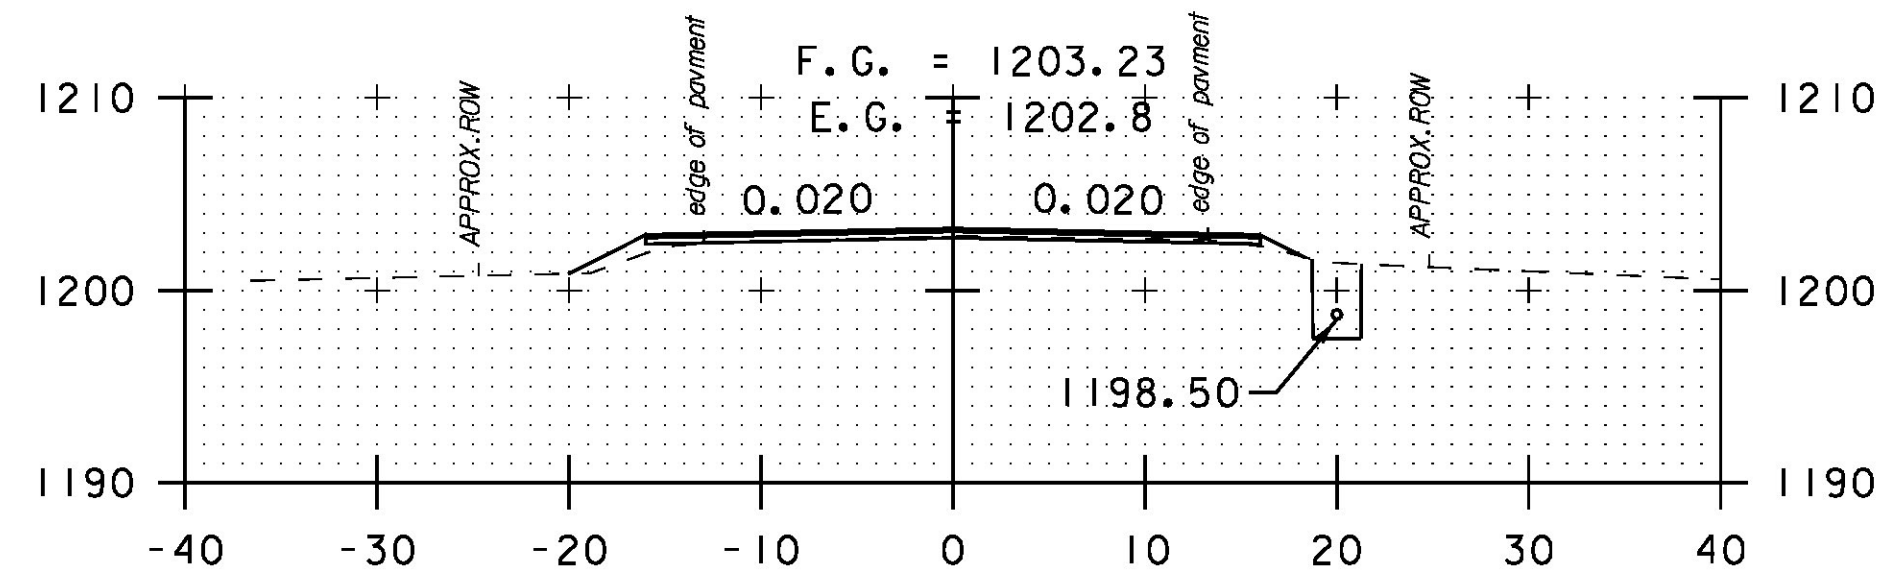


194+50

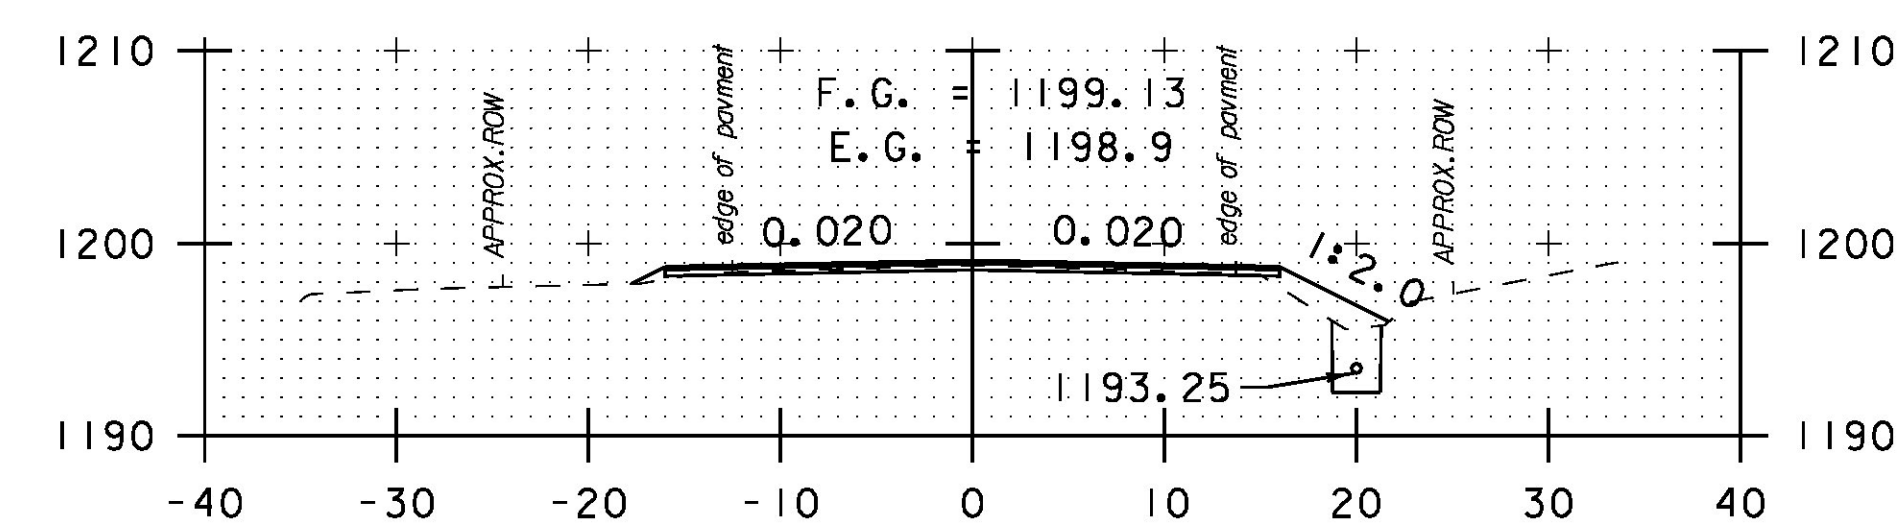


196+50

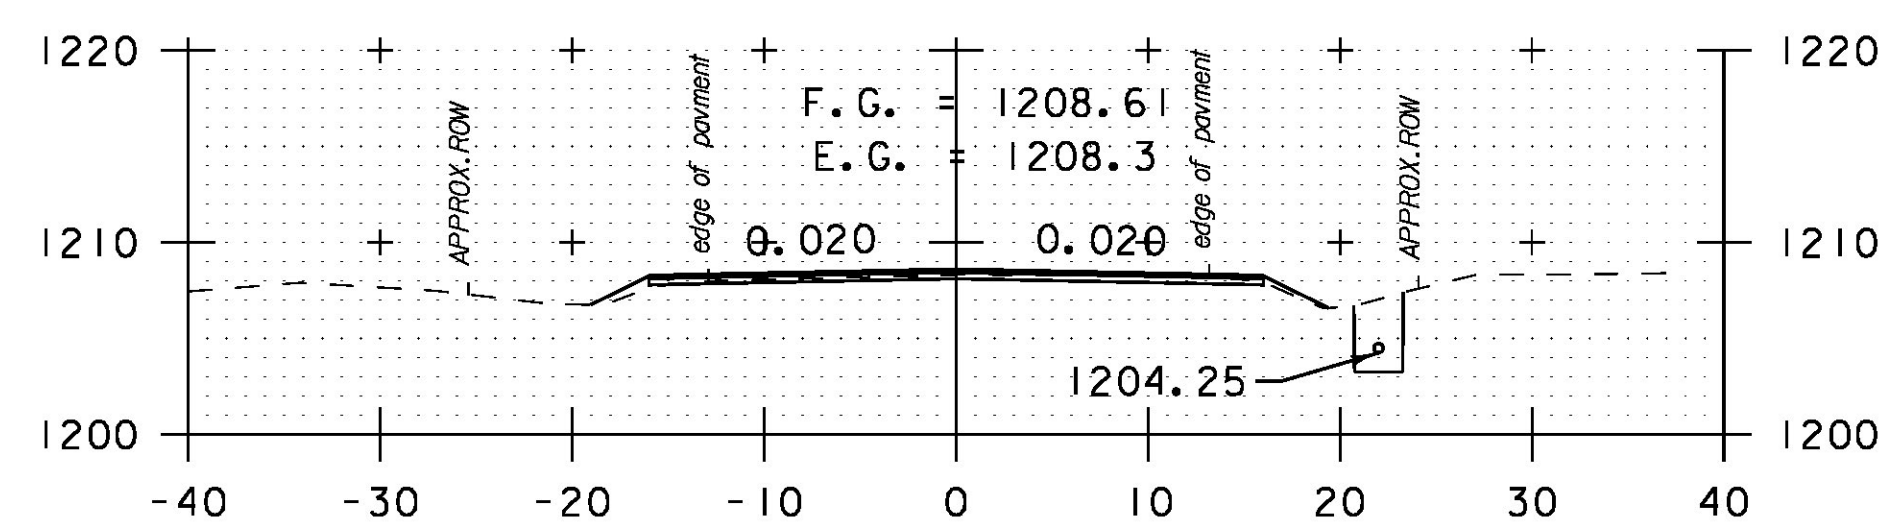

192+00

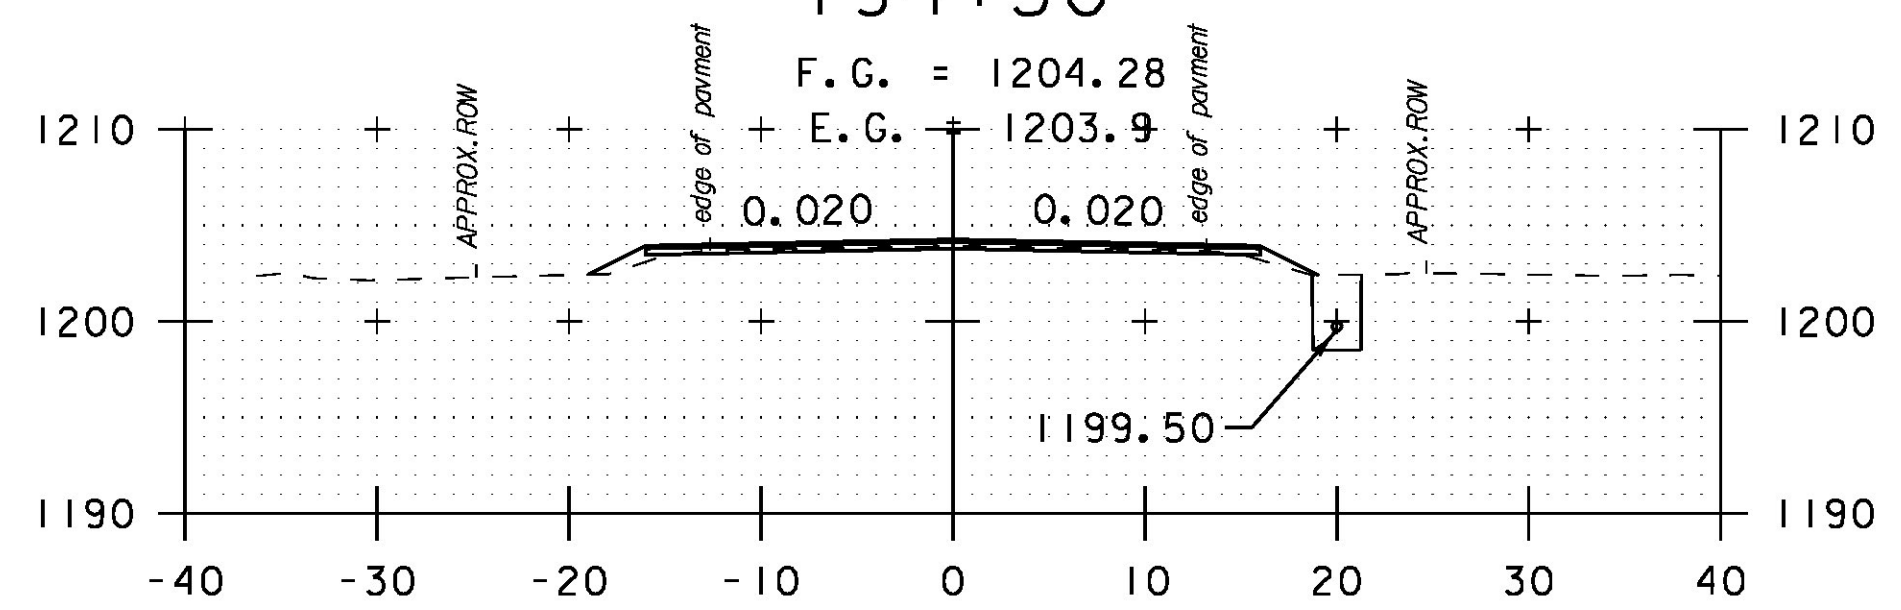

194+00

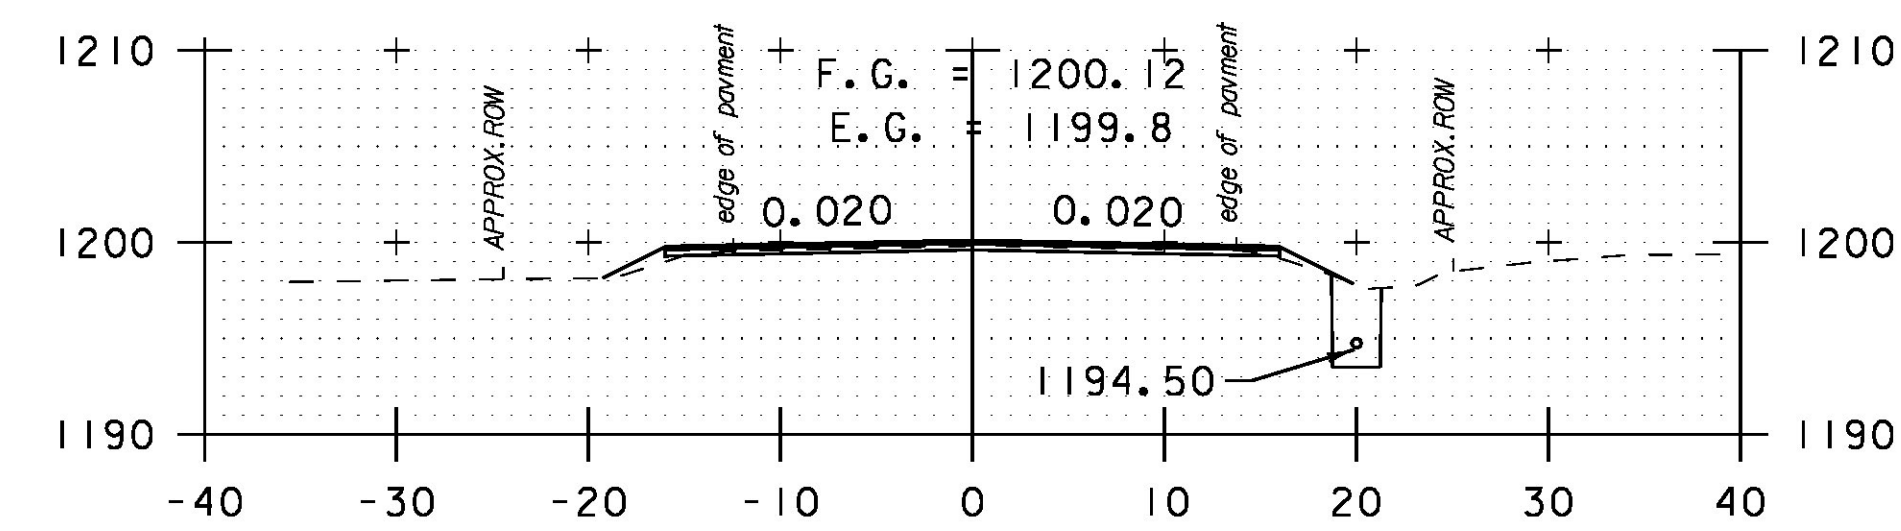

196+00



PROJECT NAME:	HANCOCK	PLOT DATE:	3/18/2015
PROJECT NUMBER:	STP 2923 (1)	DRAWN BY:	B. MARTIN
FILE NAME:	z10c252xs.dgn	CHECKED BY:	C. LATHROP
PROJECT LEADER:	C. LATHROP	CROSS SECTION SHEET	35
DESIGNED BY:	B. MARTIN	SHEET	162 OF 207