
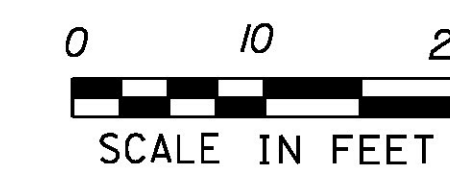
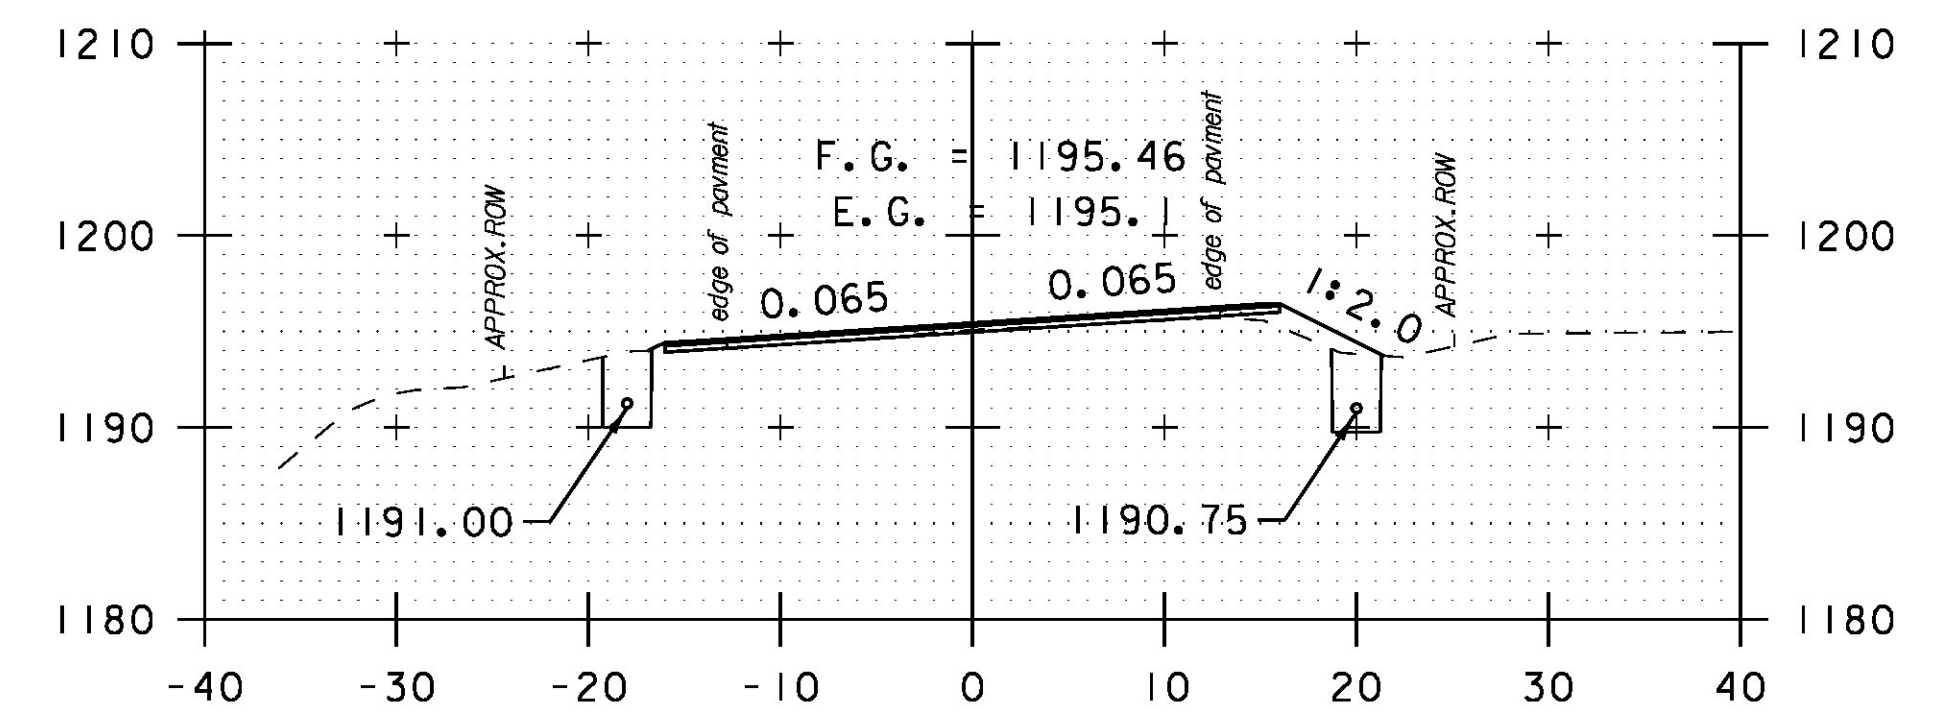
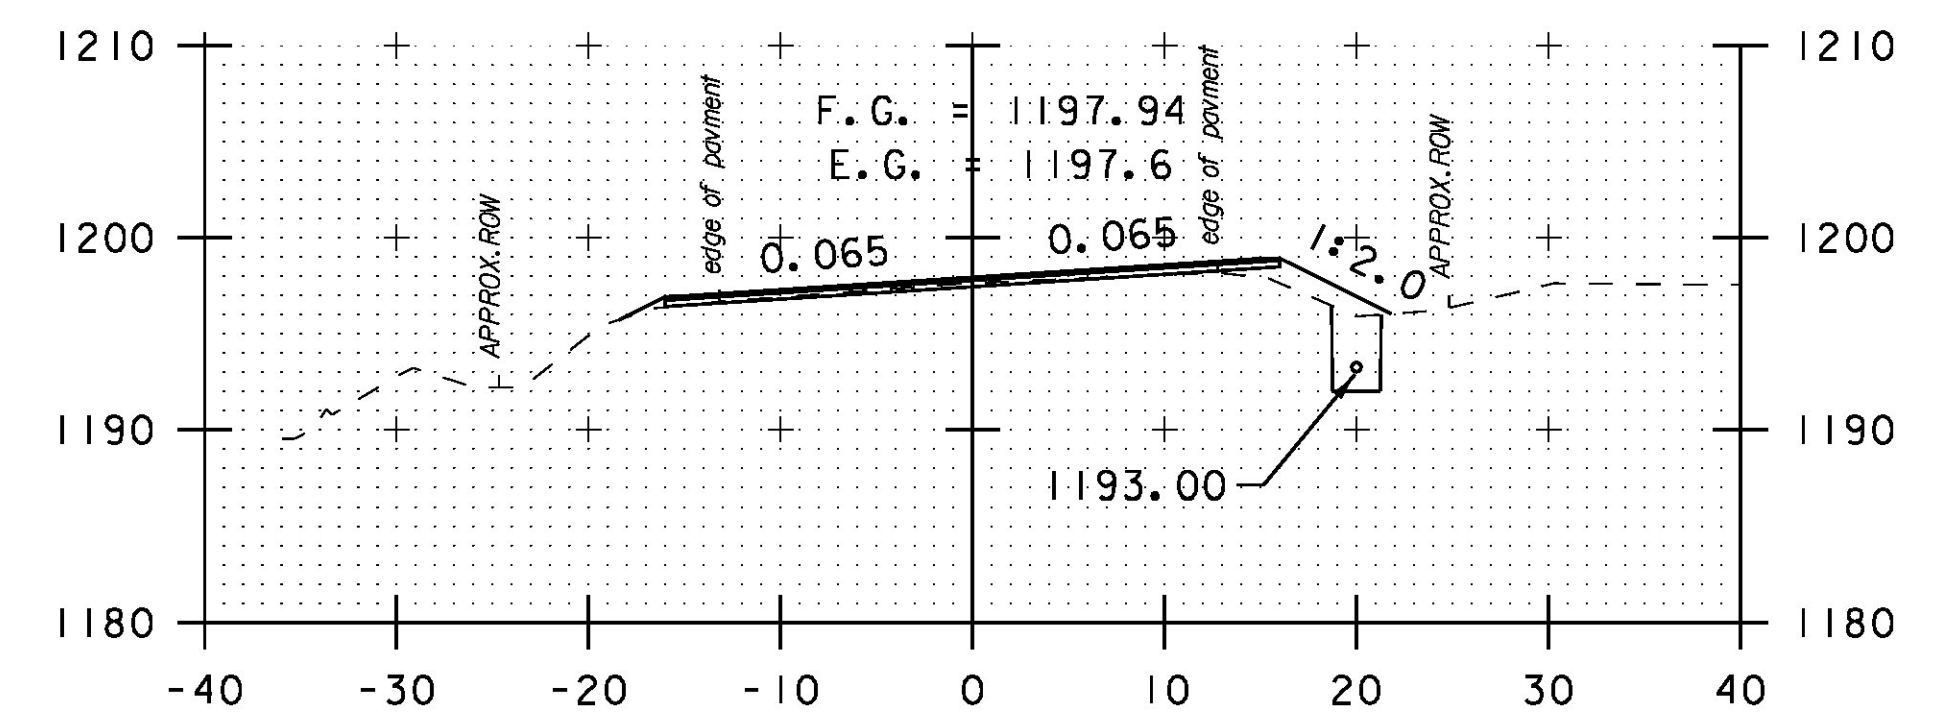


12

STA. 207+02.74 LT 22.08' TO
STA. 207+37.58 RT 20.50'
ASKEW ANGLE = 50.8593° RT
REMOVE EXISTING 15" CMP PIPE
INSTALL 18" CPEP (55'-0")
STONE FILL ON CUT SLOPE RT
INV. IN = 1194.90'
INV. OUT = 1192.19'

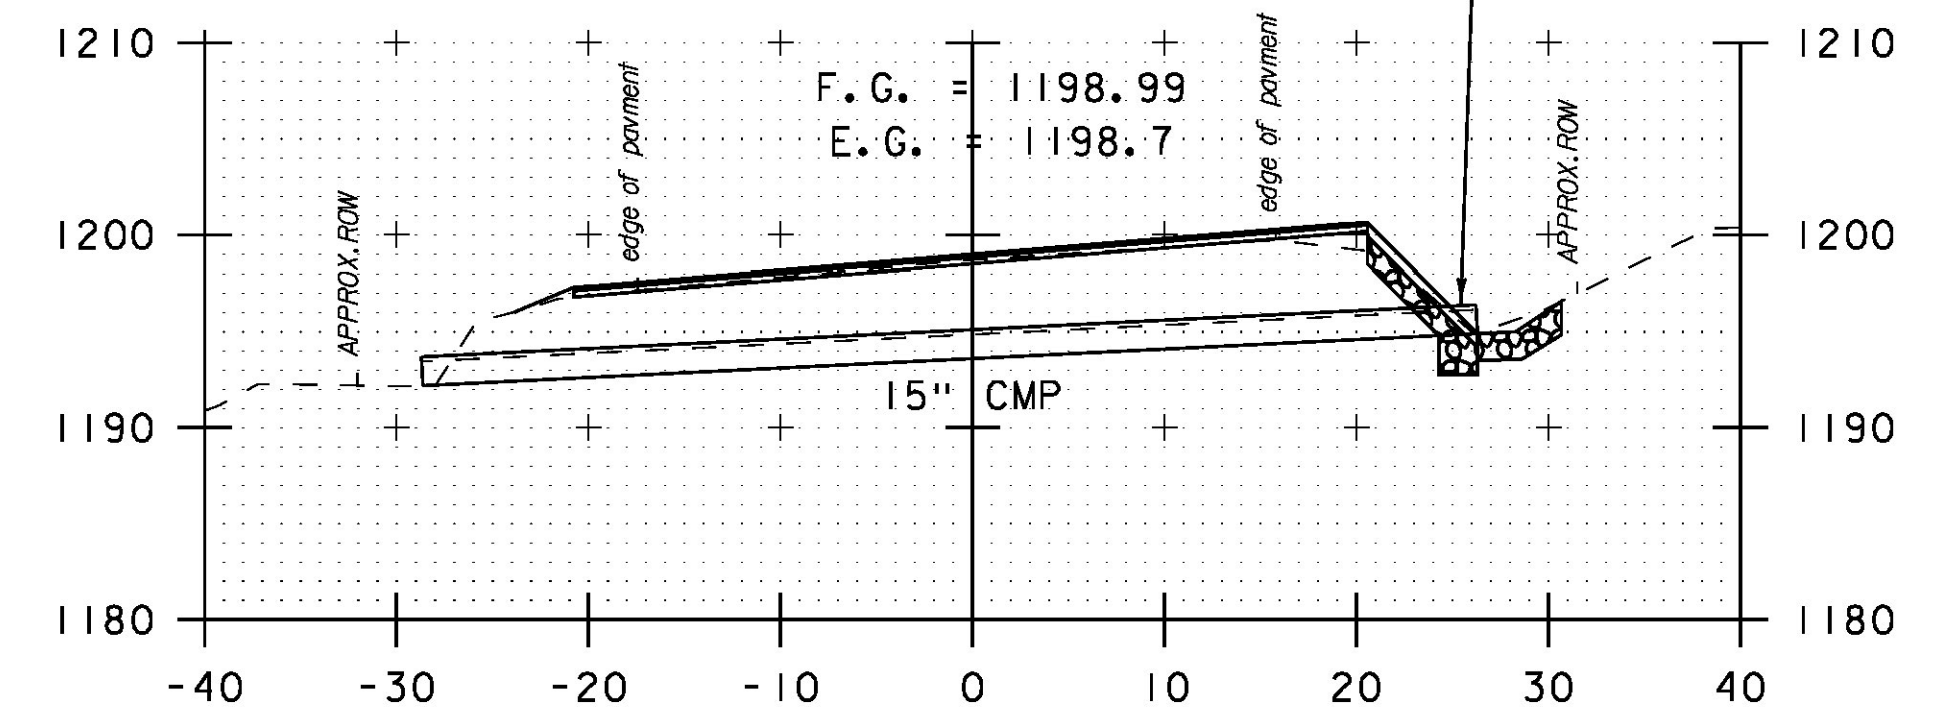

PROJECT NAME: HANCOCK	PLOT DATE: 3/18/2015
PROJECT NUMBER: STP 2923 (1)	DRAWN BY: B. MARTIN
FILE NAME: z10c252xs.dgn	CHECKED BY: C. LATHROP
PROJECT LEADER: C. LATHROP	SHEET 164 OF 207
DESIGNED BY: B. MARTIN	
CROSS SECTION SHEET 37	