




209+00

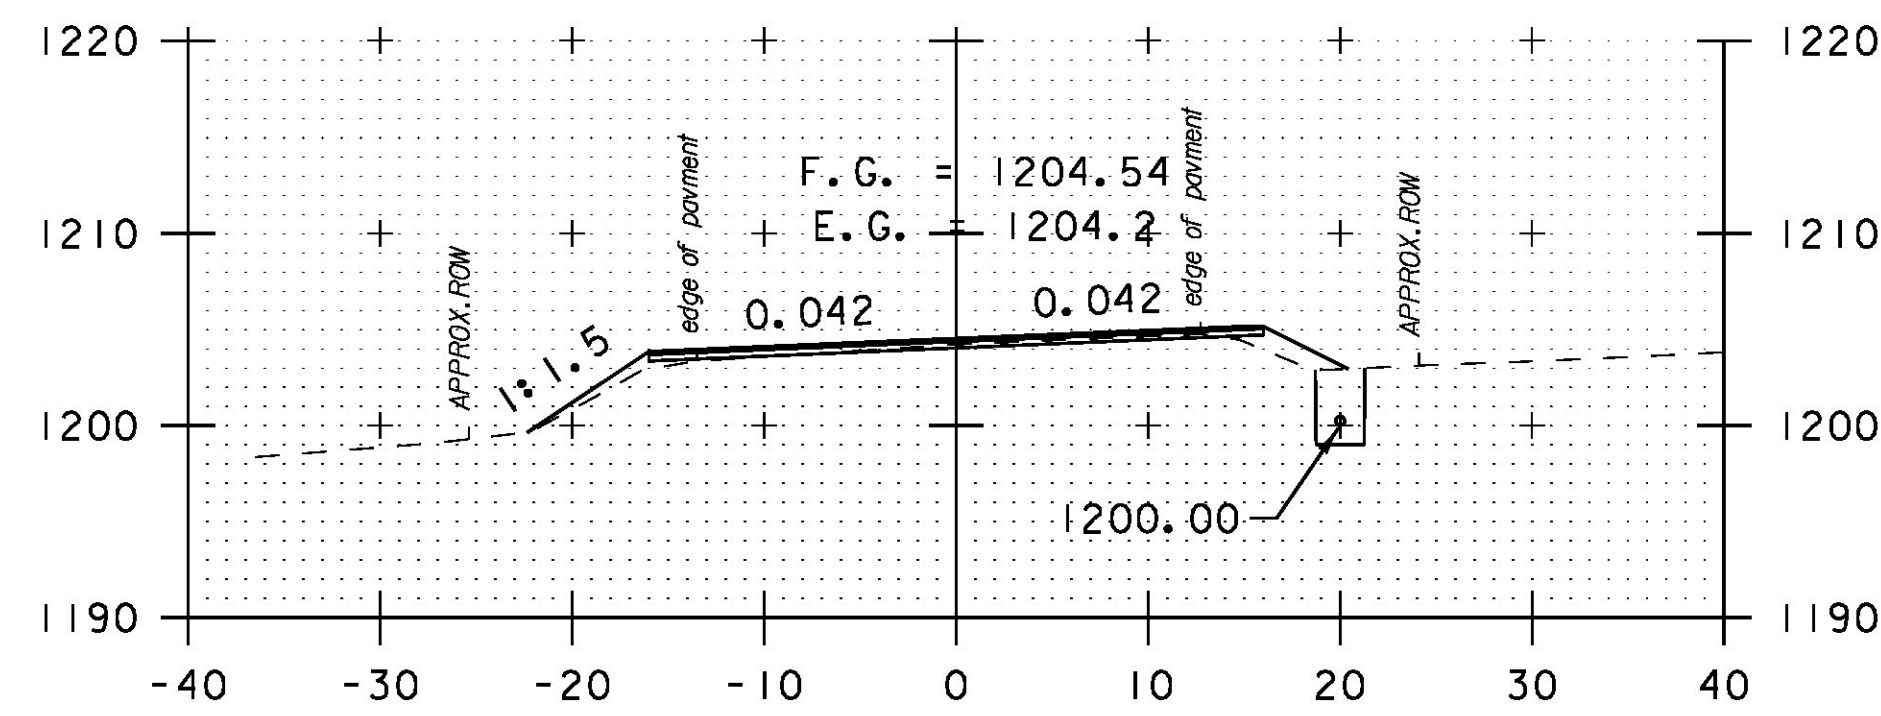


208+50

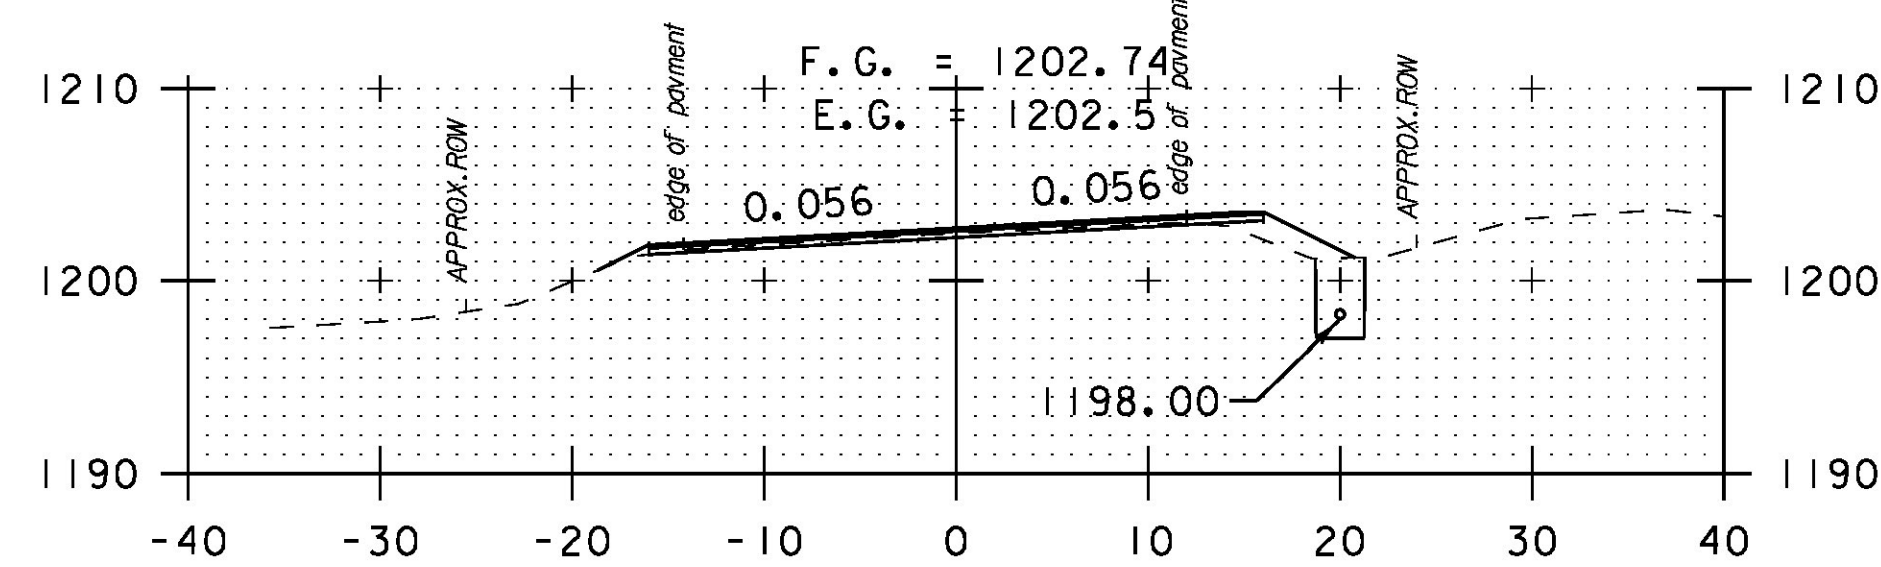


208+00

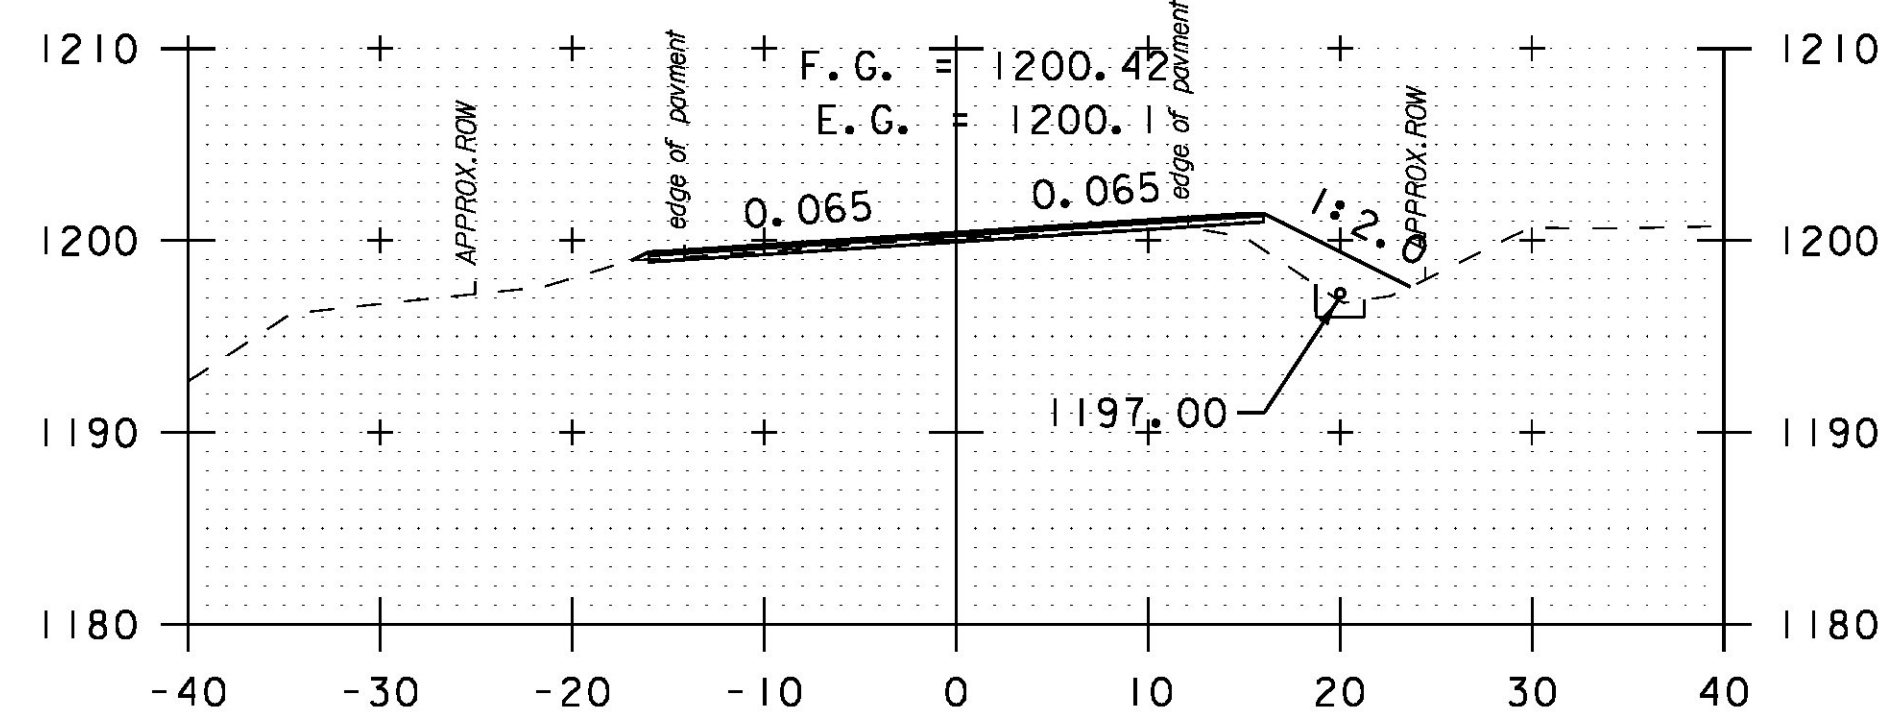


207+50

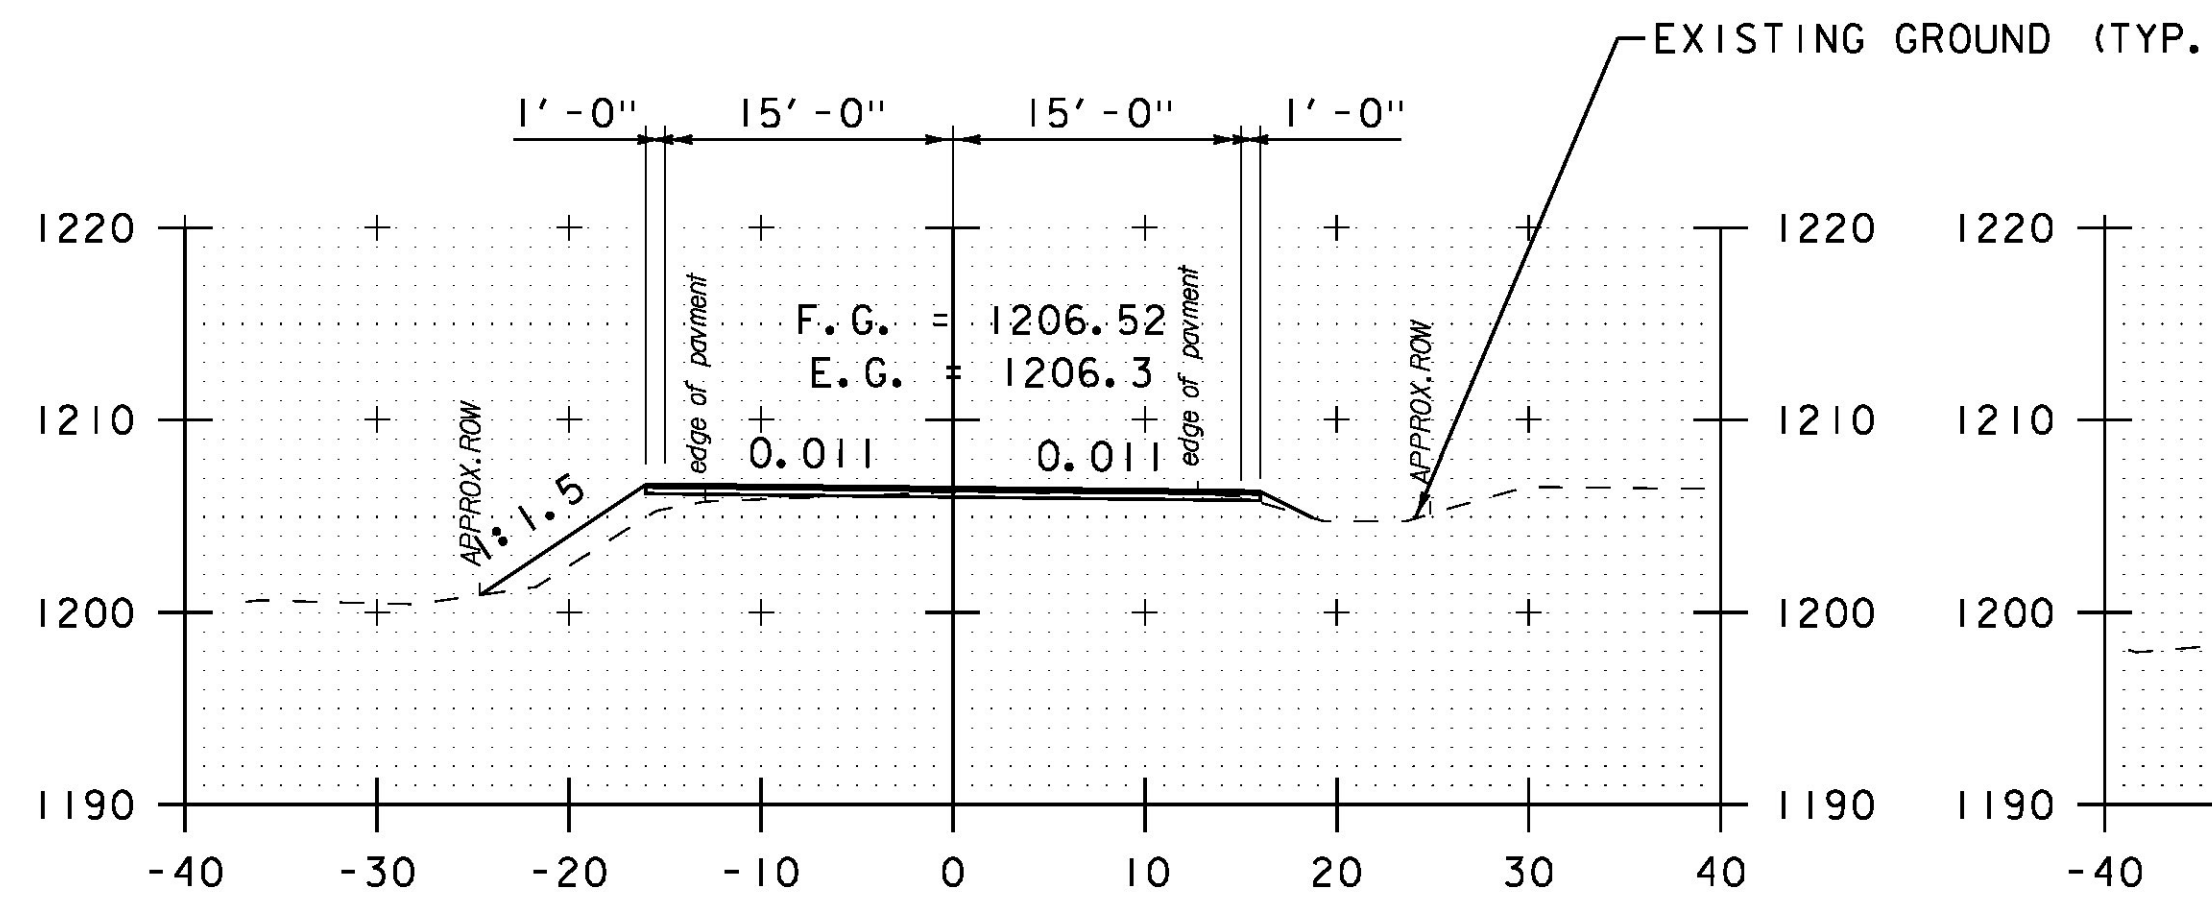


210+50

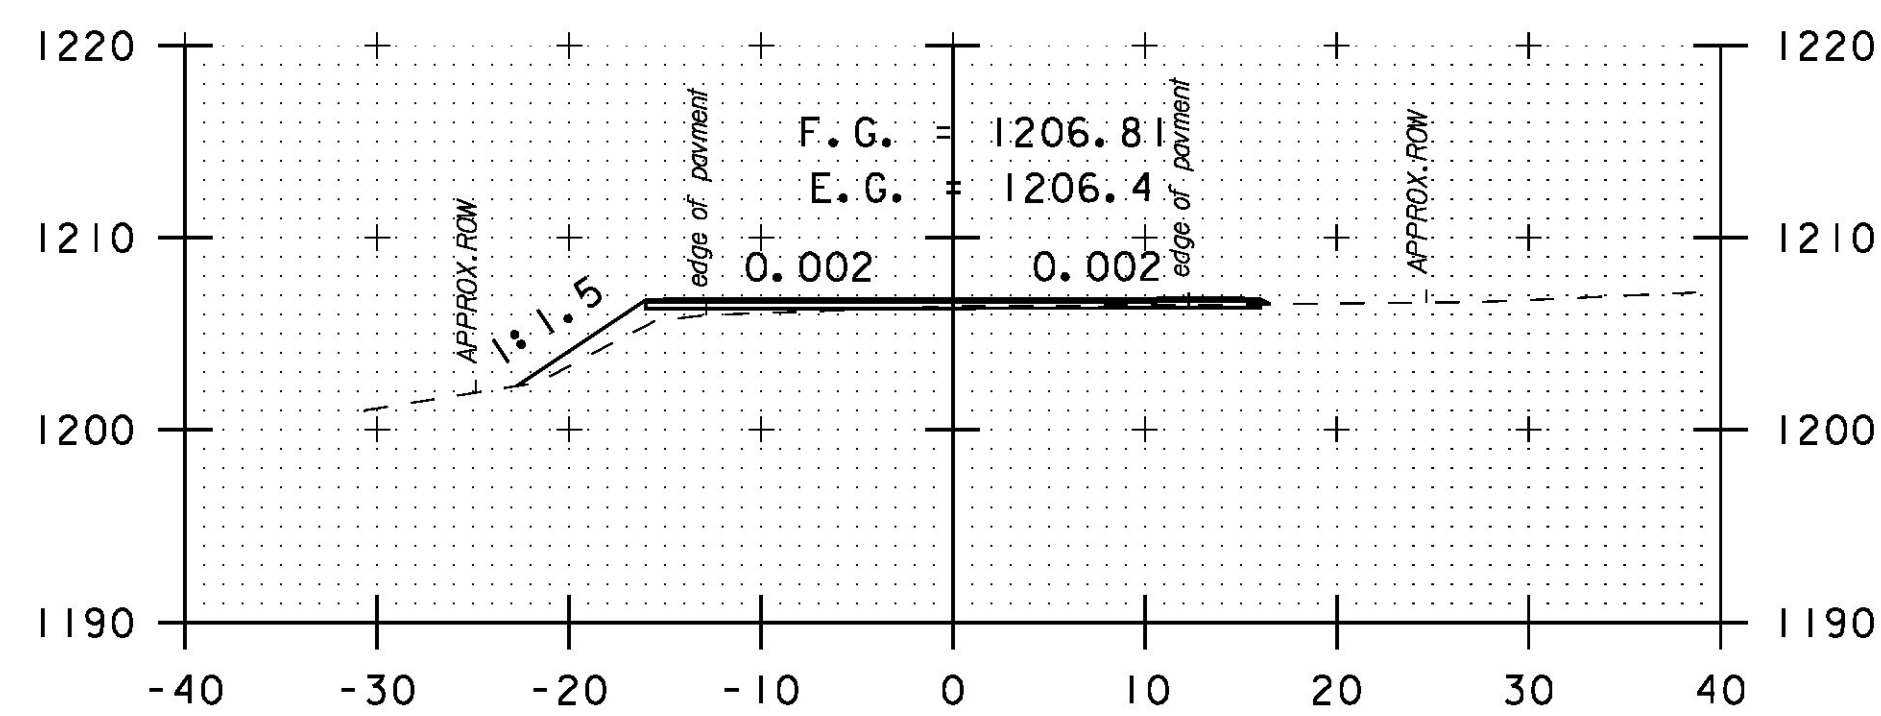


210+00  
DRIVE RT

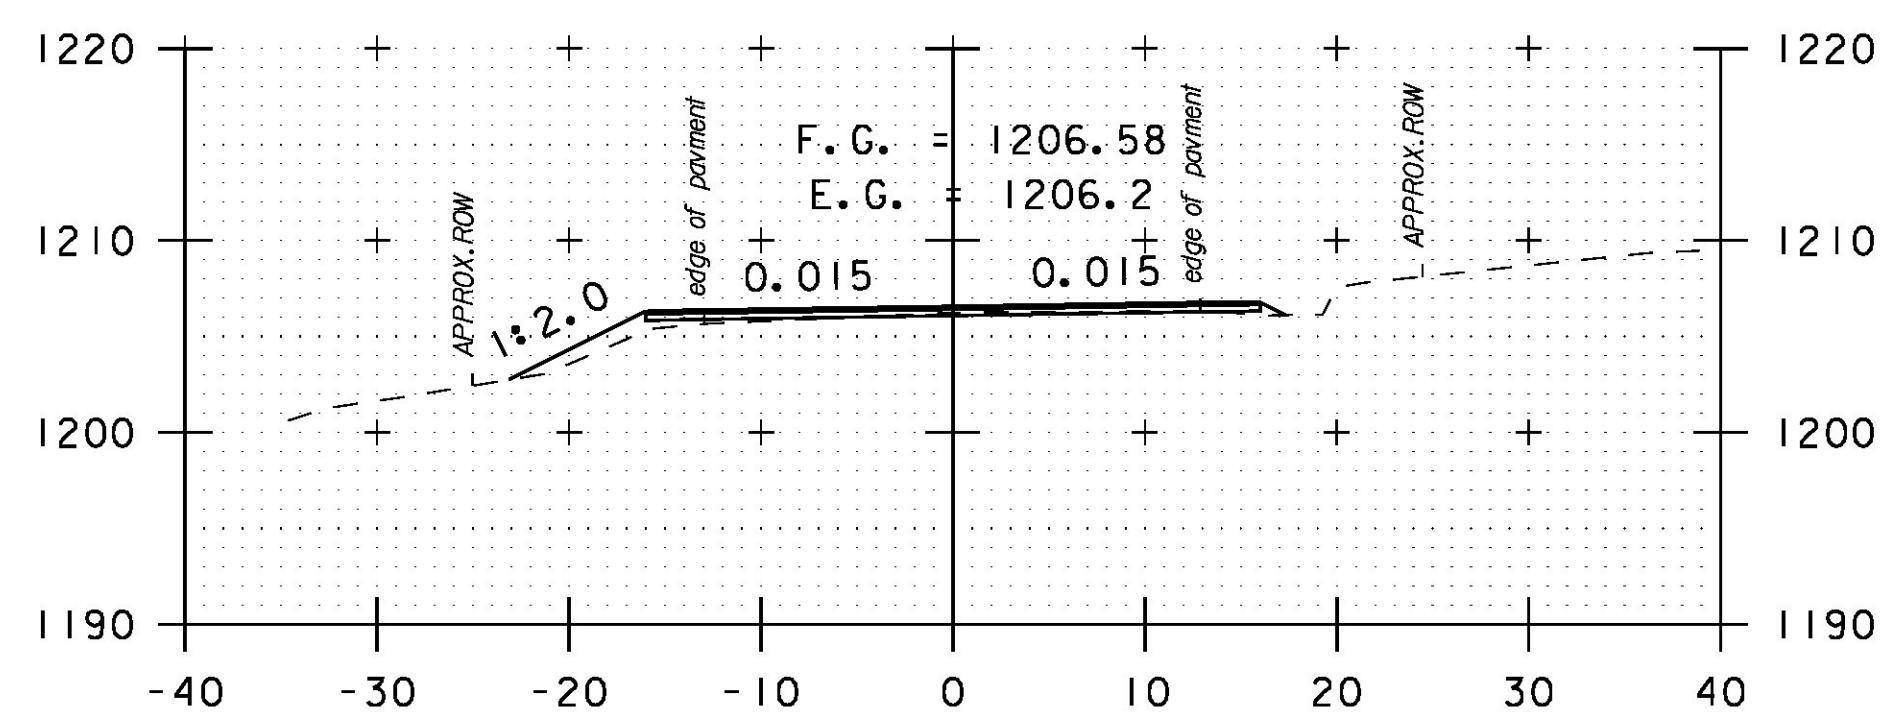


209+50

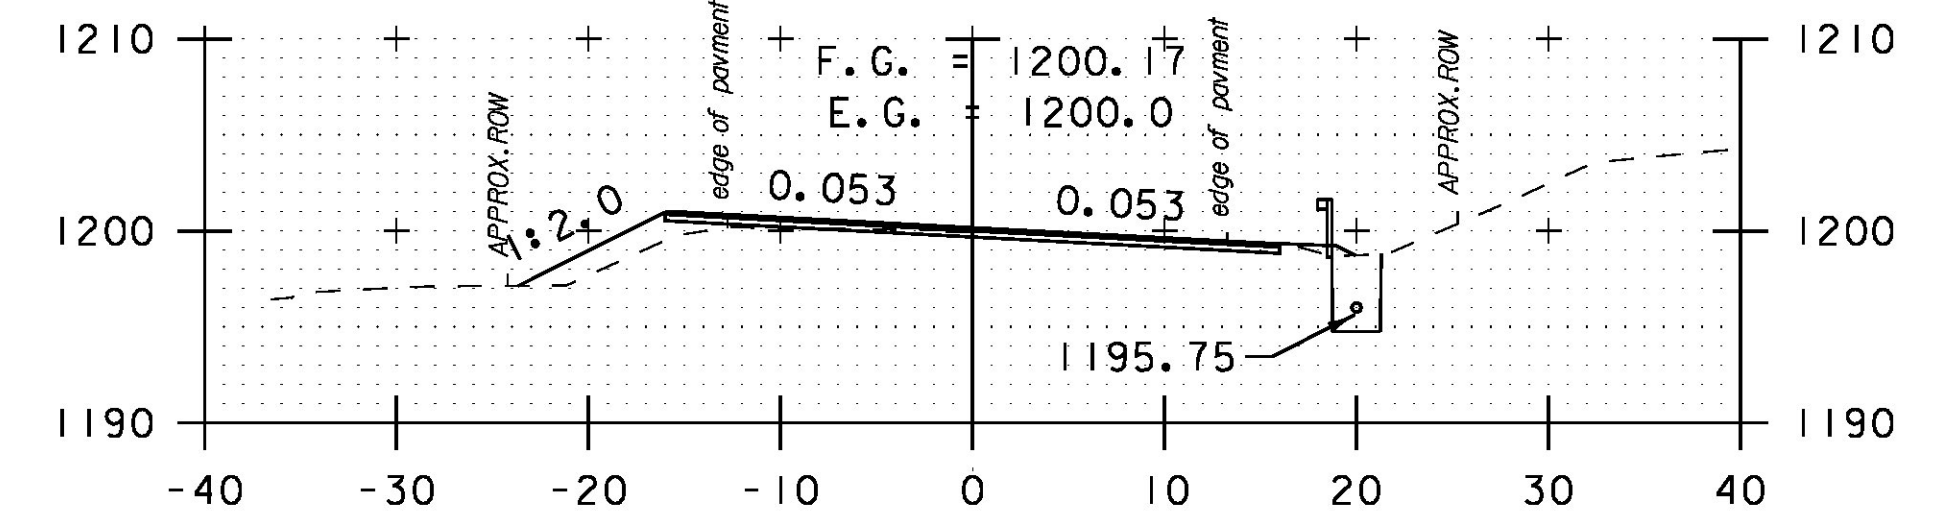


212+50

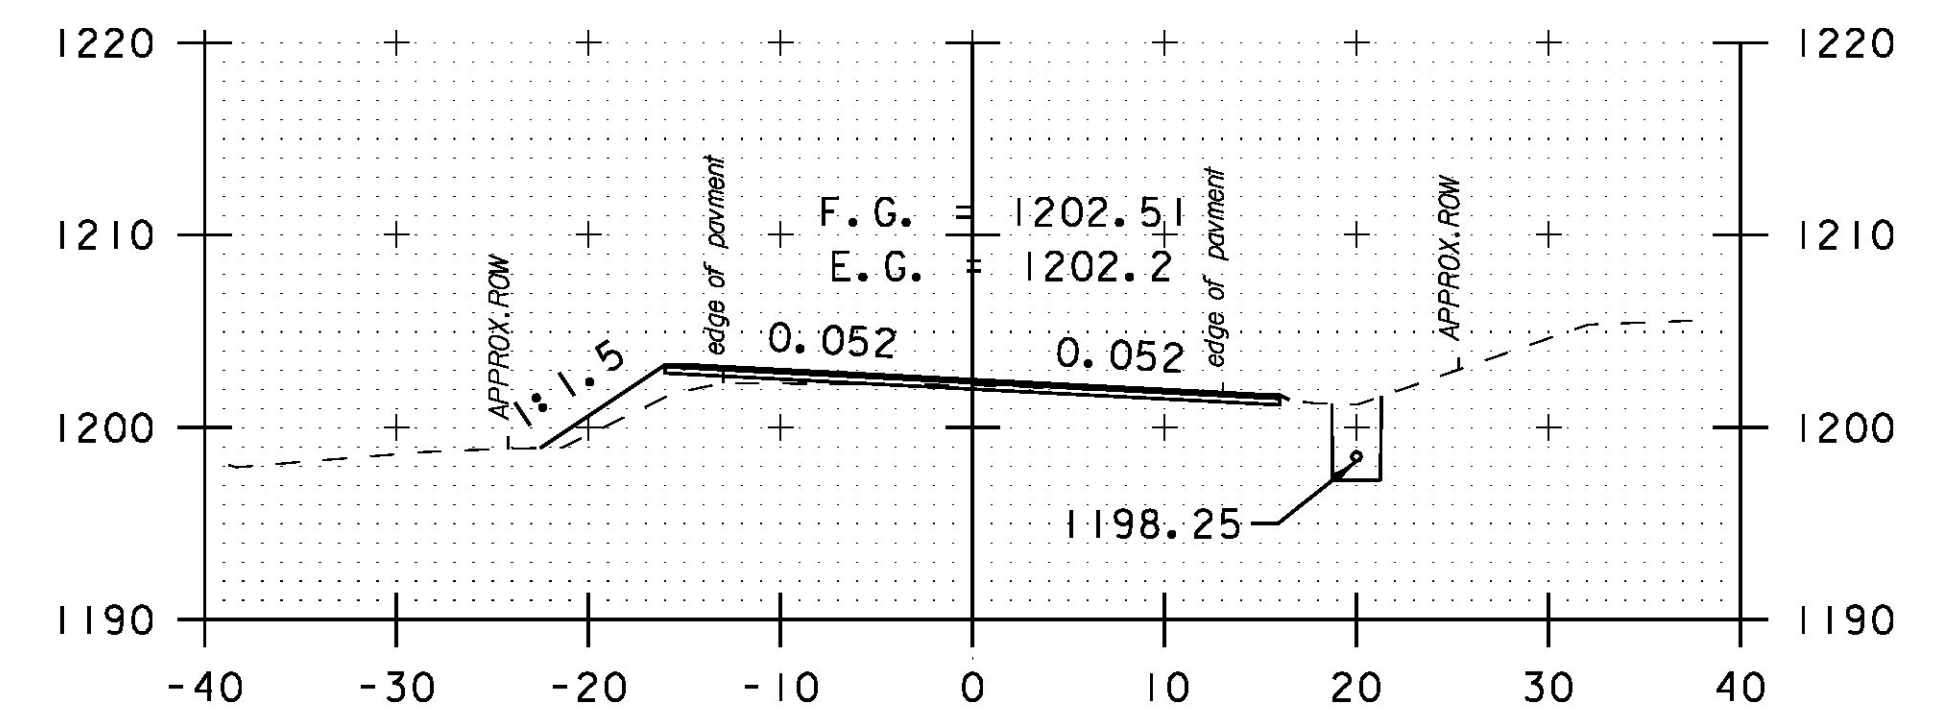


212+00

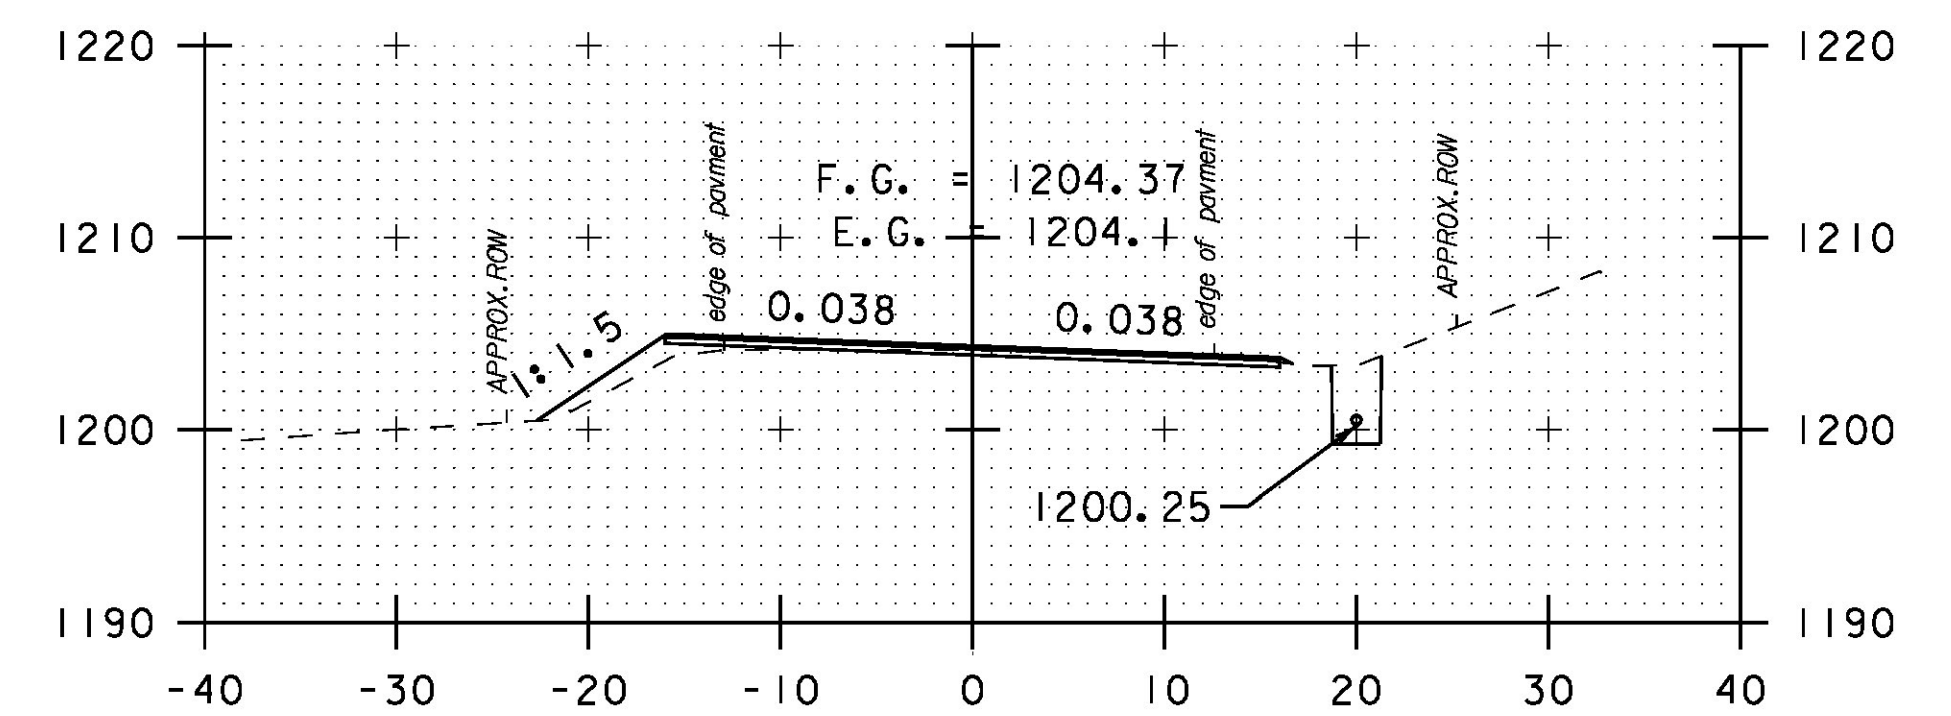

211+50

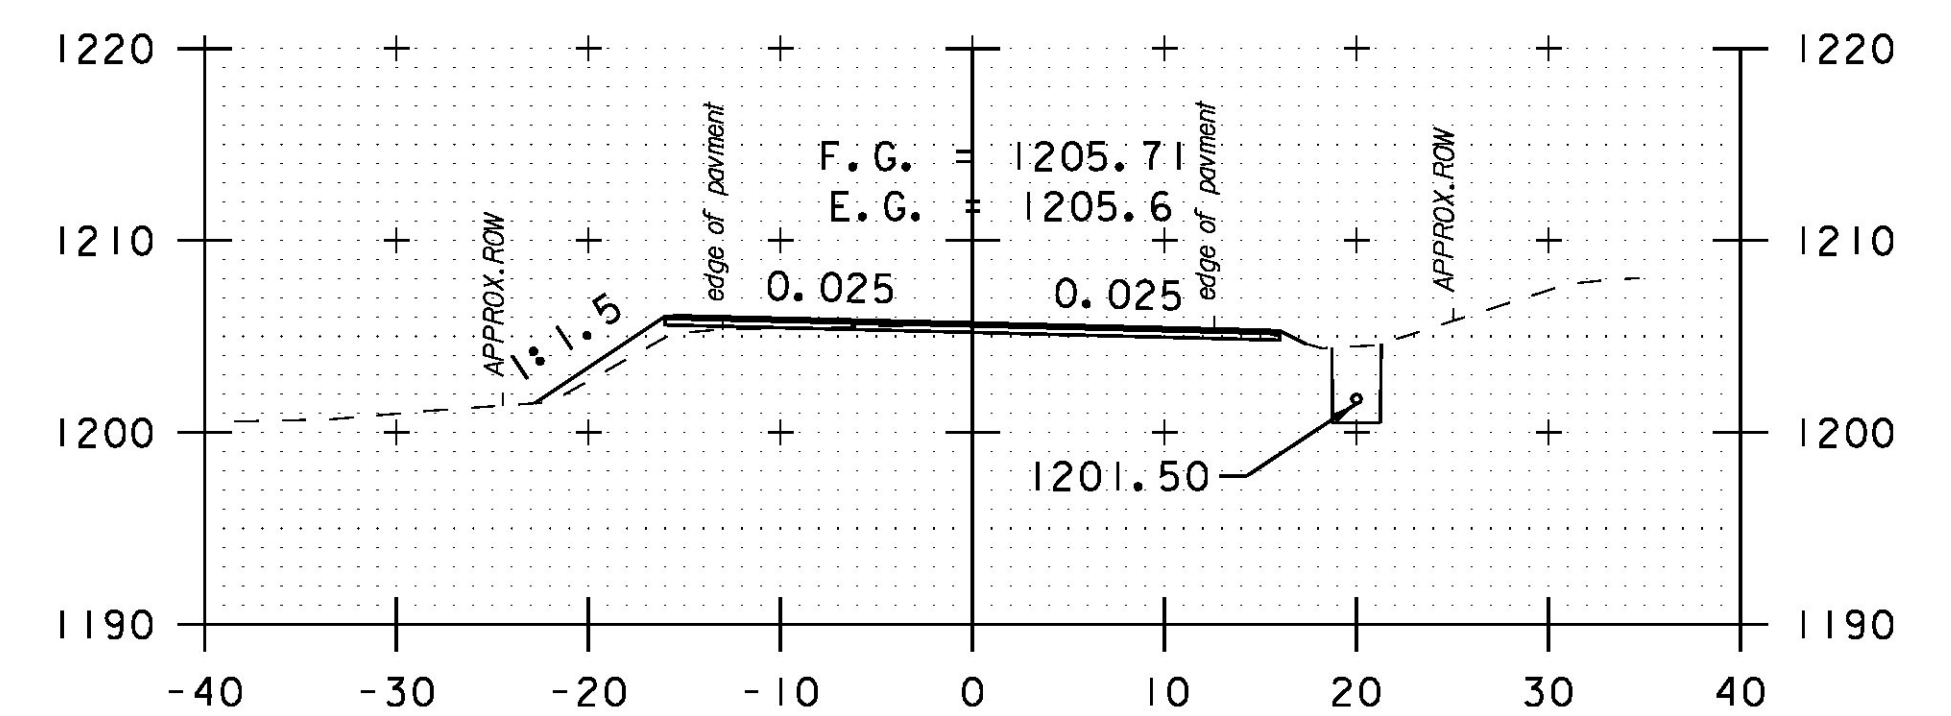

211+00

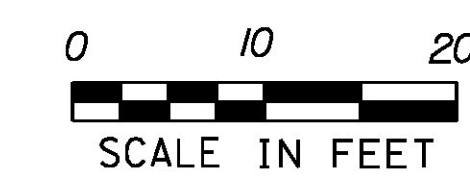

PROJECT NAME:	HANCOCK	PLOT DATE:	3/18/2015
PROJECT NUMBER:	STP 2923 (1)	DRAWN BY:	B. MARTIN
FILE NAME:	z10c252xs.dgn	CHECKED BY:	C. LATHROP
PROJECT LEADER:	C. LATHROP	CROSS SECTION SHEET	38
DESIGNED BY:	B. MARTIN	SHEET	165 OF 207