




213+84
BRIDGE #21

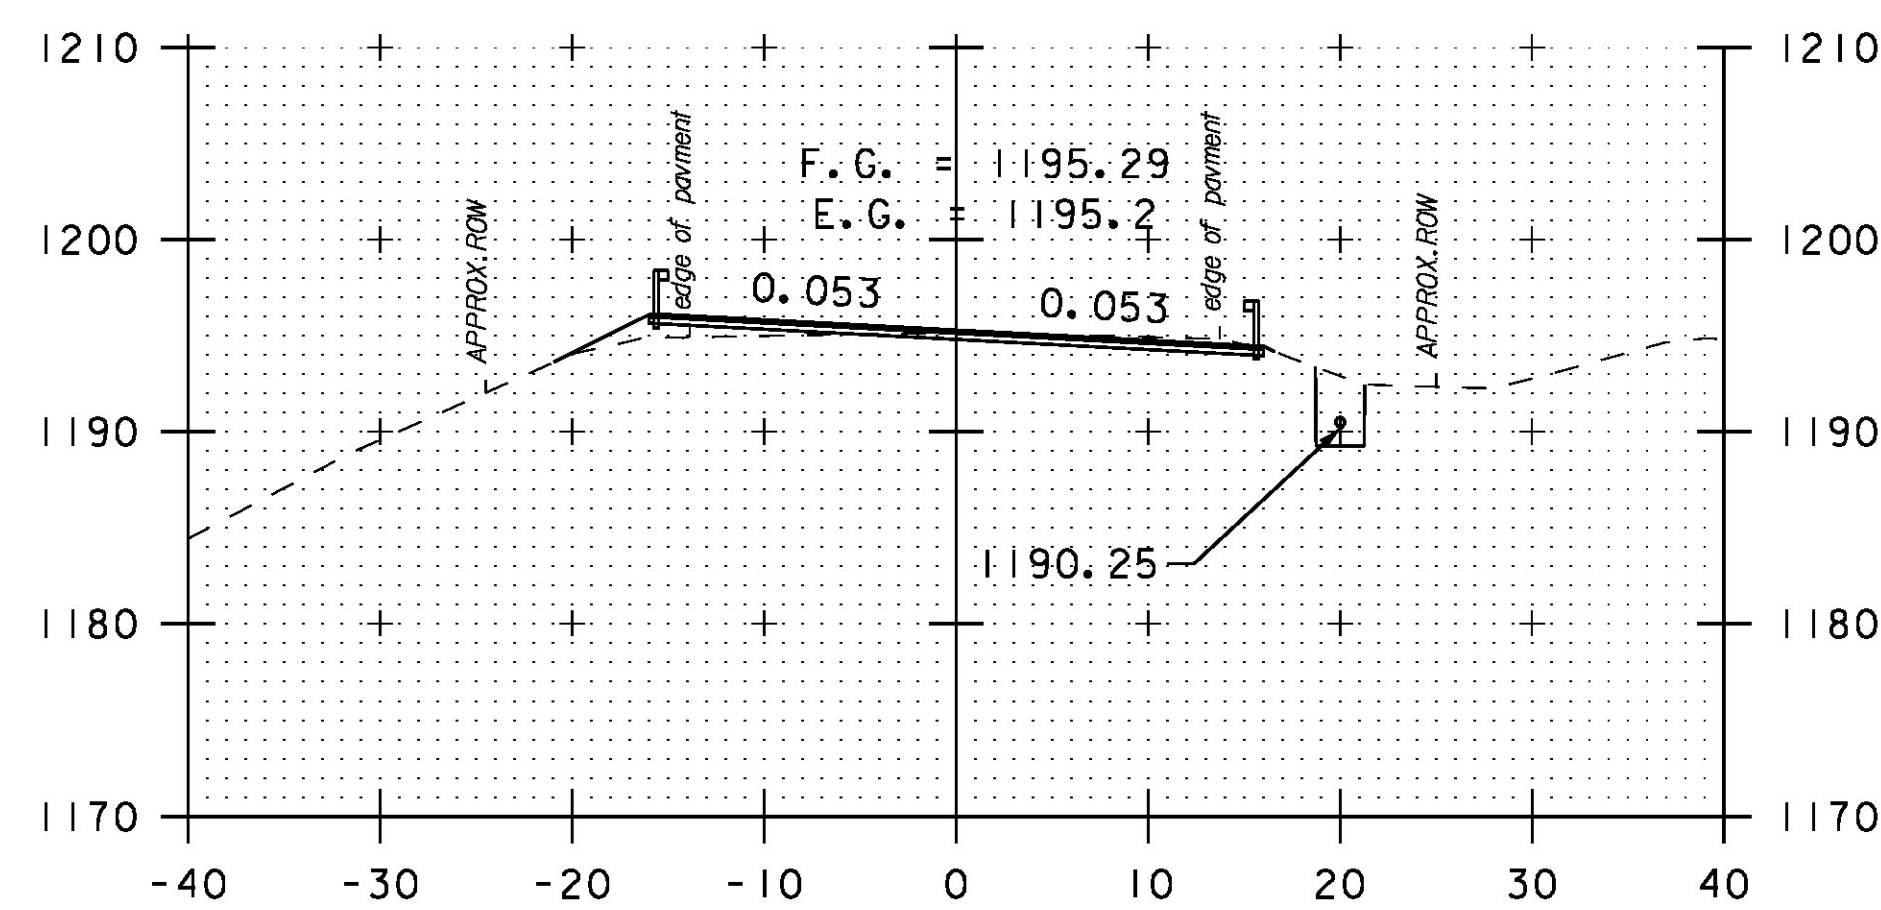


213+50

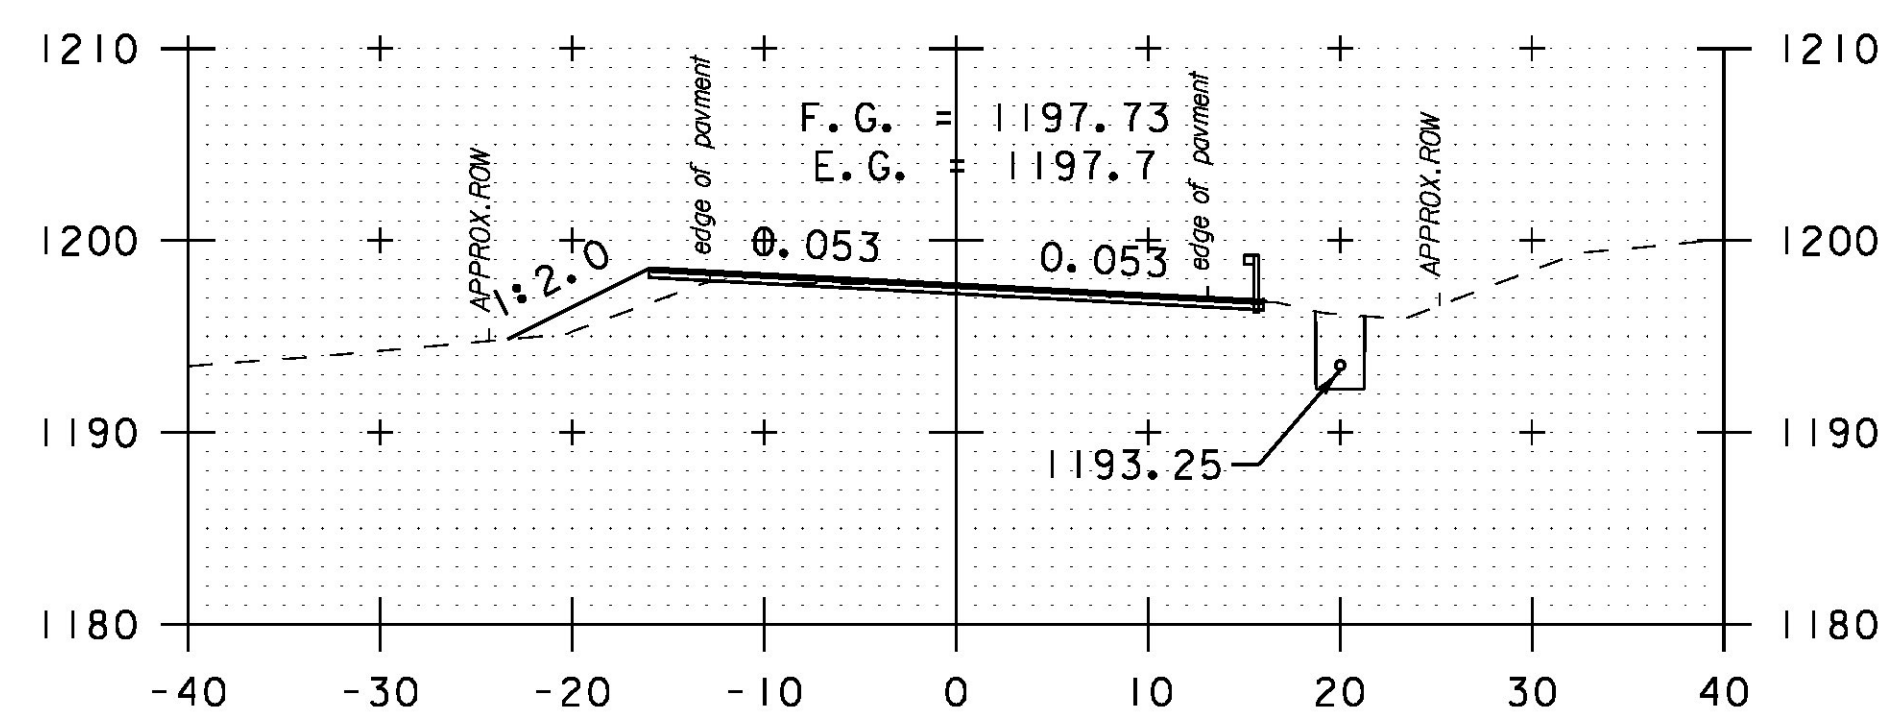


213+00

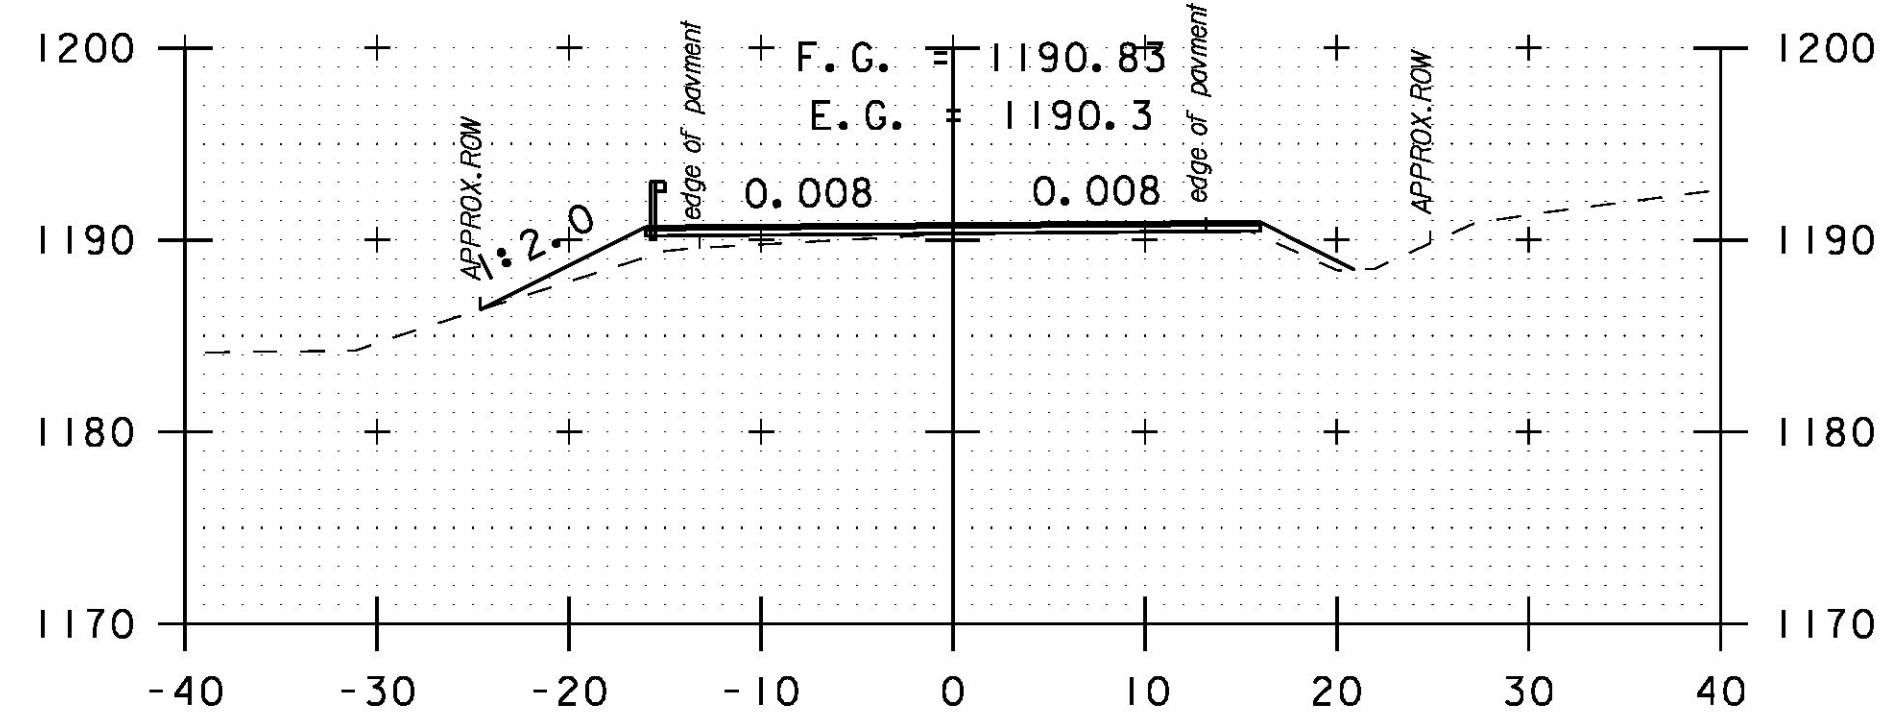


215+00

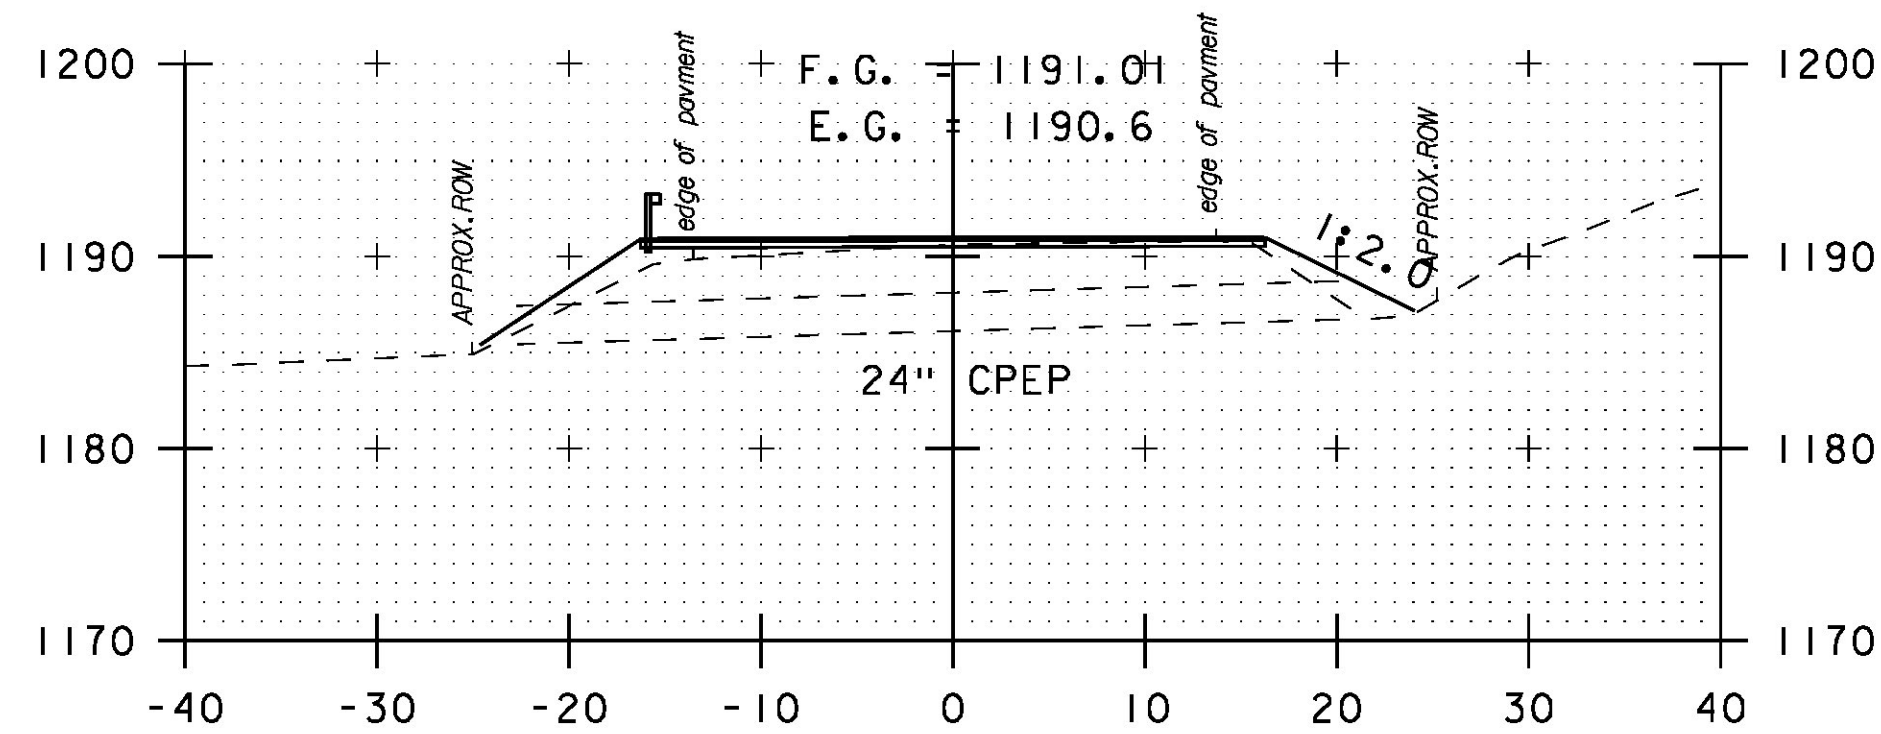


214+83

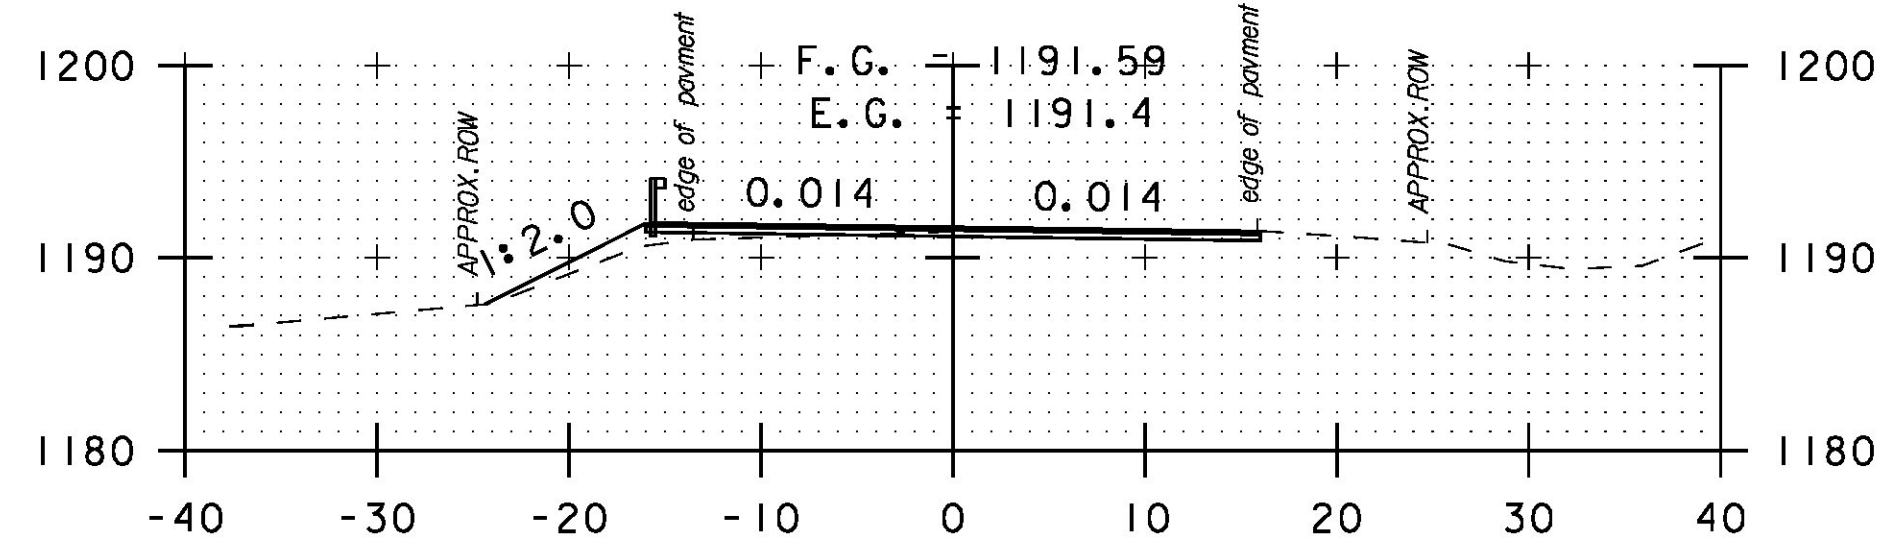


214+50

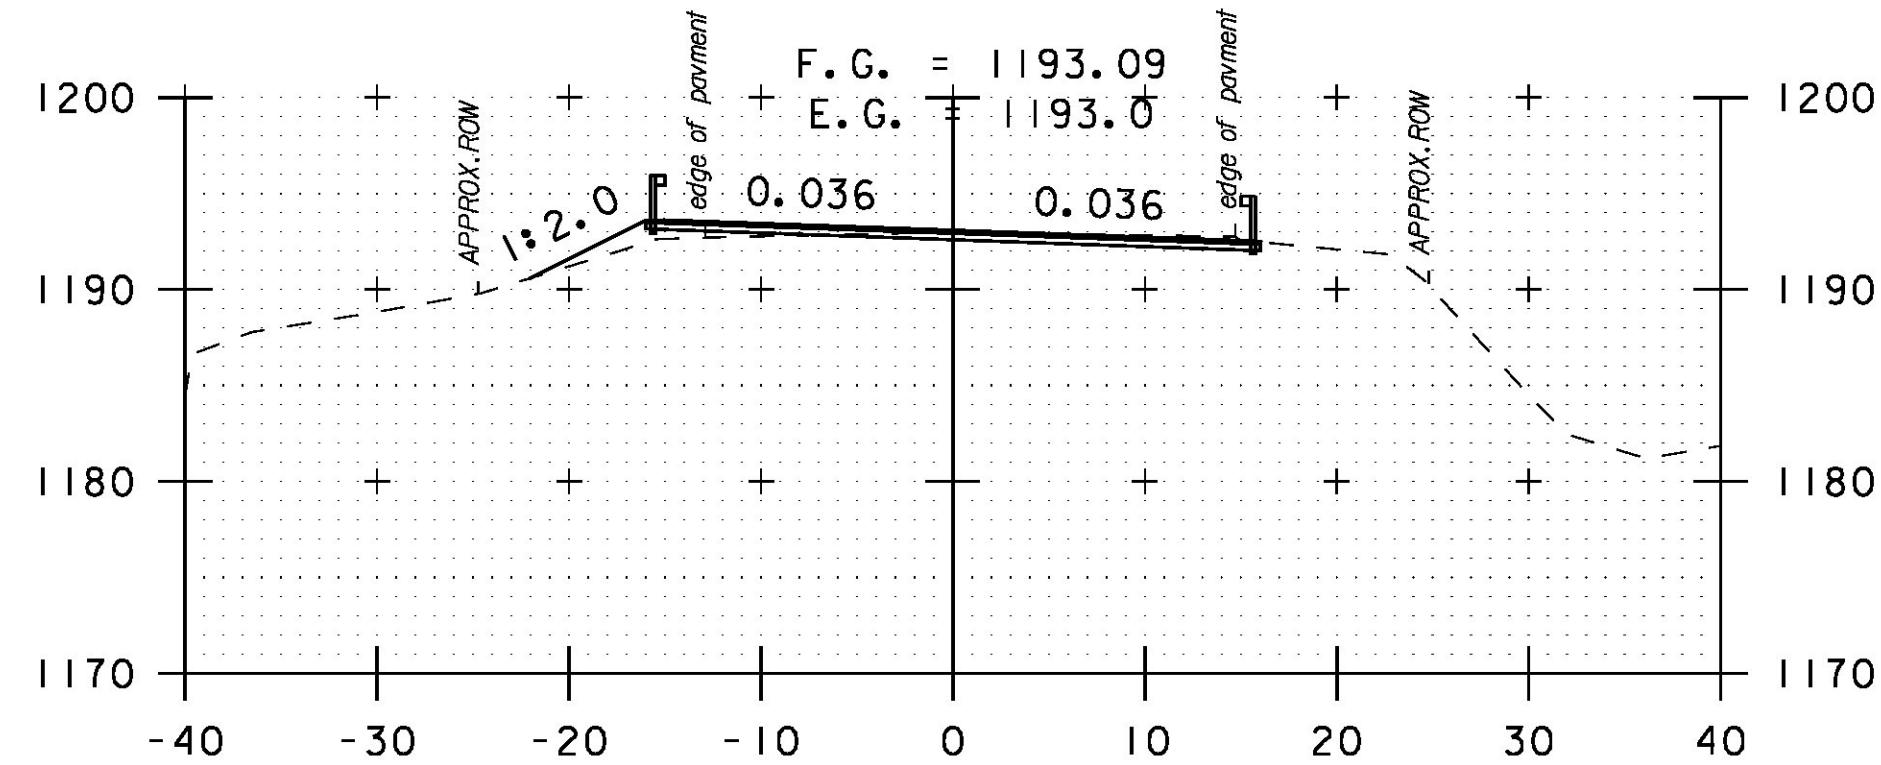


214+00

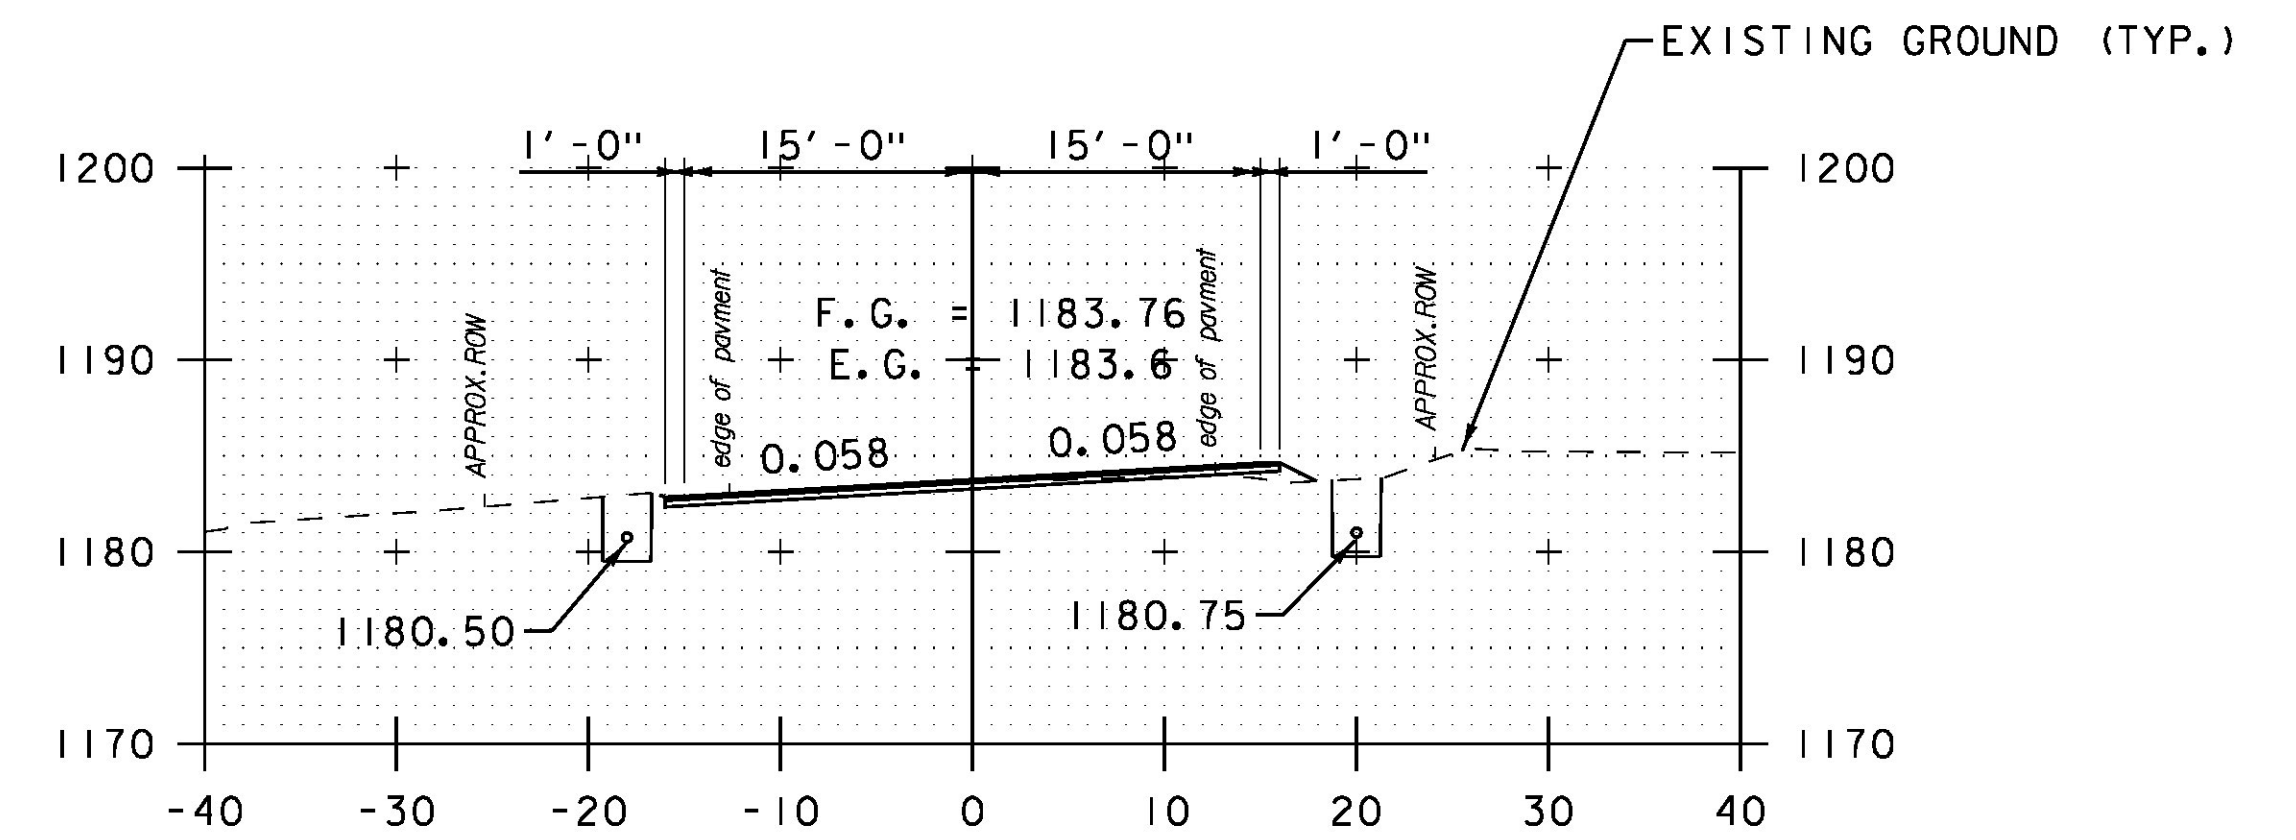


217+00

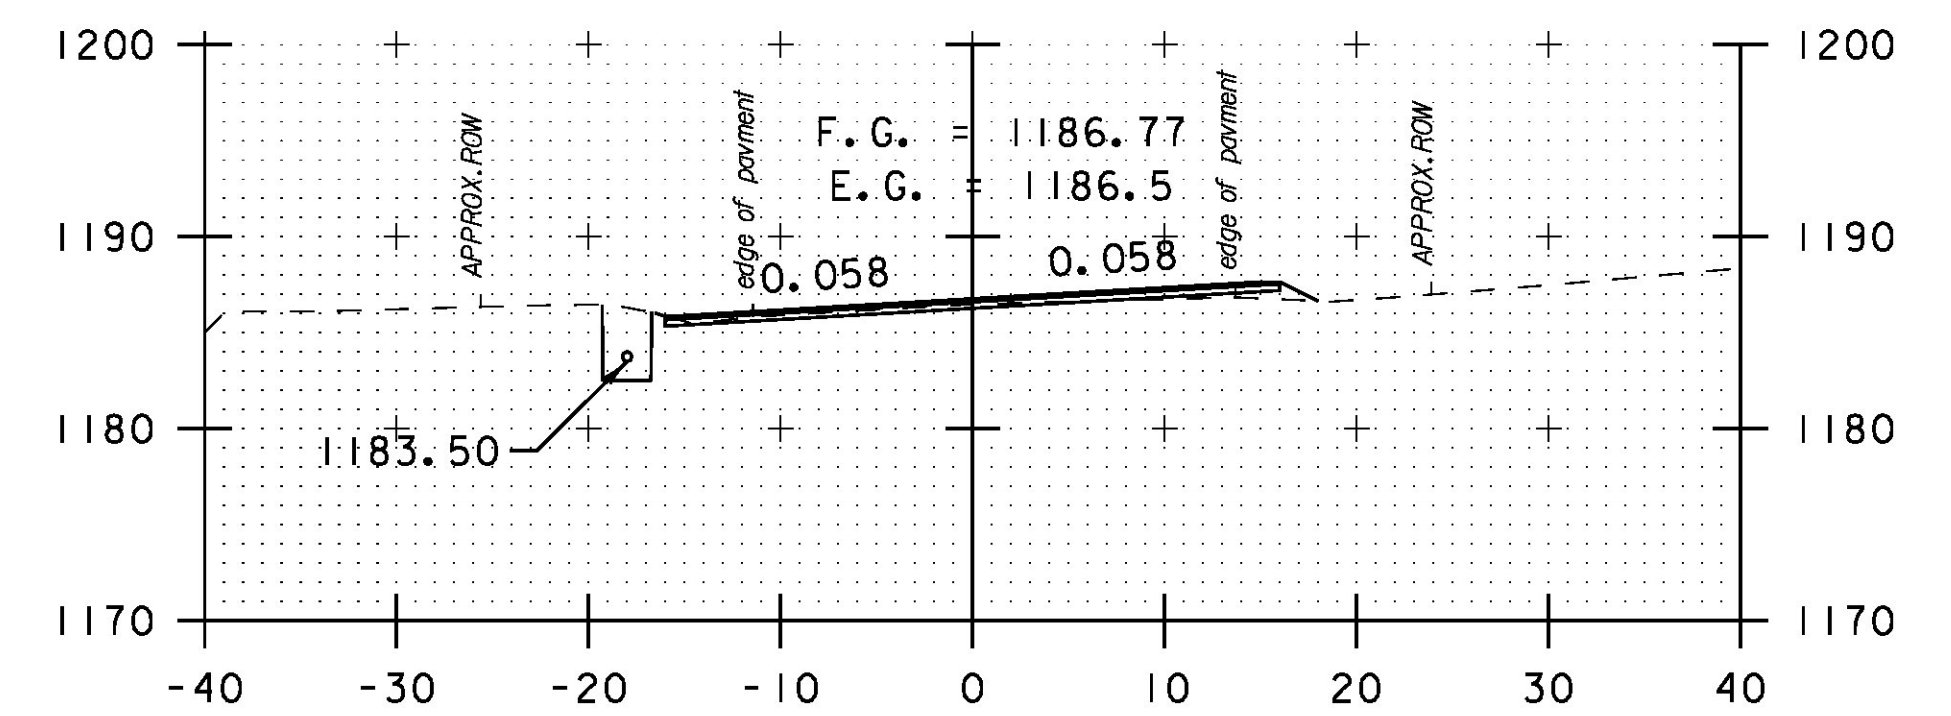

216+50

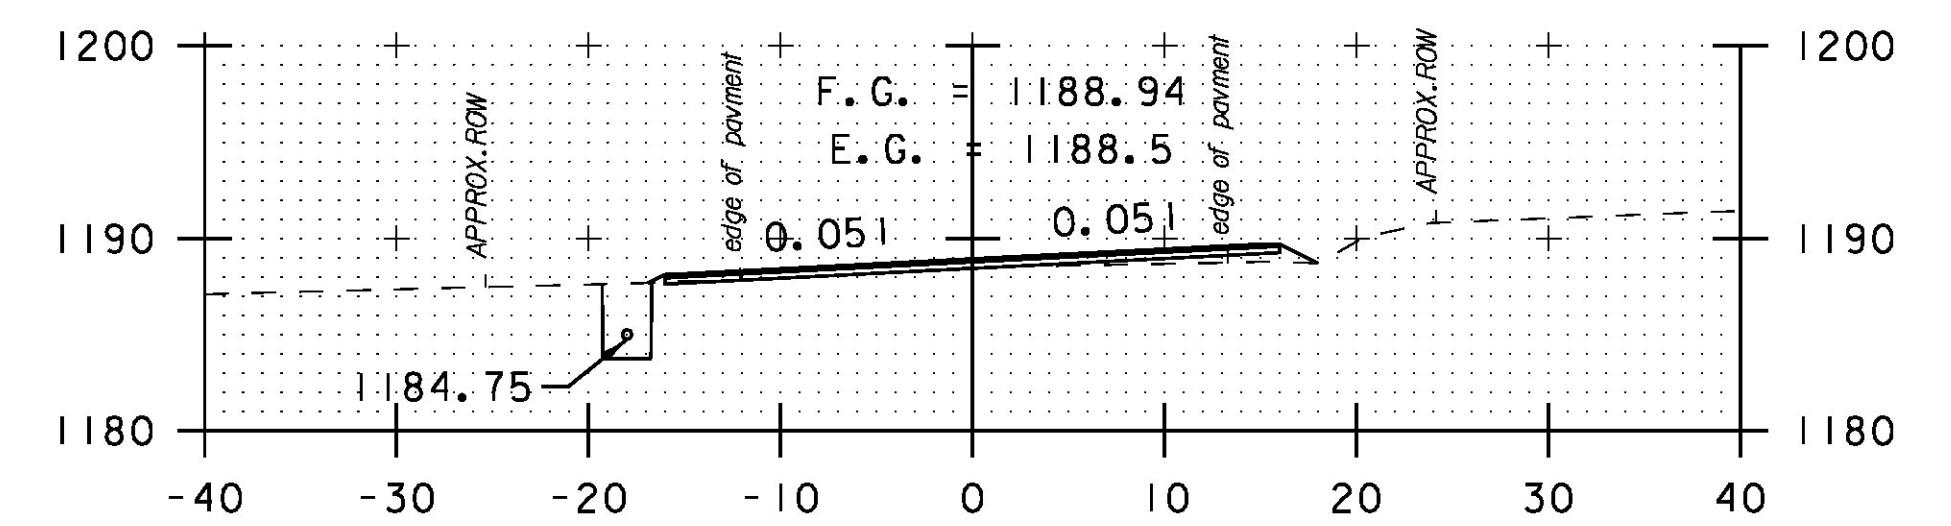

216+00

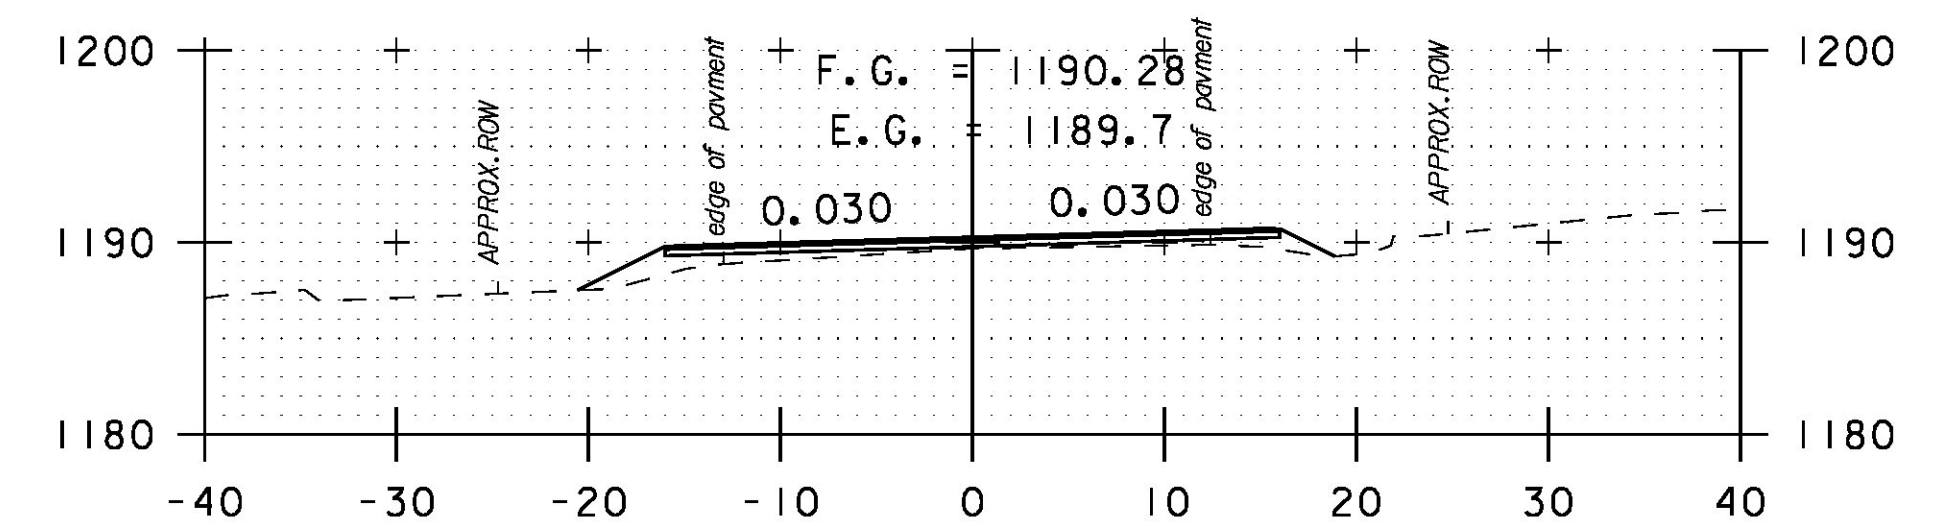

215+50



PROJECT NAME: HANCOCK
PROJECT NUMBER: STP 2923 (1)

FILE NAME: z10c252xs.dgn
PROJECT LEADER: C. LATHROP
DESIGNED BY: B. MARTIN
CROSS SECTION SHEET 39

PLOT DATE: 3/18/2015
DRAWN BY: B. MARTIN
CHECKED BY: C. LATHROP
SHEET 166 OF 207