




222+50

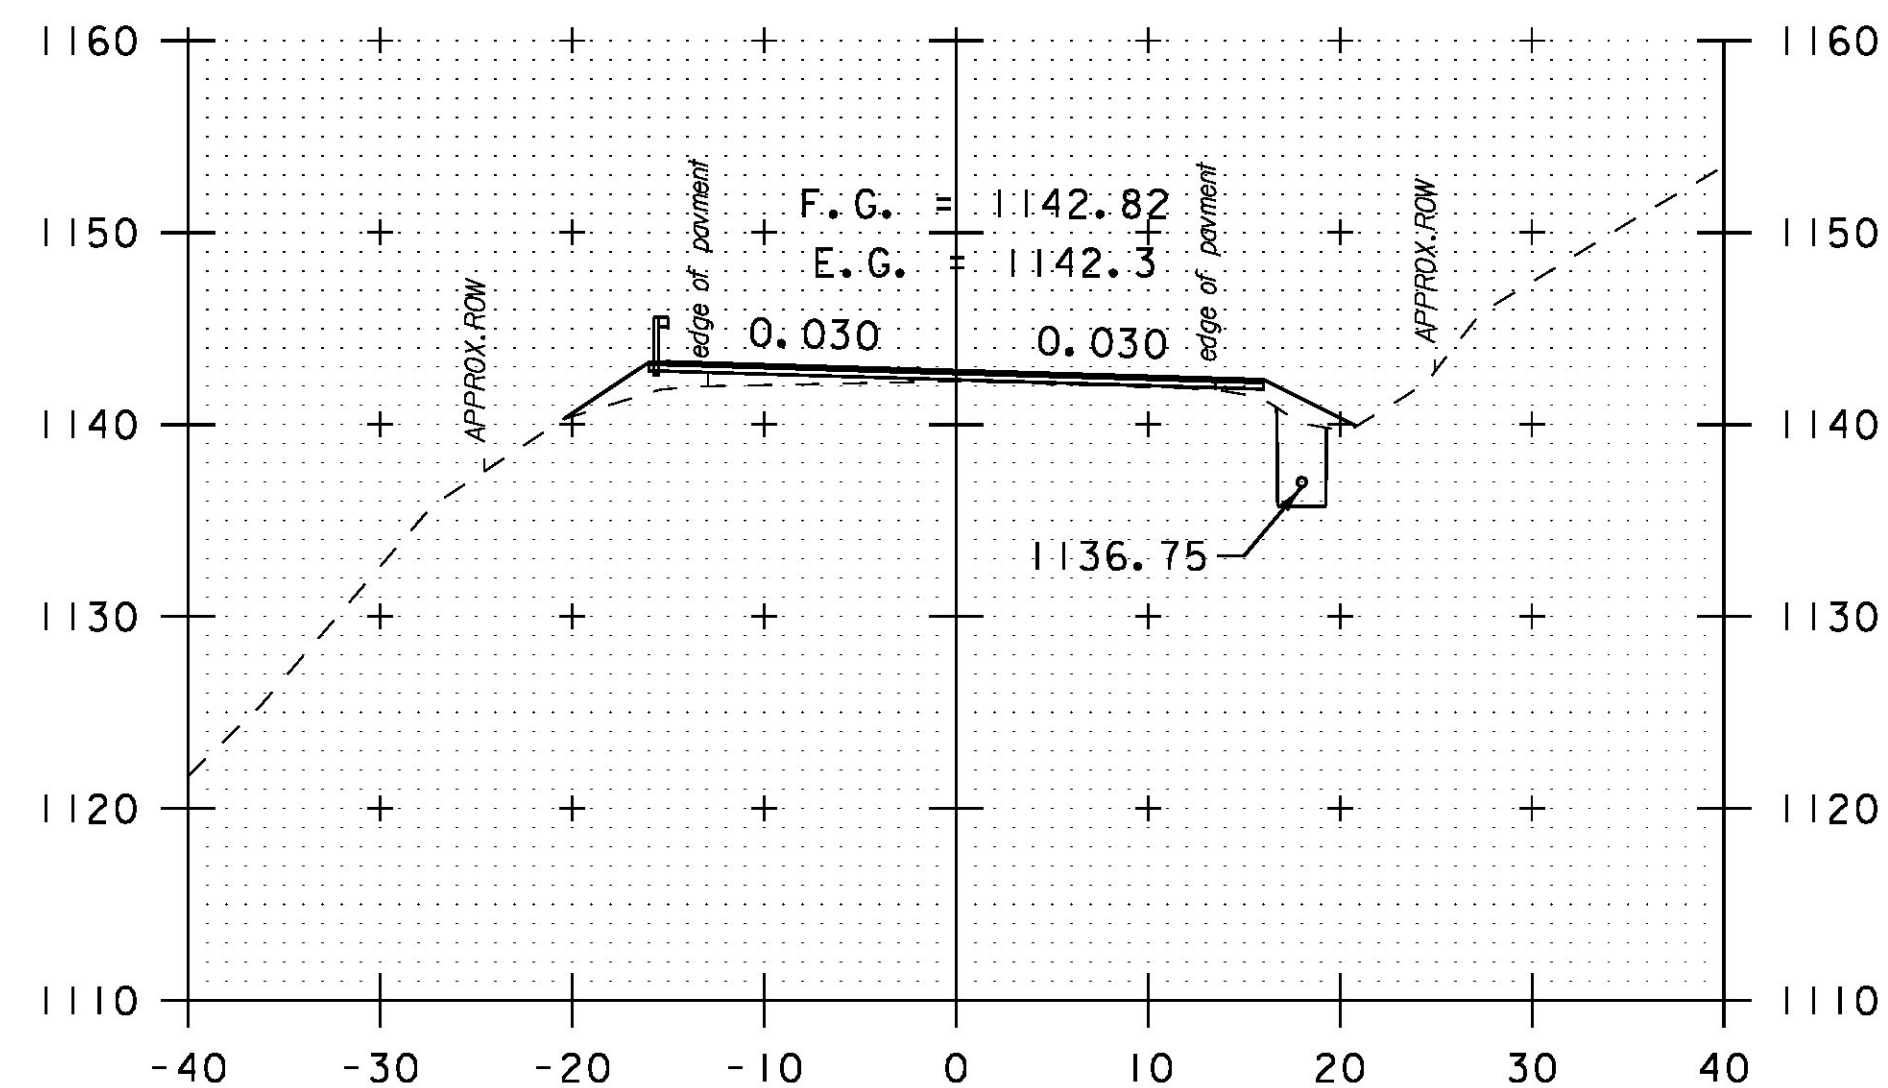


222+00

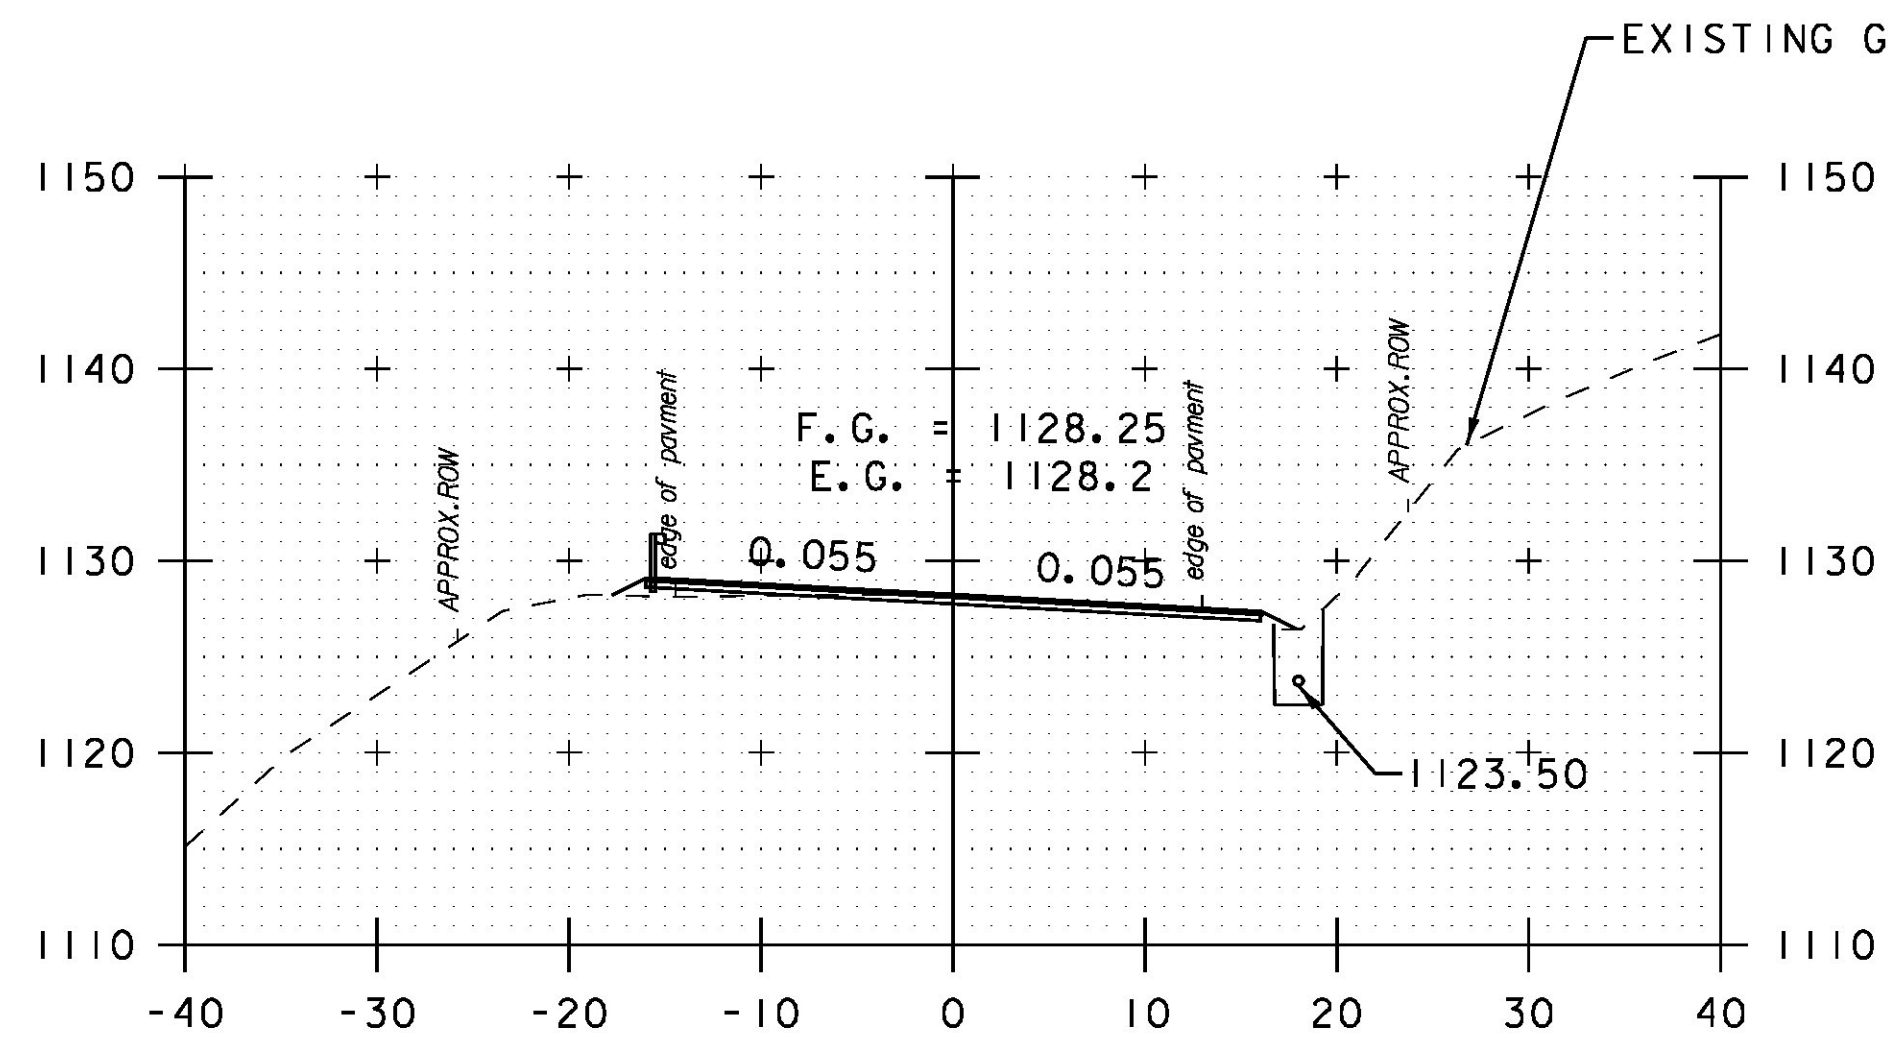


224+00

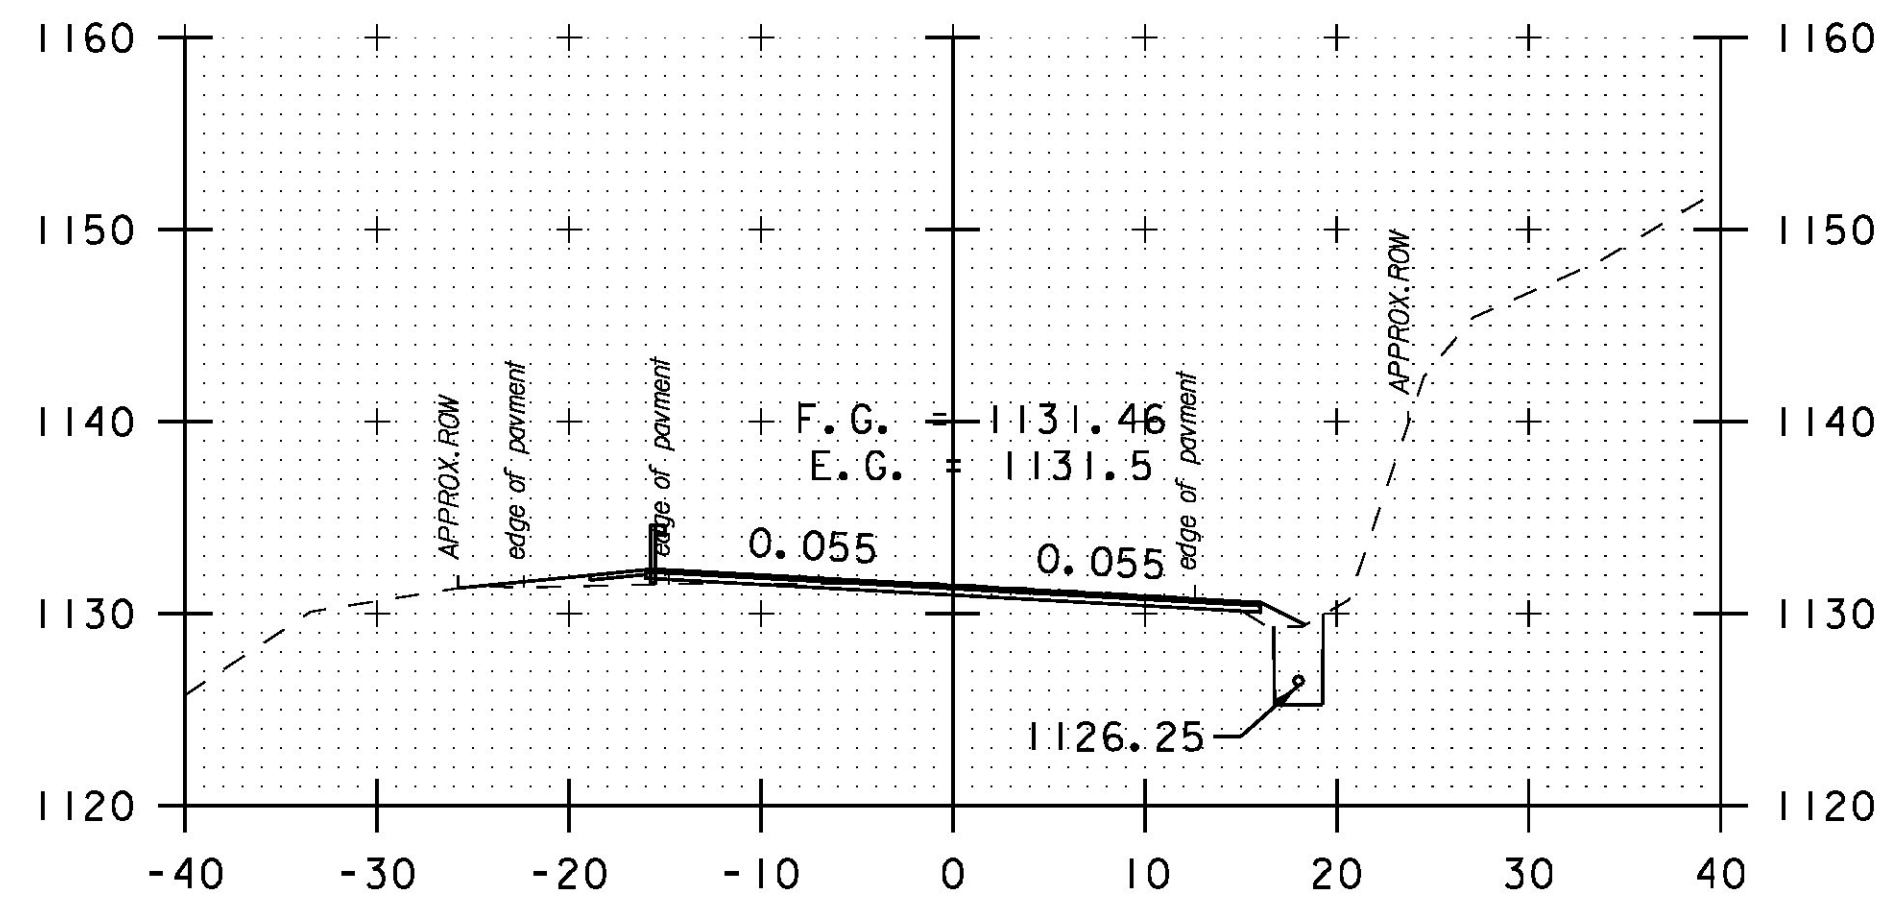


223+50  
TH #2 LT

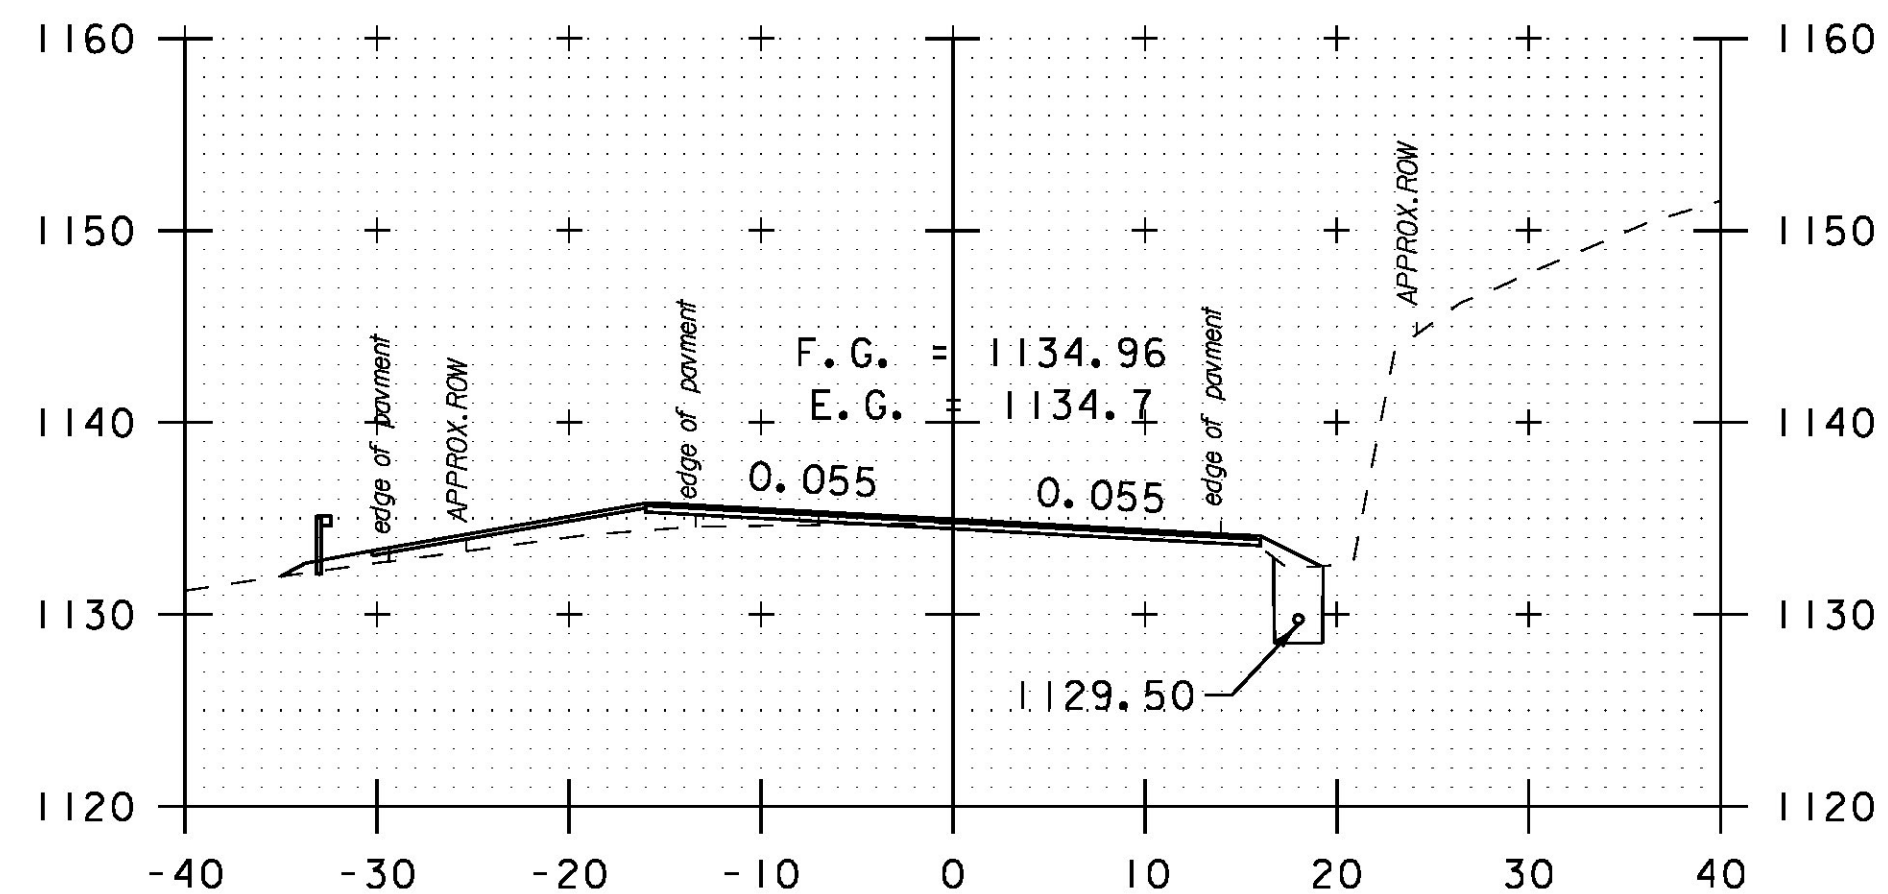


223+00  
TH #2 LT

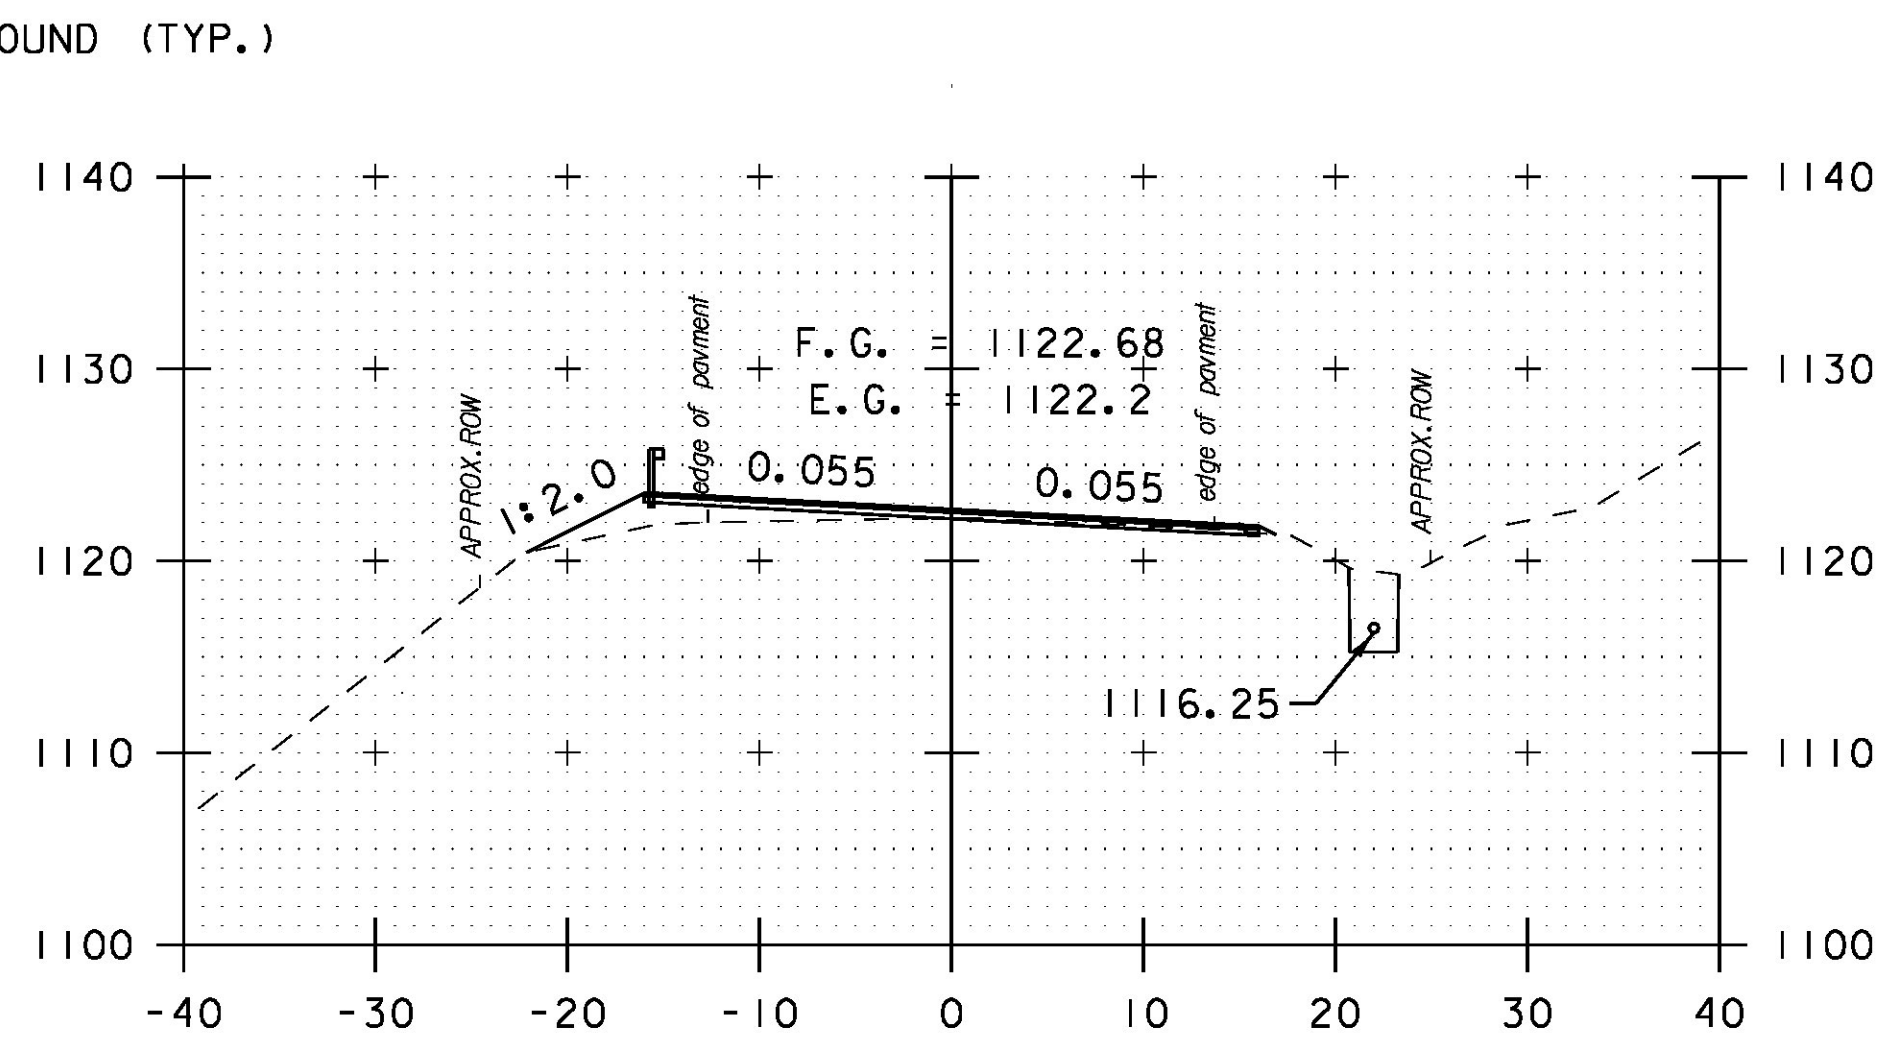


225+00

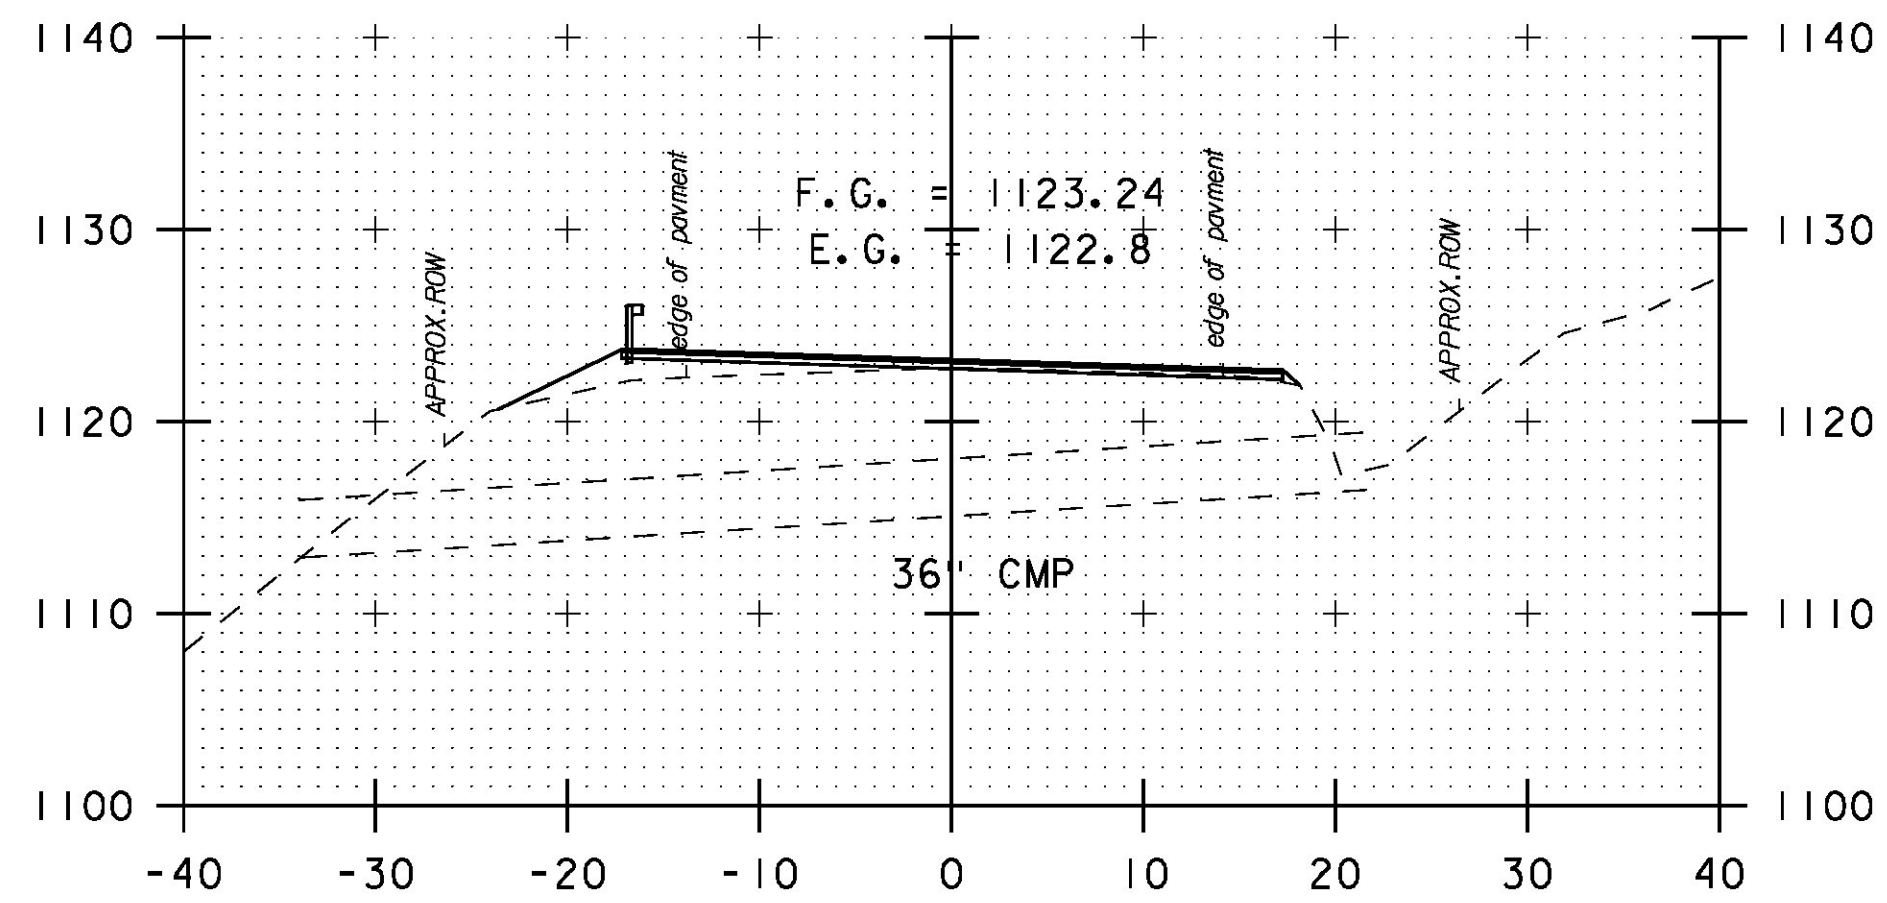

224+89  
SKEWED

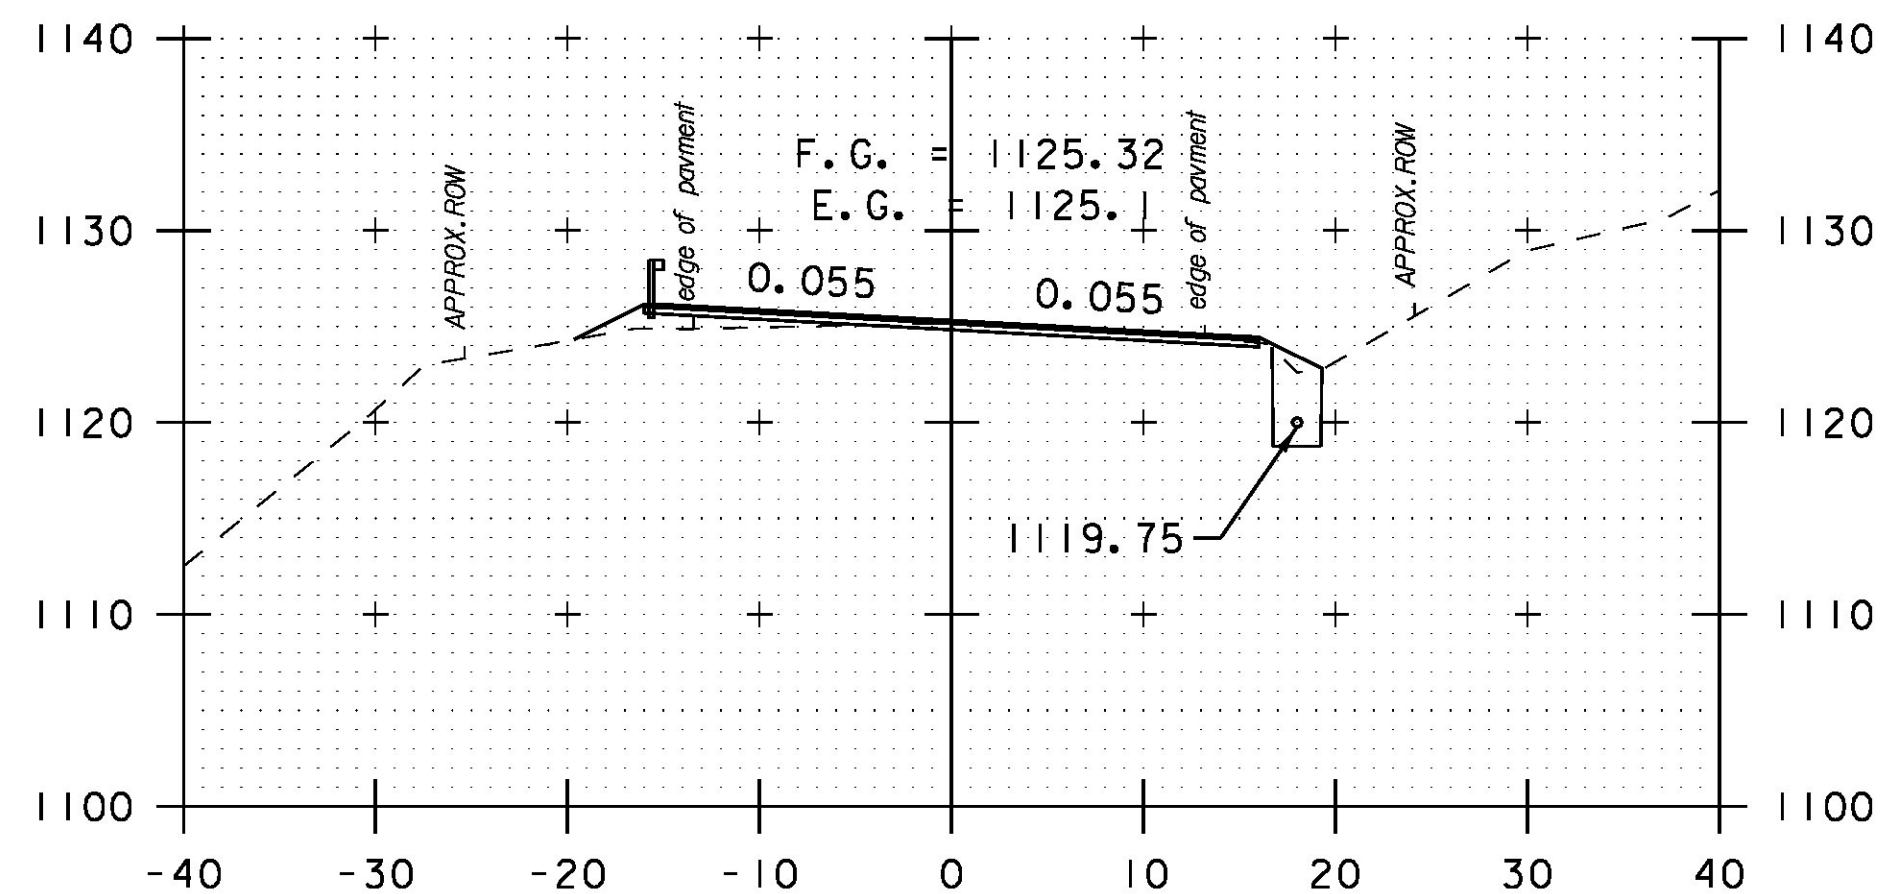

224+50

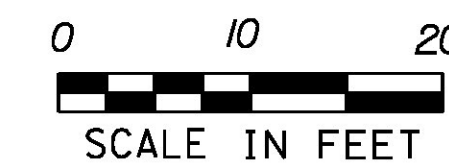

PROJECT NAME:	HANCOCK
PROJECT NUMBER:	STP 2923 (1)
FILE NAME:	z10c252xs.dgn
PROJECT LEADER:	C. LATHROP
DESIGNED BY:	B. MARTIN
CROSS SECTION SHEET:	41
PLOT DATE:	3/18/2015
DRAWN BY:	B. MARTIN
CHECKED BY:	C. LATHROP
SHEET:	168 OF 207