




231+00

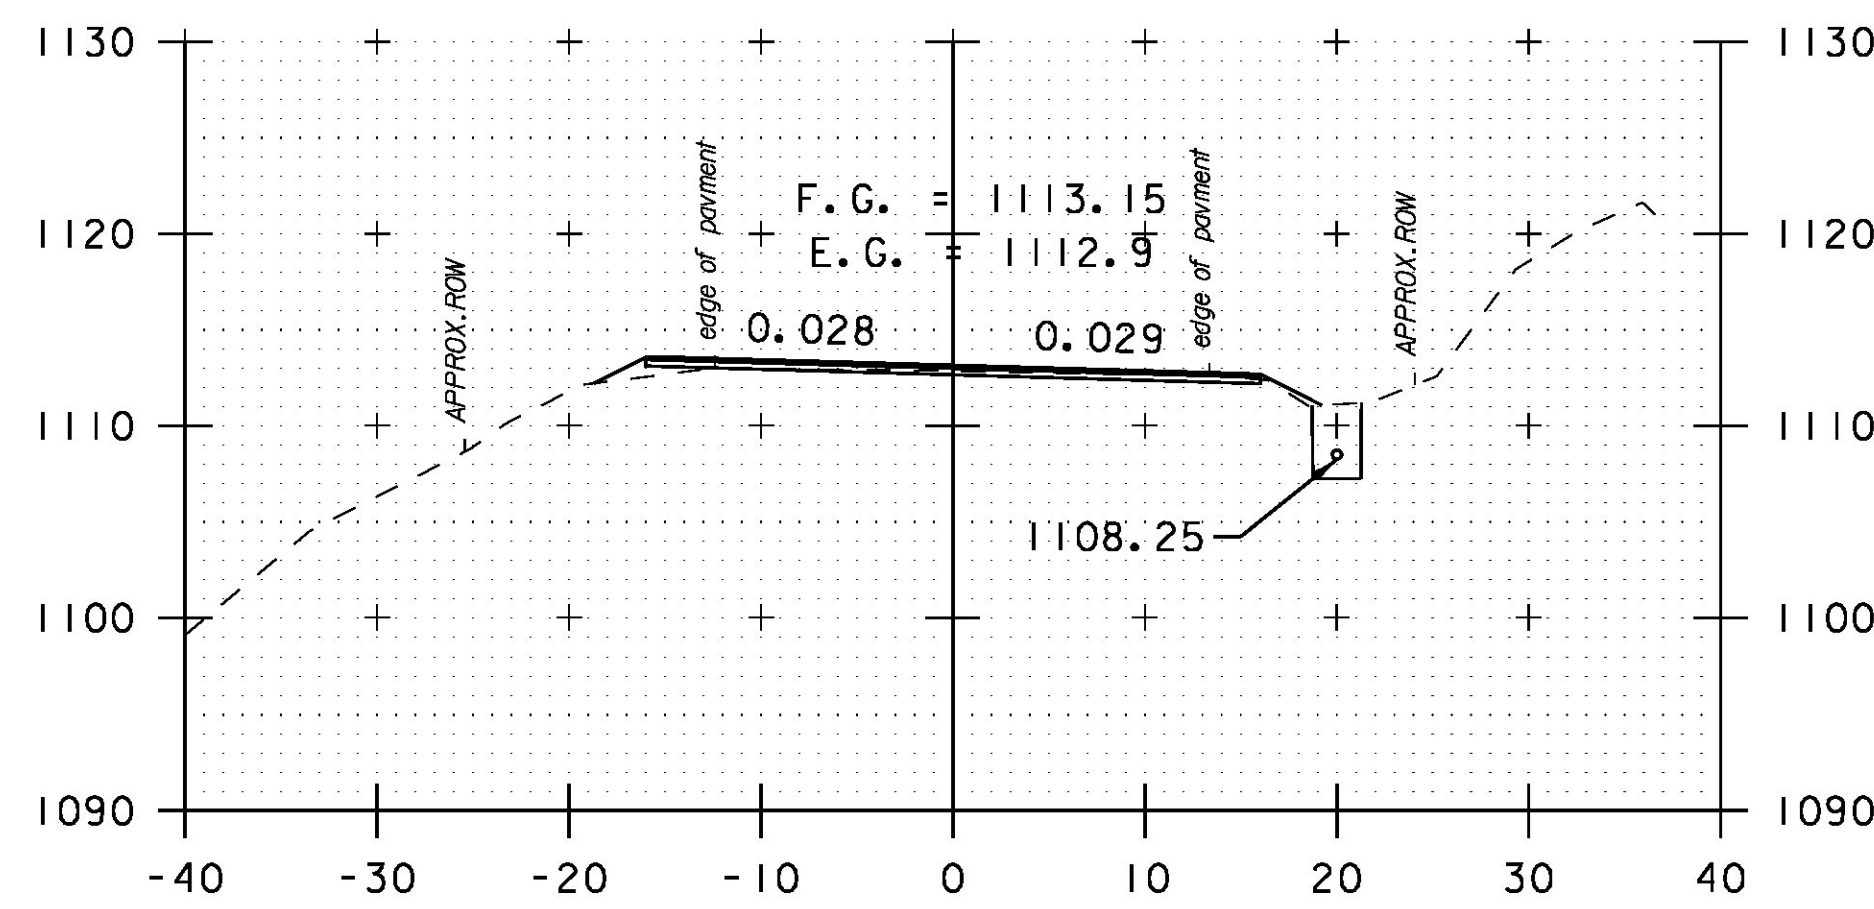


232+50

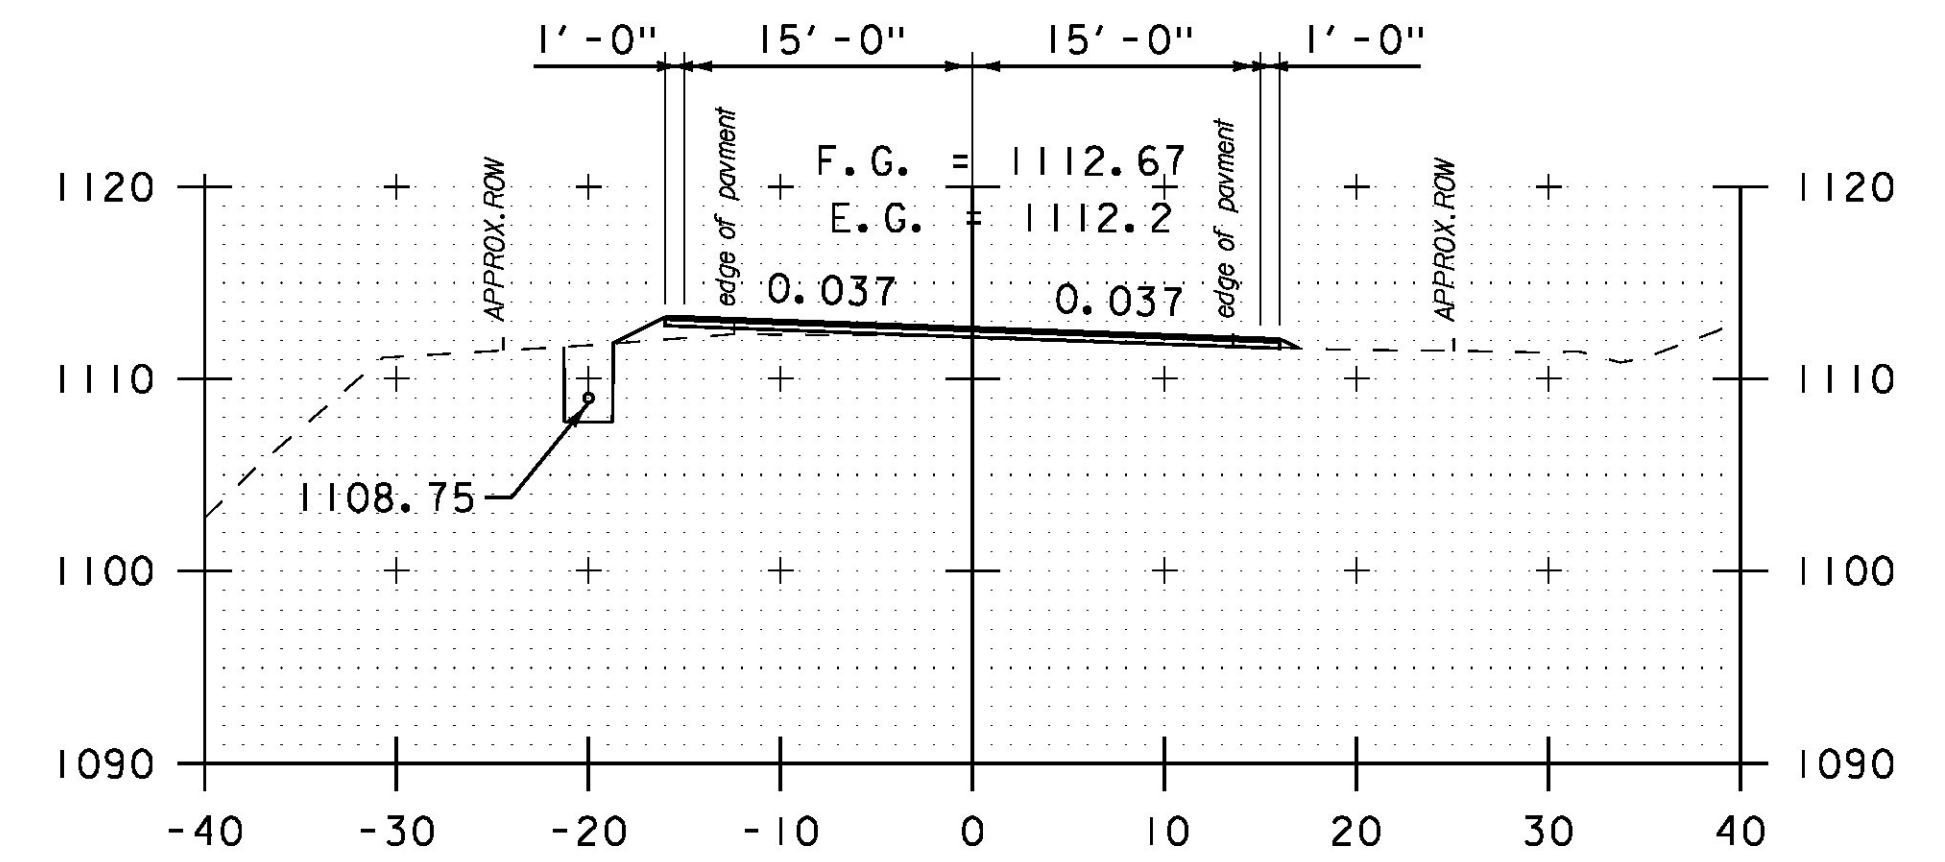


234+00

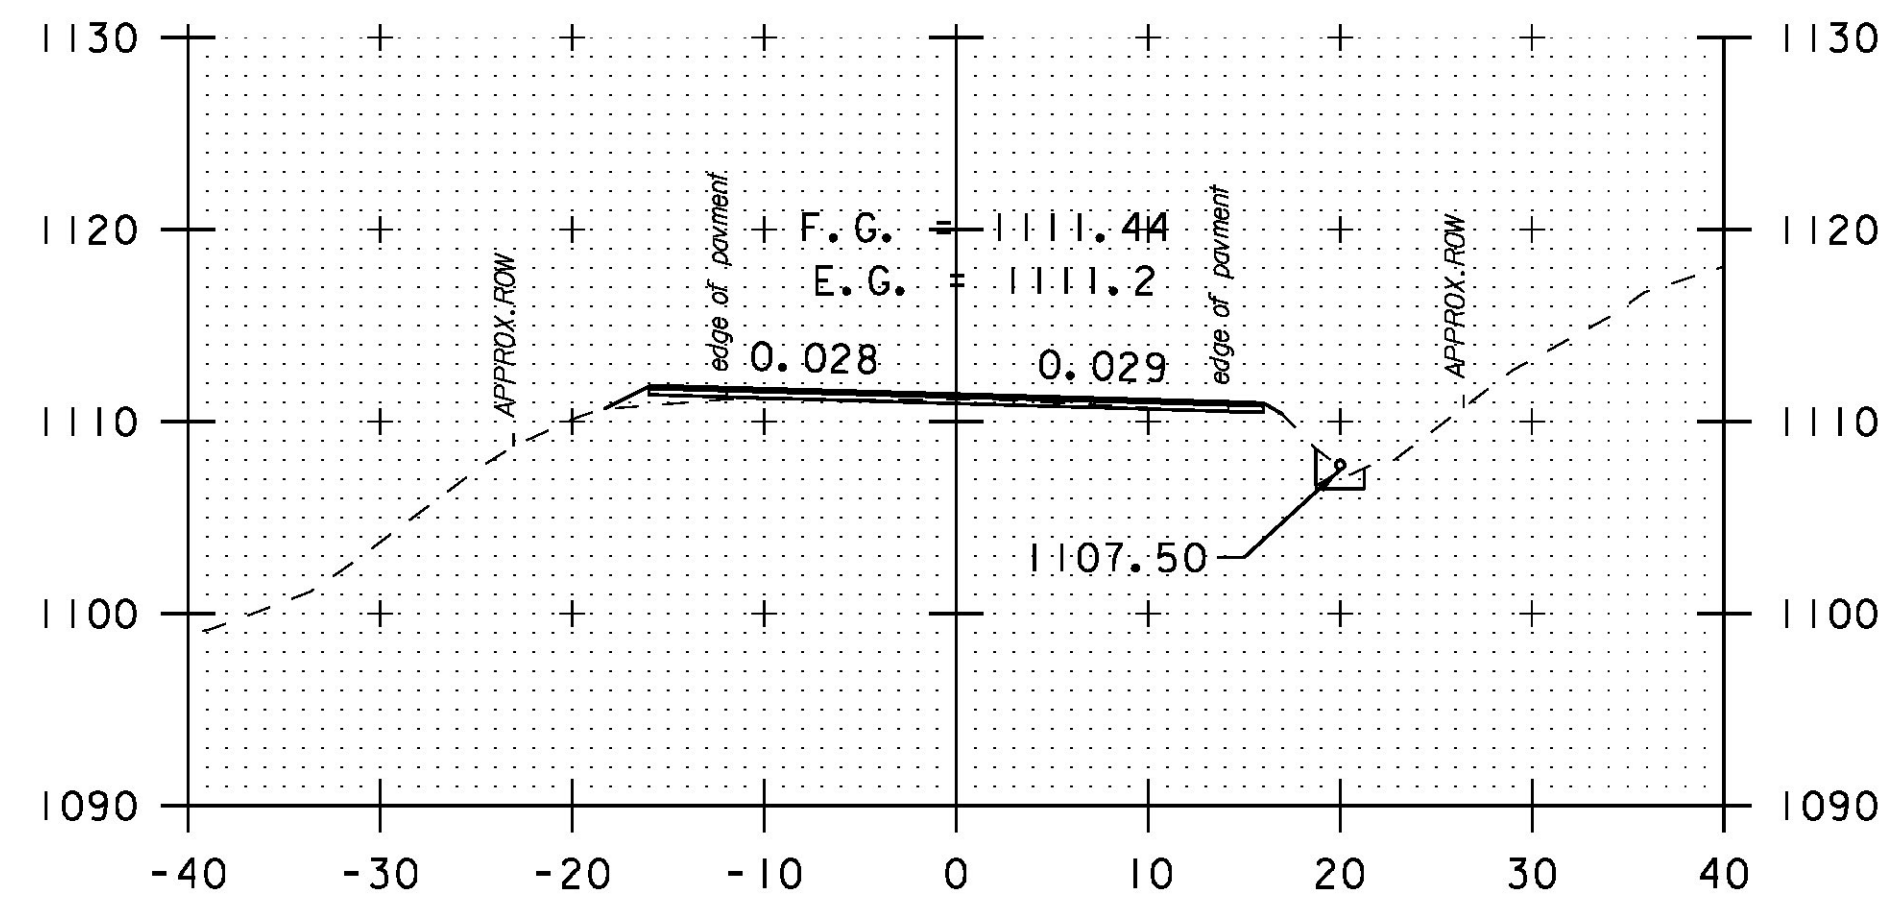


230+50

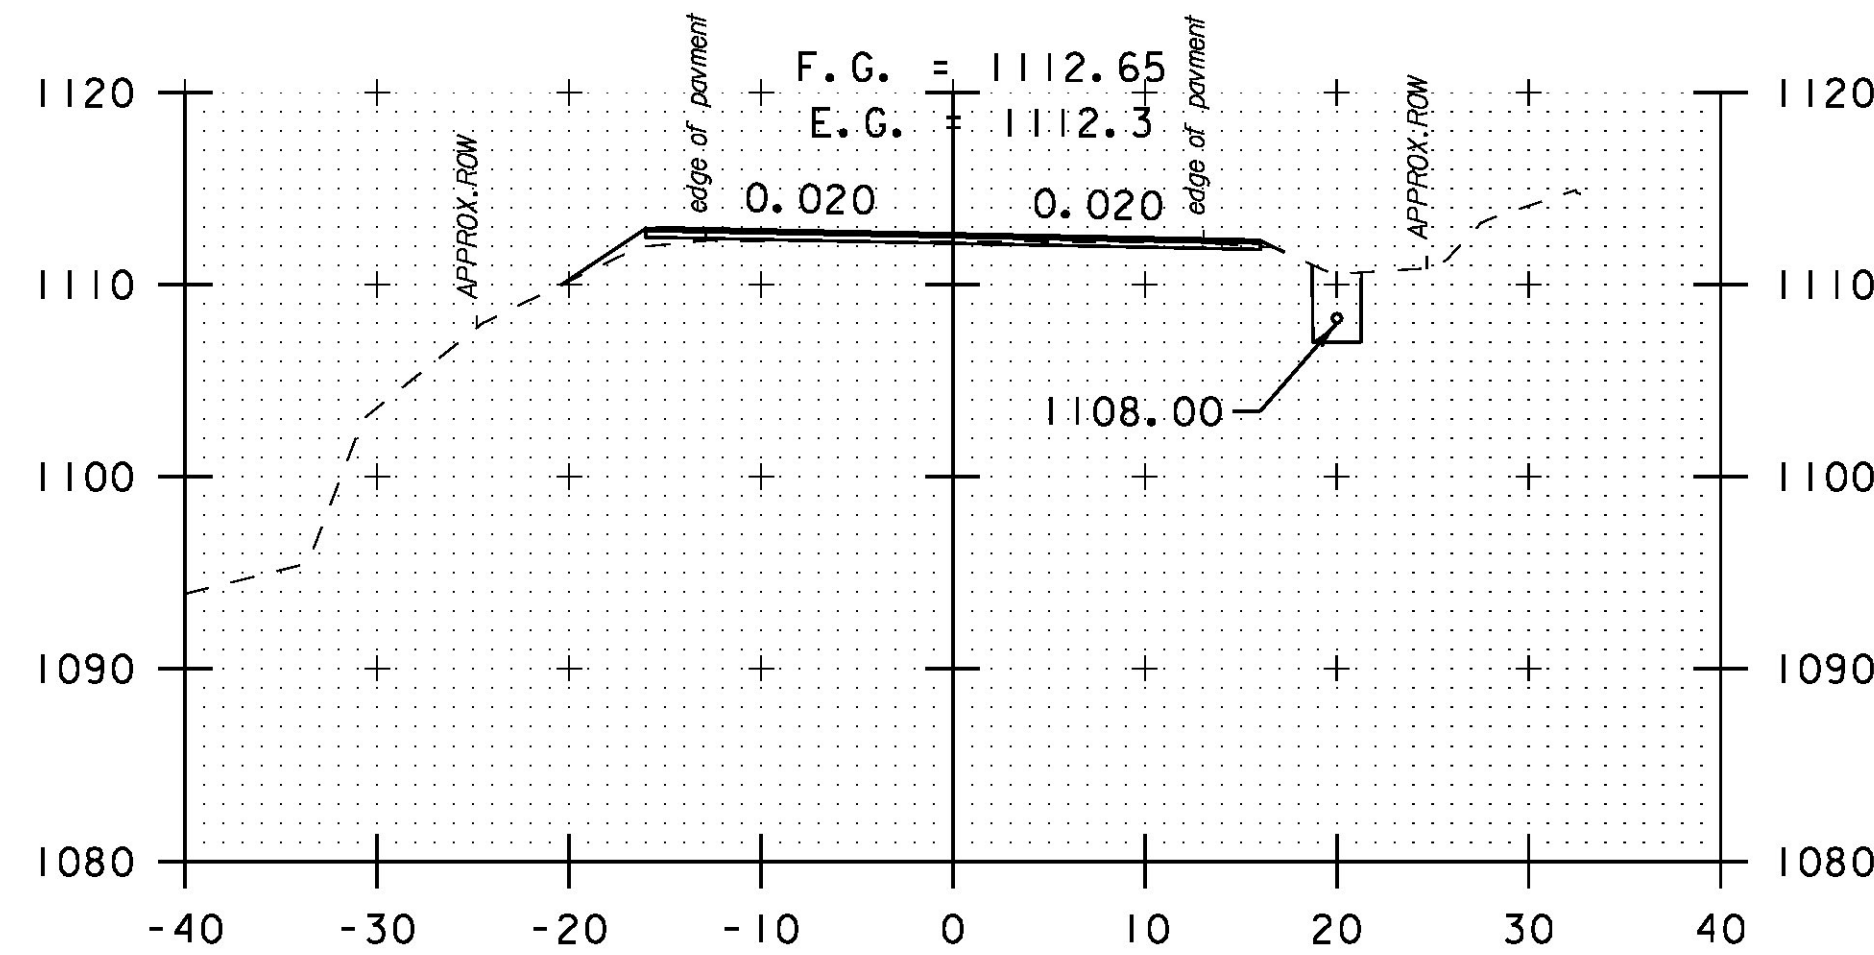


232+00

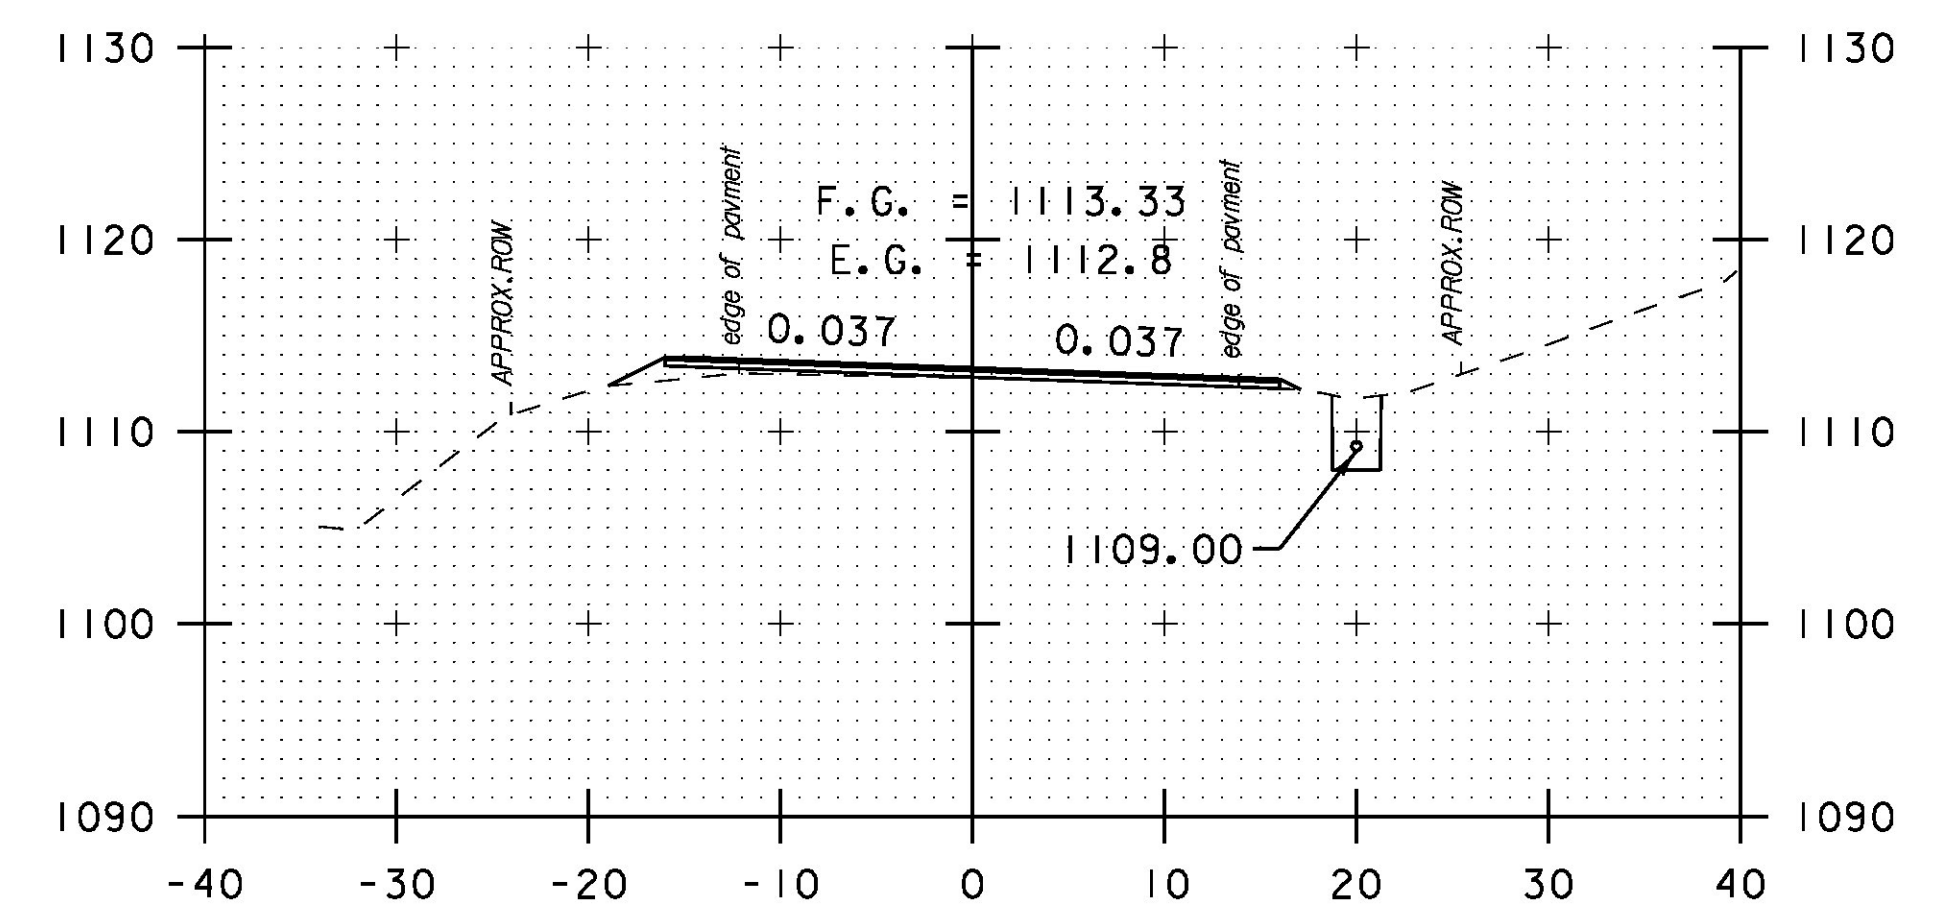


233+50

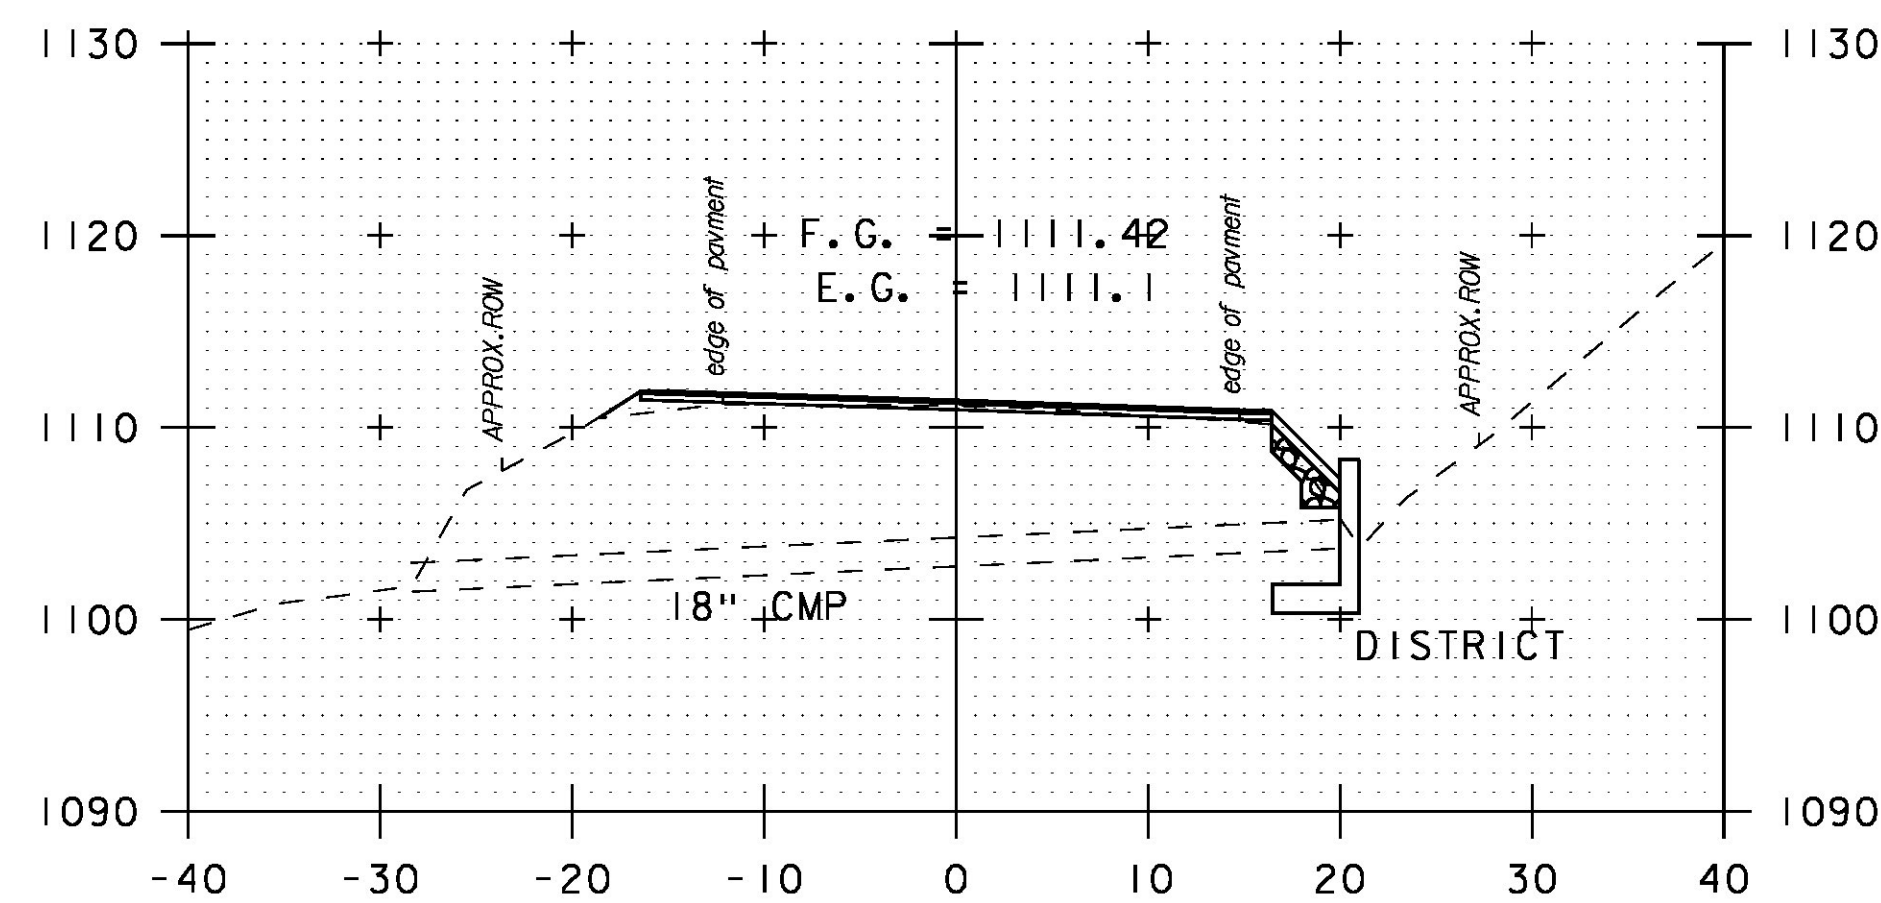

230+35

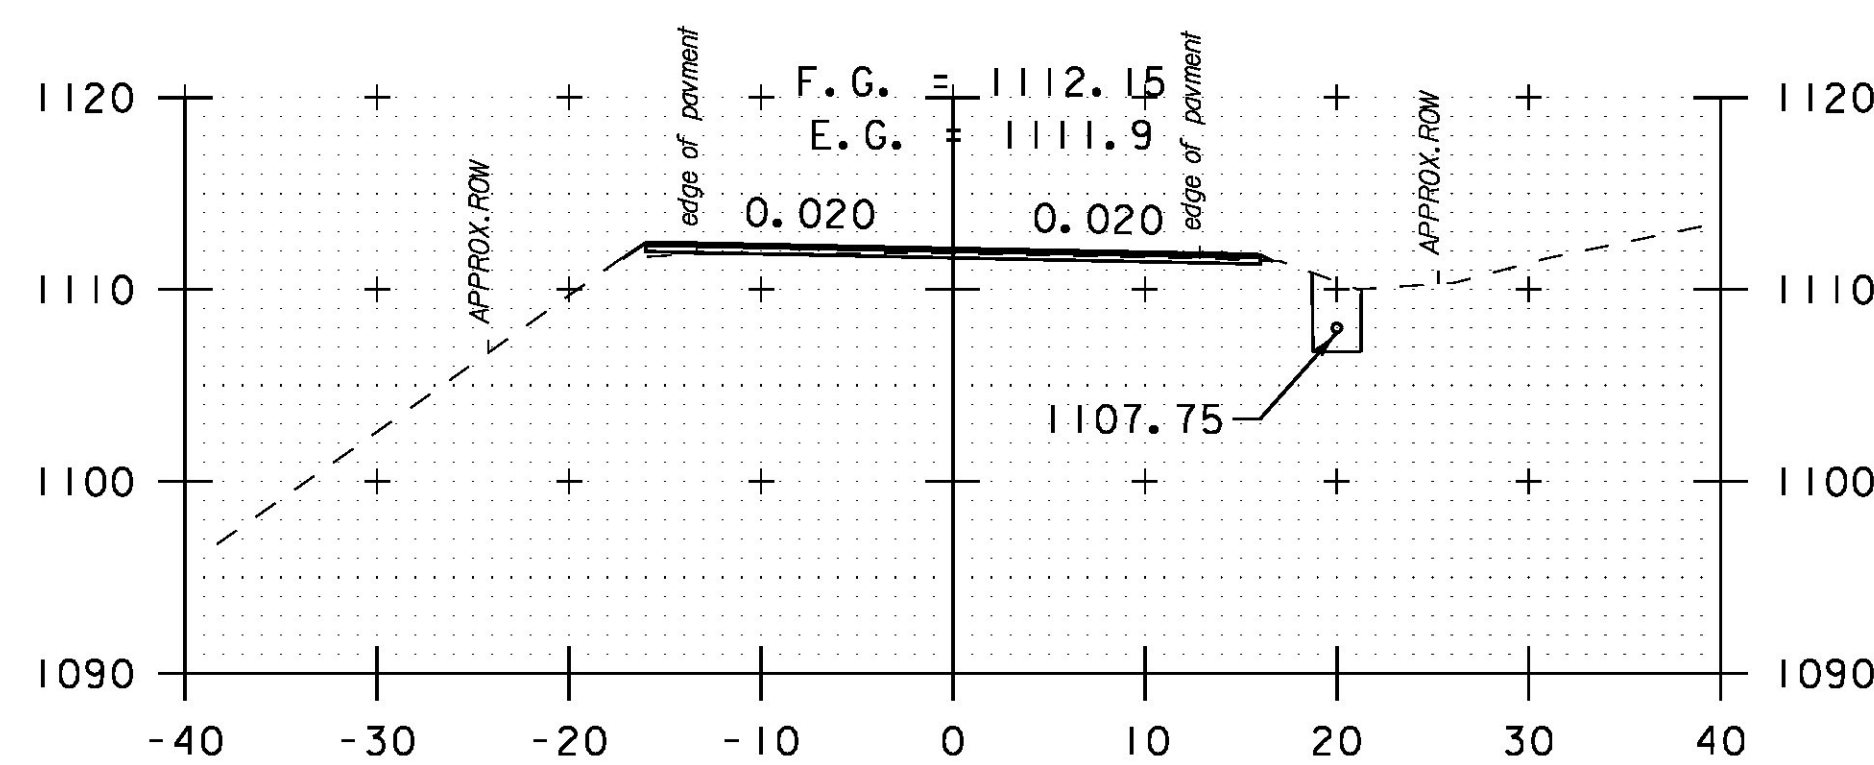

231+50

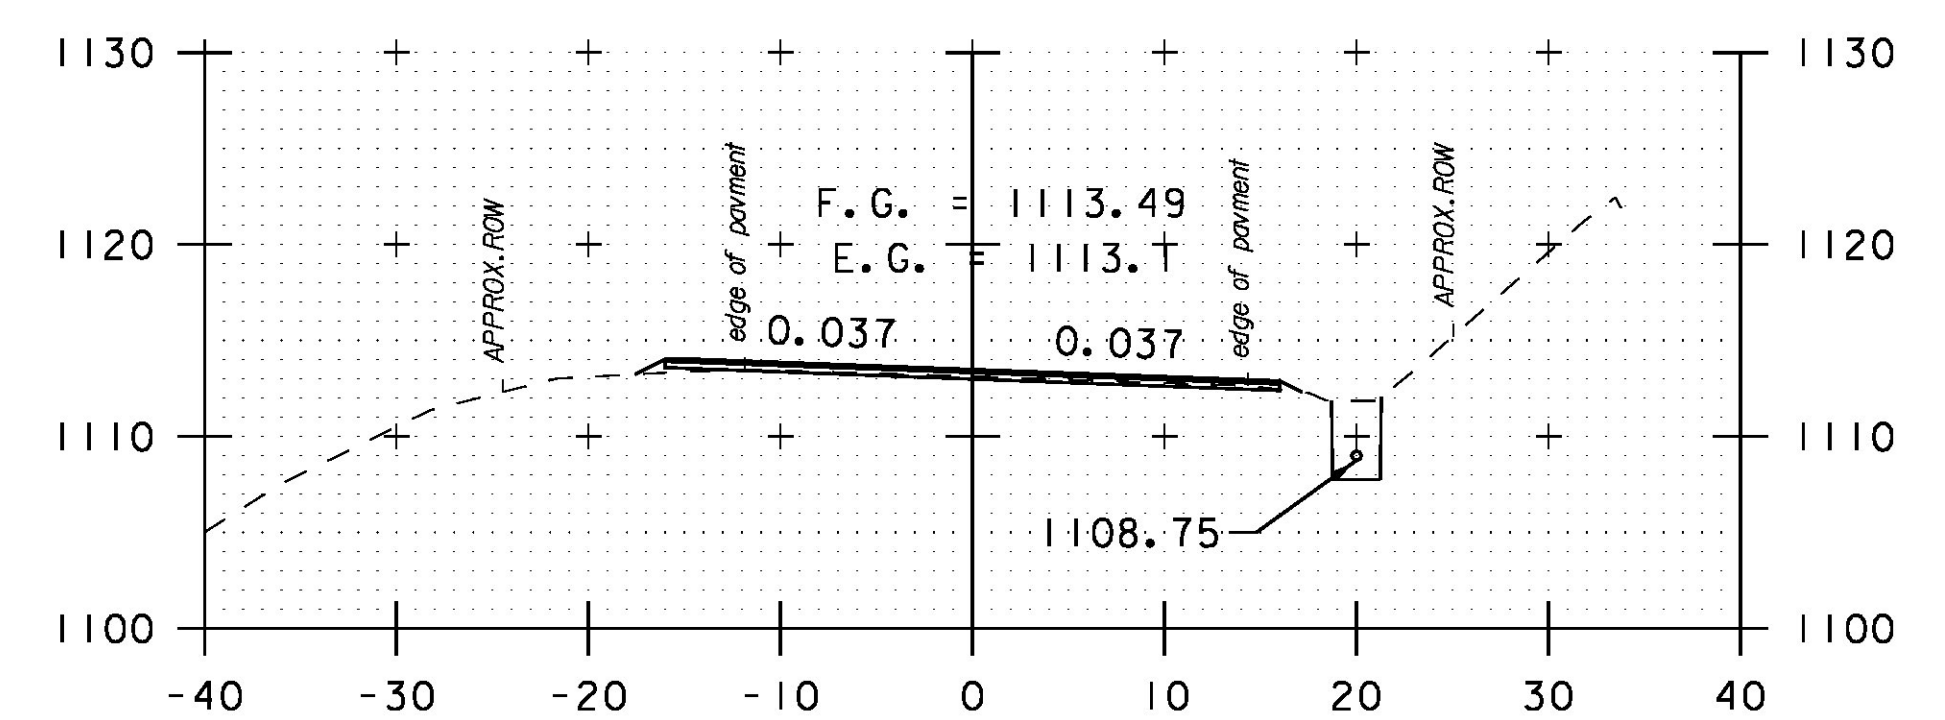

233+00



PROJECT NAME:	HANCOCK	PLOT DATE:	3/18/2015
PROJECT NUMBER:	STP 2923 (1)	DRAWN BY:	B. MARTIN
FILE NAME:	z10c252xs.dgn	CHECKED BY:	C. LATHROP
PROJECT LEADER:	C. LATHROP	CROSS SECTION SHEET	43
DESIGNED BY:	B. MARTIN	SHEET	170 OF 207