




235+50
DRIVE RT

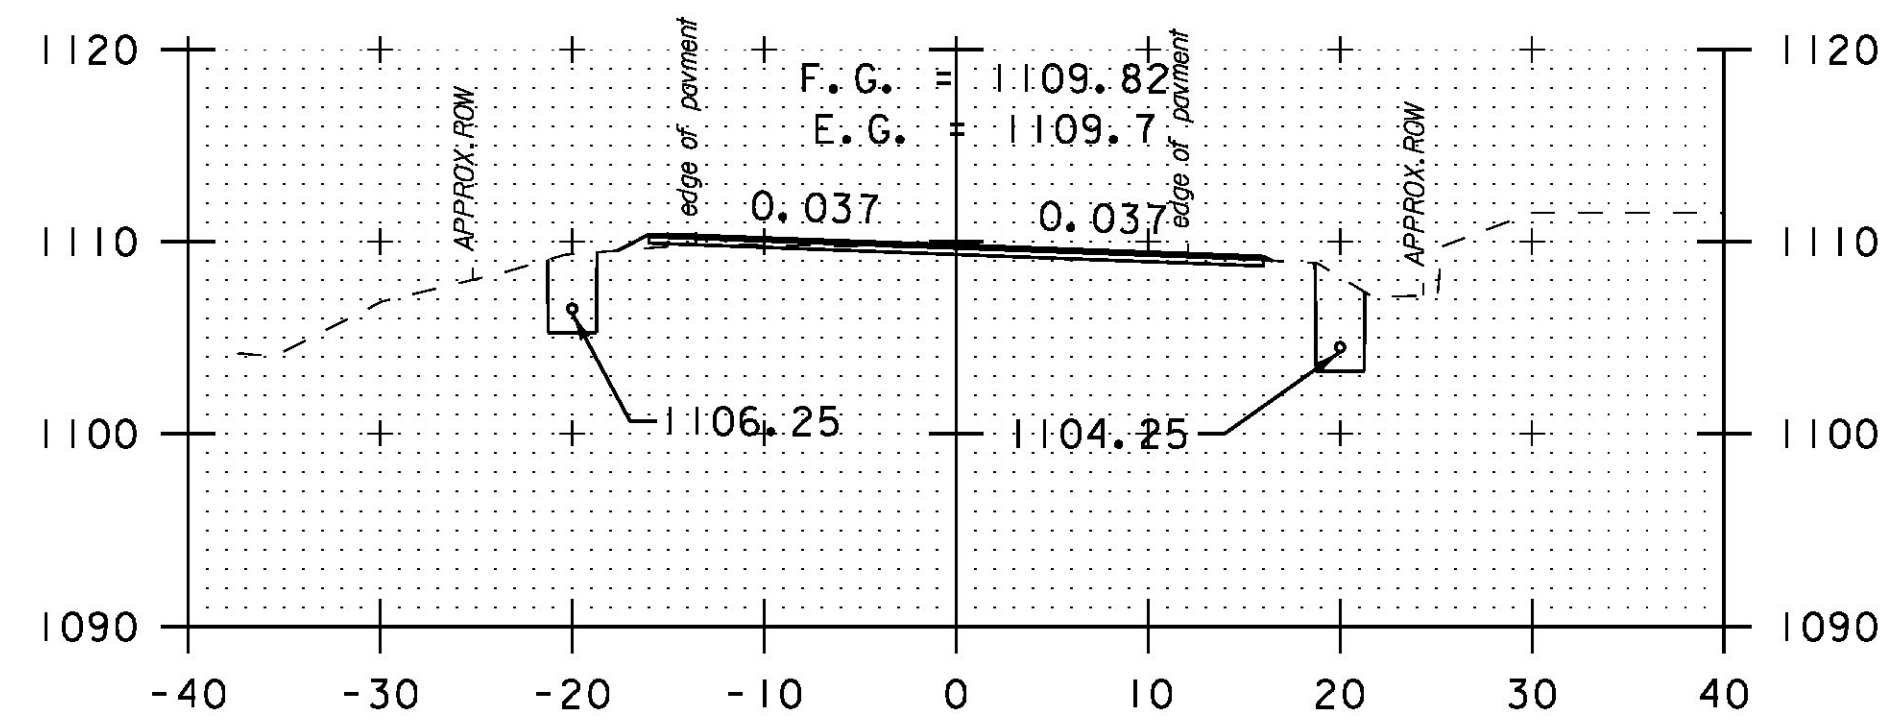


235+00

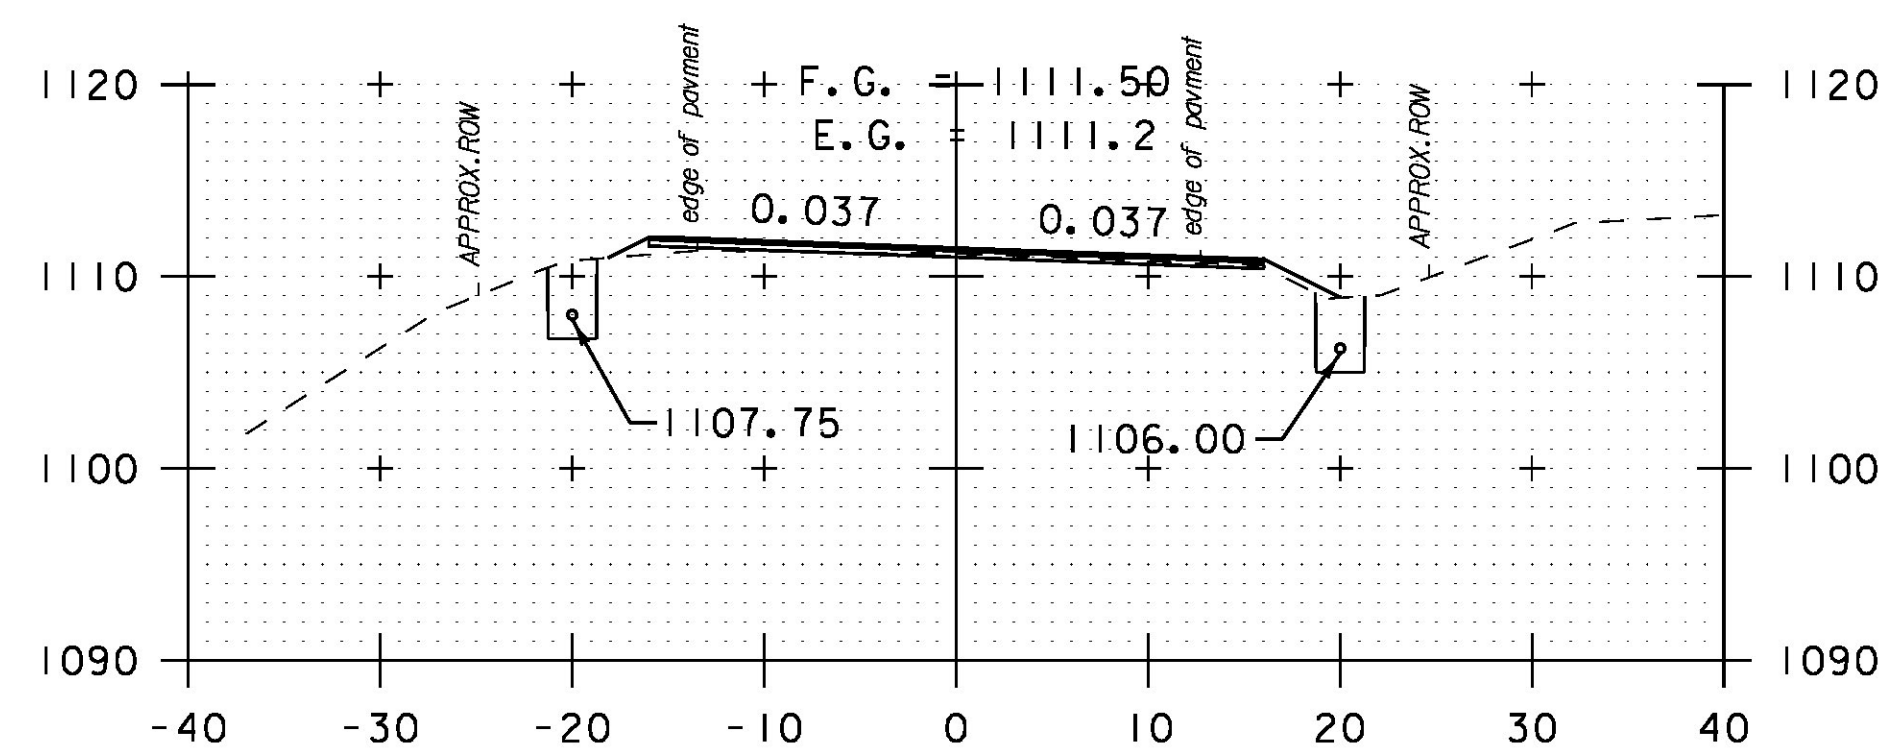


234+50

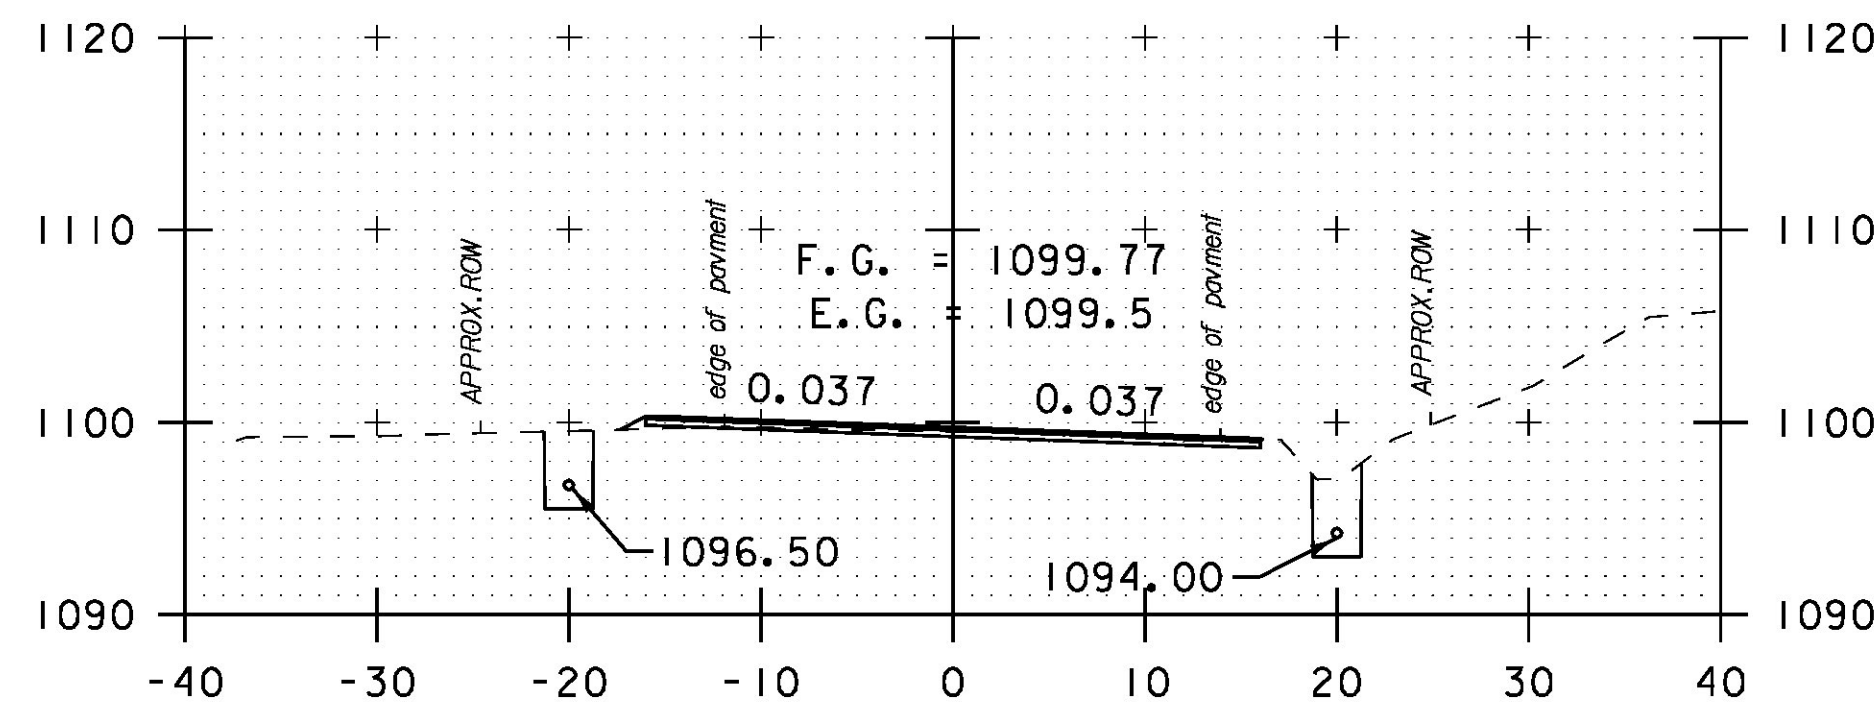


237+00
DRIVE LT

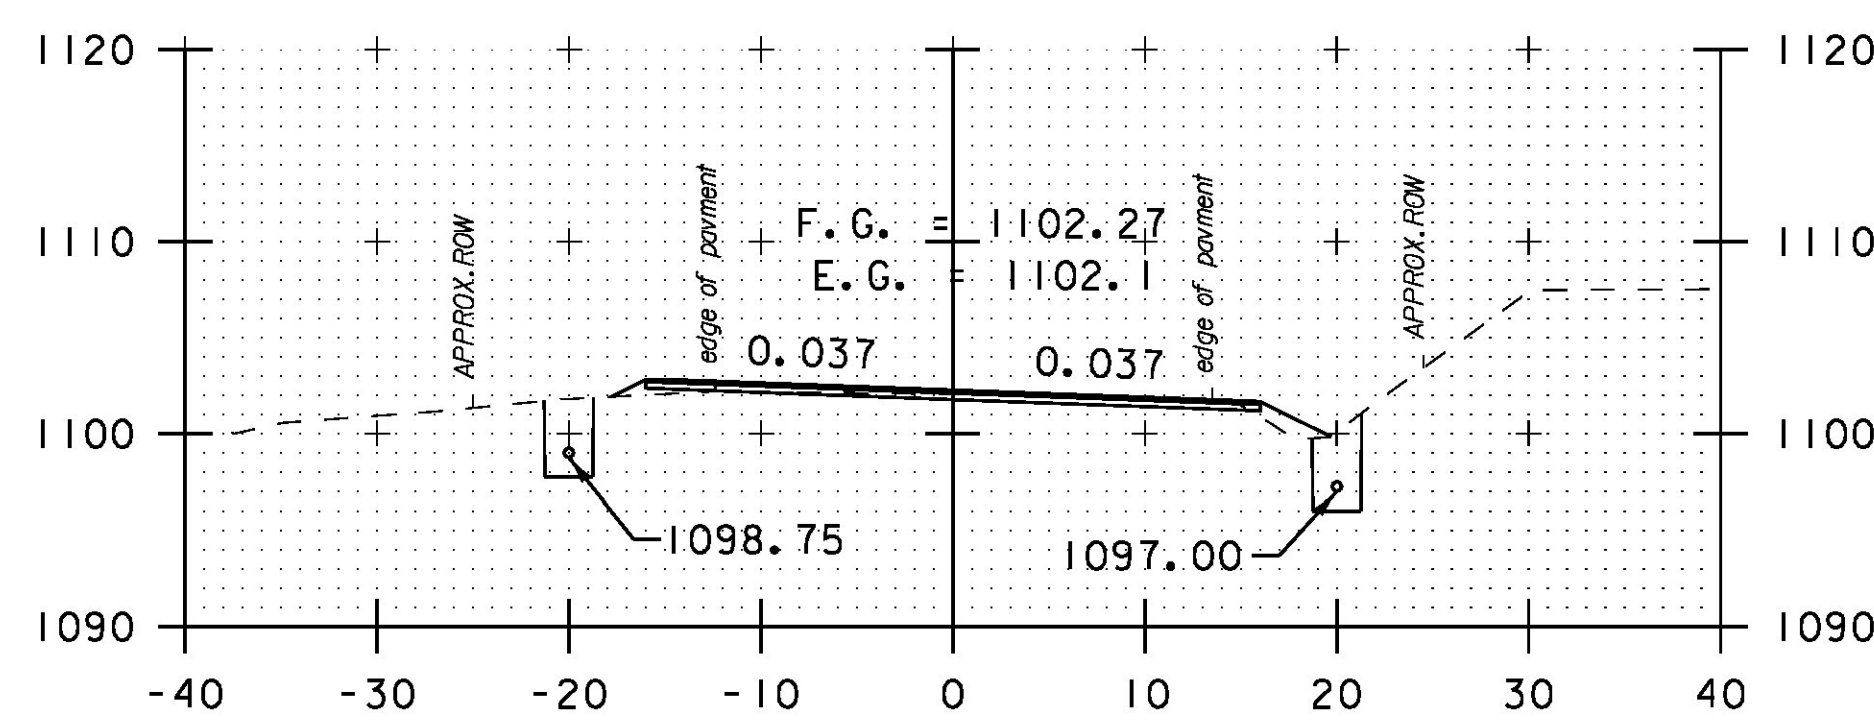


236+50
DRIVE LT

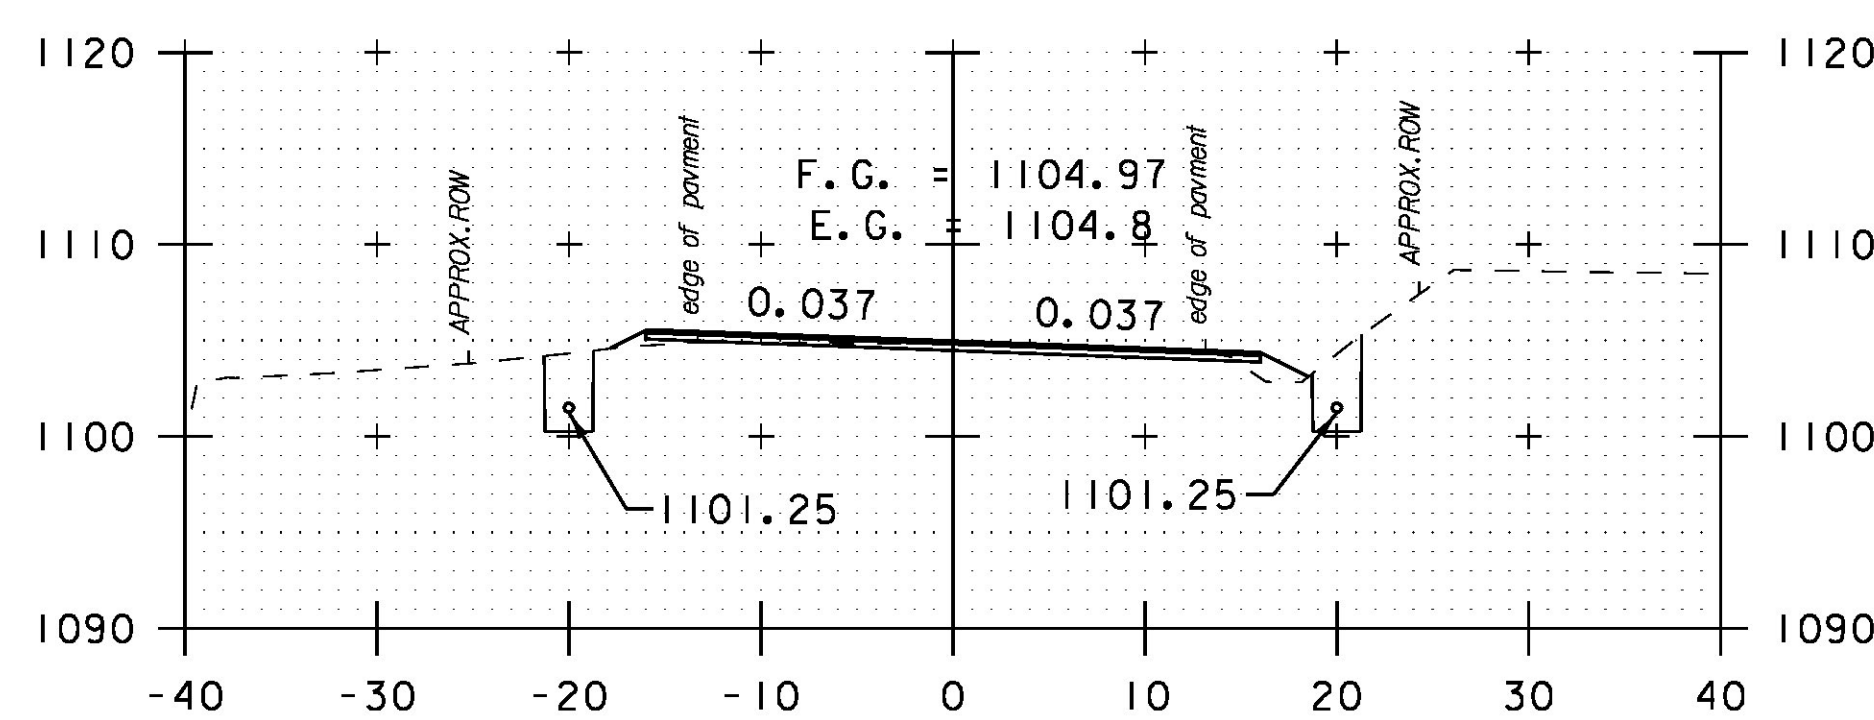


236+00

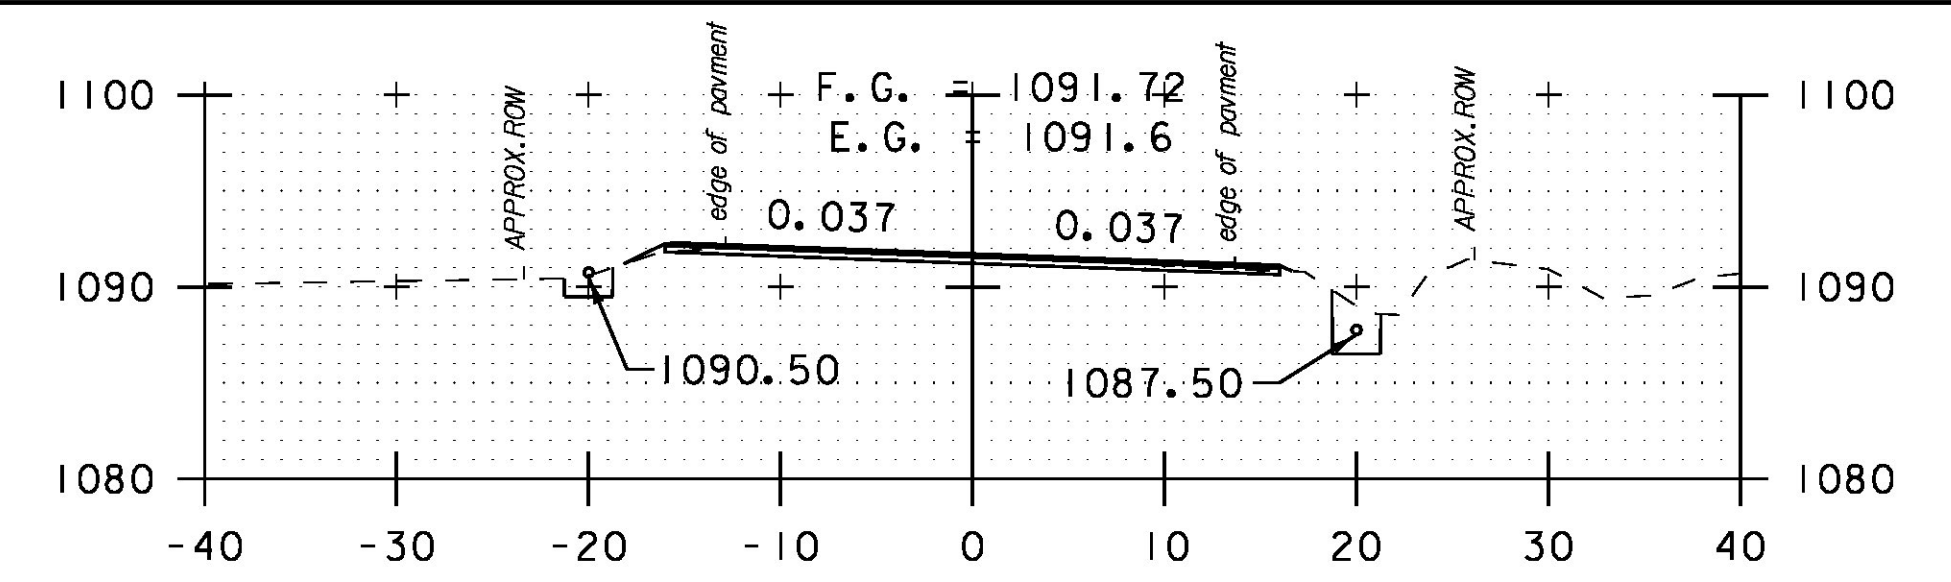


239+00

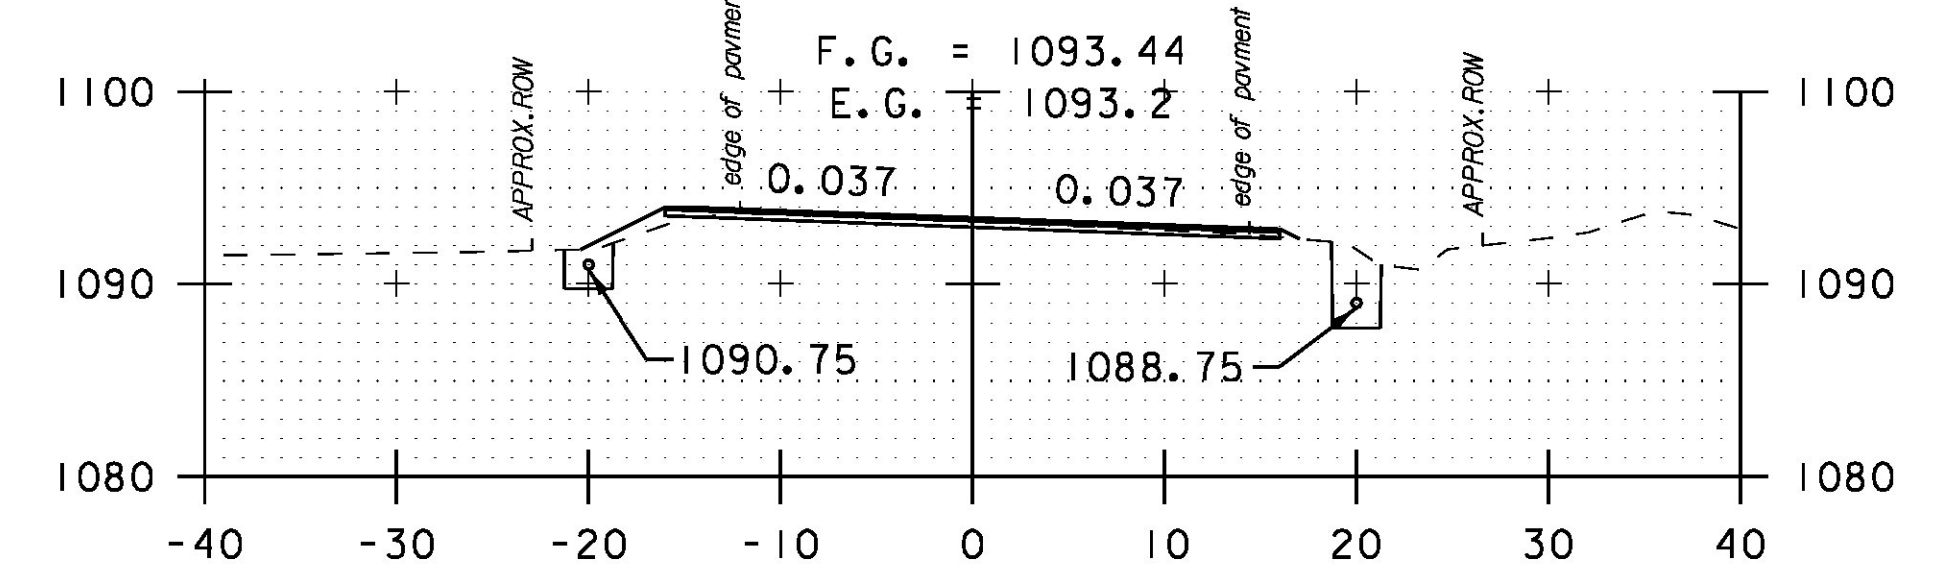

238+50

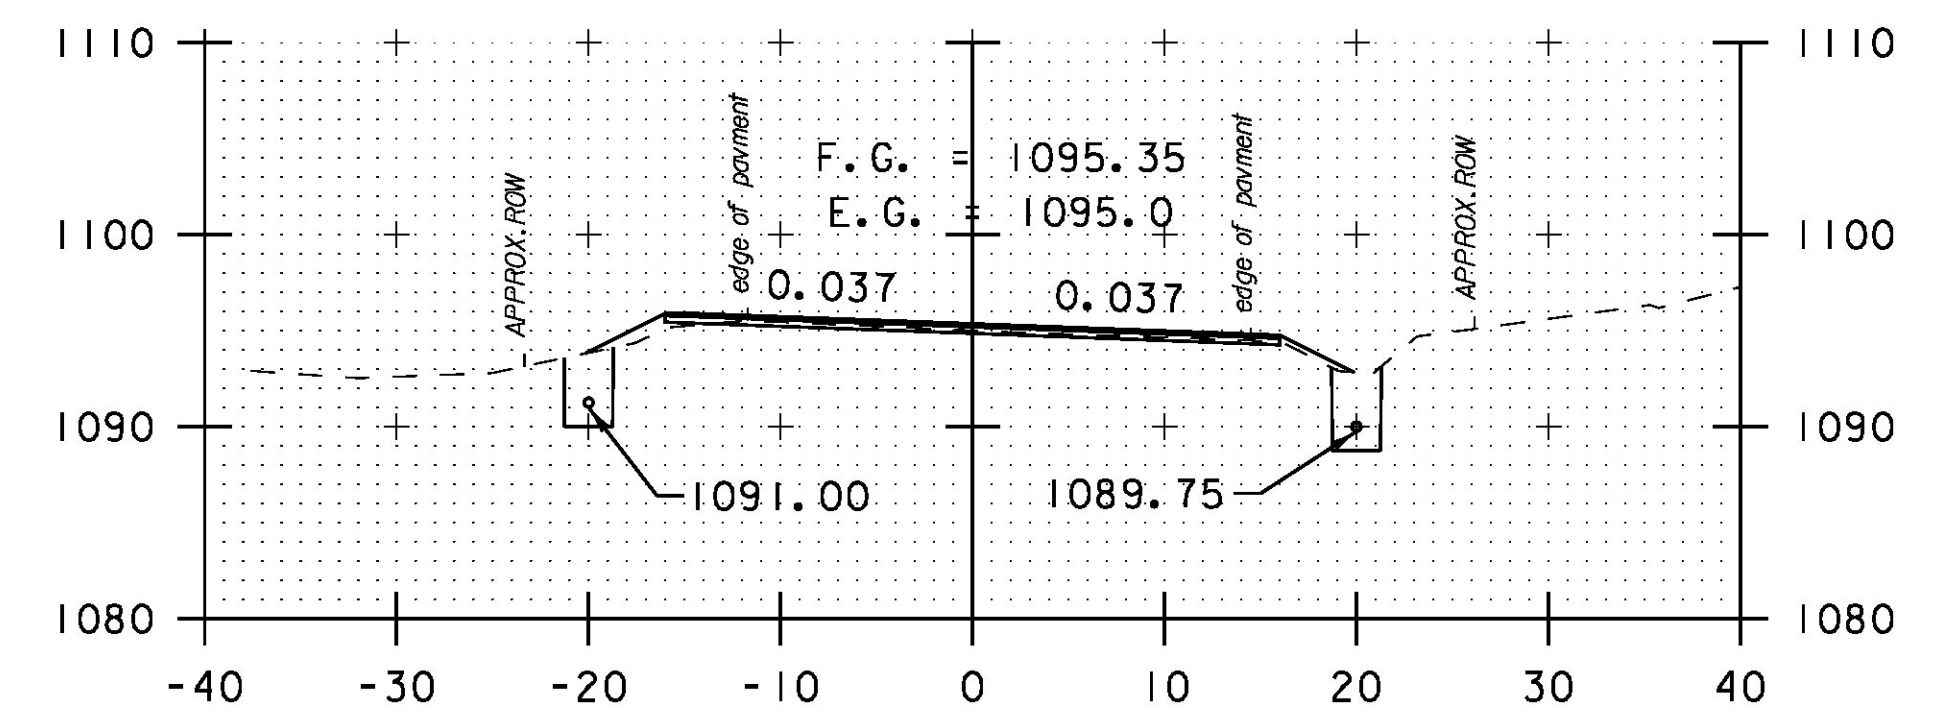

238+00

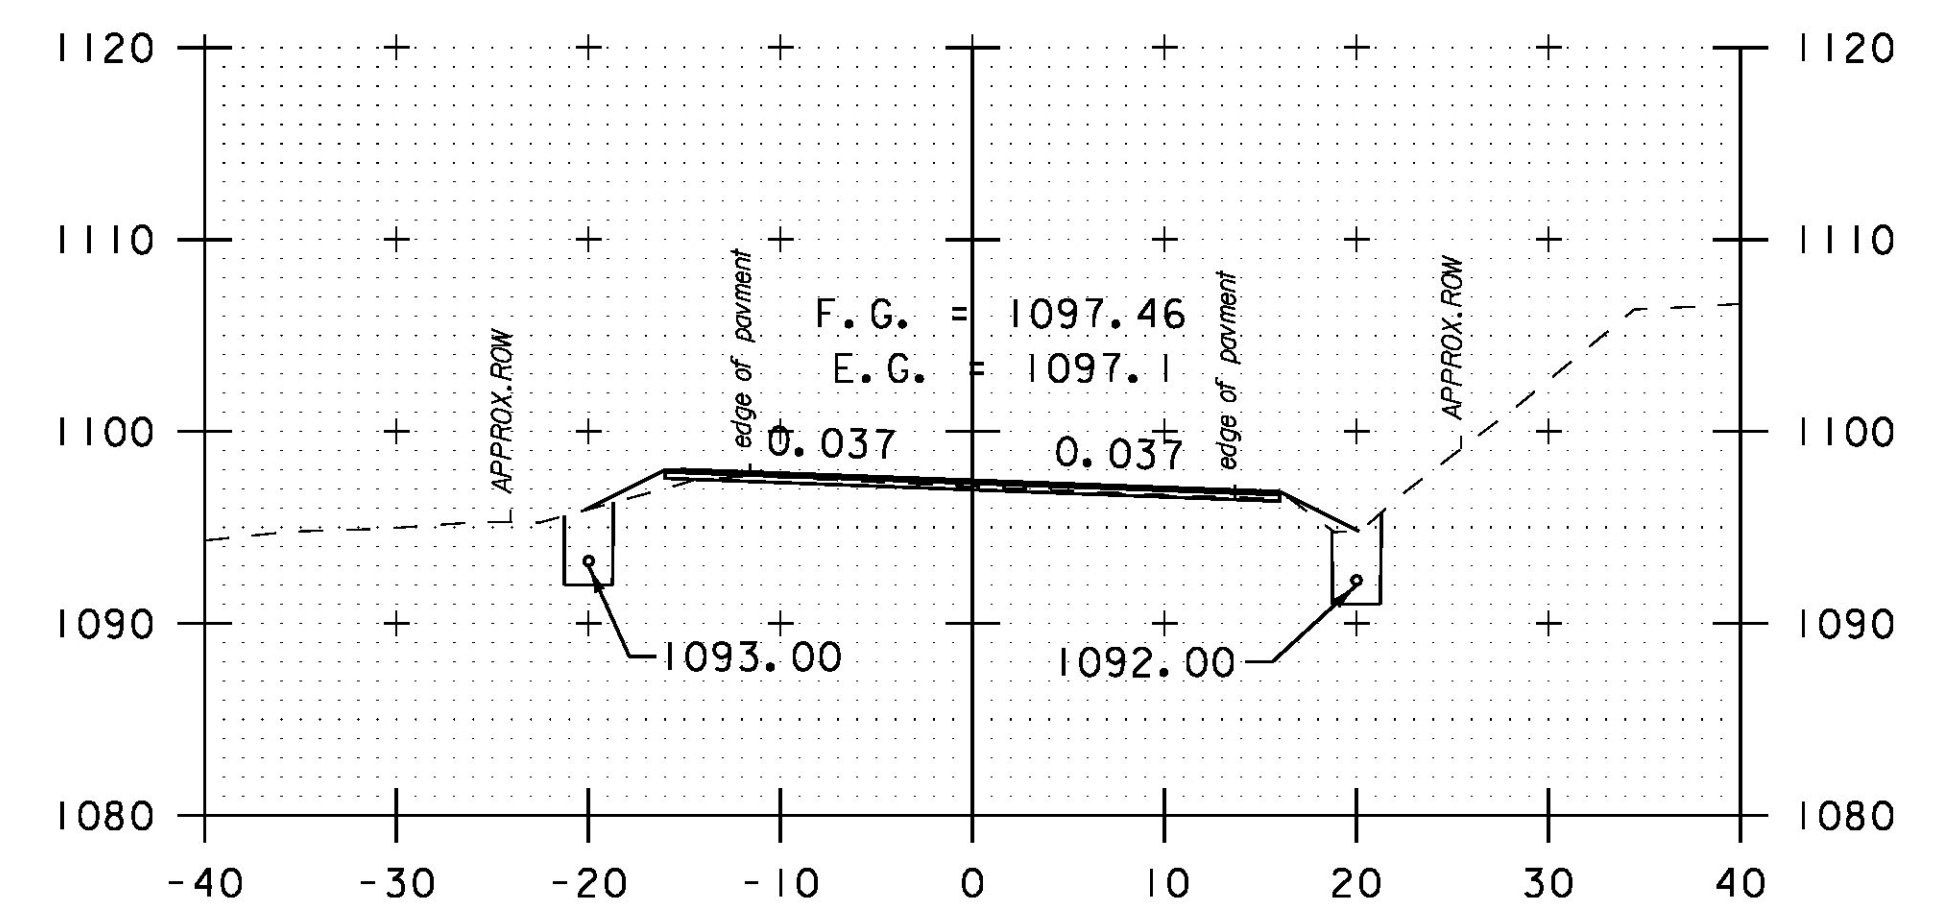

237+50



PROJECT NAME:	HANCOCK	PLOT DATE:	3/18/2015
PROJECT NUMBER:	STP 2923 (1)	DRAWN BY:	B. MARTIN
FILE NAME:	z10c252xs.dgn	CHECKED BY:	C. LATHROP
PROJECT LEADER:	C. LATHROP	CROSS SECTION SHEET	44
DESIGNED BY:	B. MARTIN	SHEET	171 OF 207