




241+00

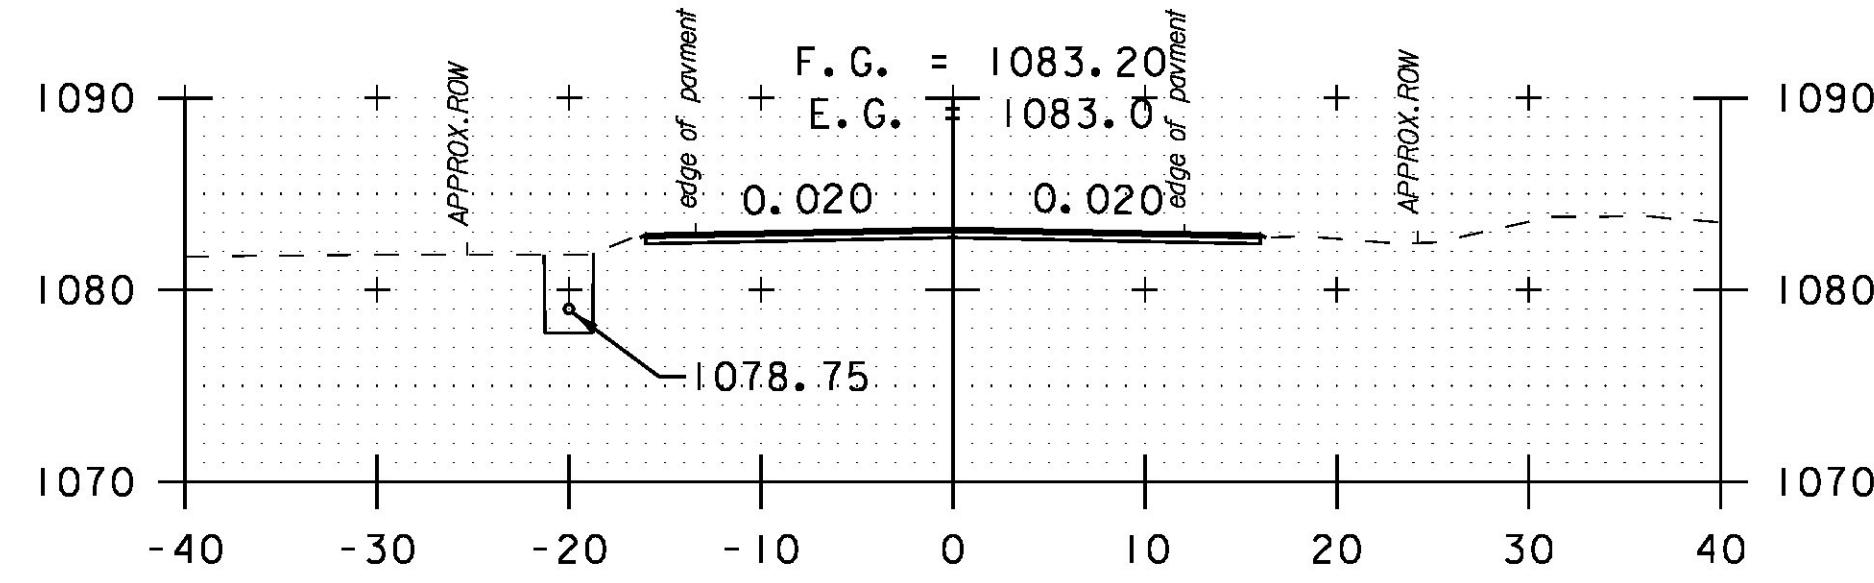


243+00

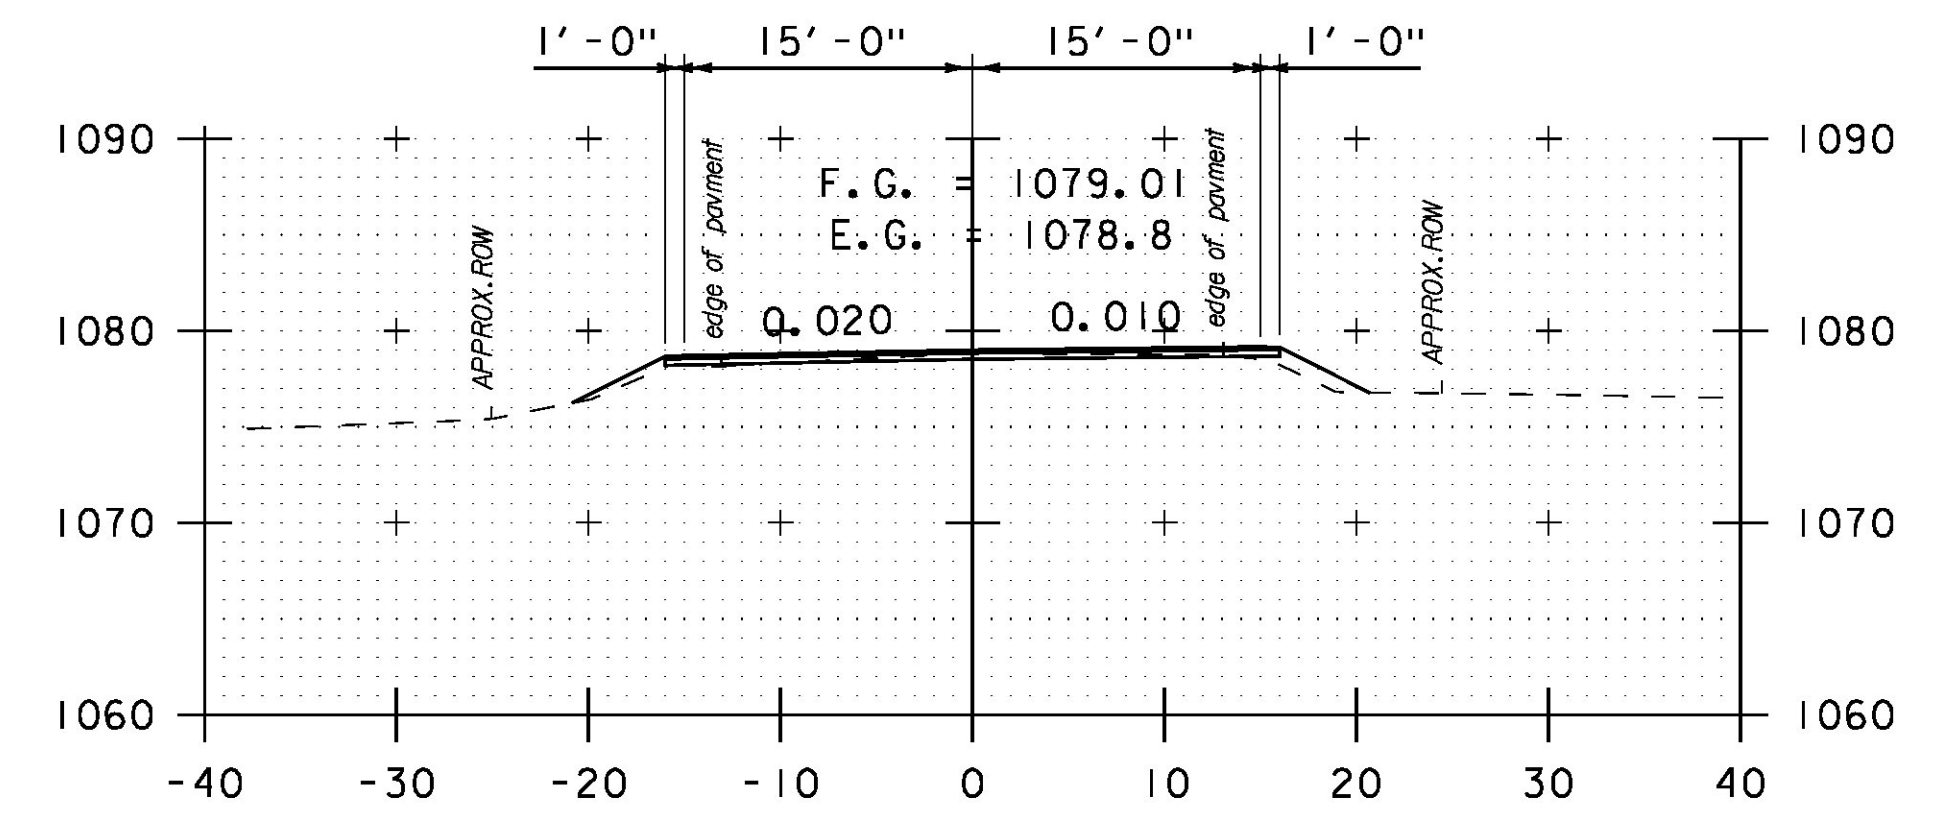


245+00

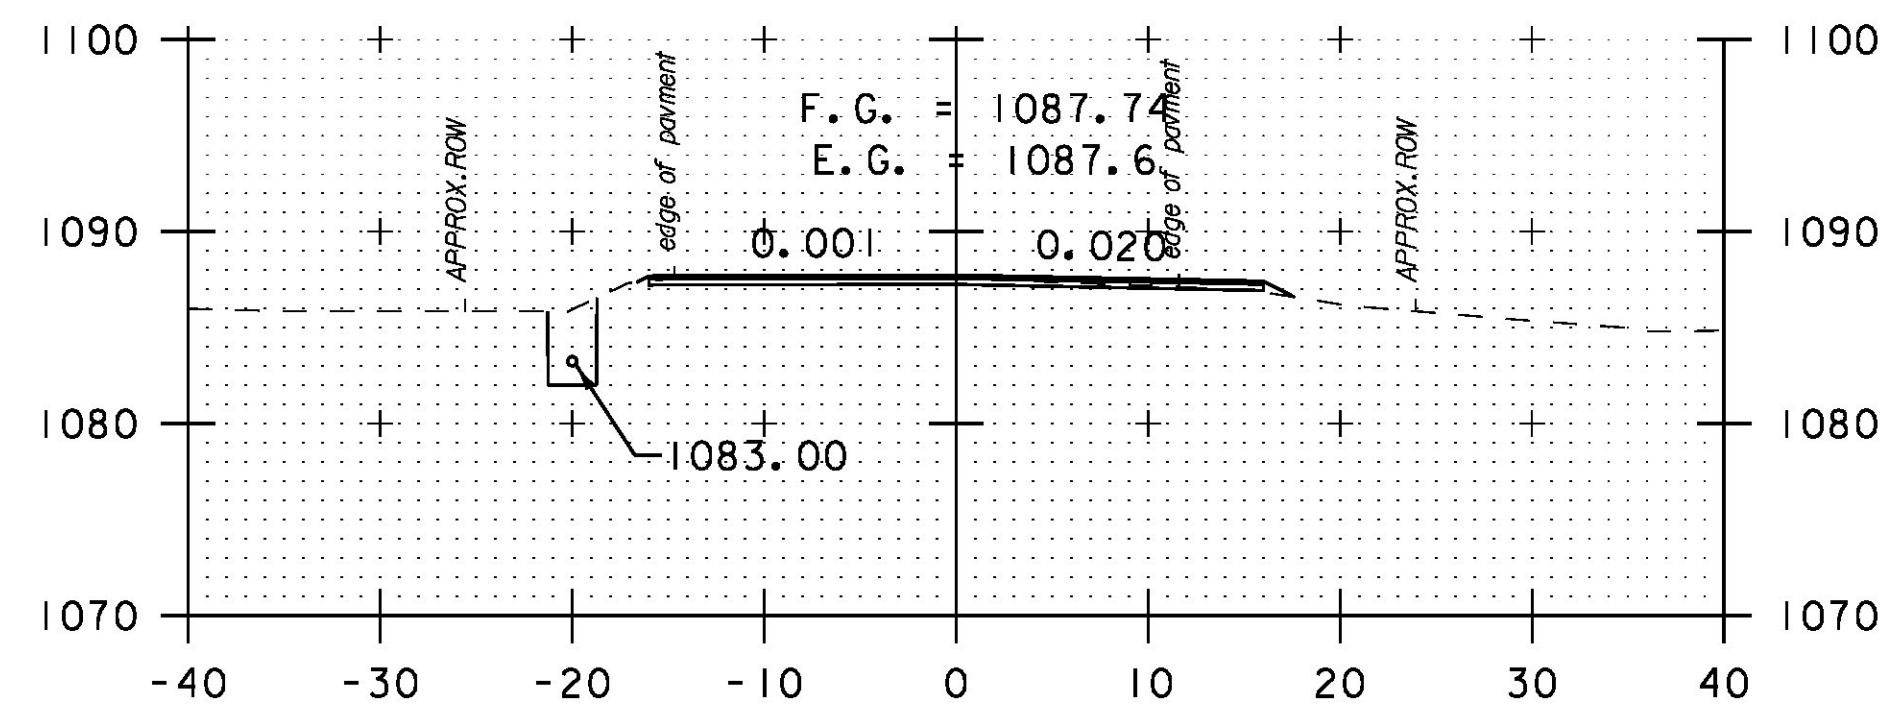


240+50

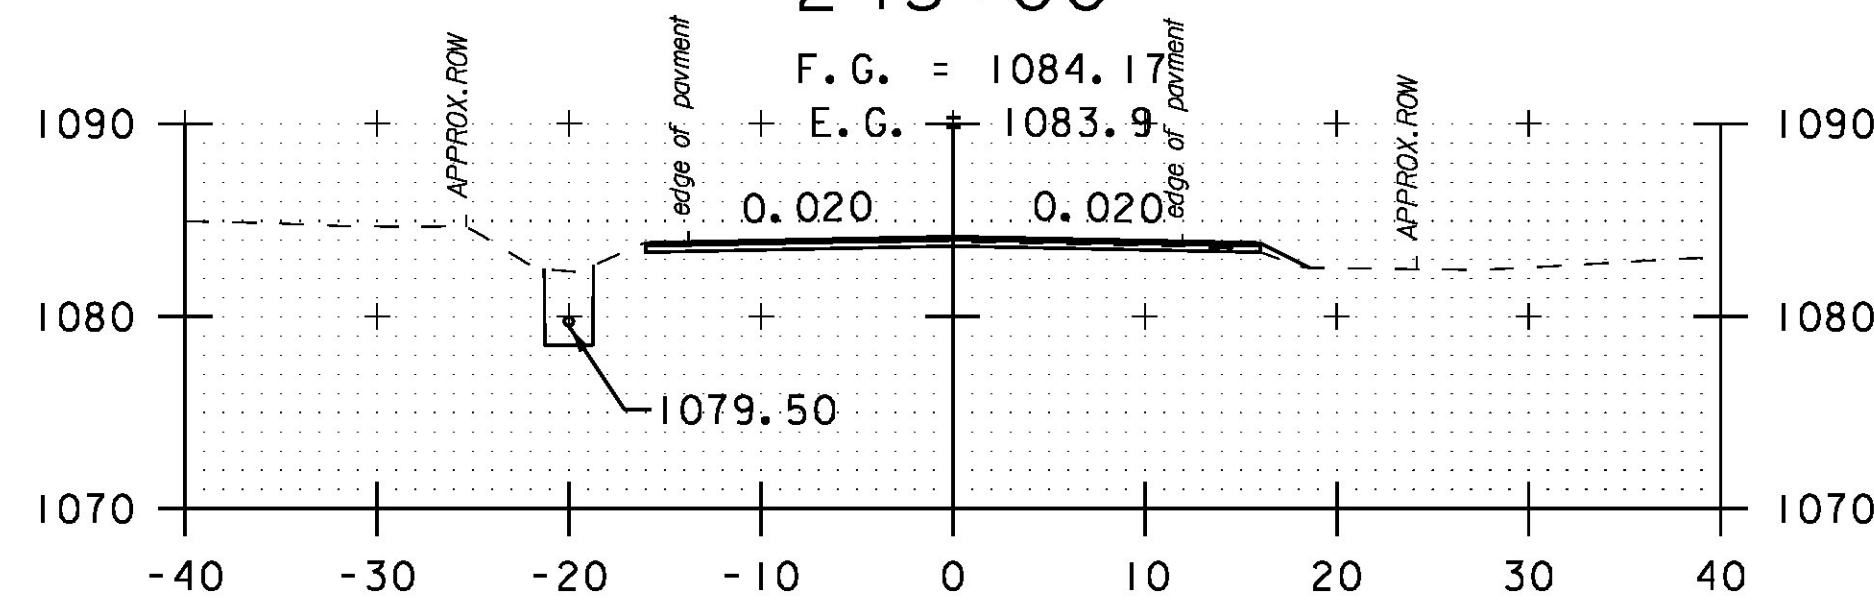


242+50

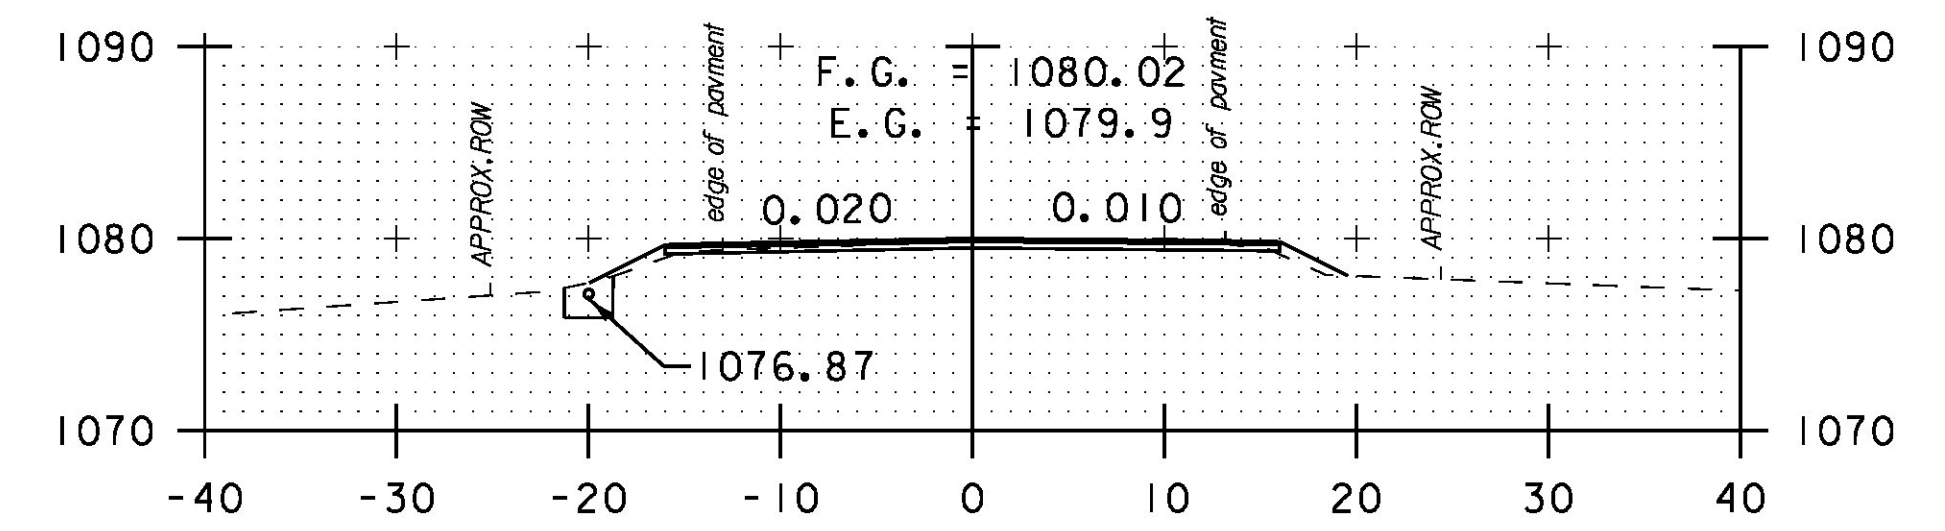


244+50

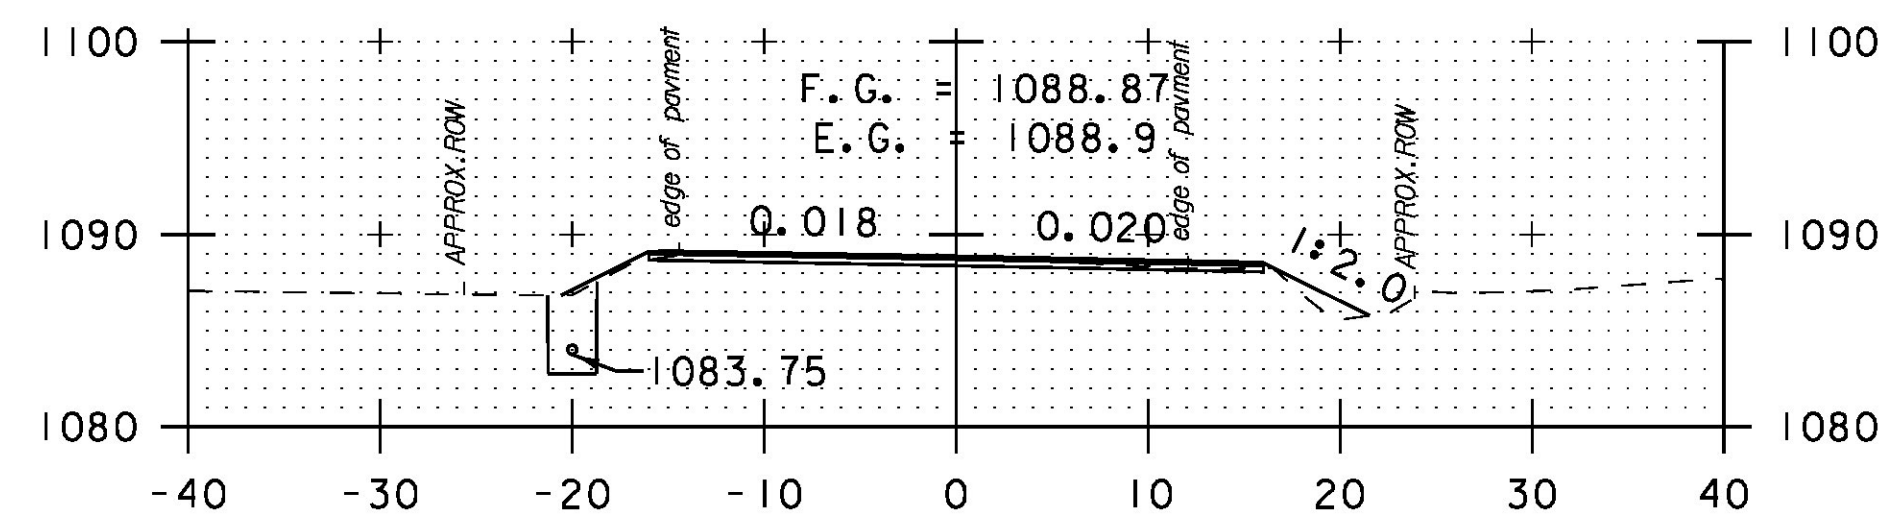


240+00

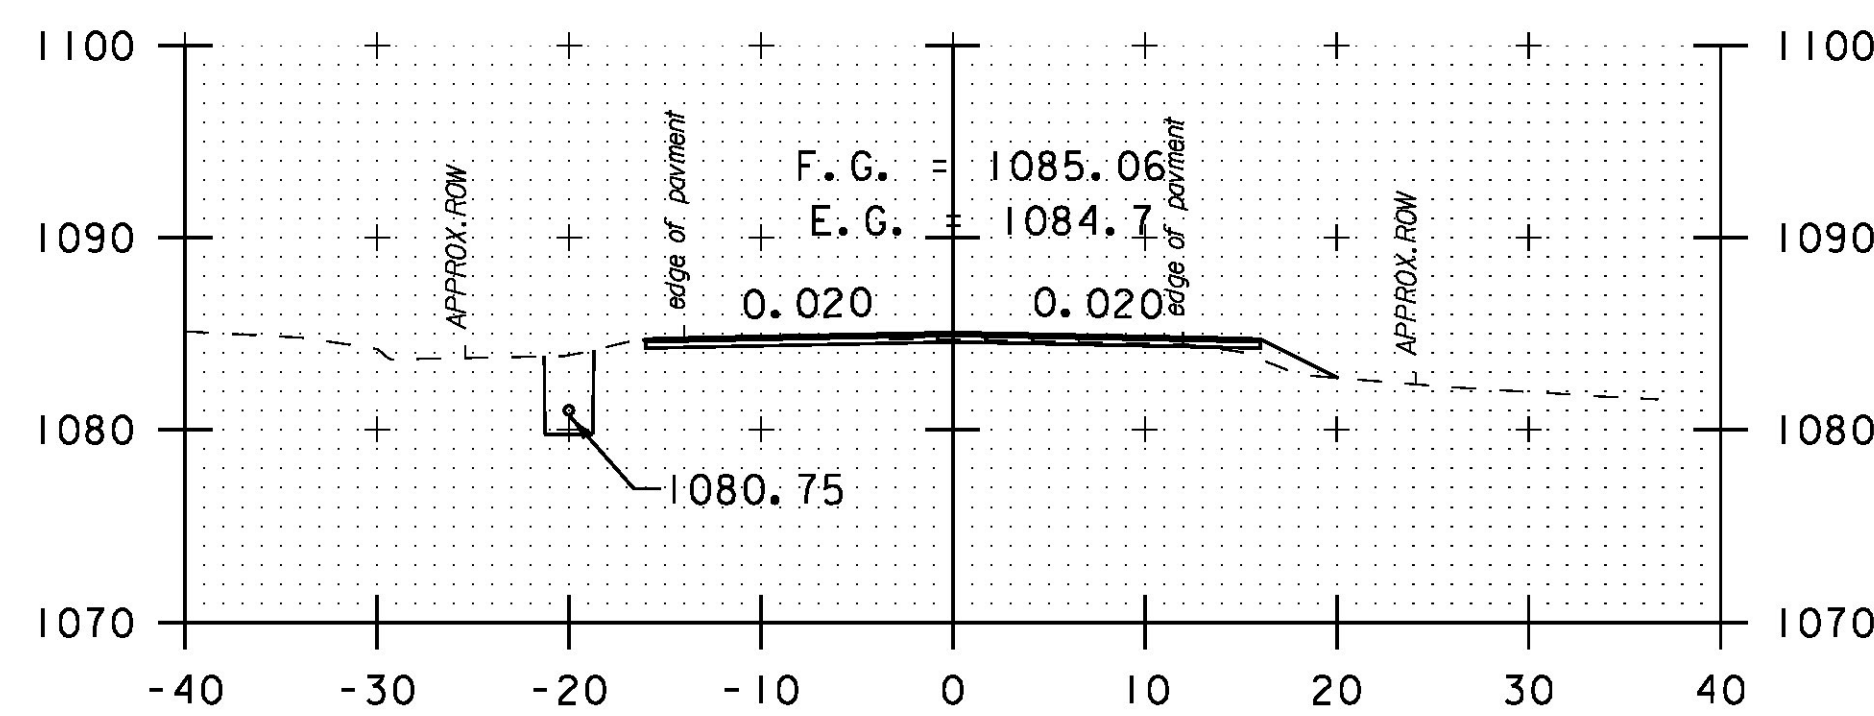


242+00

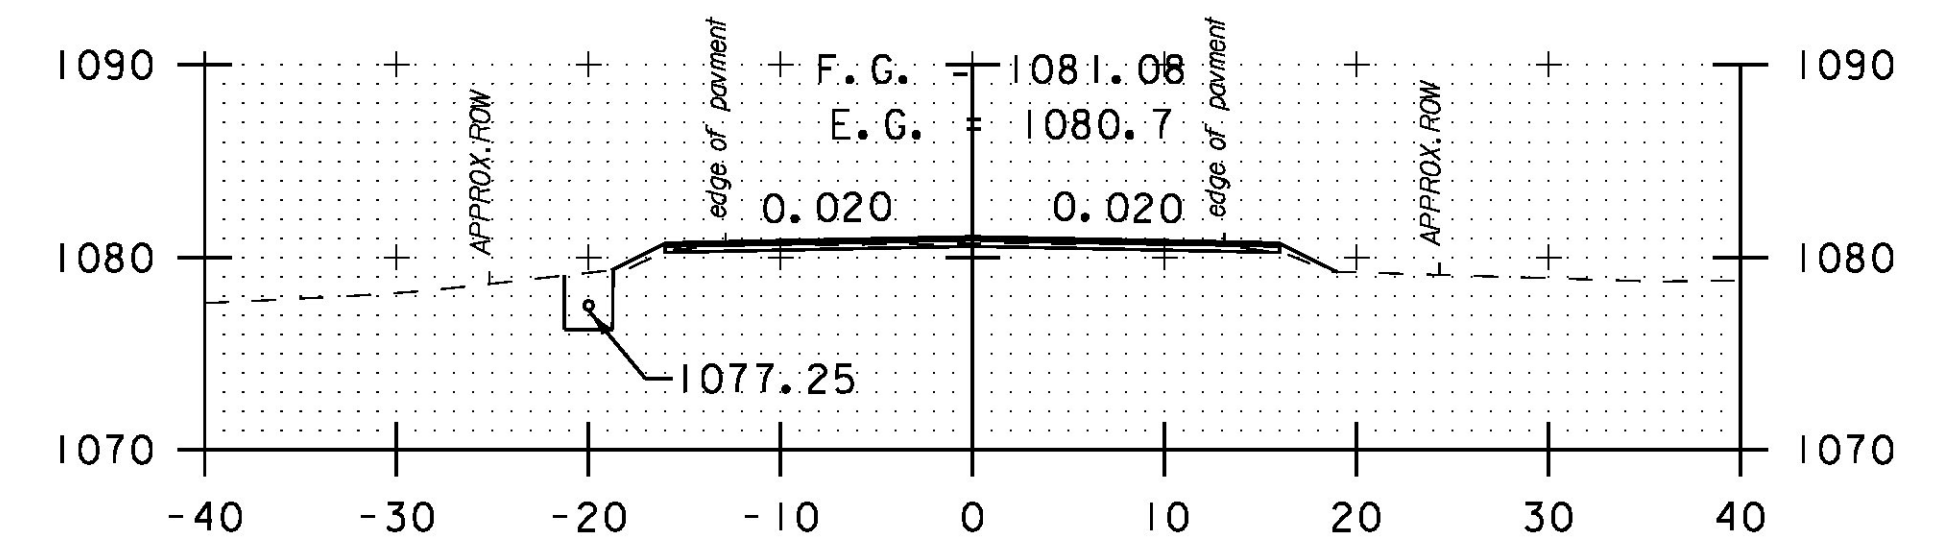


244+00

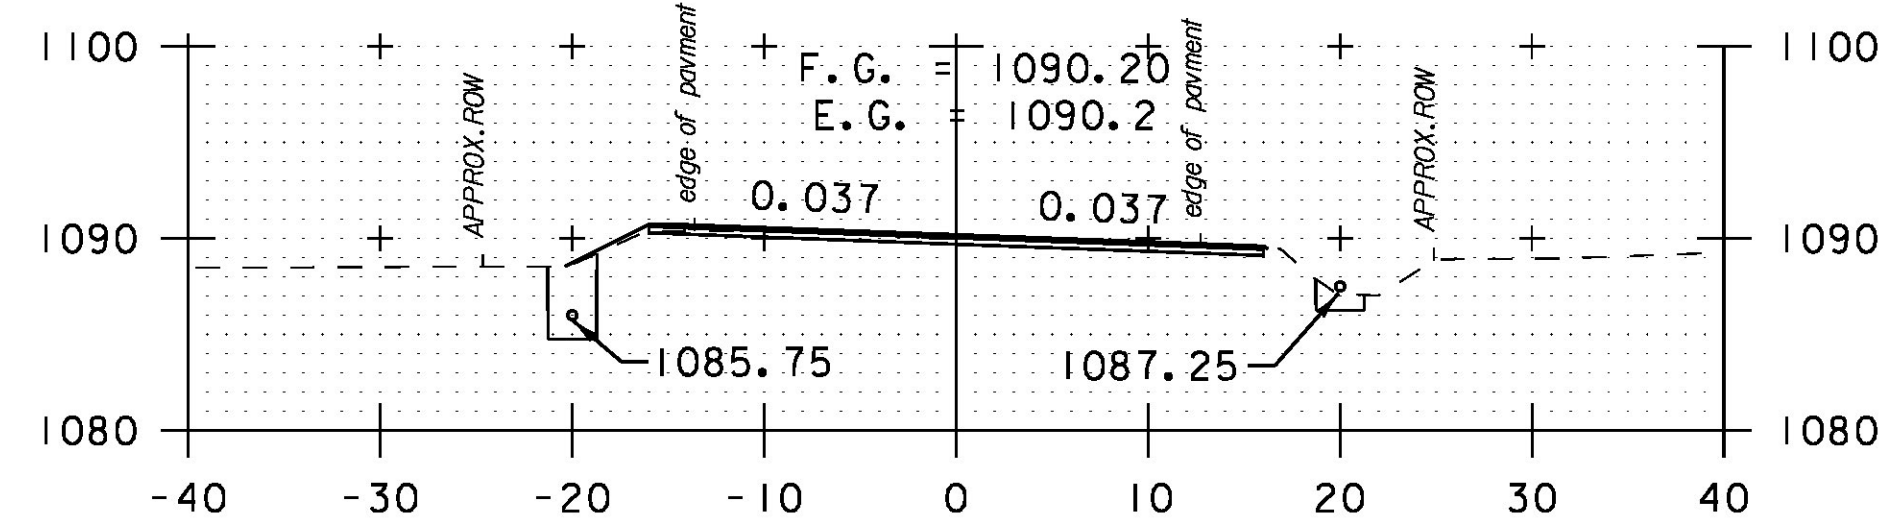

239+50

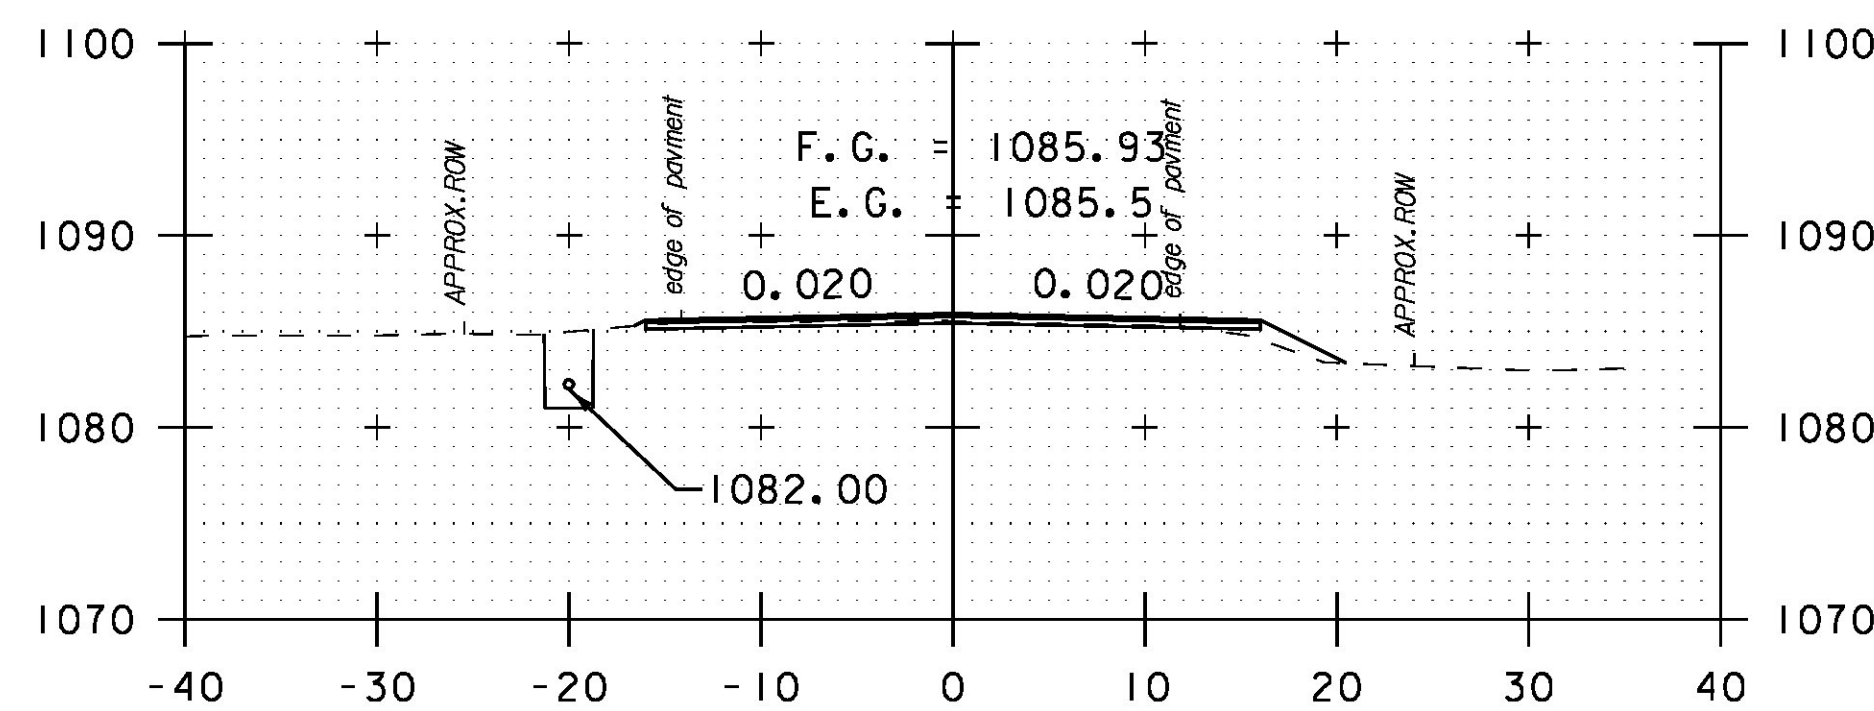

241+50

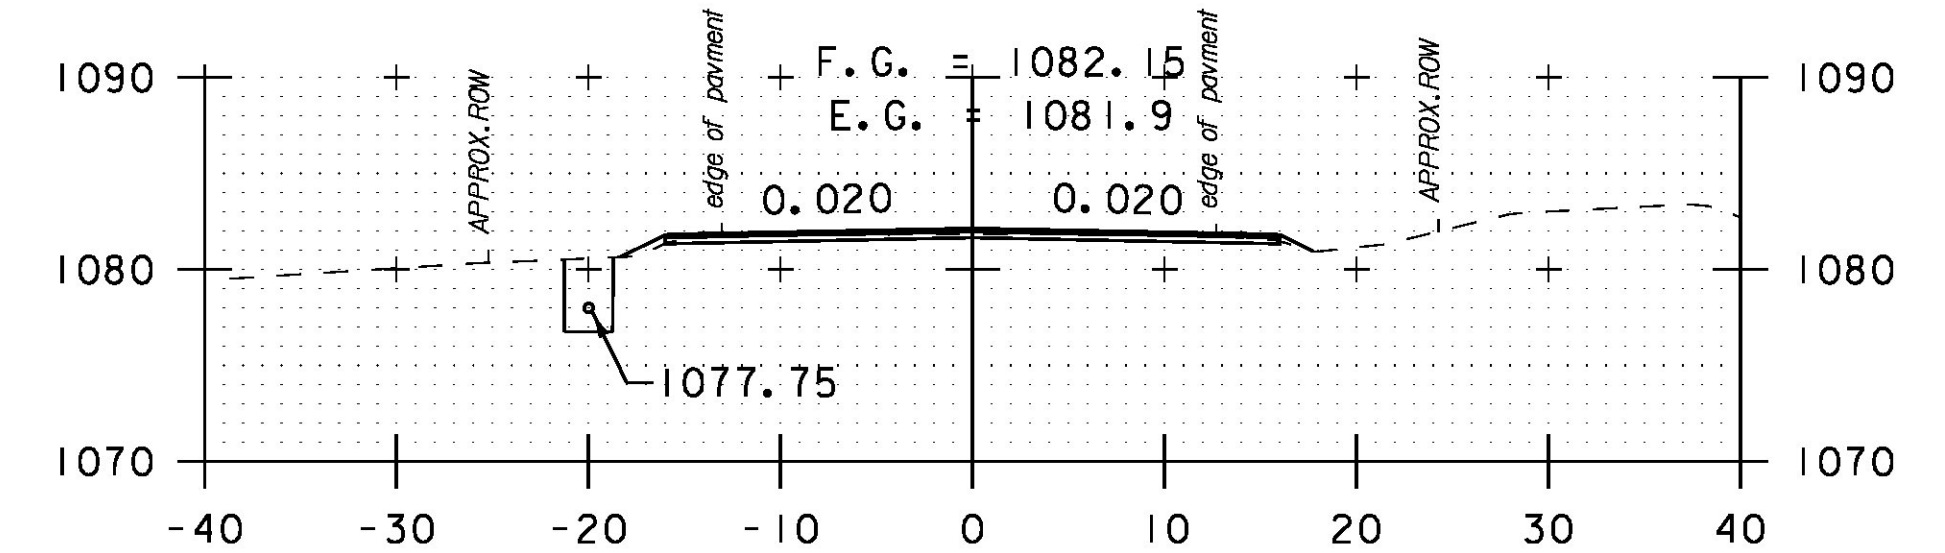

243+50



PROJECT NAME:	HANCOCK	PLOT DATE:	3/18/2015
PROJECT NUMBER:	STP 2923 (1)	DRAWN BY:	B. MARTIN
FILE NAME:	z10c252xs.dgn	CHECKED BY:	C. LATHROP
PROJECT LEADER:	C. LATHROP	CROSS SECTION SHEET	45
DESIGNED BY:	B. MARTIN	SHEET	172 OF 207