

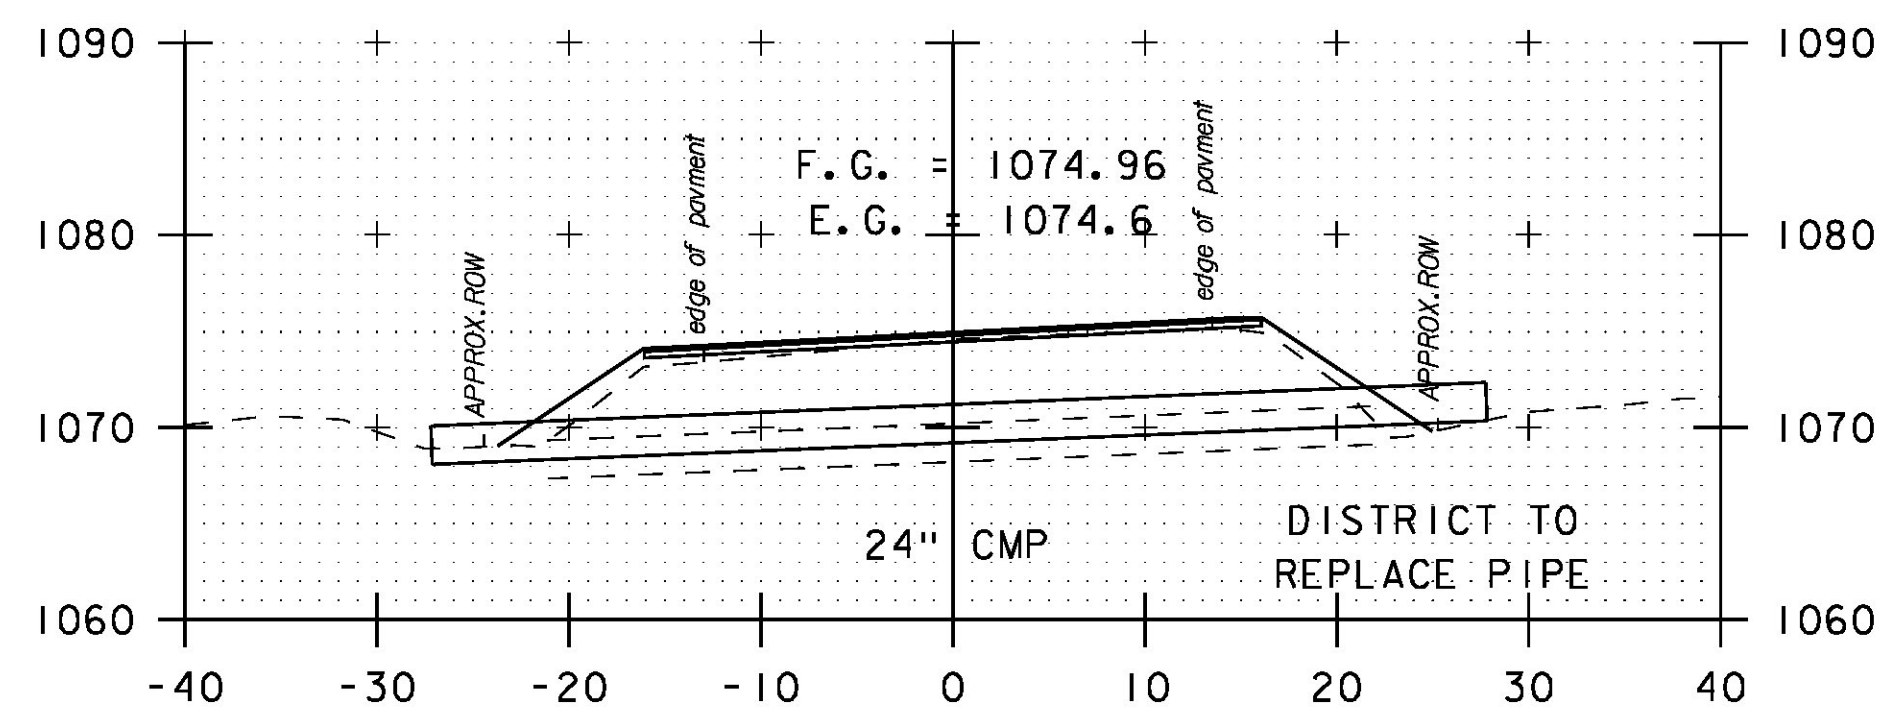



246+50

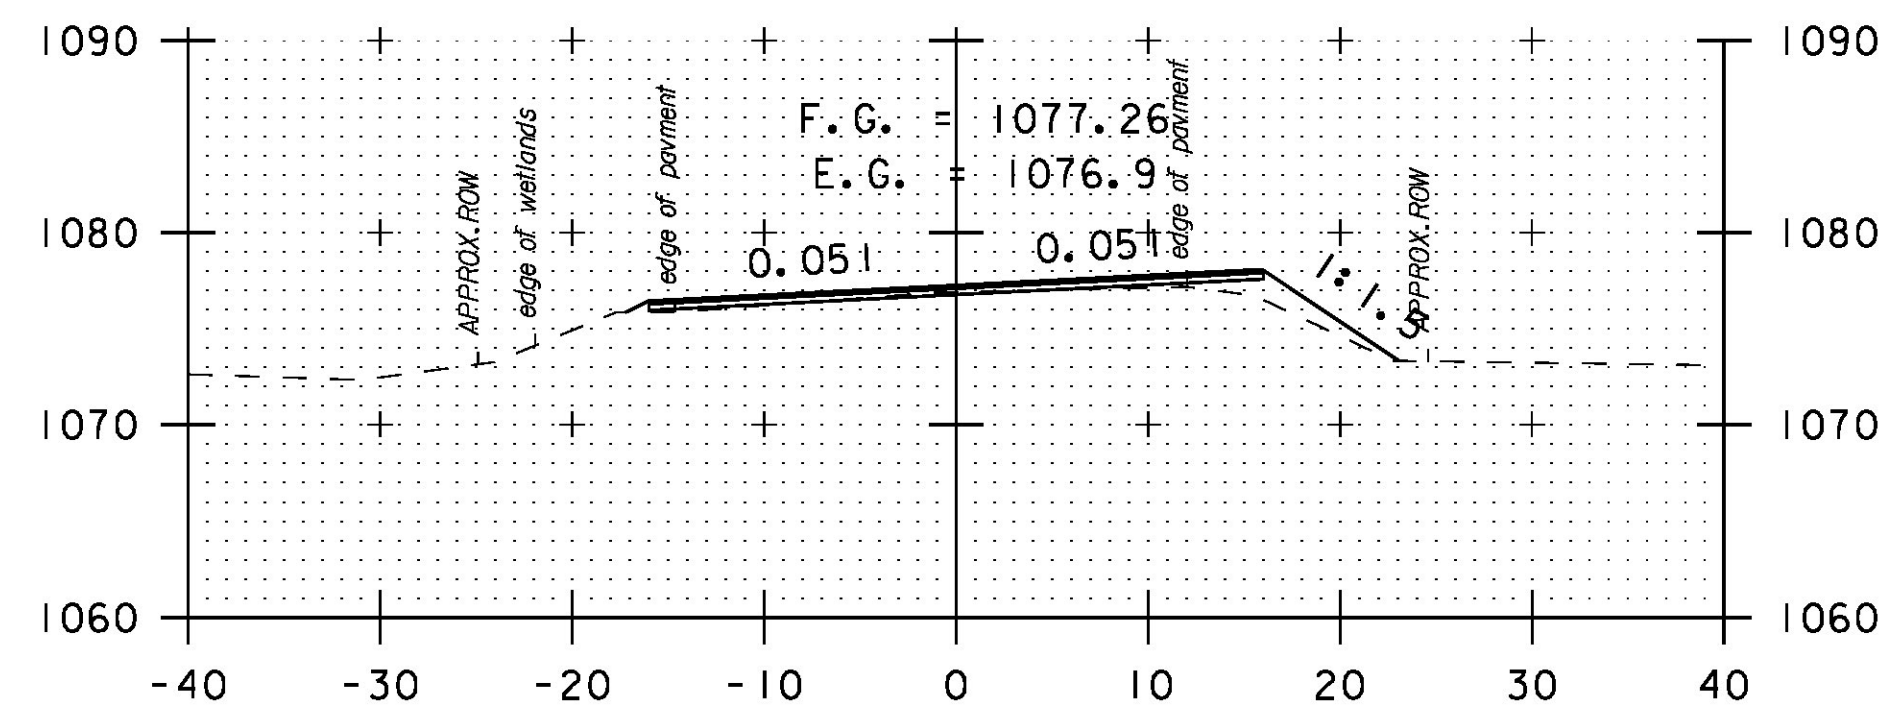



247+57
SKEWED

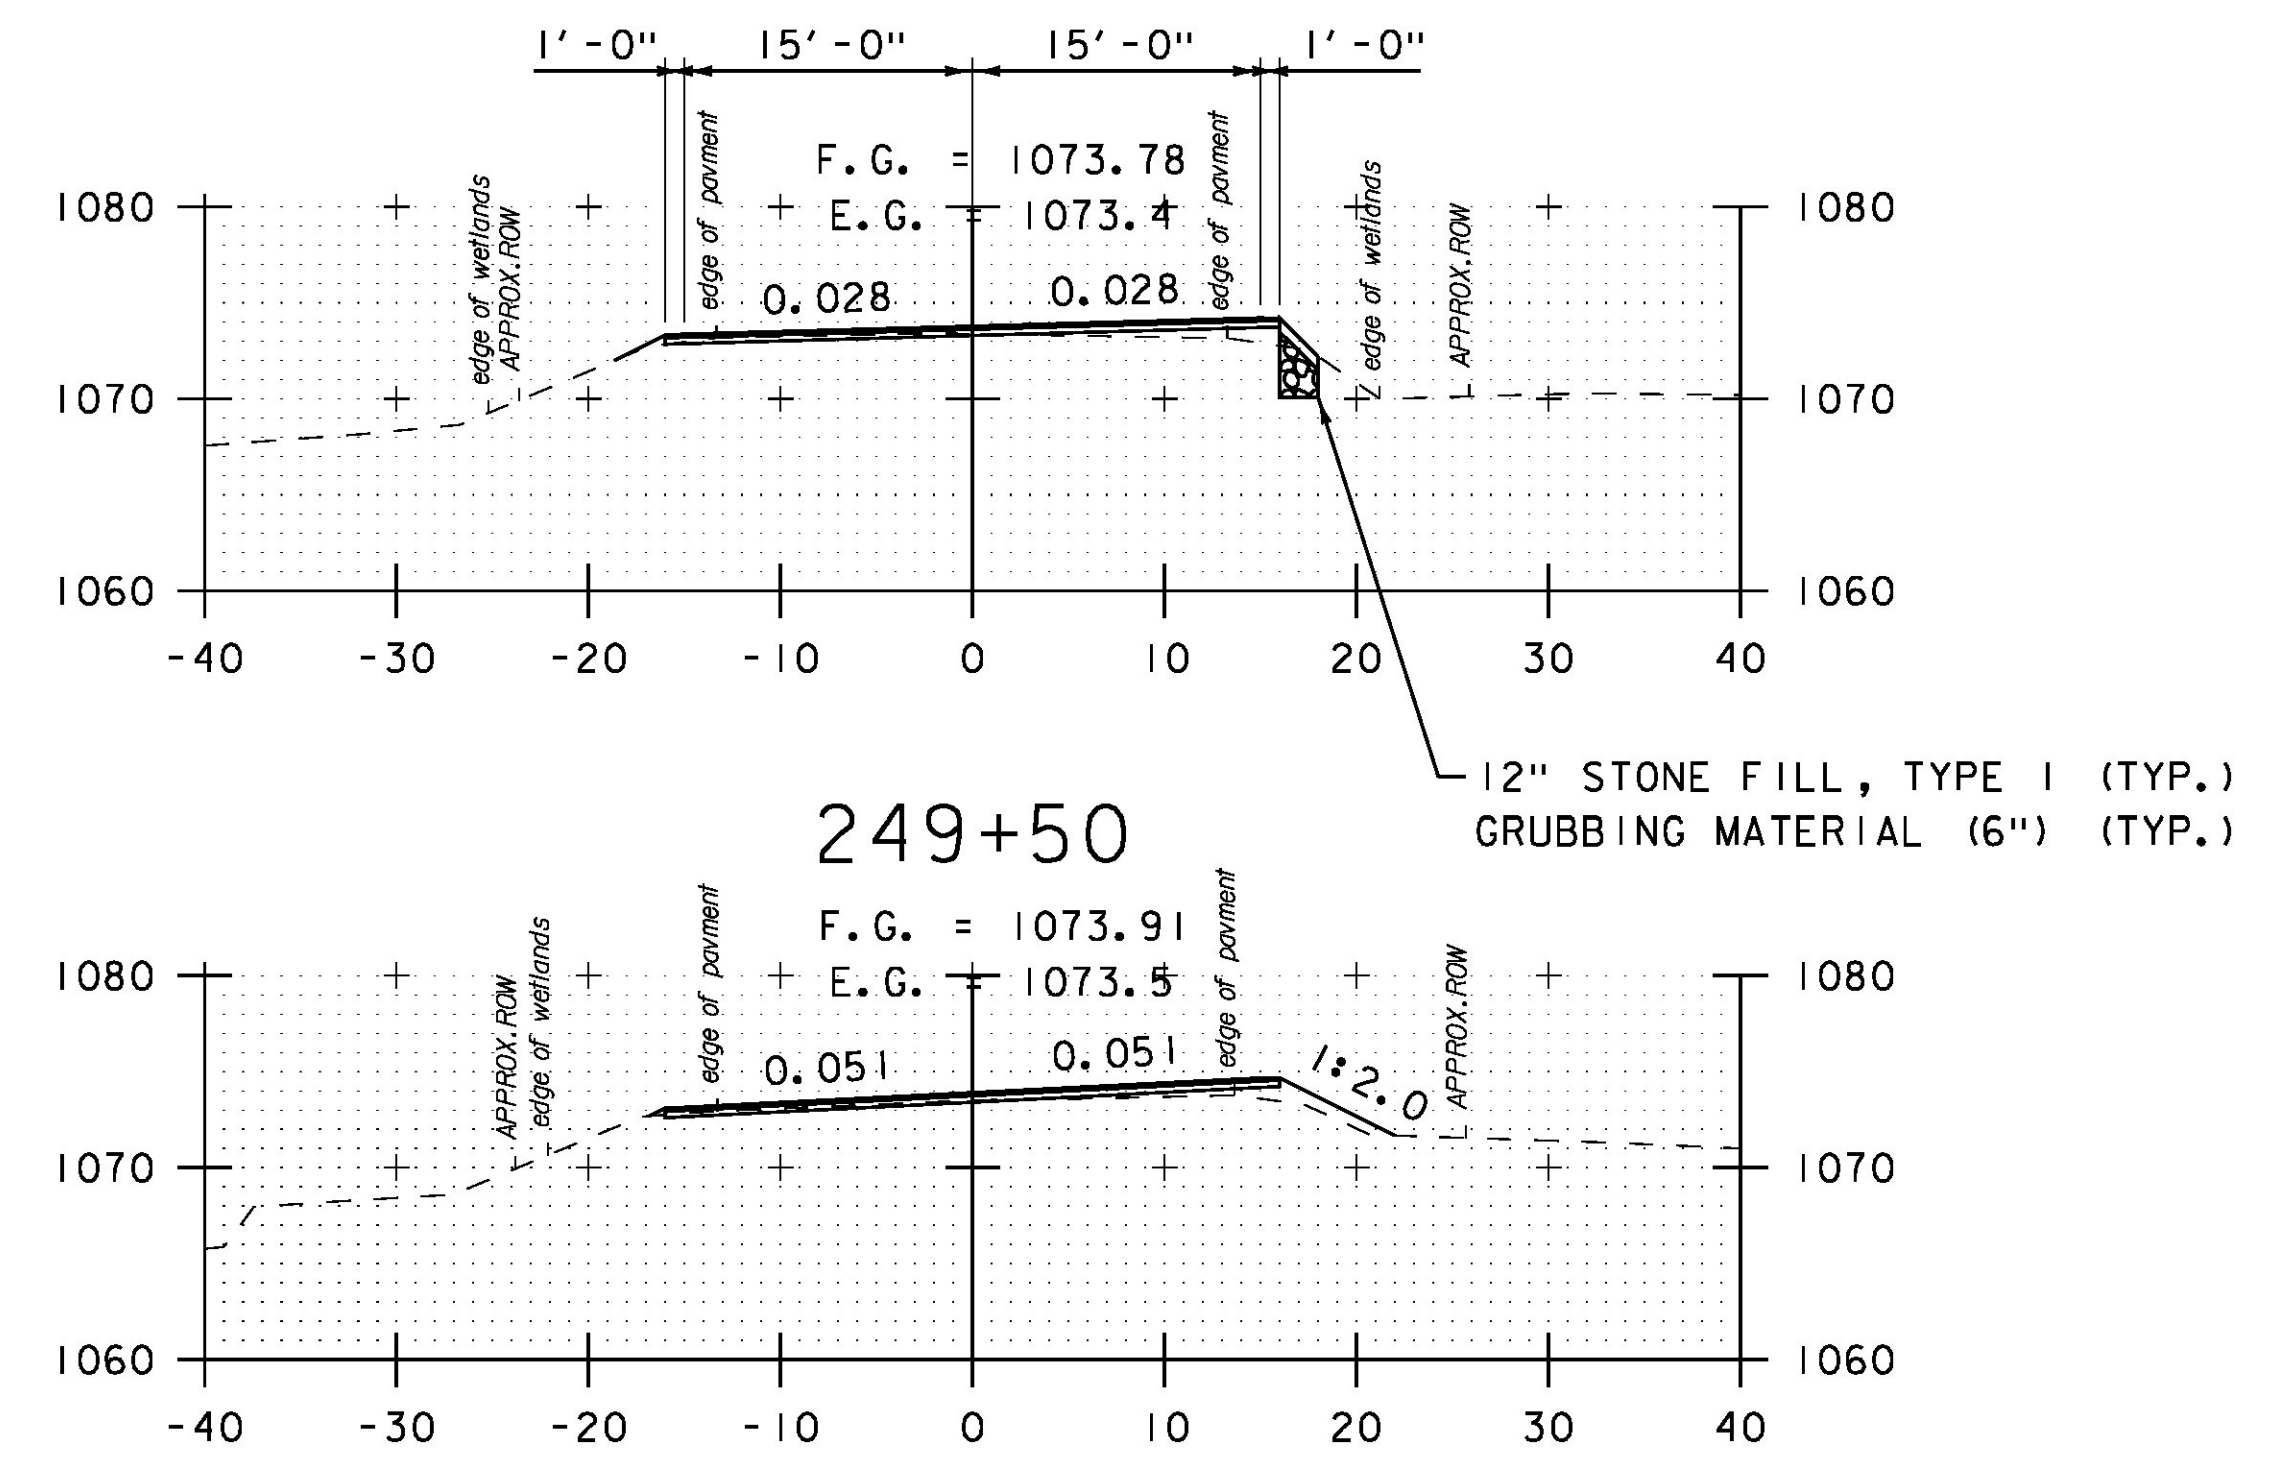


246+00

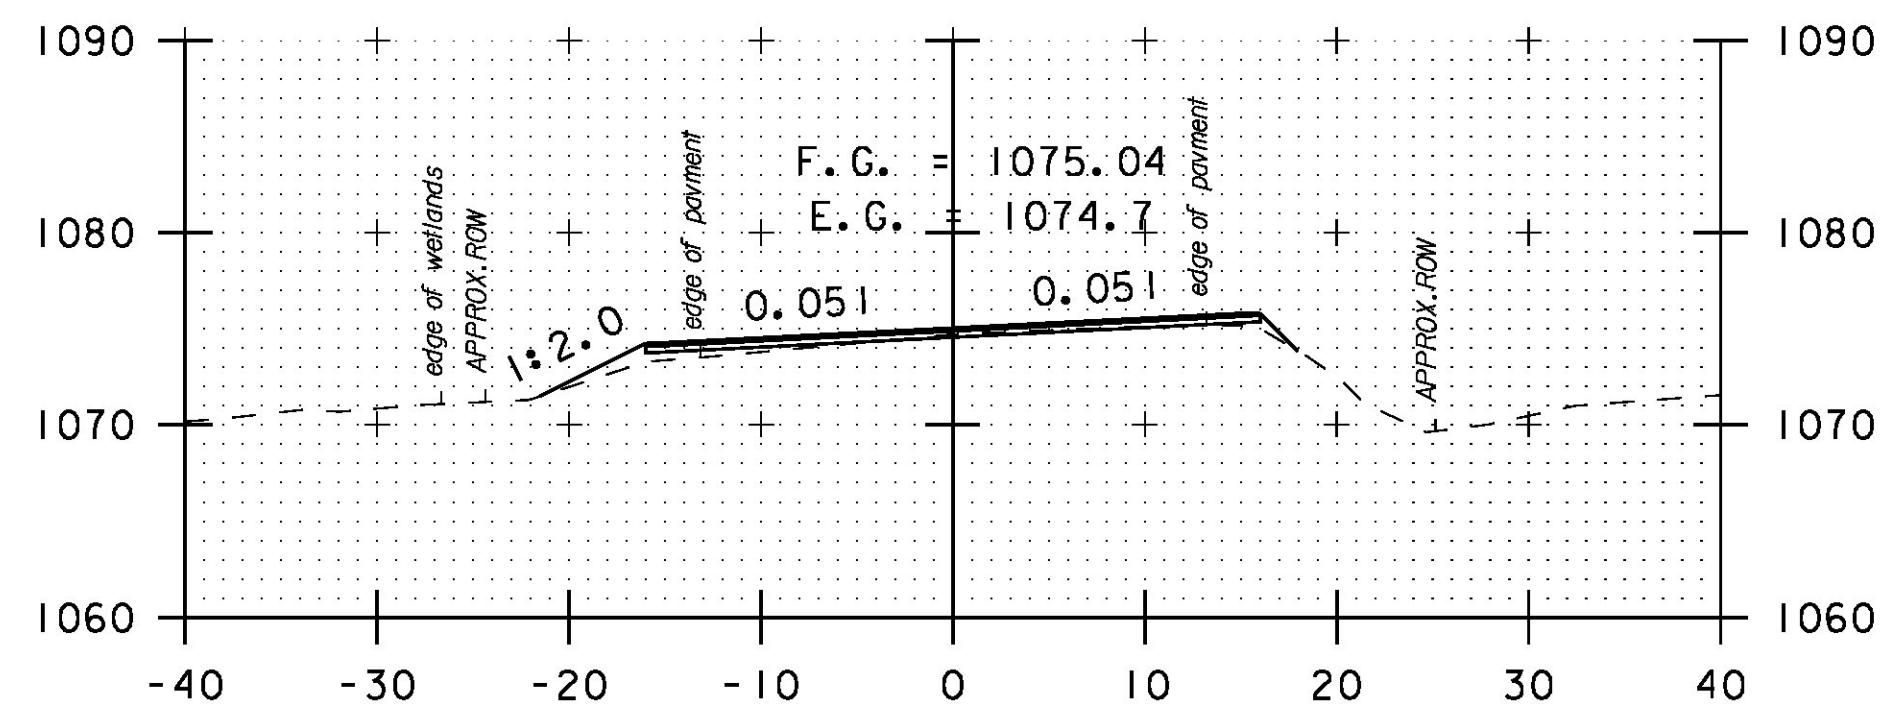


247+50

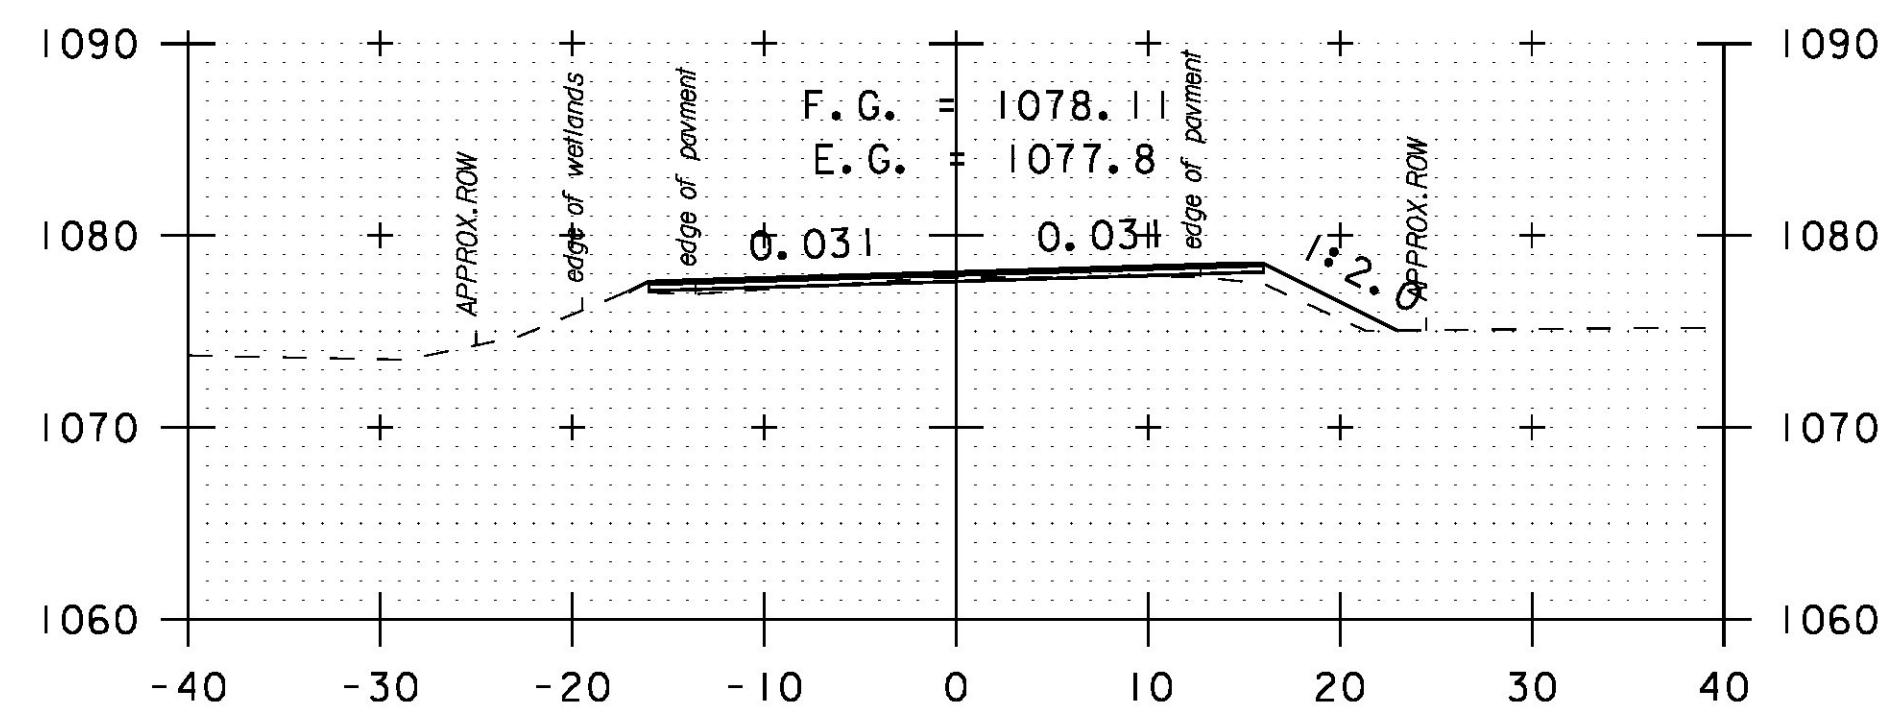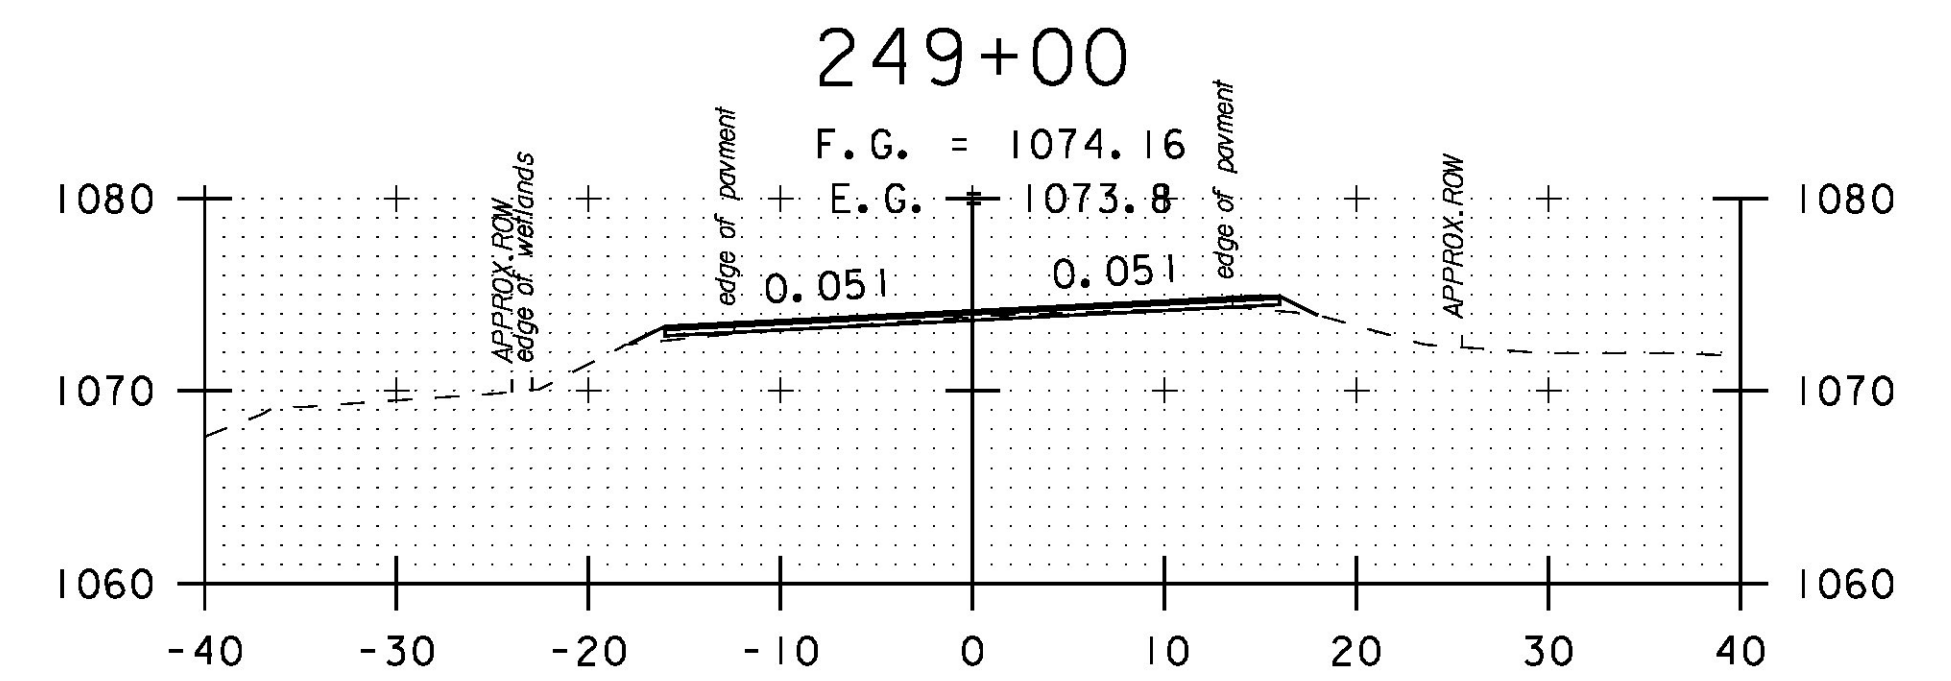

245+50

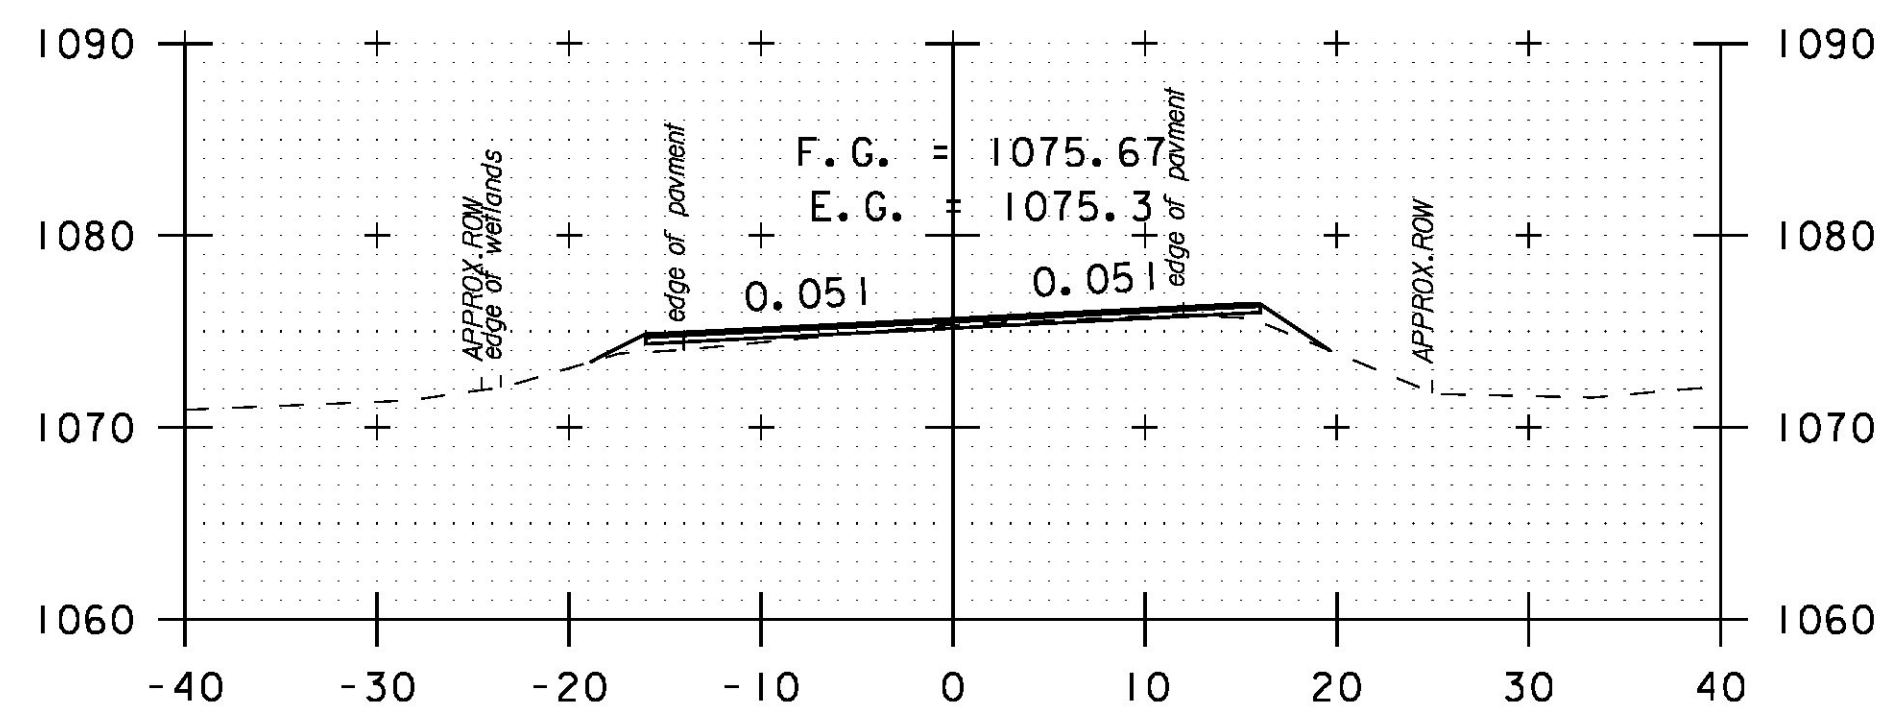

247+00

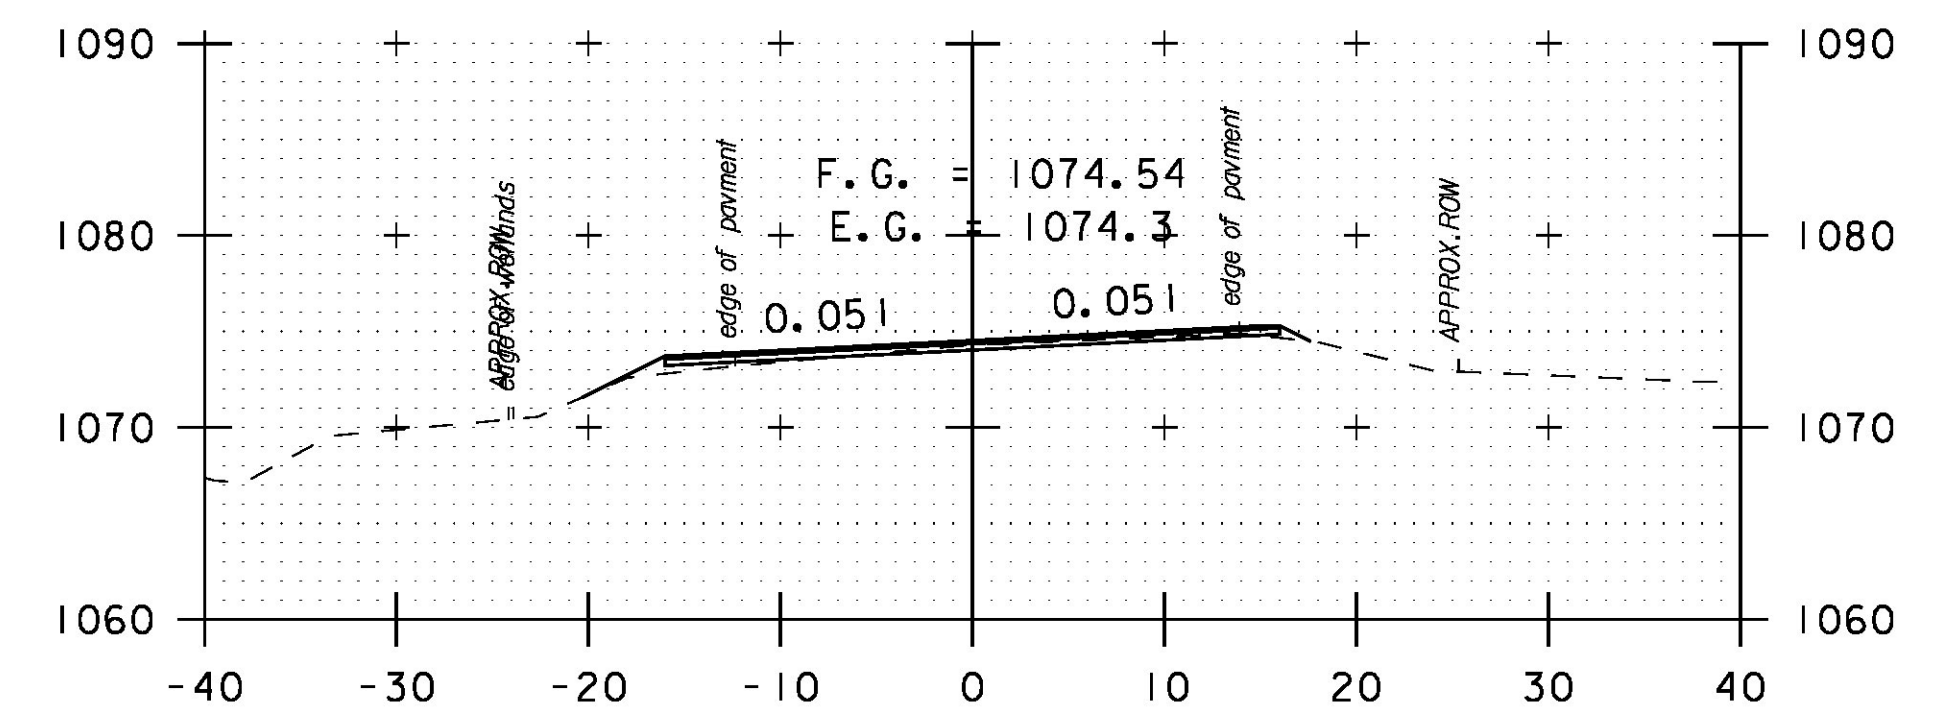

248+00



PROJECT NAME:	HANCOCK	PLOT DATE:	3/18/2015
PROJECT NUMBER:	STP 2923 (1)	DRAWN BY:	B. MARTIN
FILE NAME:	z10c252xs.dgn	DESIGNED BY:	B. MARTIN
PROJECT LEADER:	C. LATHROP	CHECKED BY:	C. LATHROP
CROSS SECTION SHEET	46	SHEET	173 OF 207