




255+00

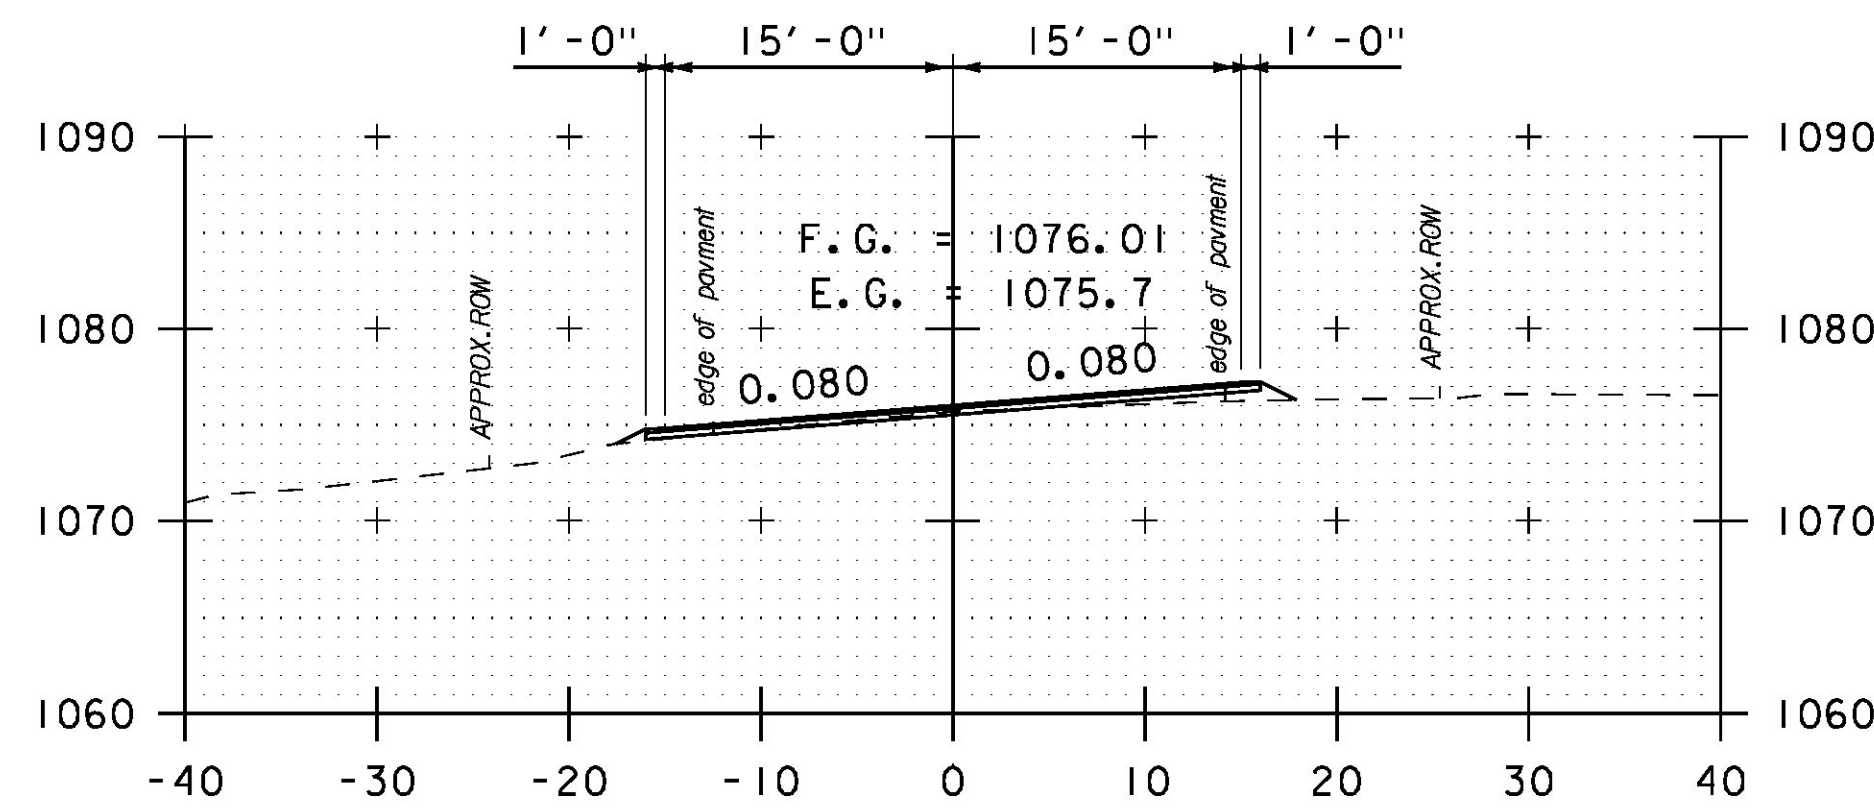


256+50
DRIVE RT

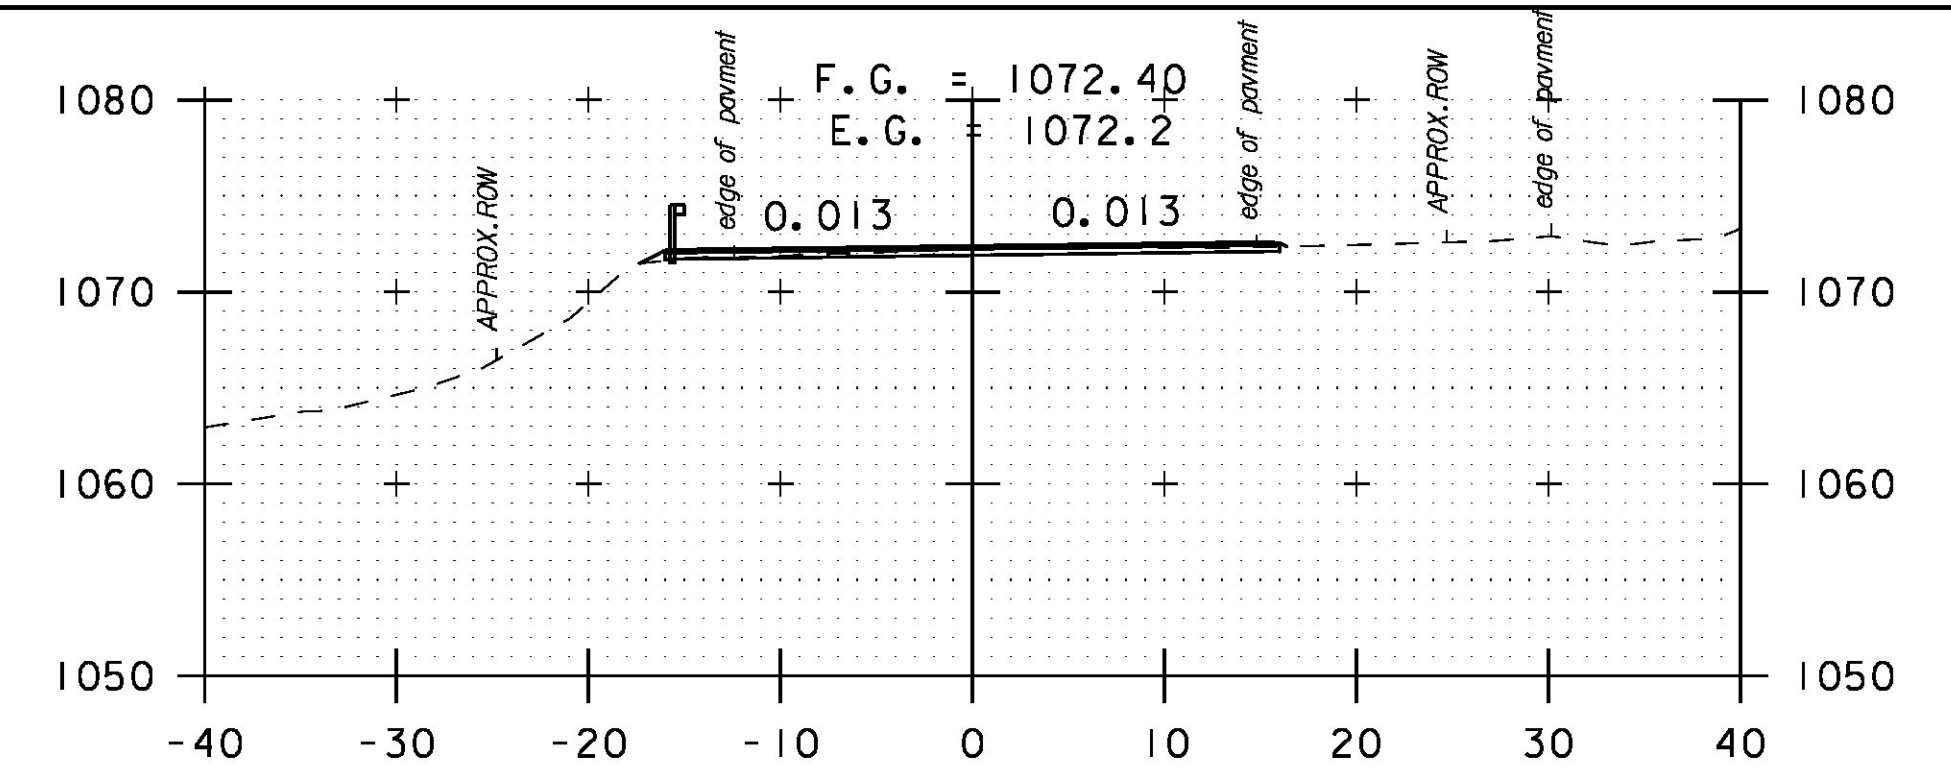


258+00
TH #17 RT

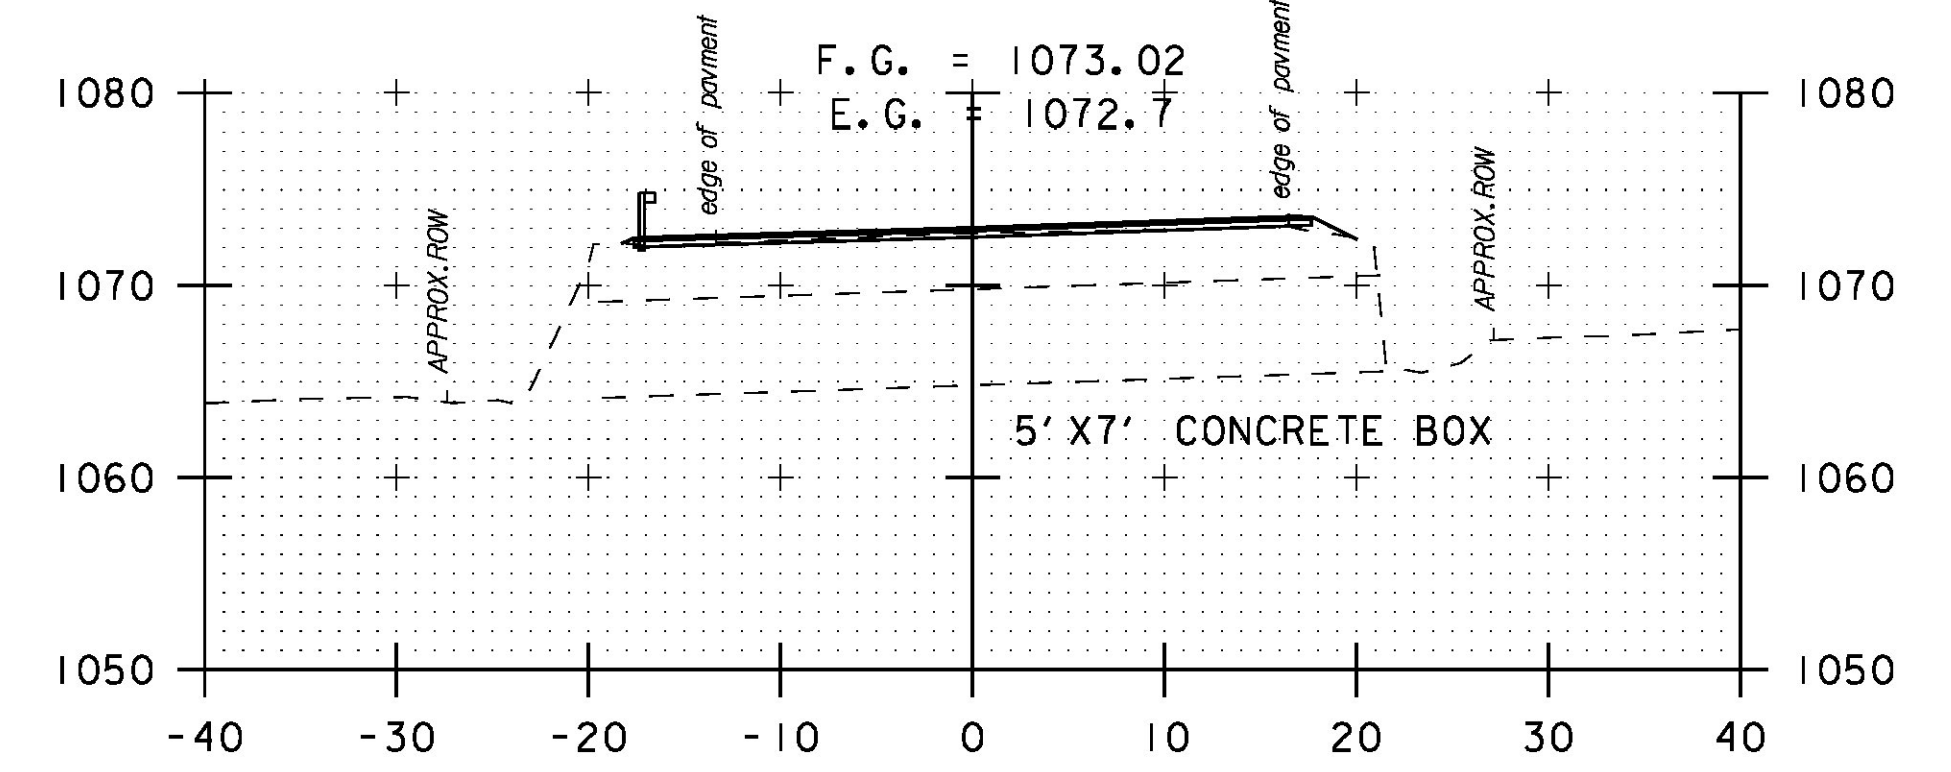


257+74
BRIDGE #22

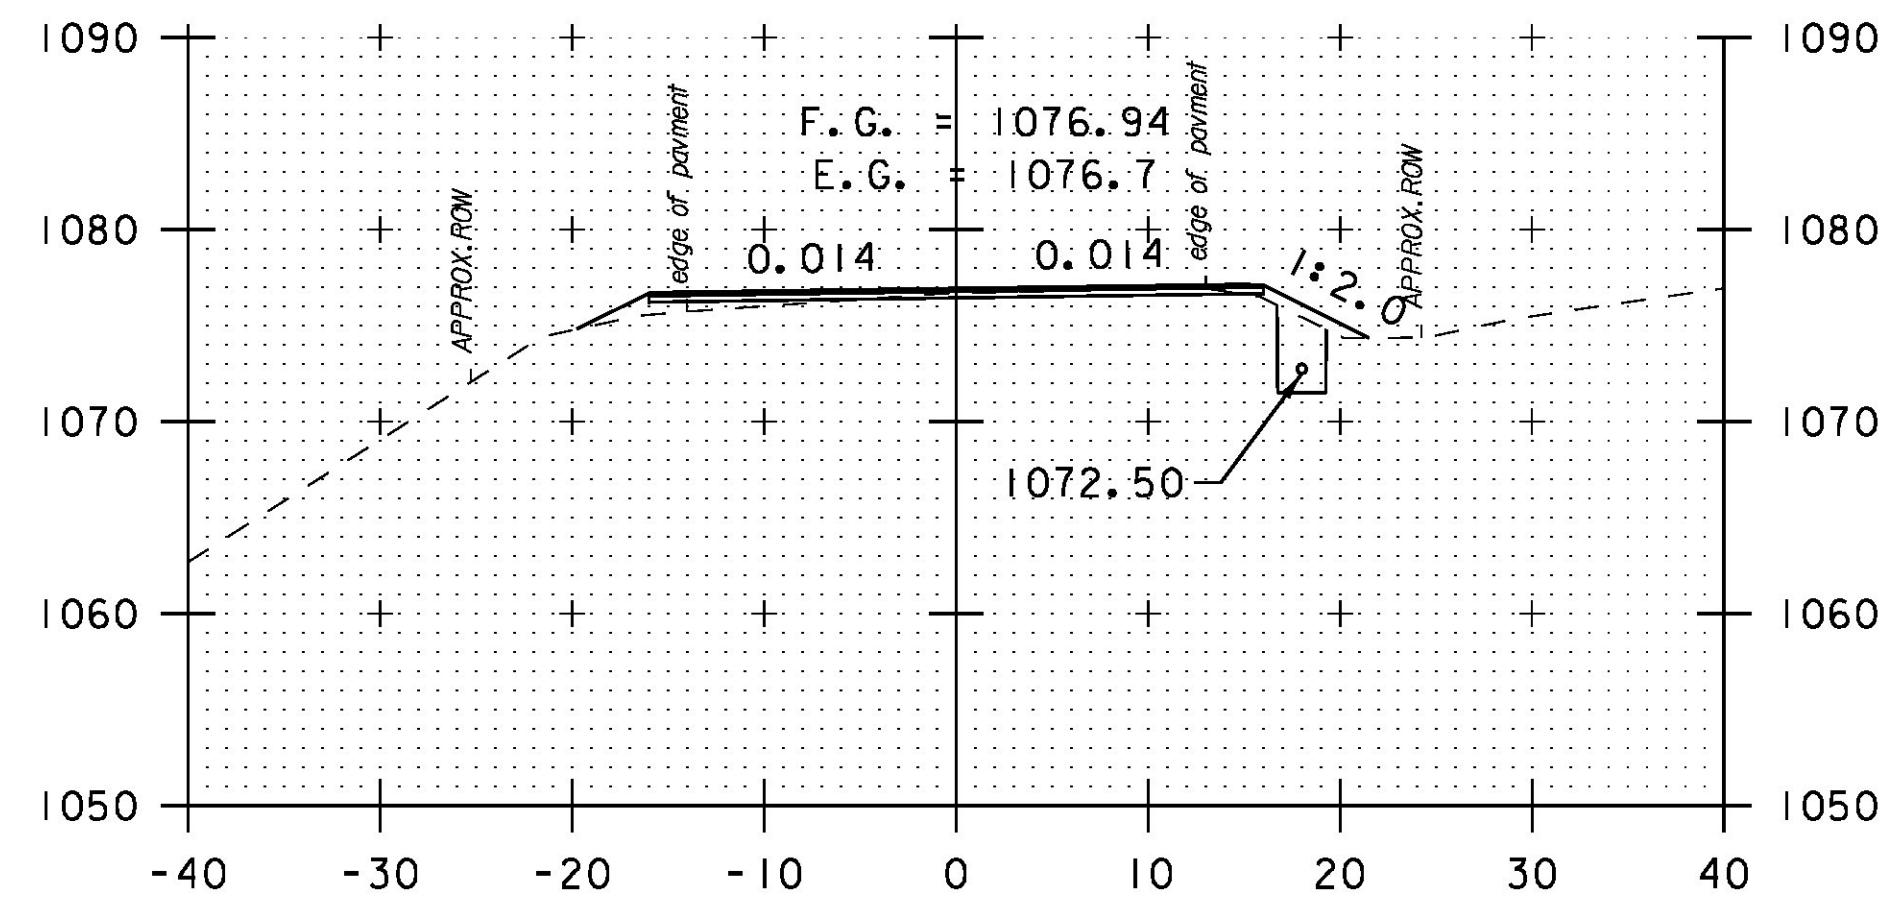


254+50

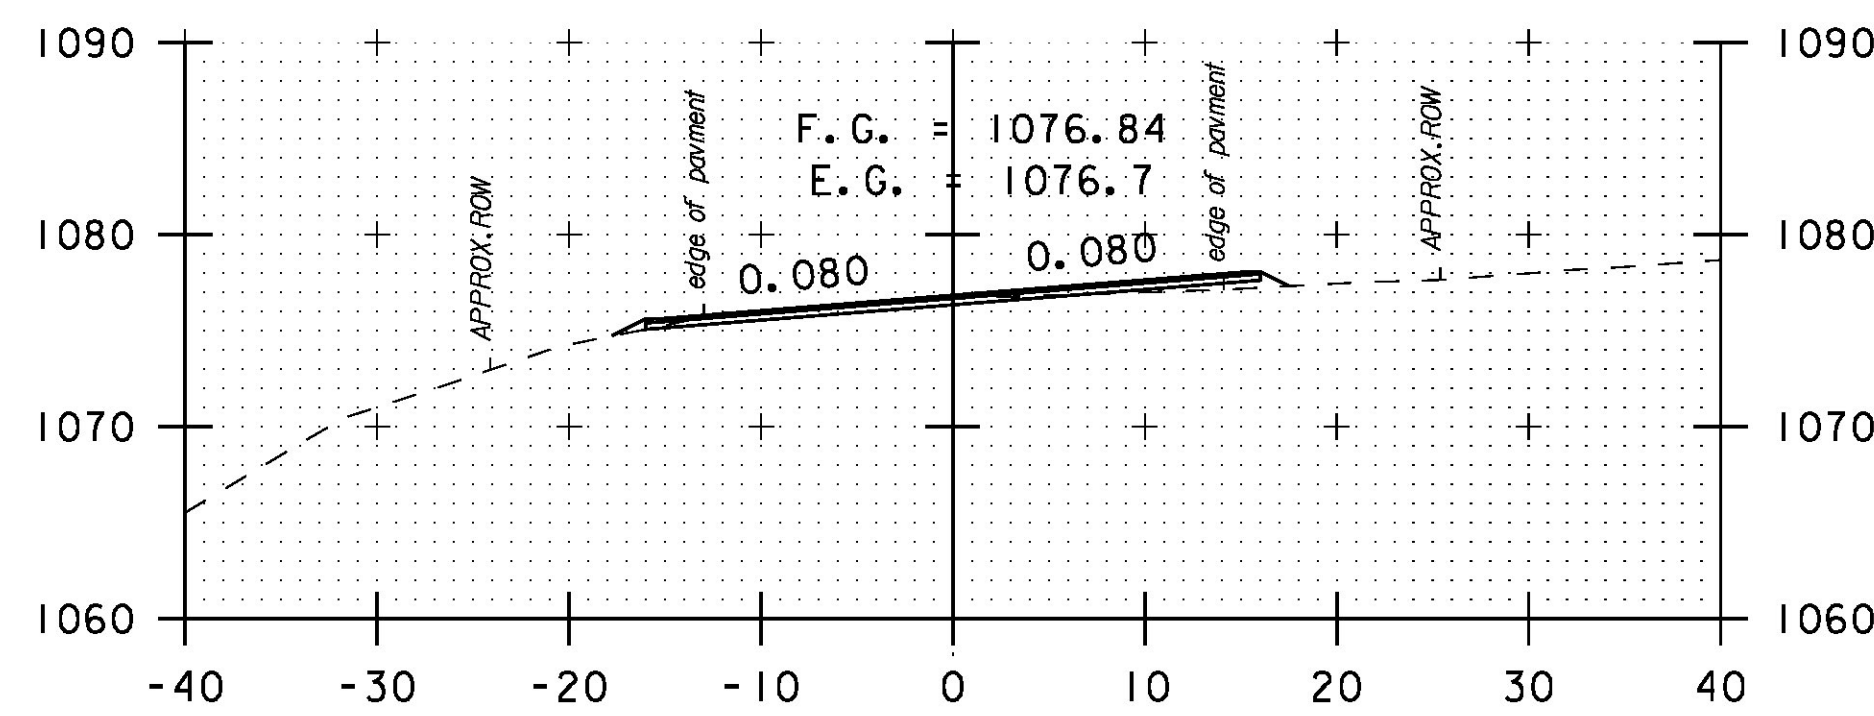


256+00
DRIVE RT

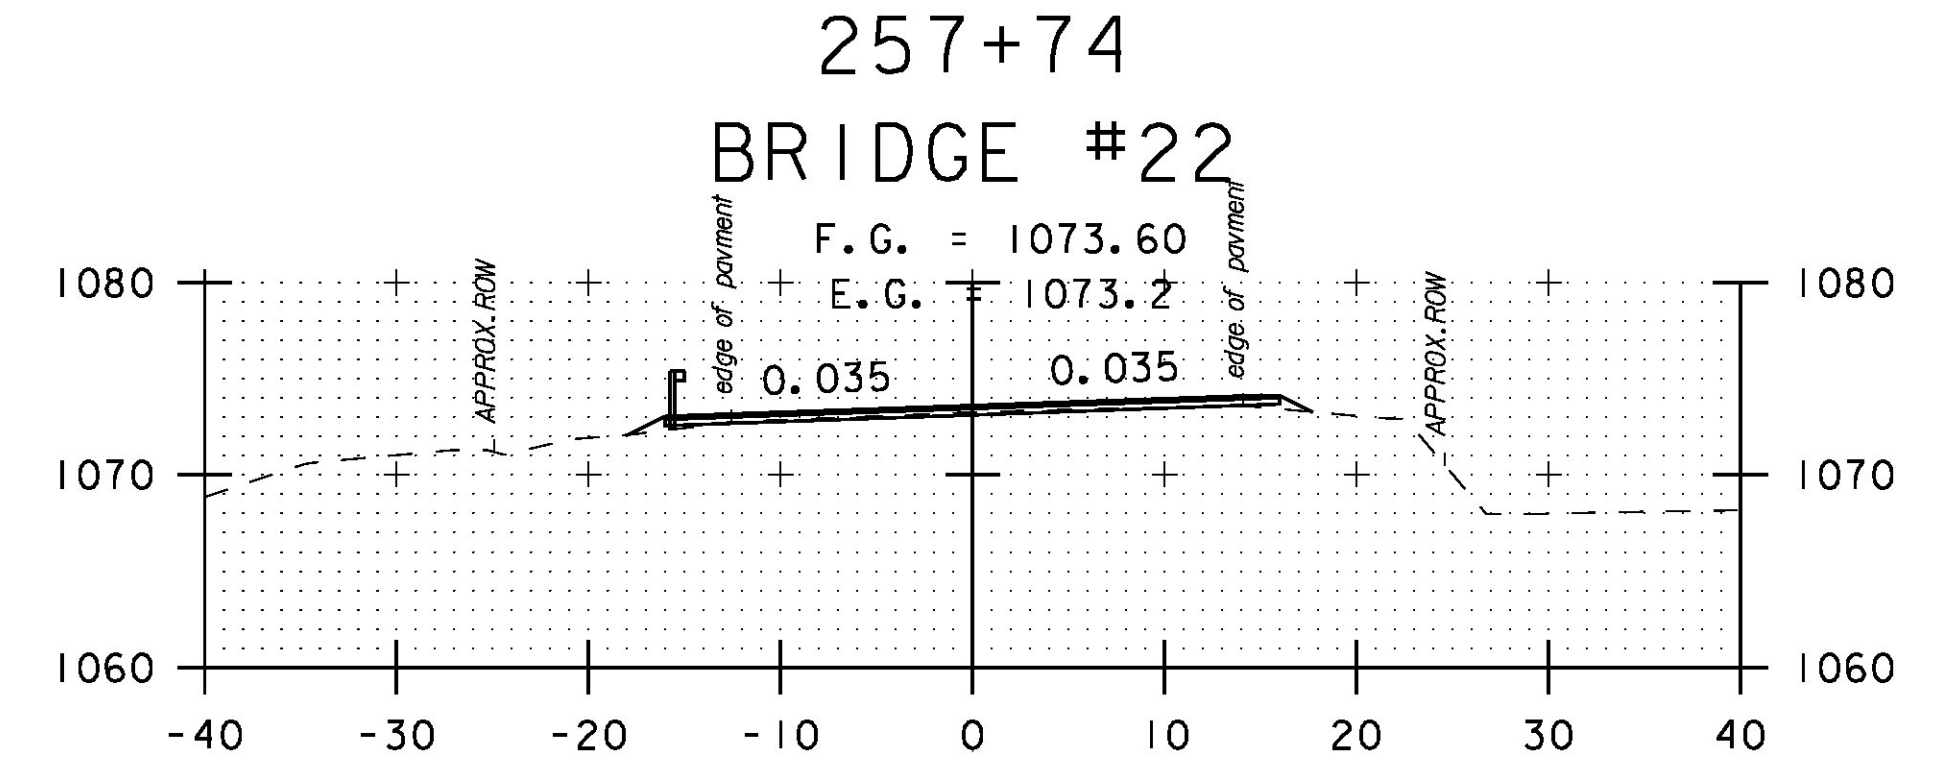


257+50

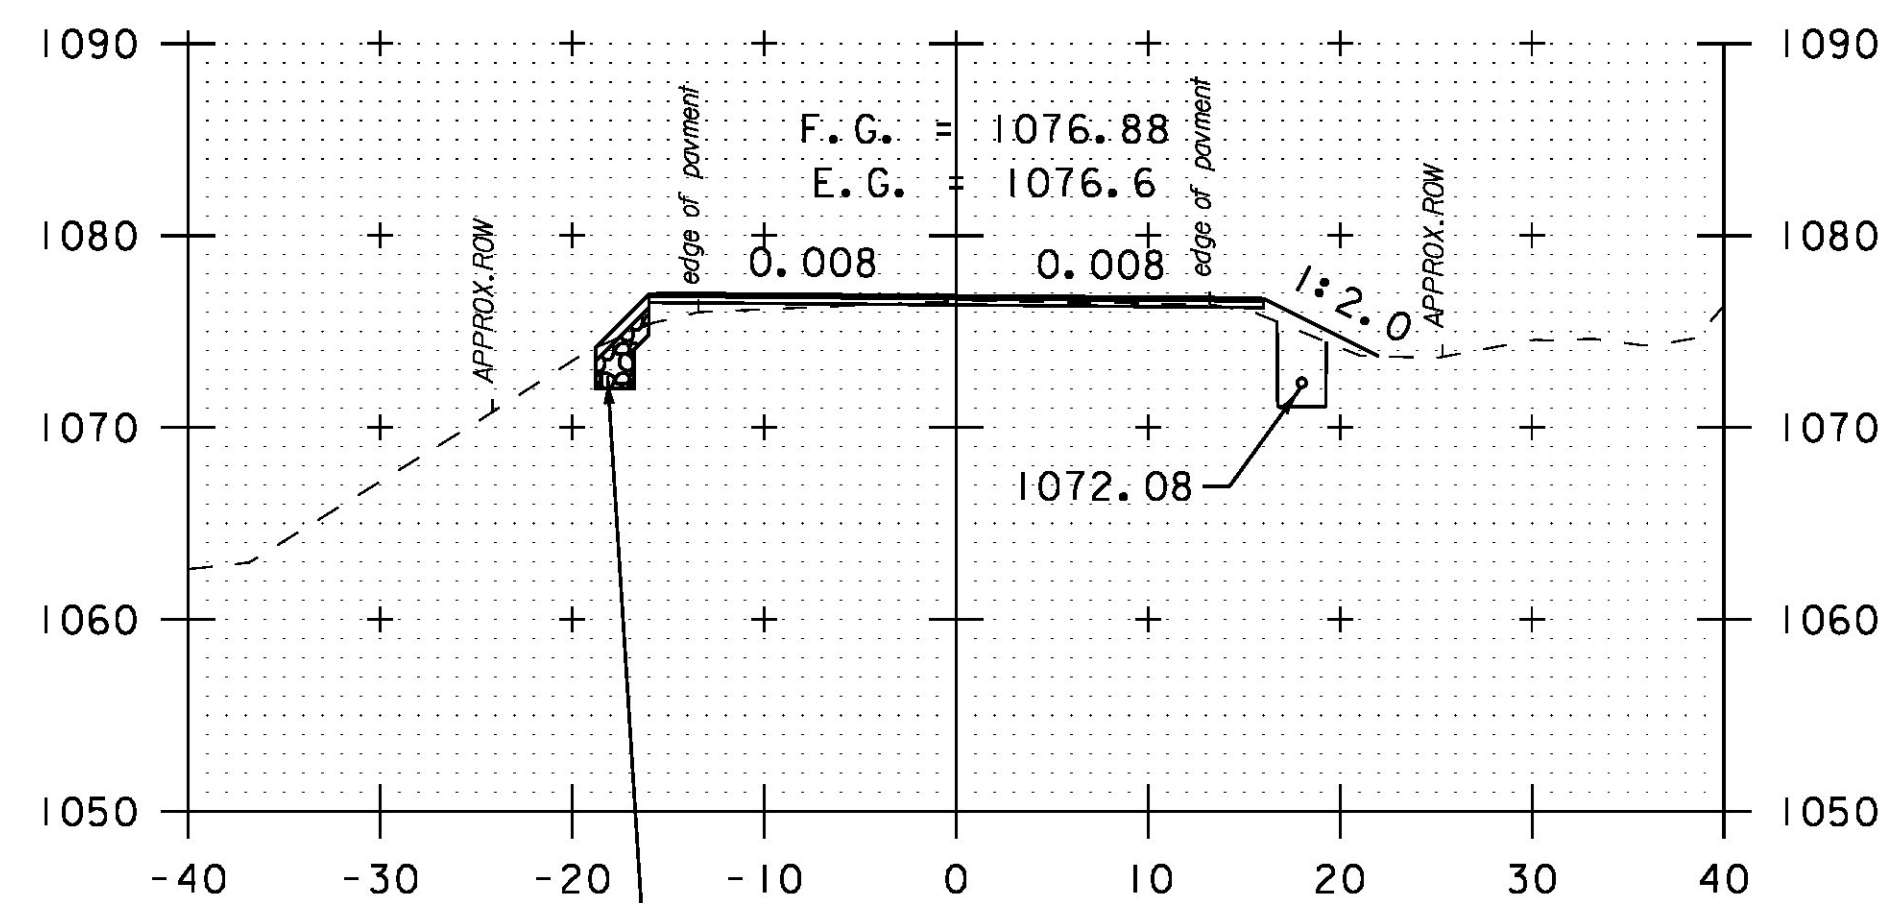

254+00

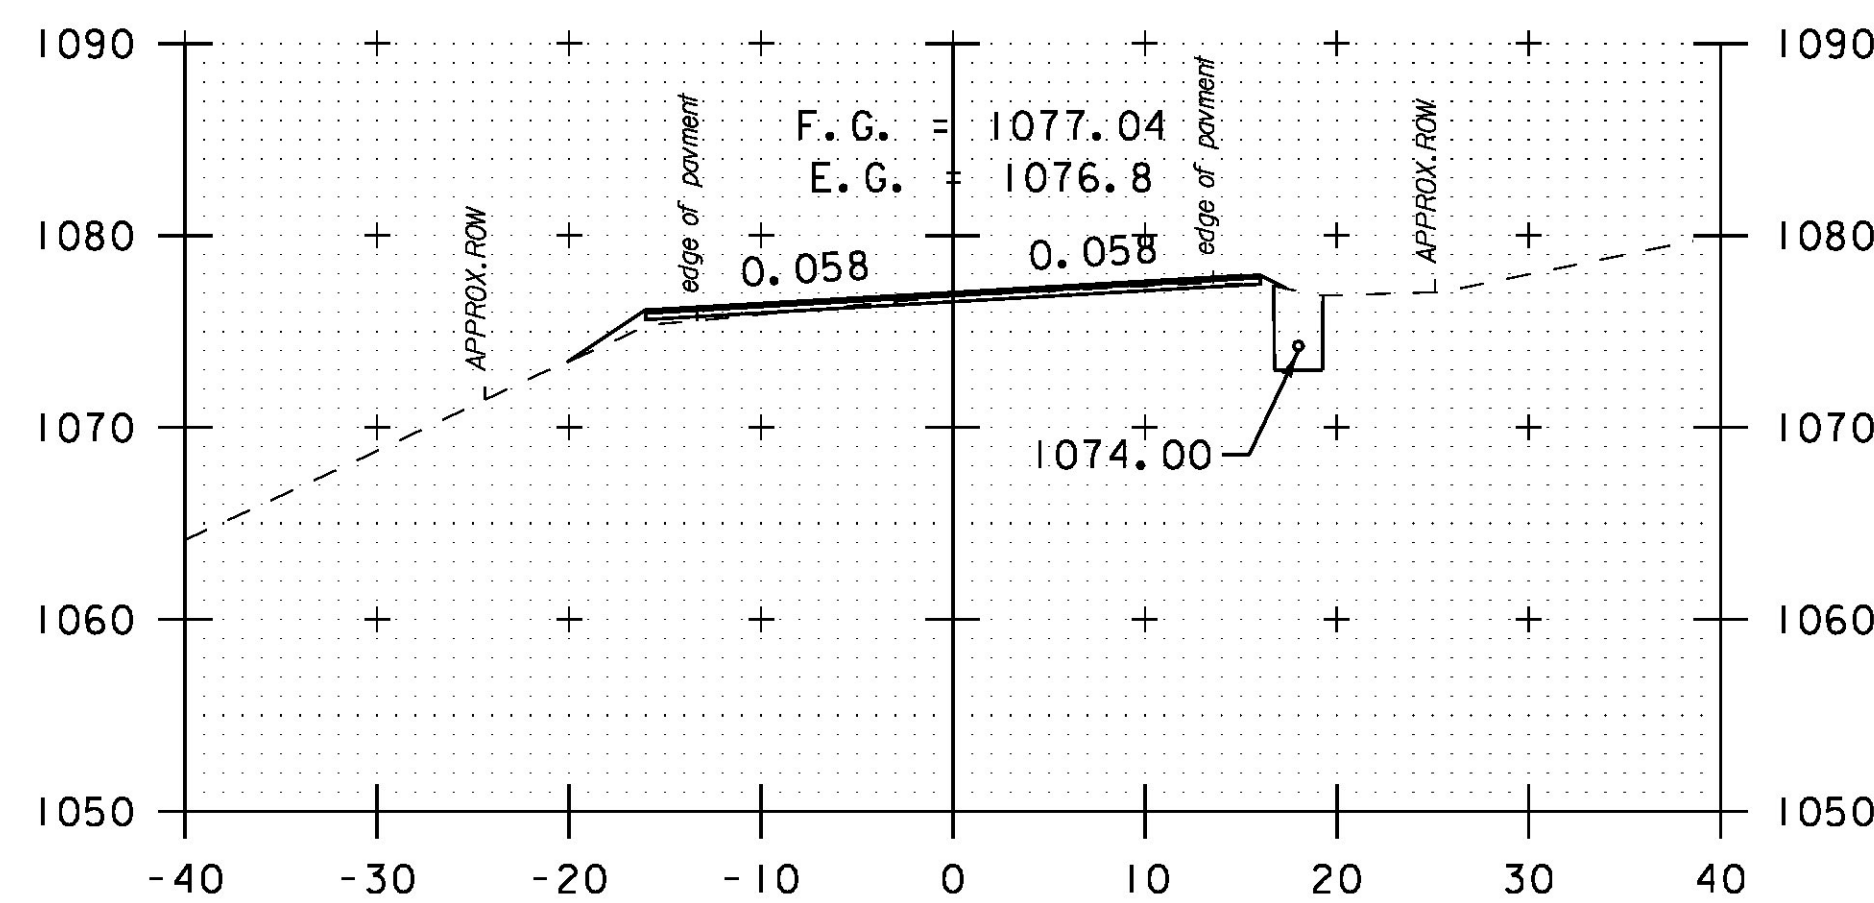

255+50

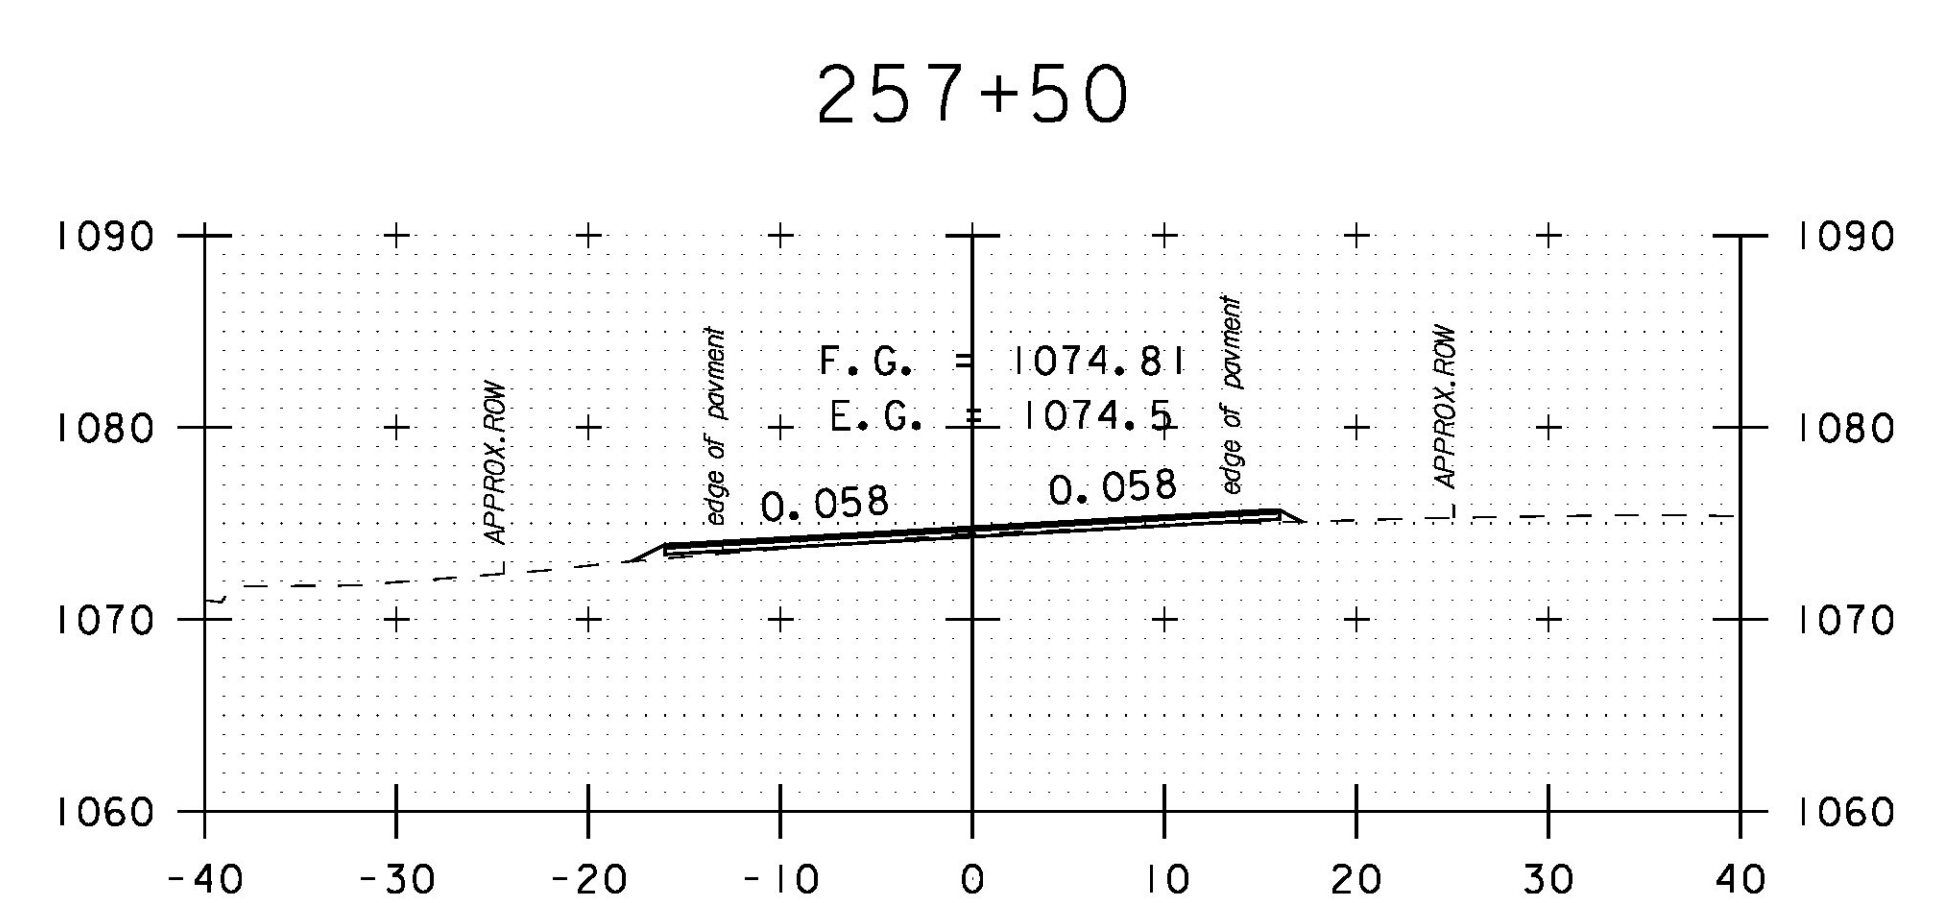

257+00
DRIVE RT

12" STONE FILL, TYPE I (TYP.)
GRUBBING MATERIAL (6") (TYP.)



PROJECT NAME: HANCOCK
PROJECT NUMBER: STP 2923 (1)

FILE NAME: z10c252xs.dgn
PROJECT LEADER: C. LATHROP
DESIGNED BY: B. MARTIN
CROSS SECTION SHEET 48

PLOT DATE: 3/18/2015
DRAWN BY: B. MARTIN
CHECKED BY: C. LATHROP
SHEET 175 OF 207