




260+00
DRIVE LT

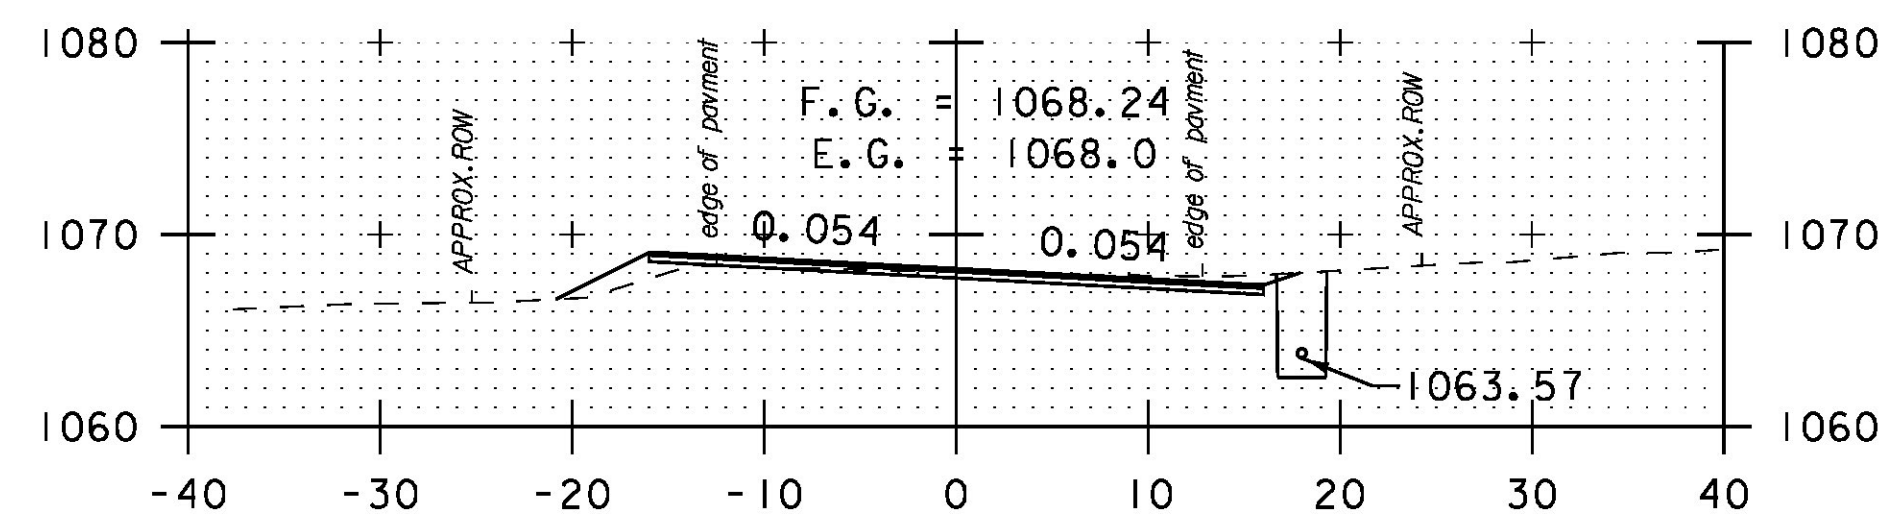


259+50
DRIVE RT

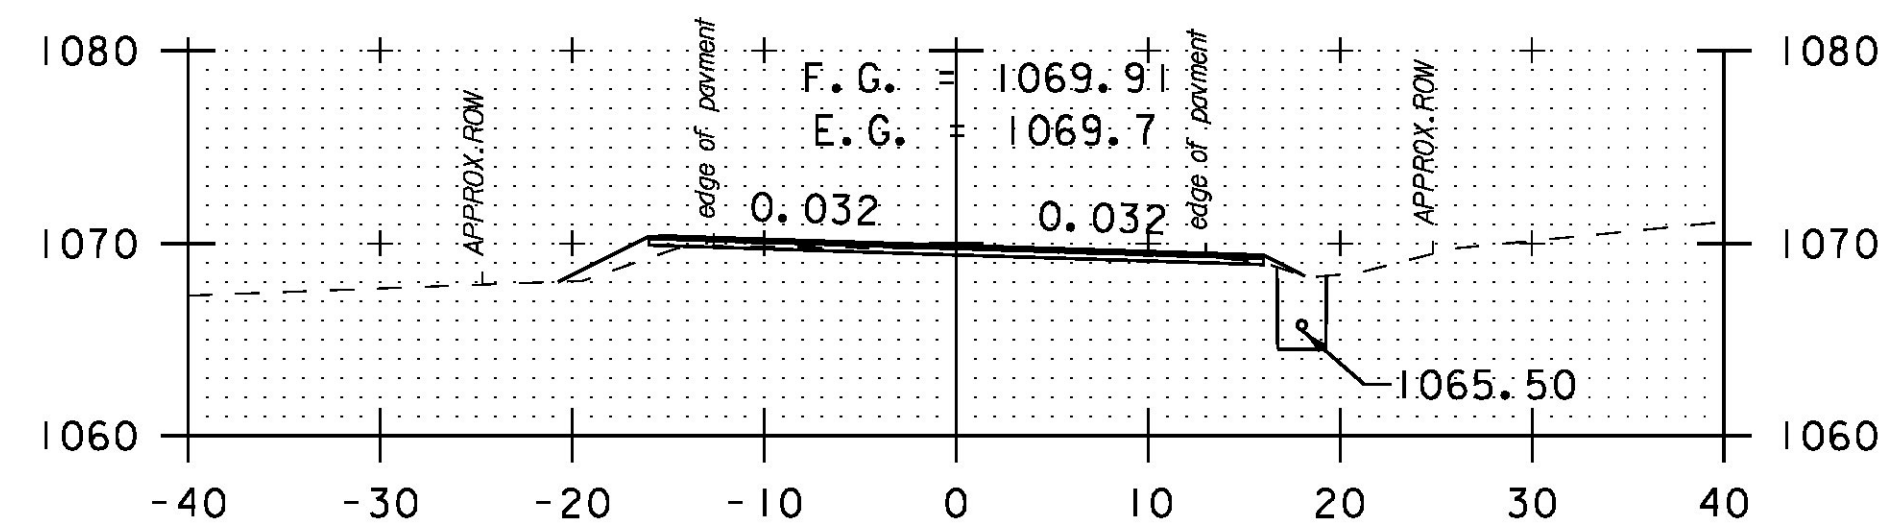


259+00

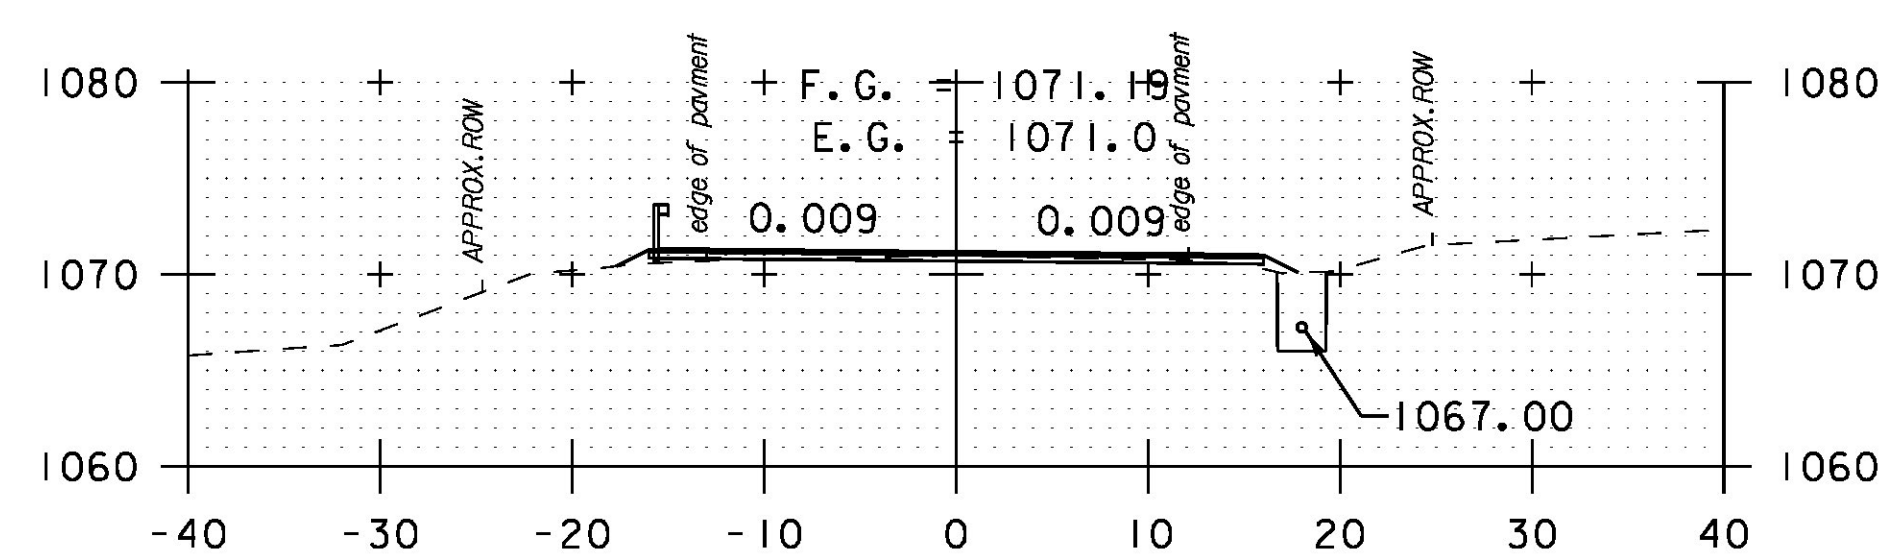


258+50

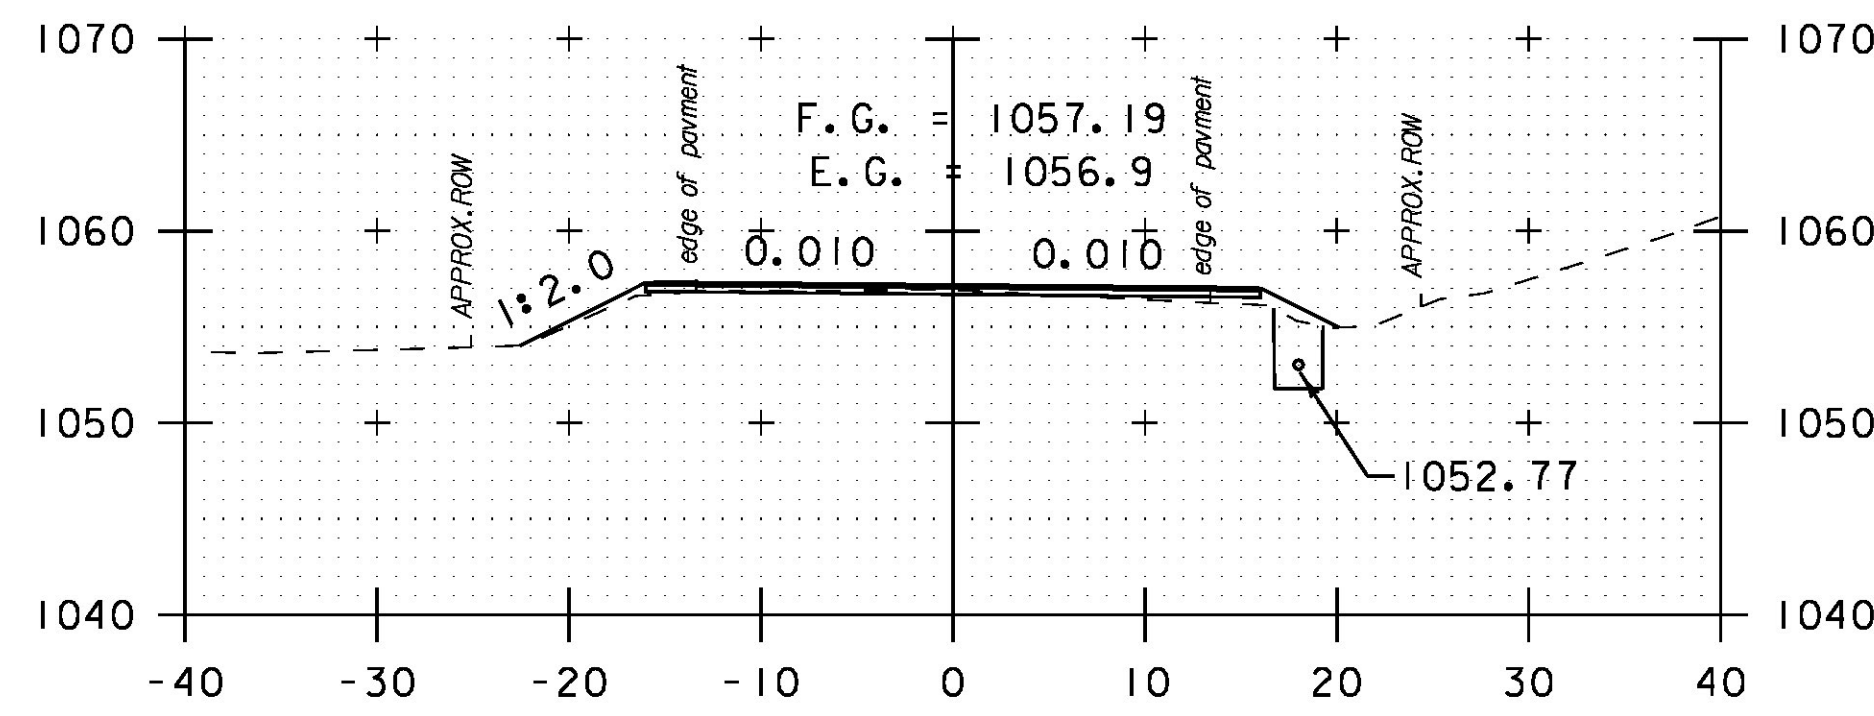


262+00

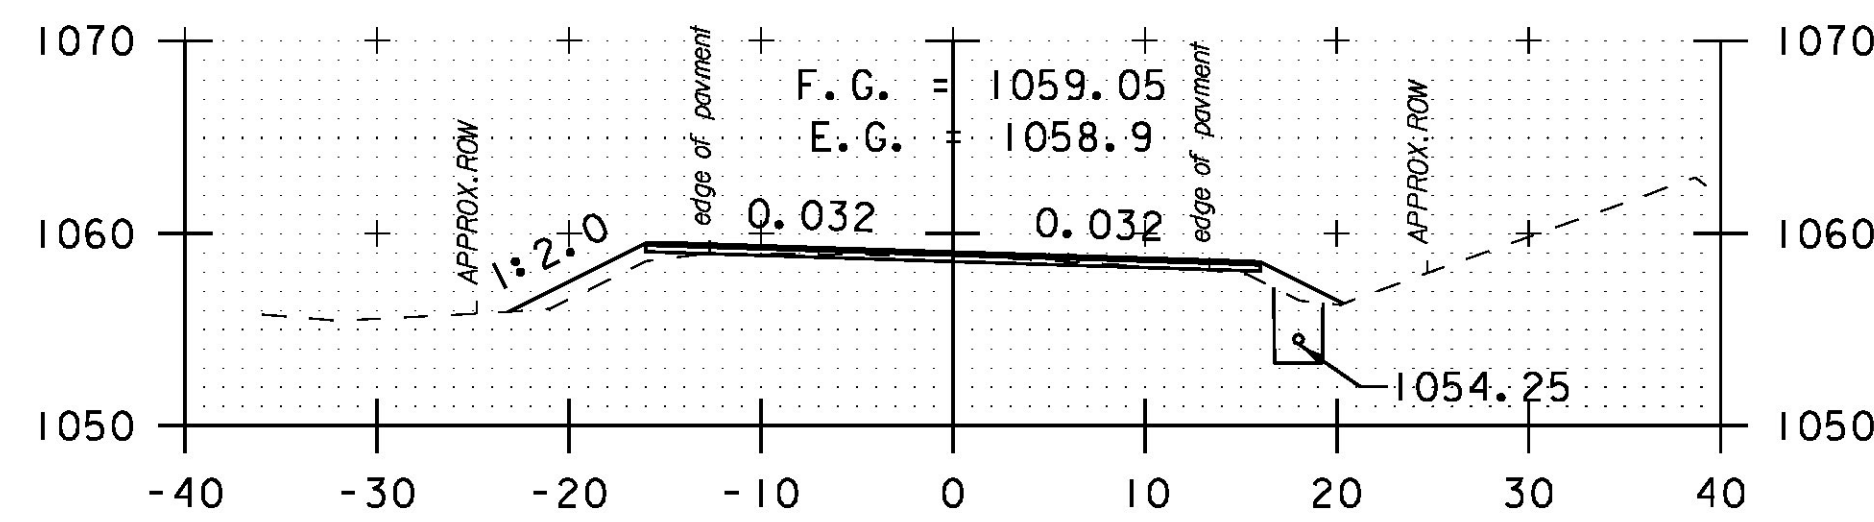


261+50

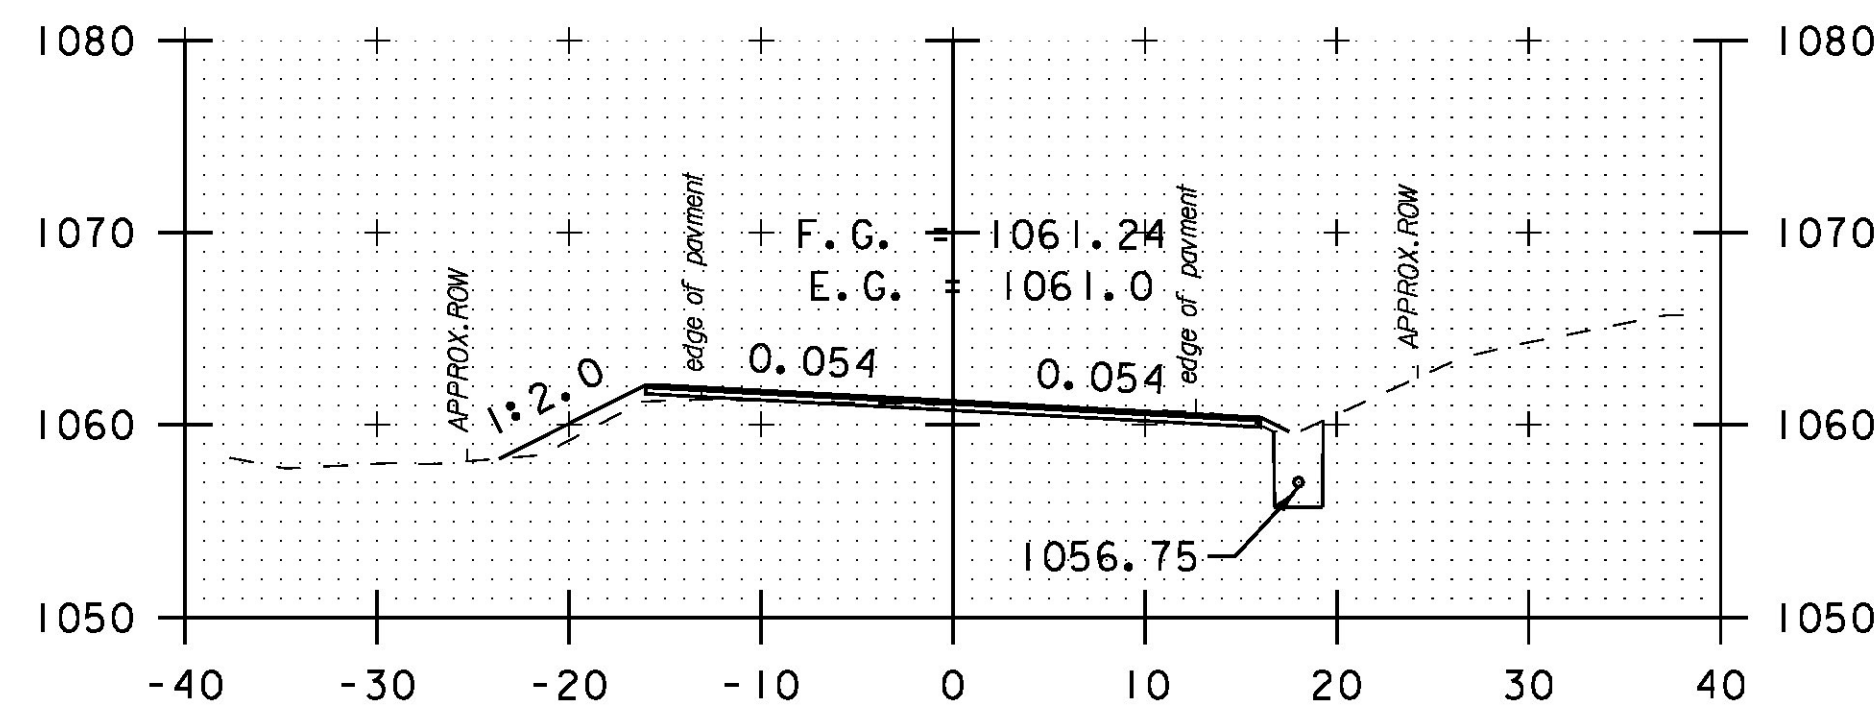


261+00

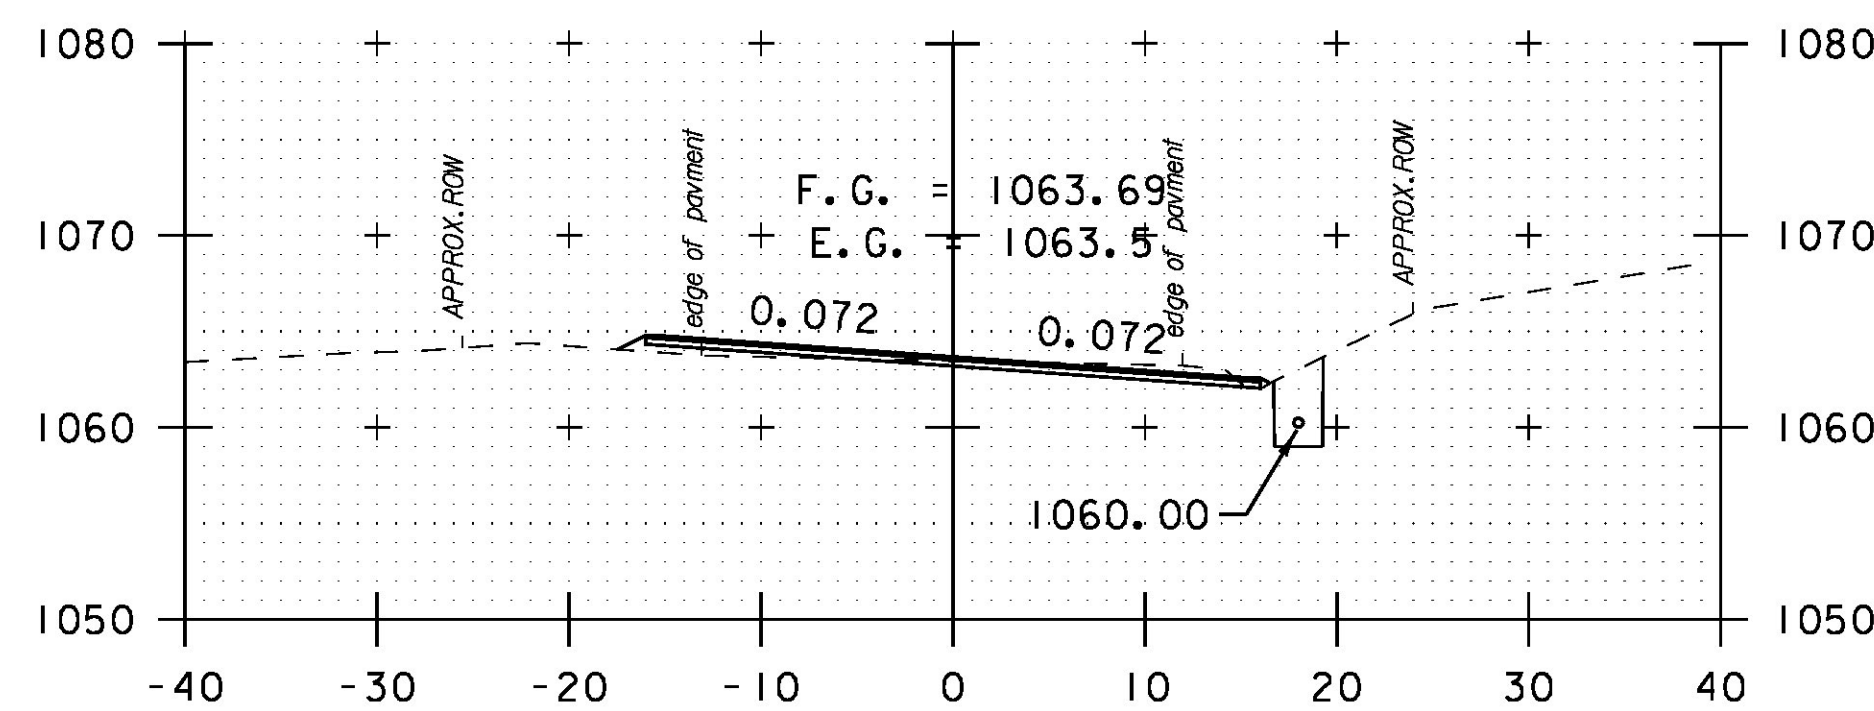


260+50

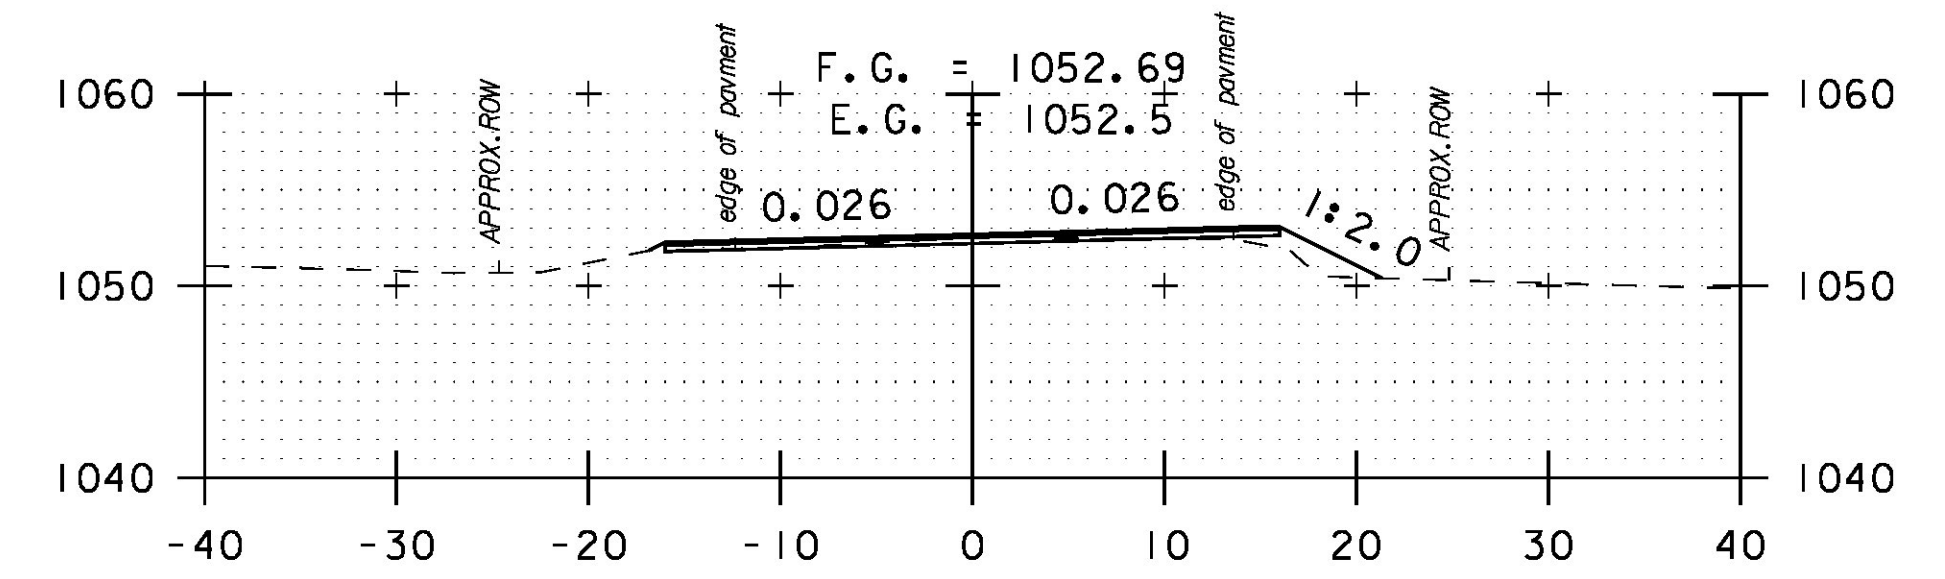


264+00

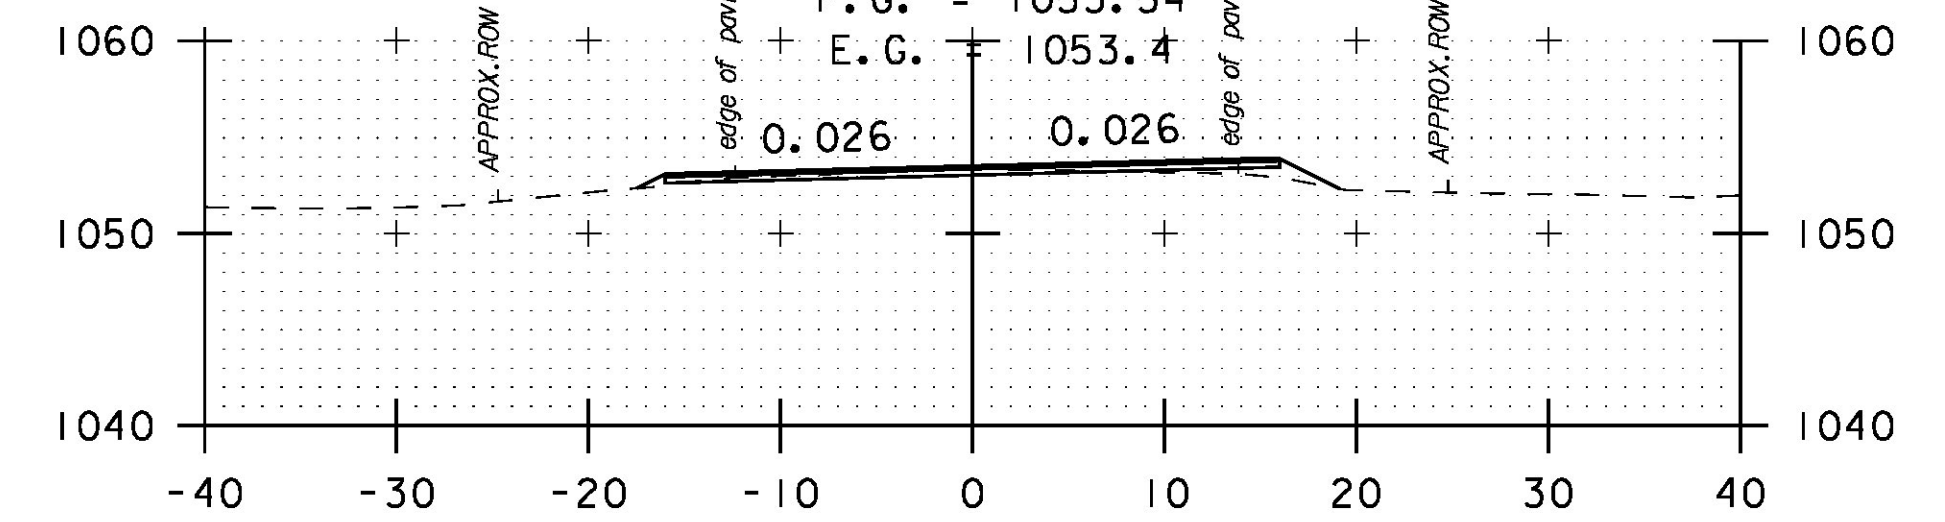

263+50
DRIVE LT

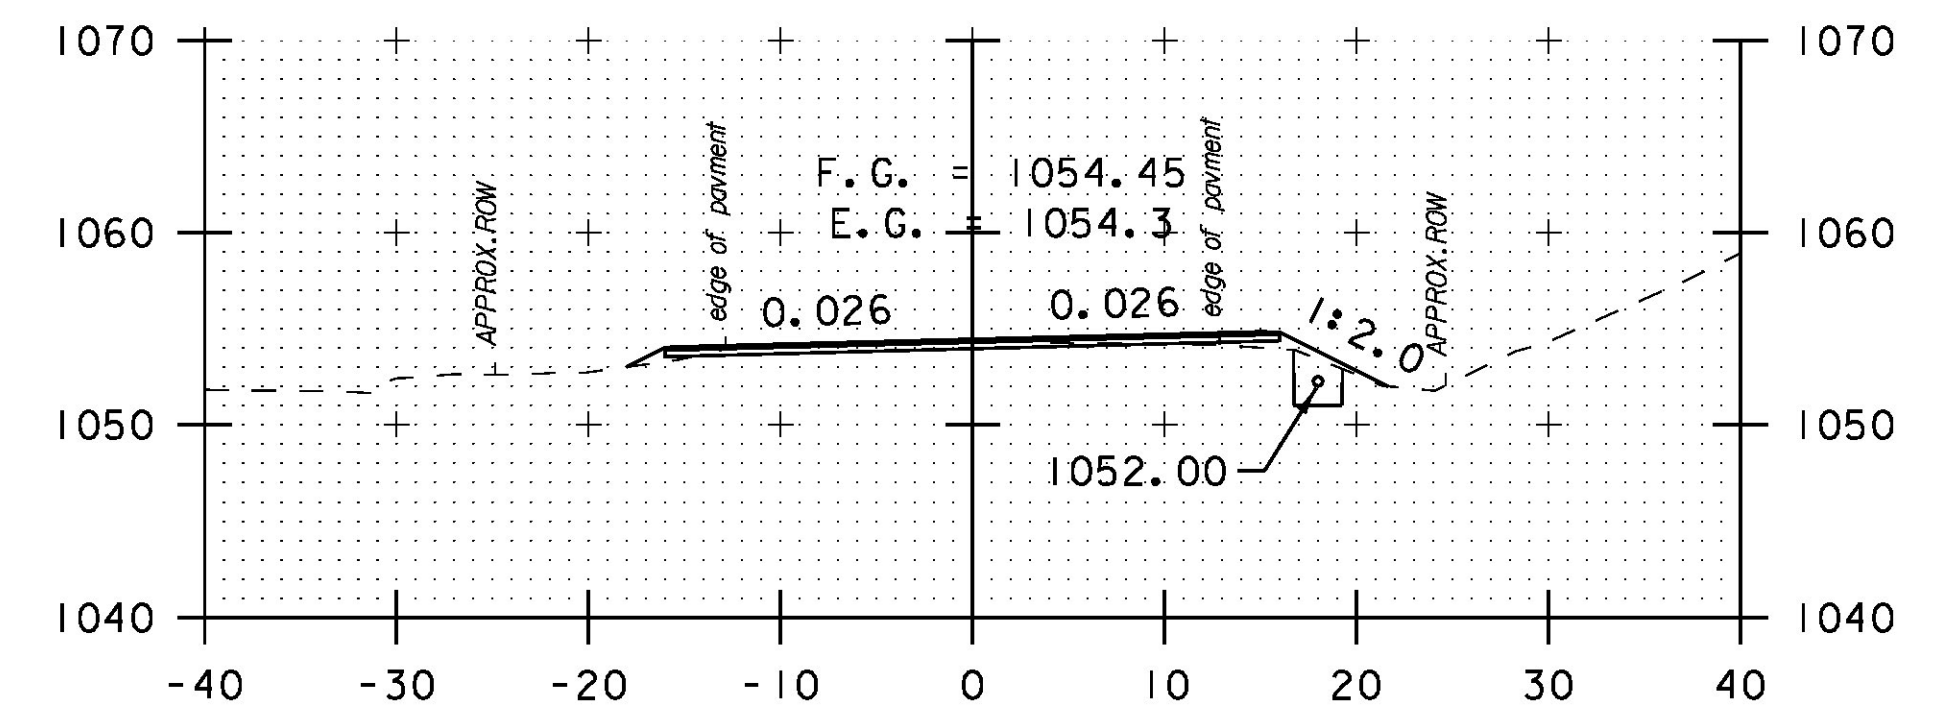

263+00

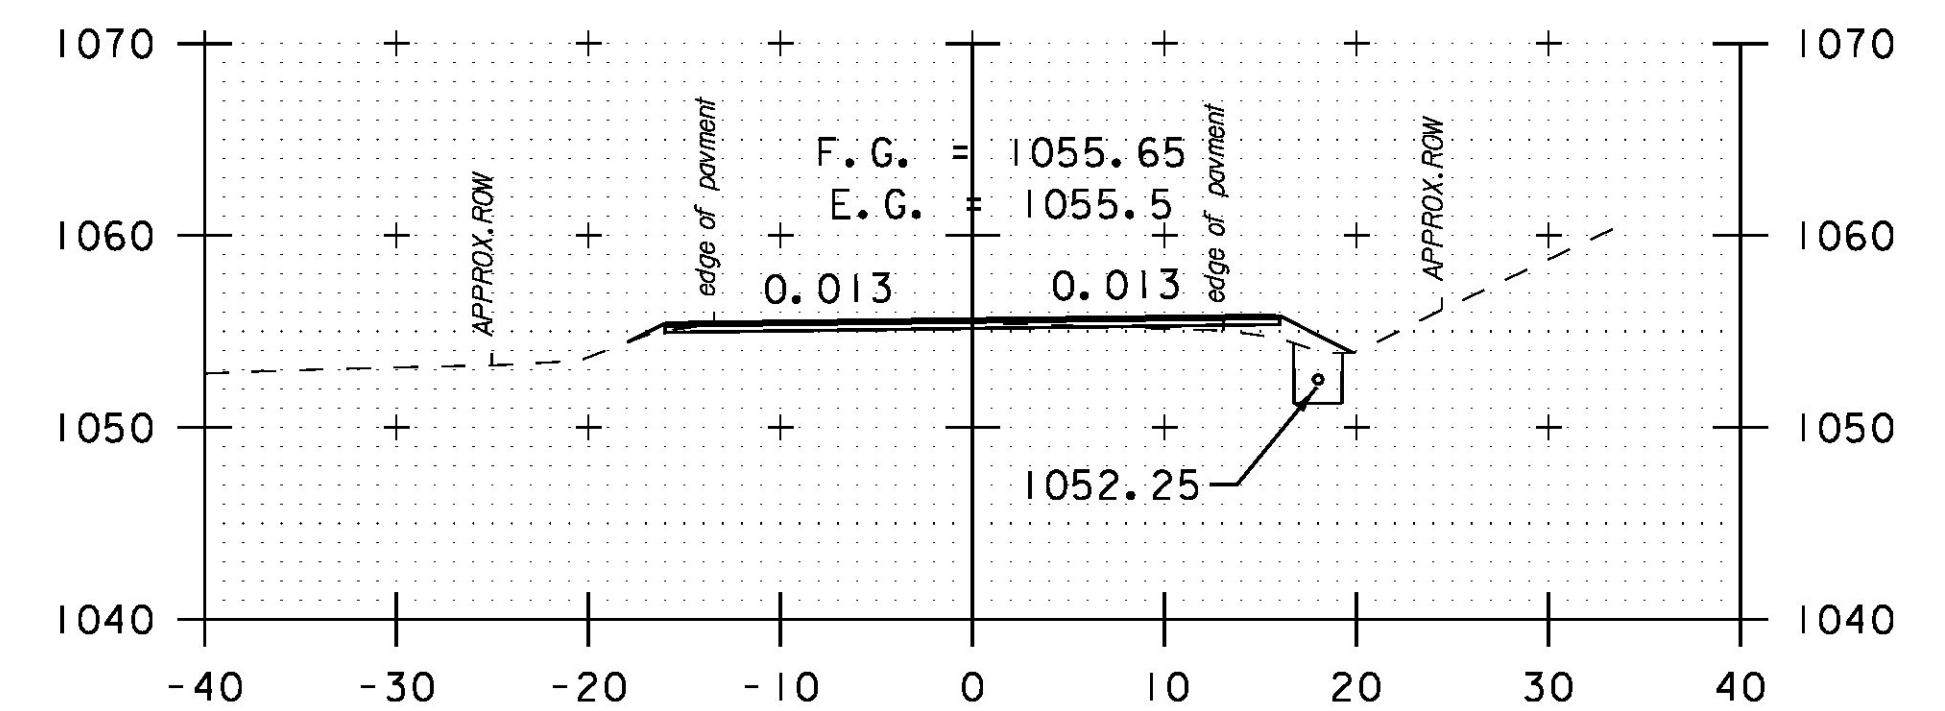

262+50



SCALE IN FEET

PROJECT NAME: HANCOCK
PROJECT NUMBER: STP 2923 (1)

FILE NAME: z10c252xs.dgn
PROJECT LEADER: C. LATHROP
DESIGNED BY: B. MARTIN
CROSS SECTION SHEET 49

PLOT DATE: 3/18/2015
DRAWN BY: B. MARTIN
CHECKED BY: C. LATHROP
SHEET 176 OF 207