




266+00  
DRIVE RT

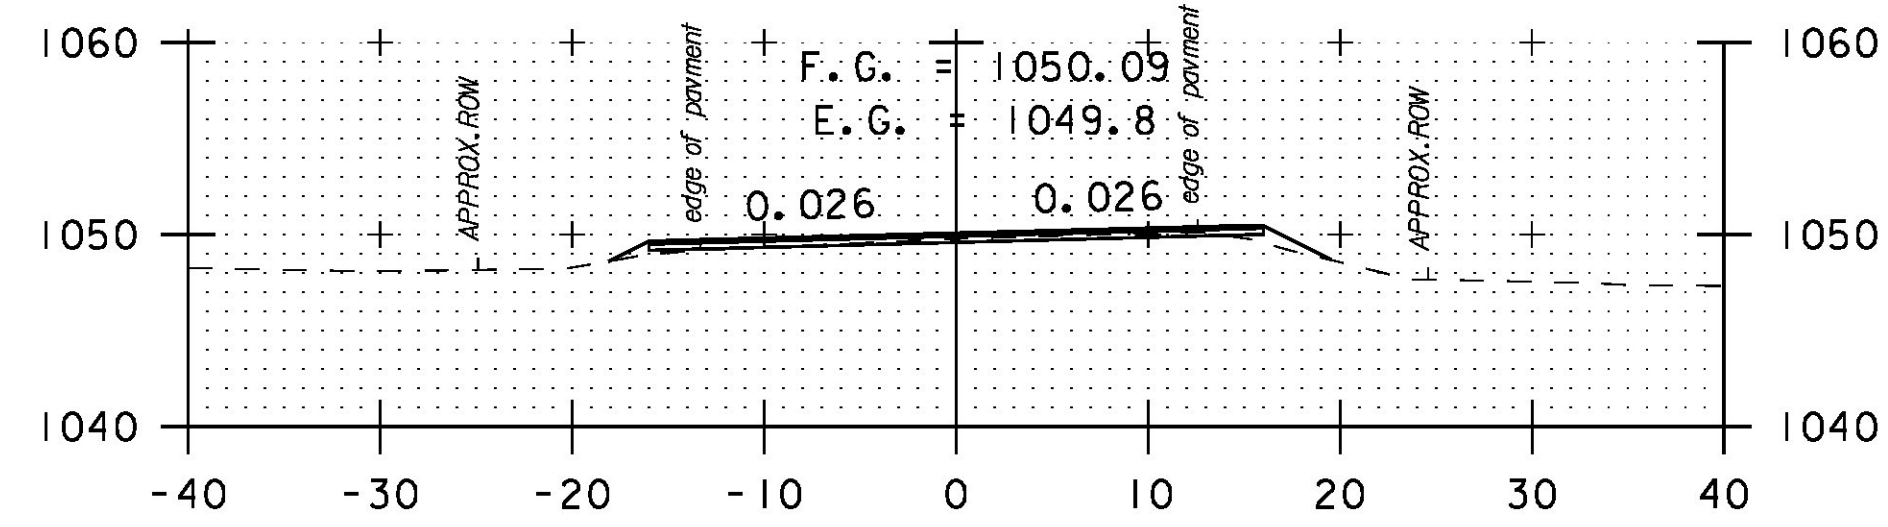


265+50

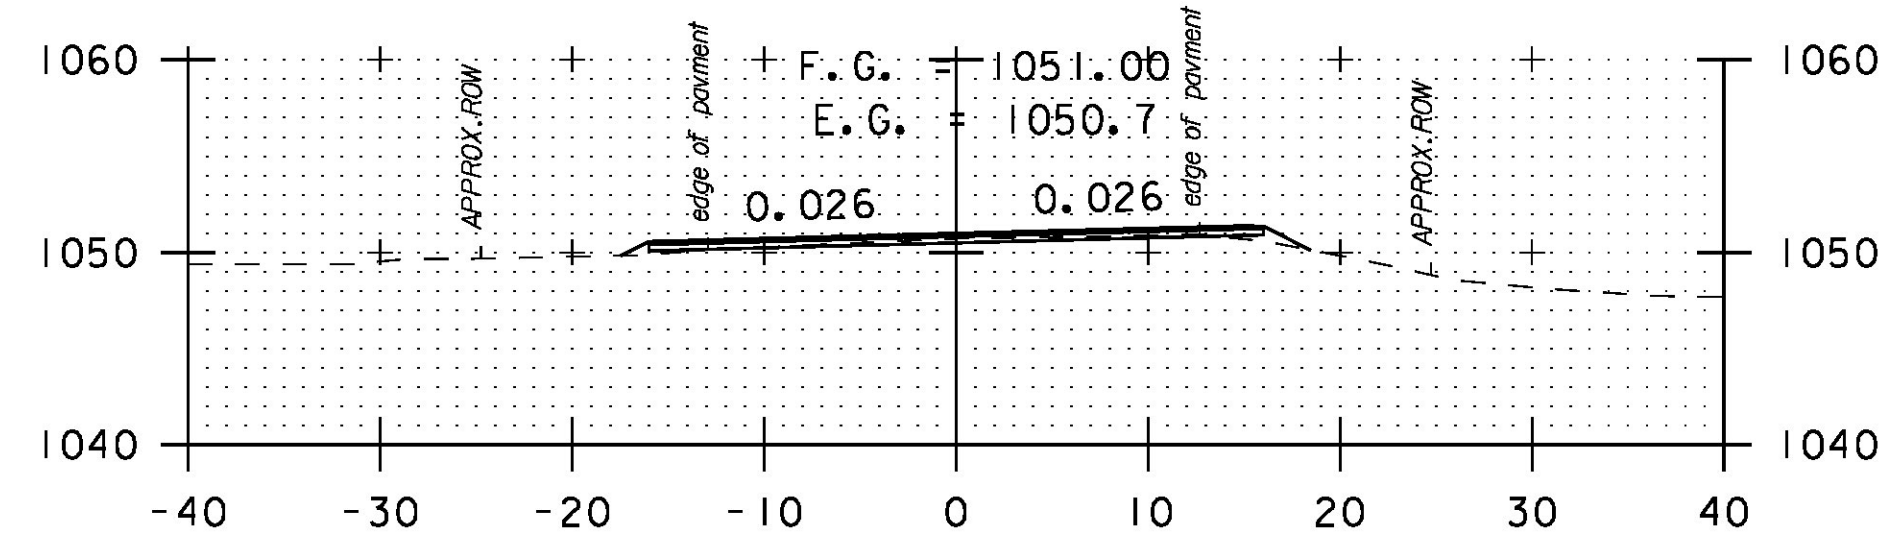


265+00

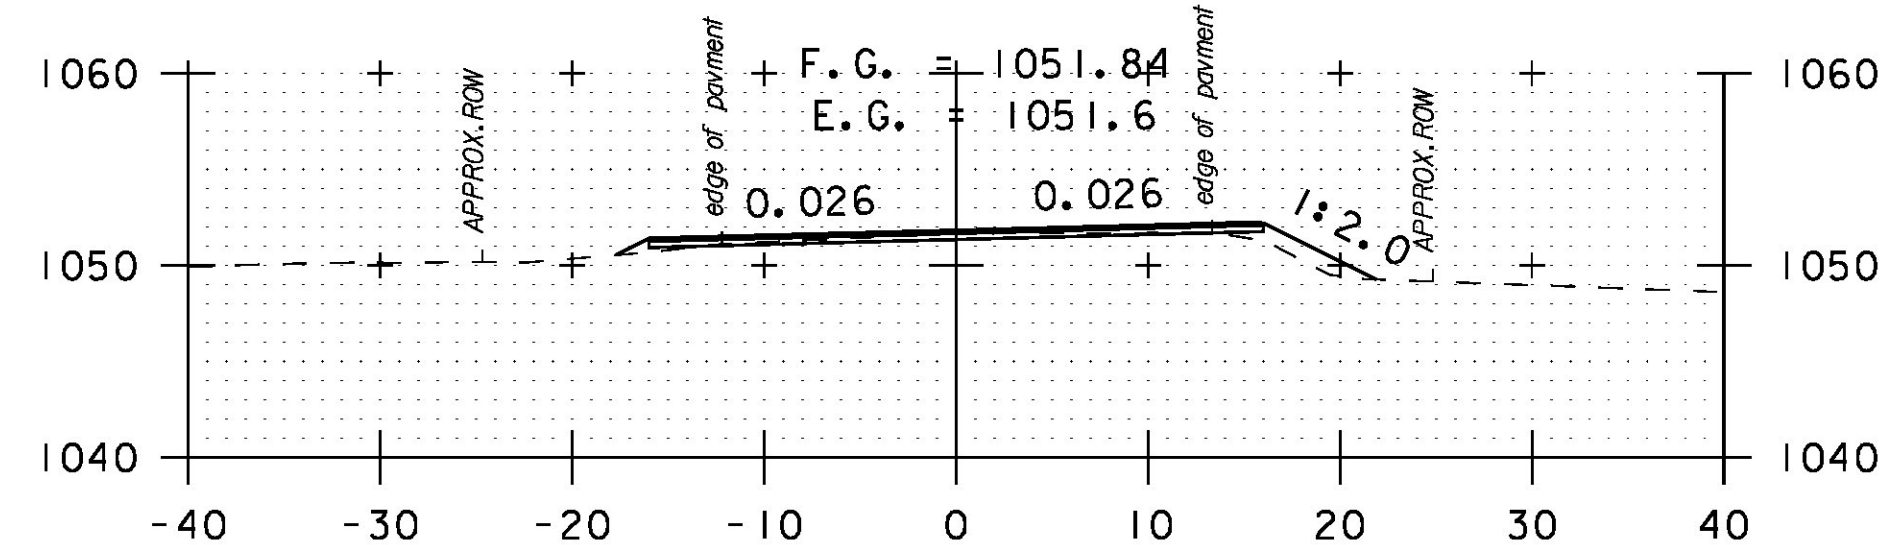


264+50

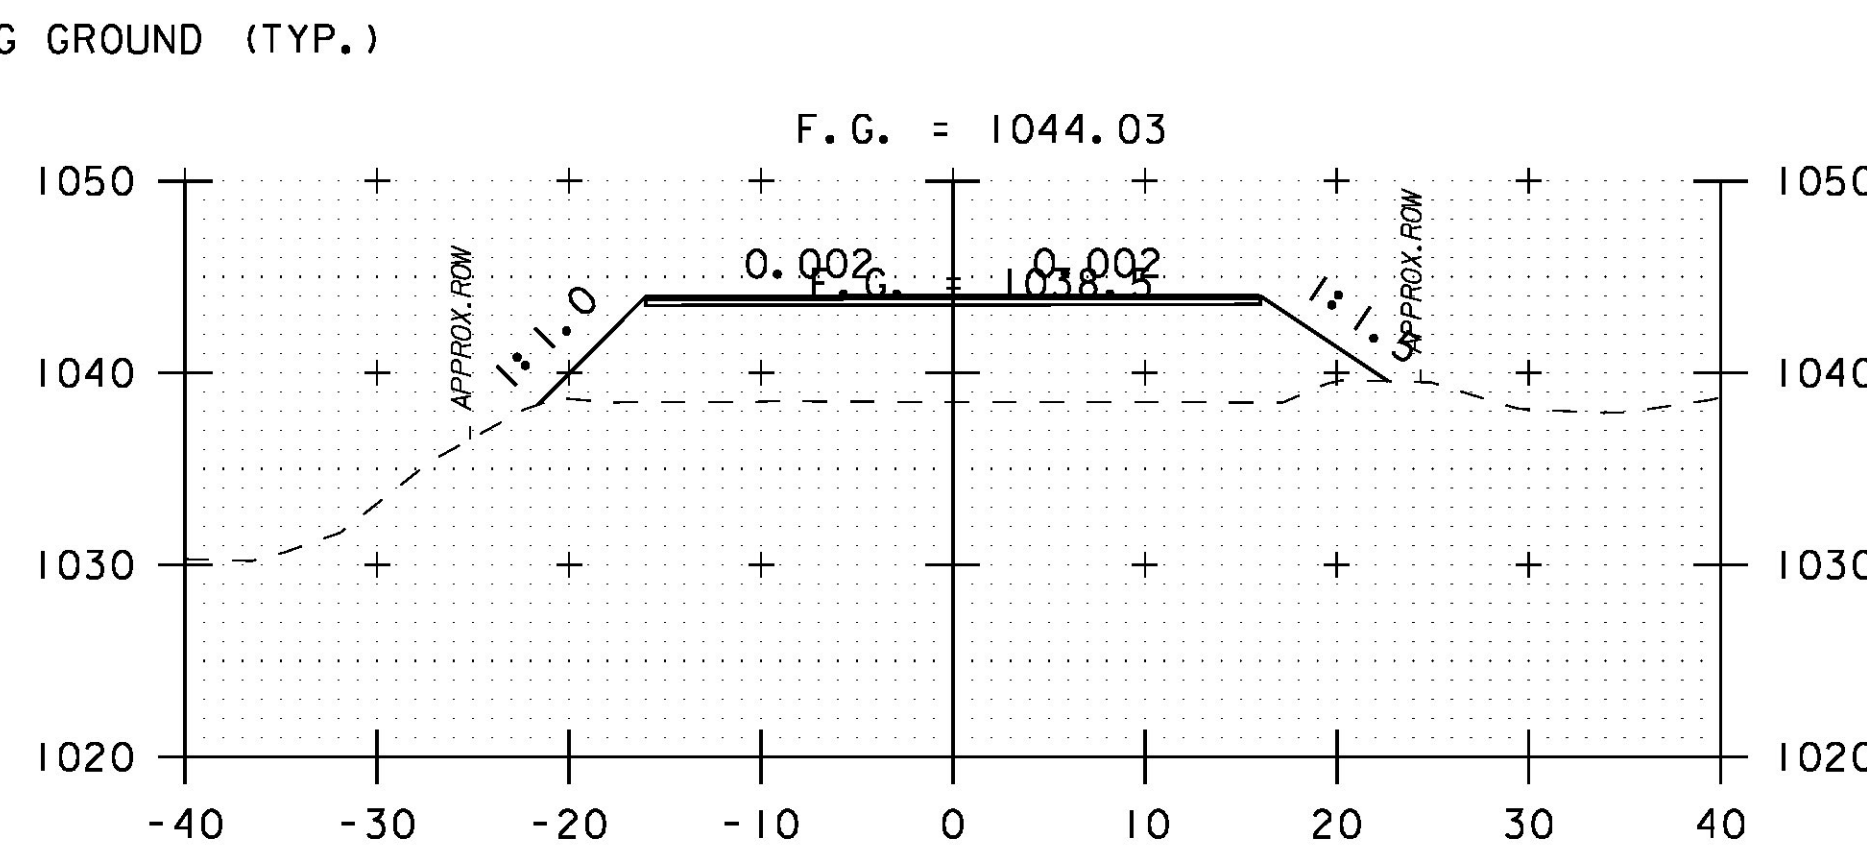


268+00  
BRIDGE #23

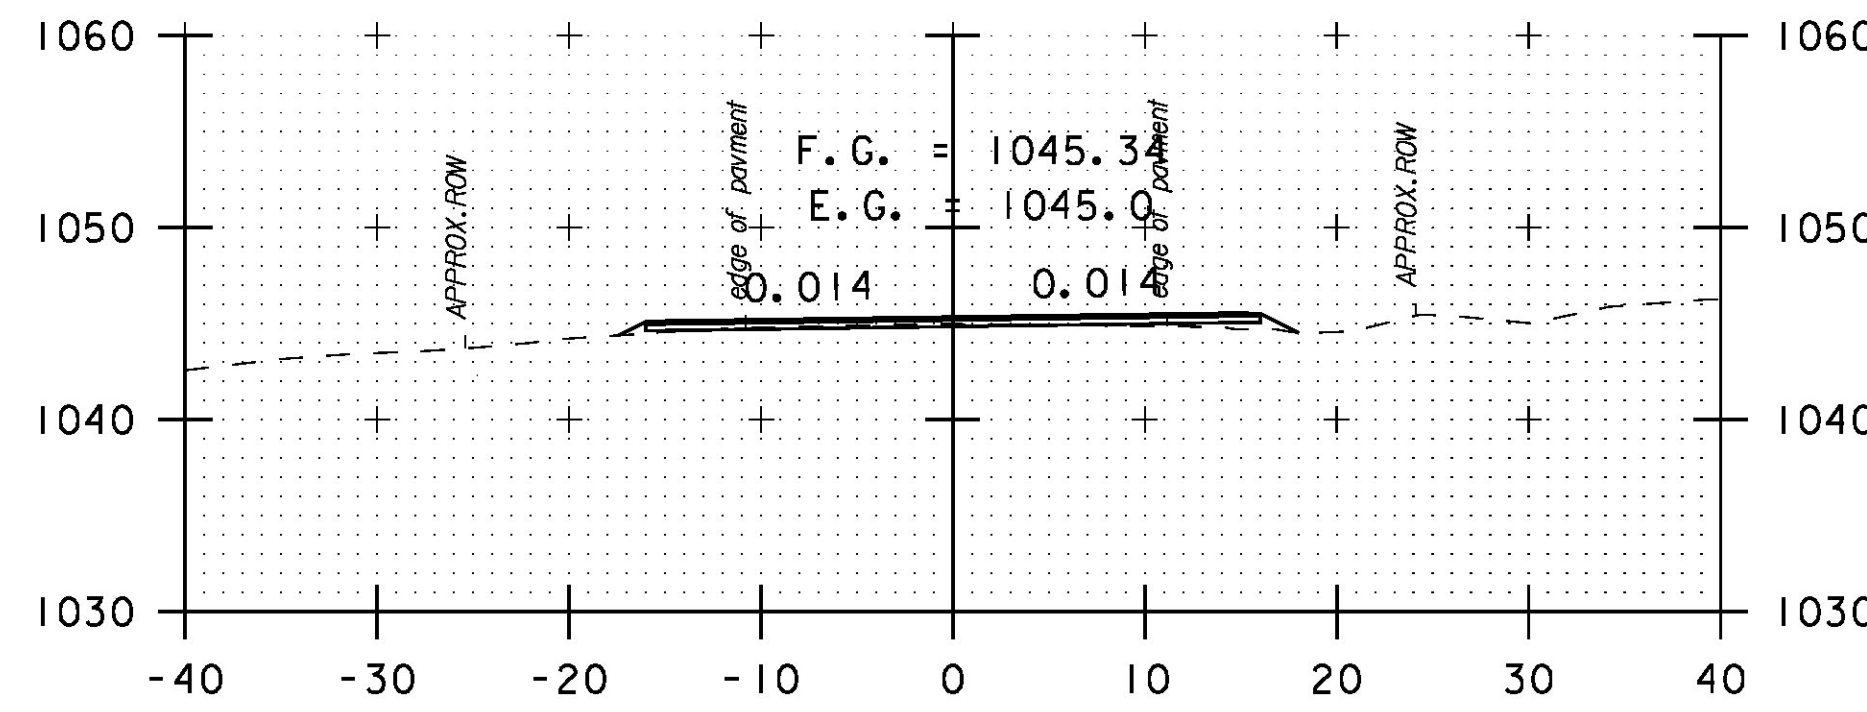


267+50

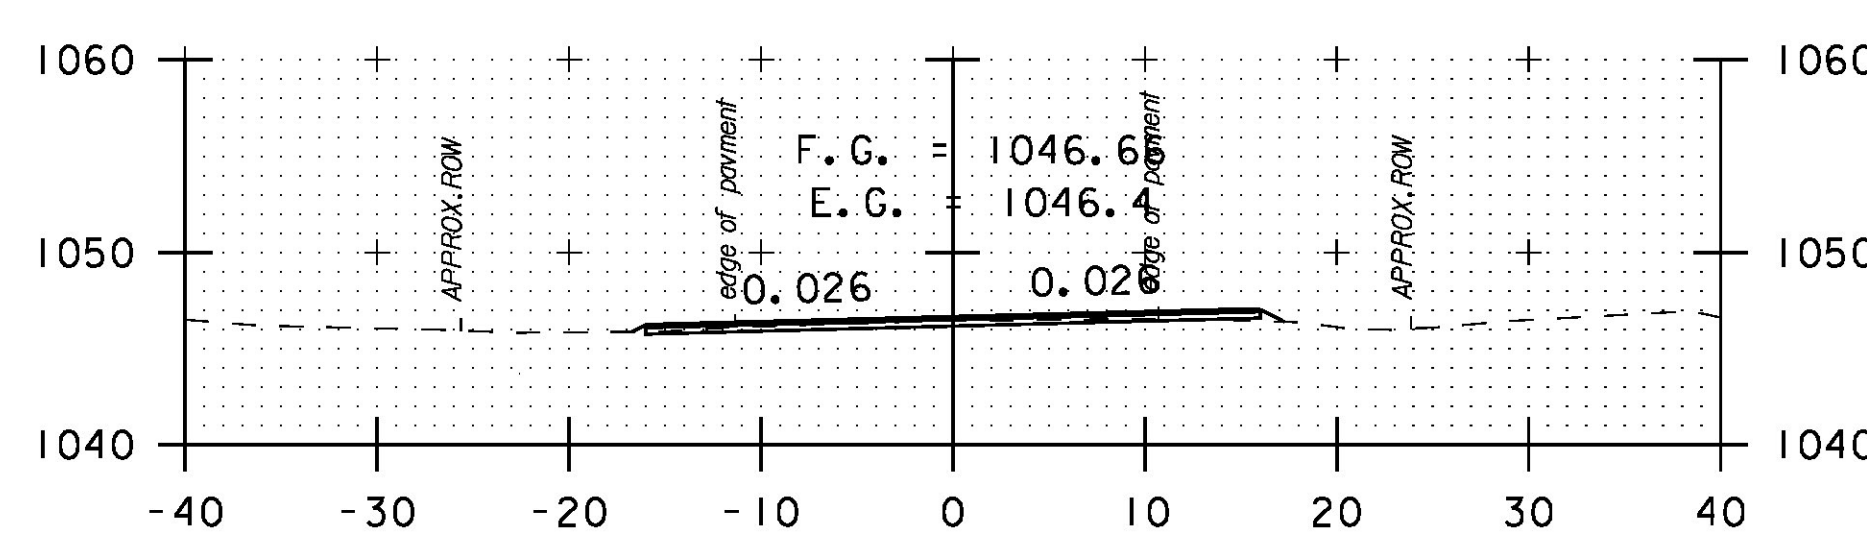


267+00  
DRIVE LT

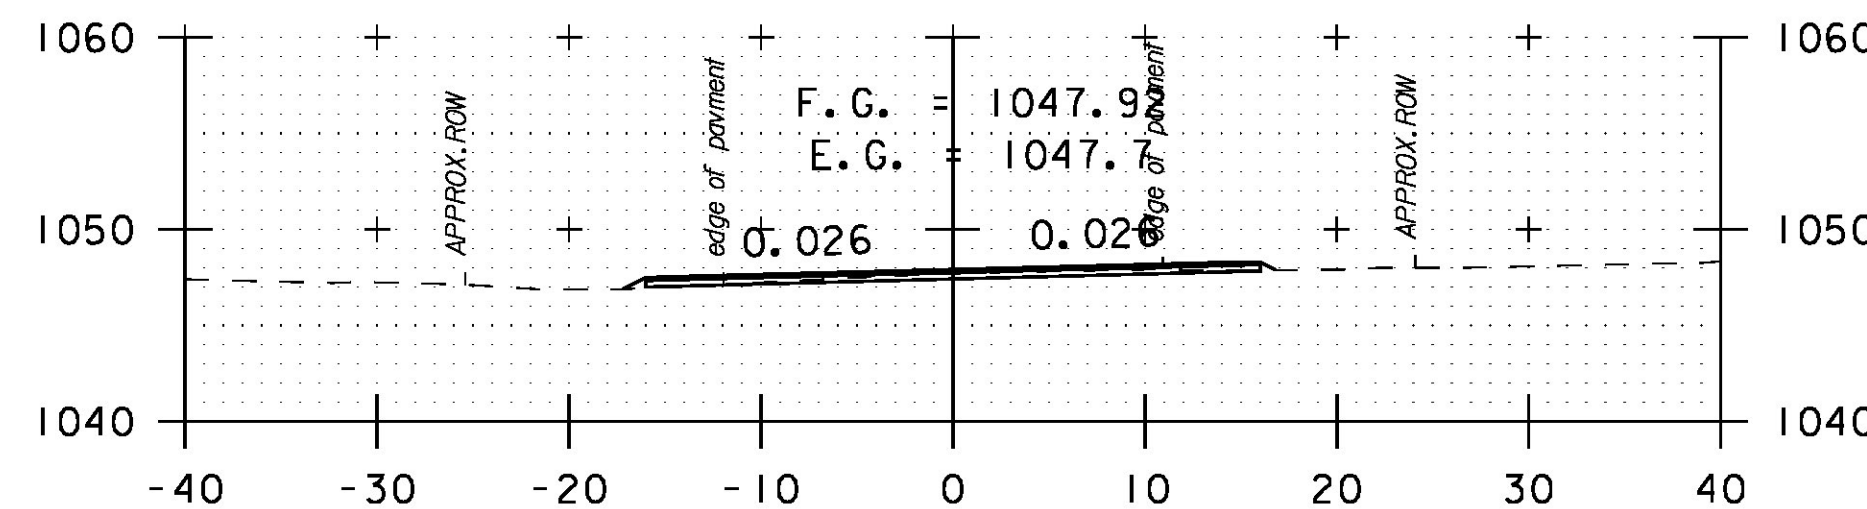


266+50

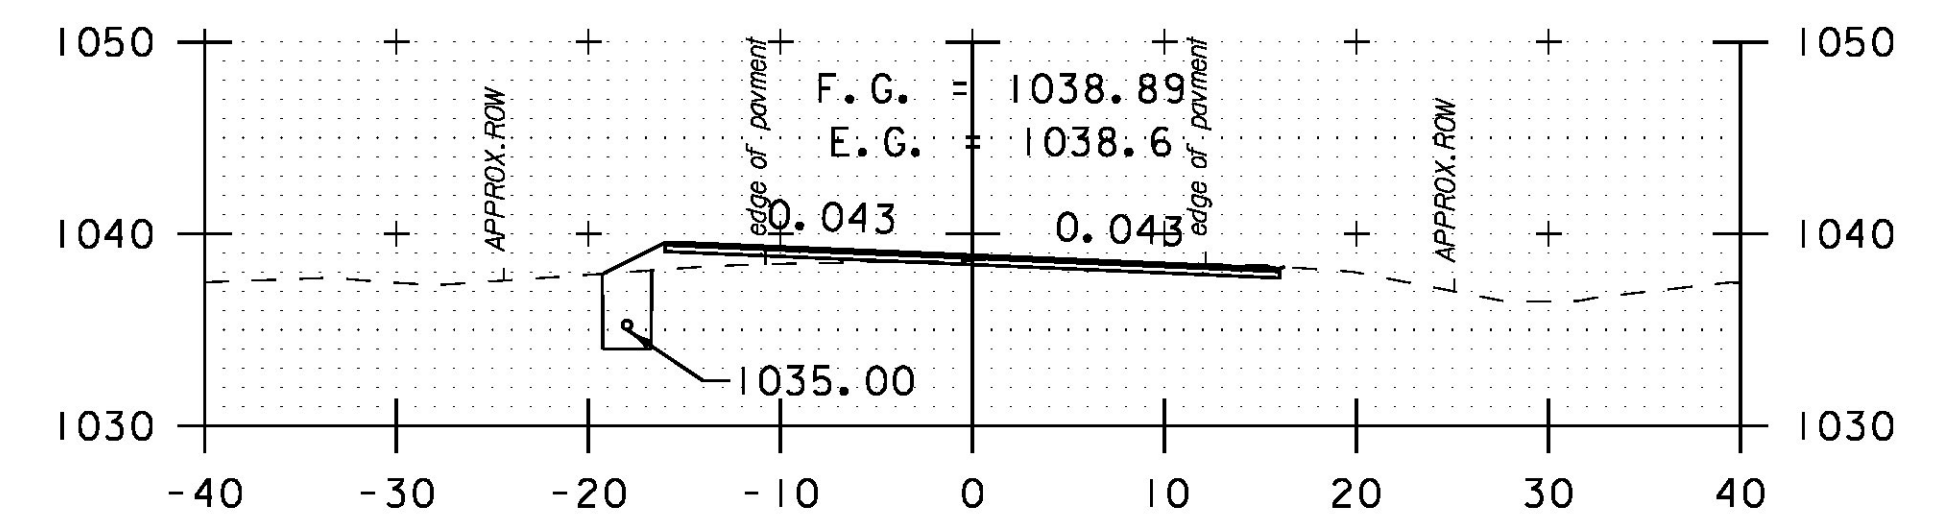


270+00

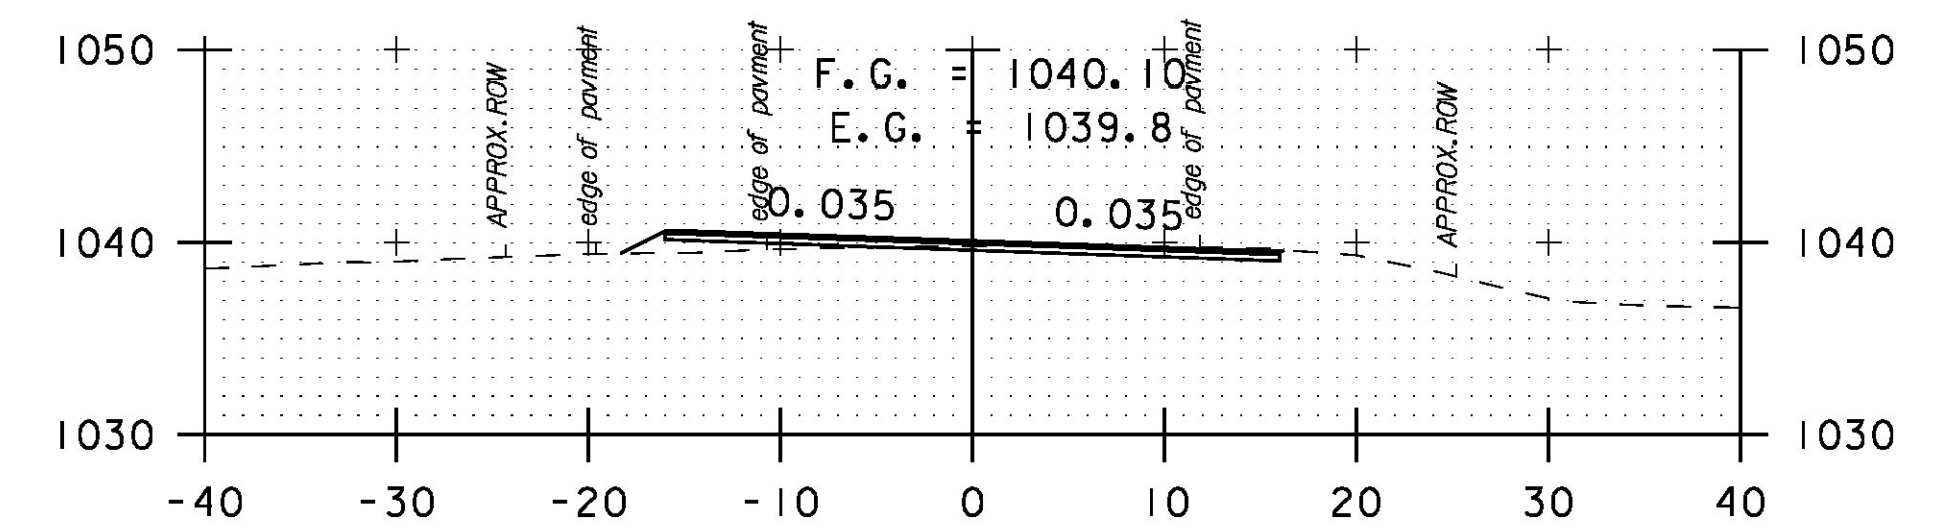


269+50  
TH #3 LT

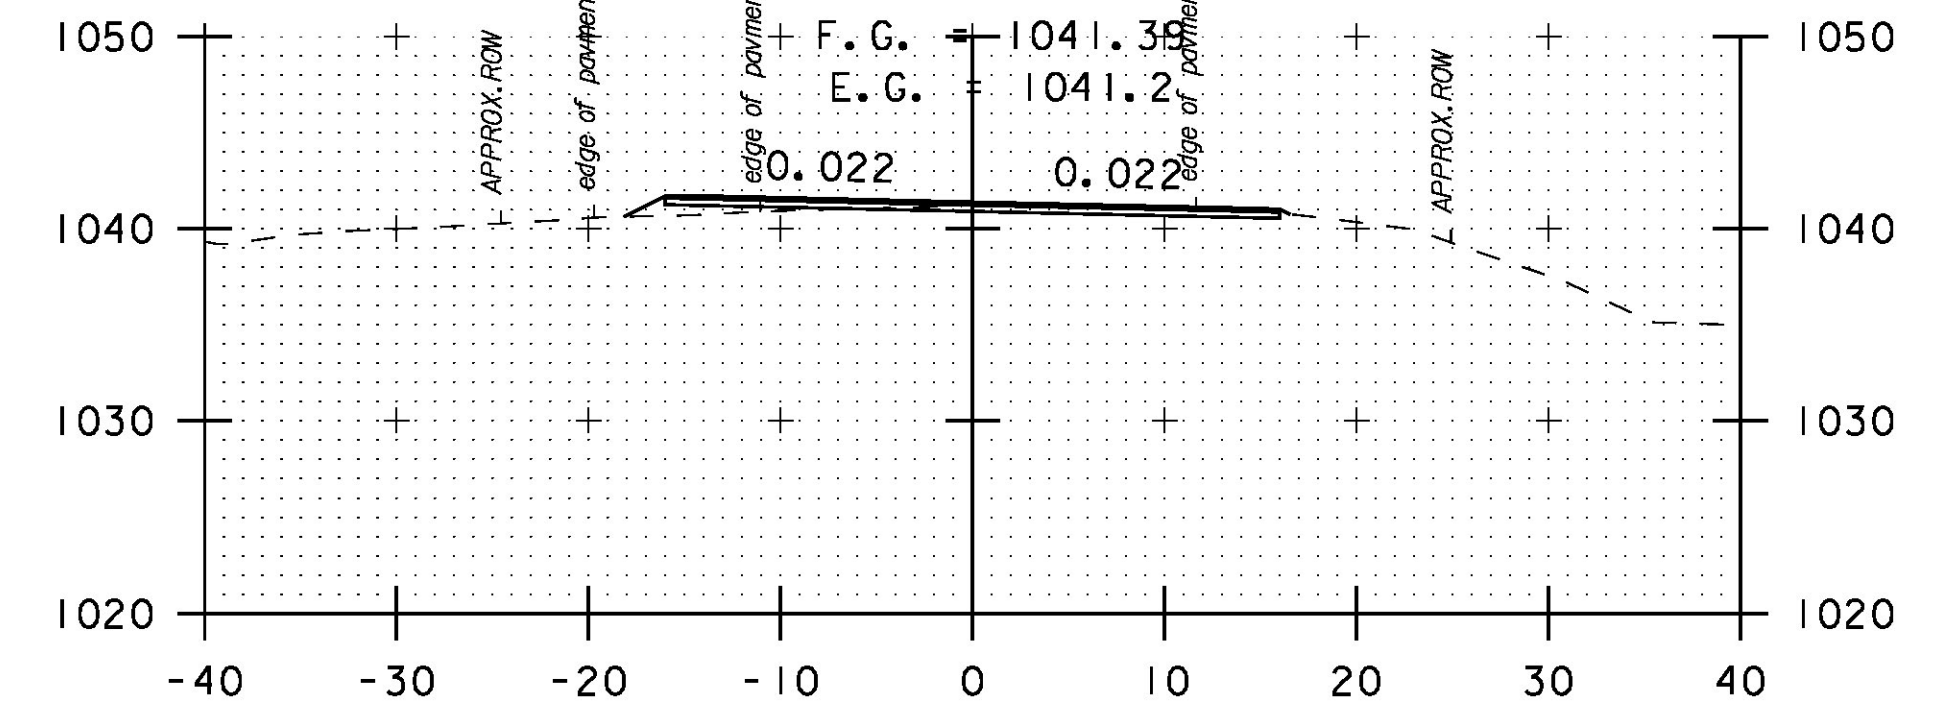

269+00  
TH #3 LT

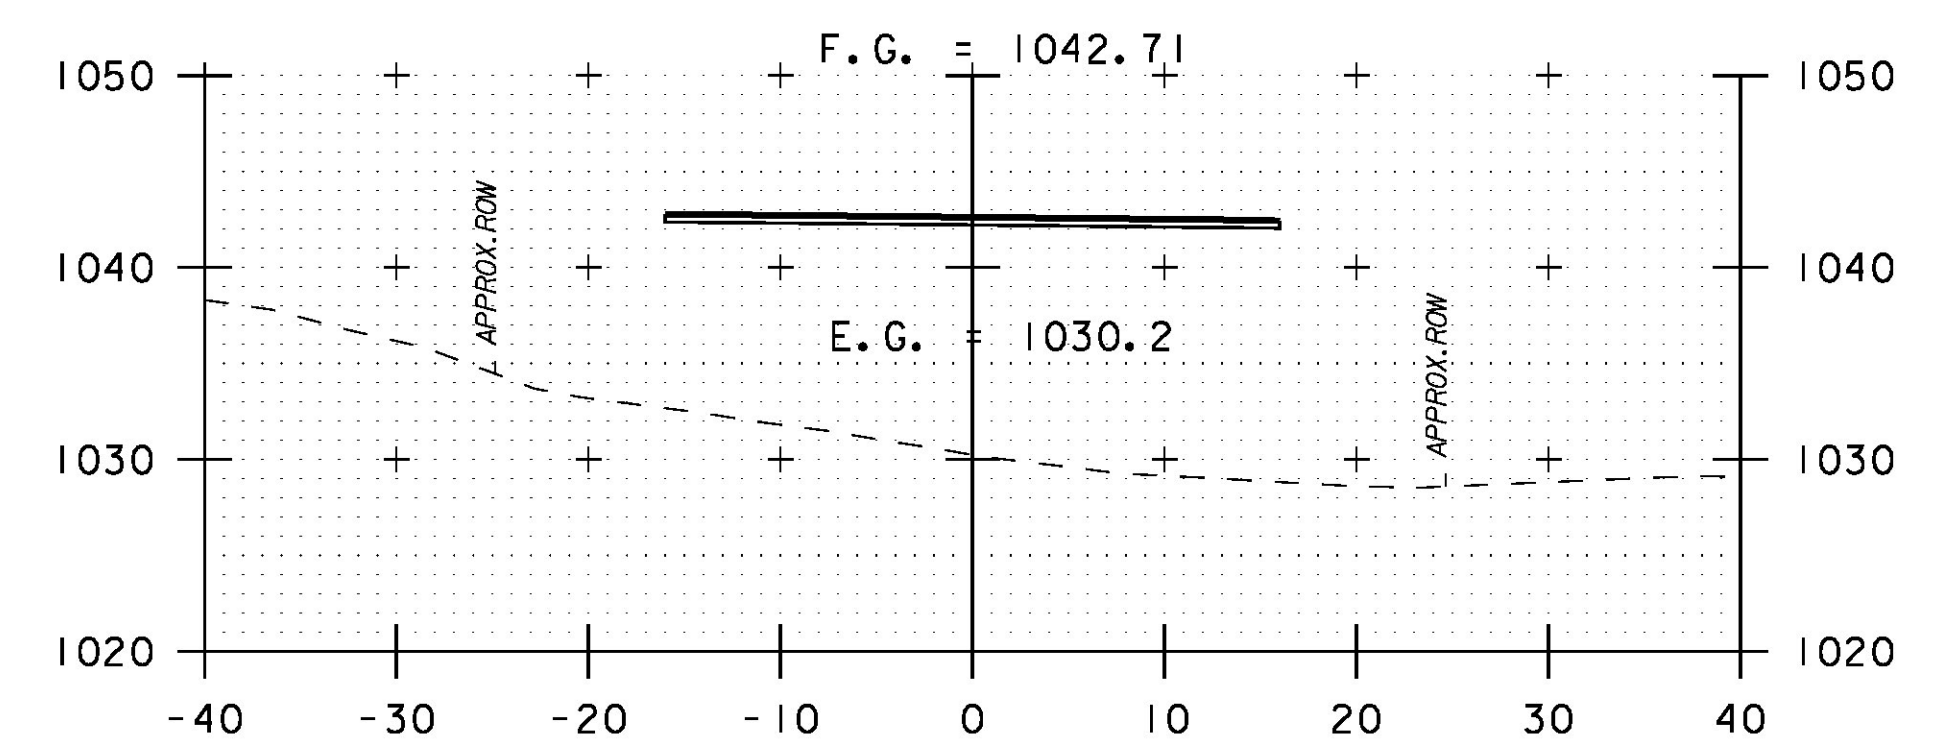

268+50  
BRIDGE #23

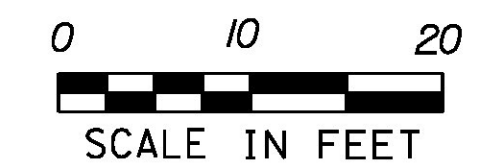

PROJECT NAME: HANCOCK	PLOT DATE: 3/18/2015
PROJECT NUMBER: STP 2923 (1)	DRAWN BY: B. MARTIN
FILE NAME: z10c252xs.dgn	CHECKED BY: C. LATHROP
PROJECT LEADER: C. LATHROP	SHEET 177 OF 207
DESIGNED BY: B. MARTIN	
CROSS SECTION SHEET 50	