




272+00
DRIVE LT

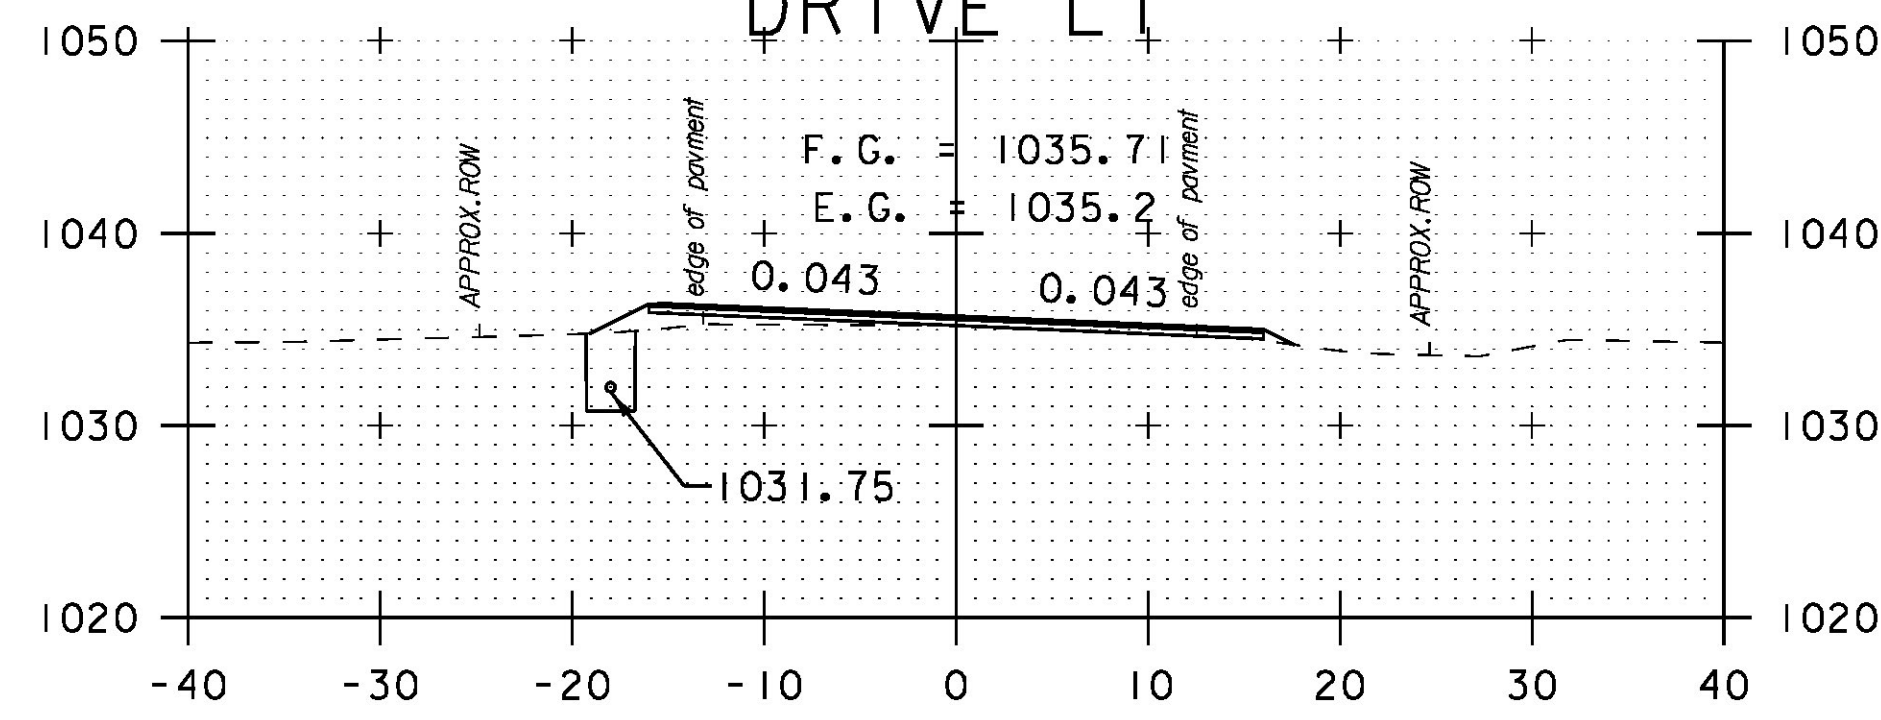


271+50

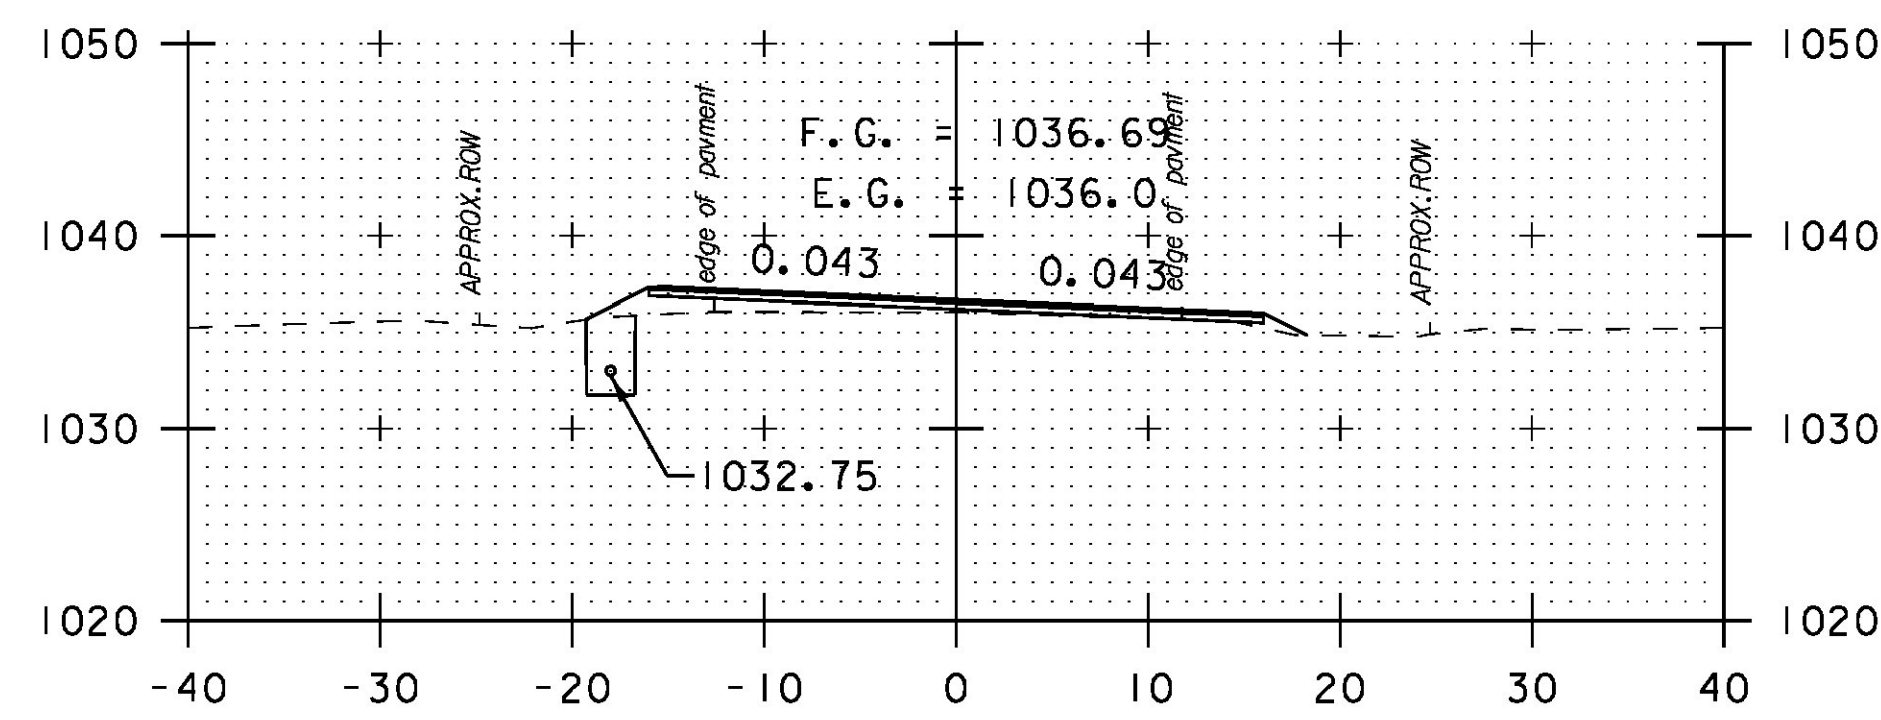


271+00
DRIVE LT

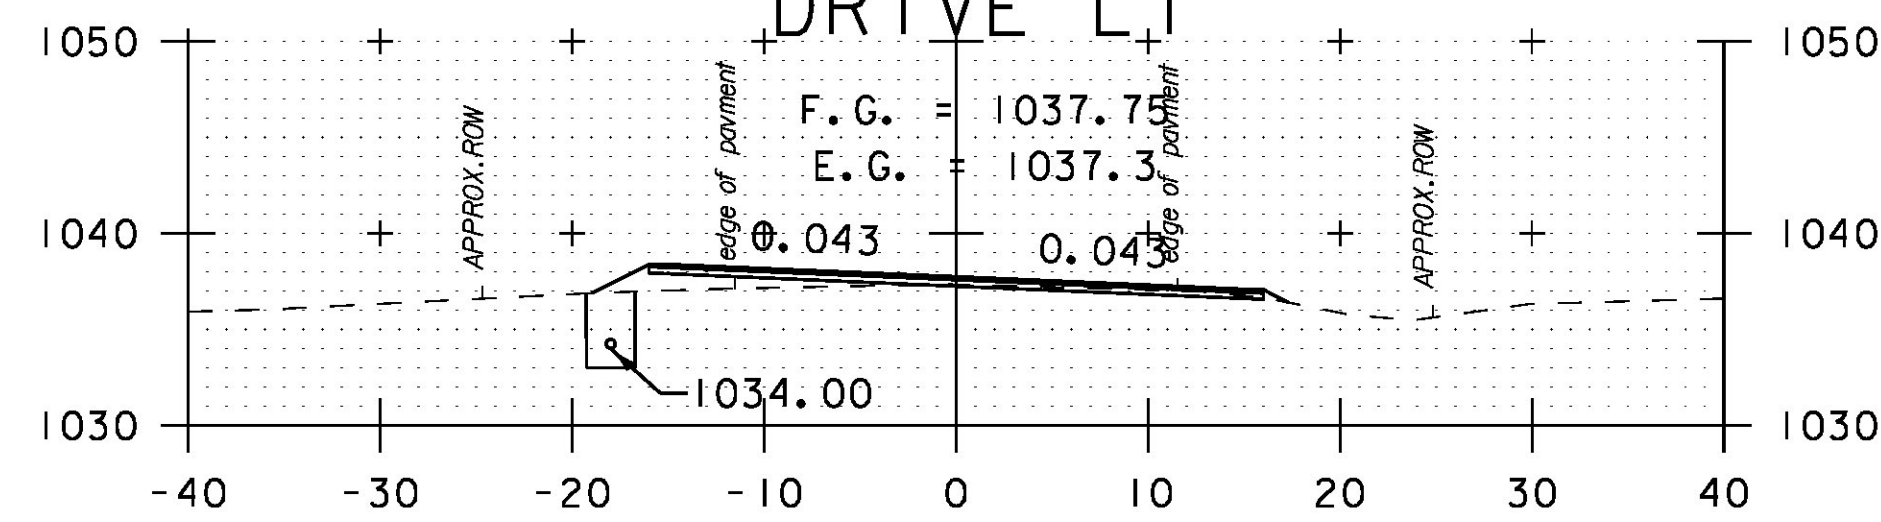


270+50
DRIVE LT

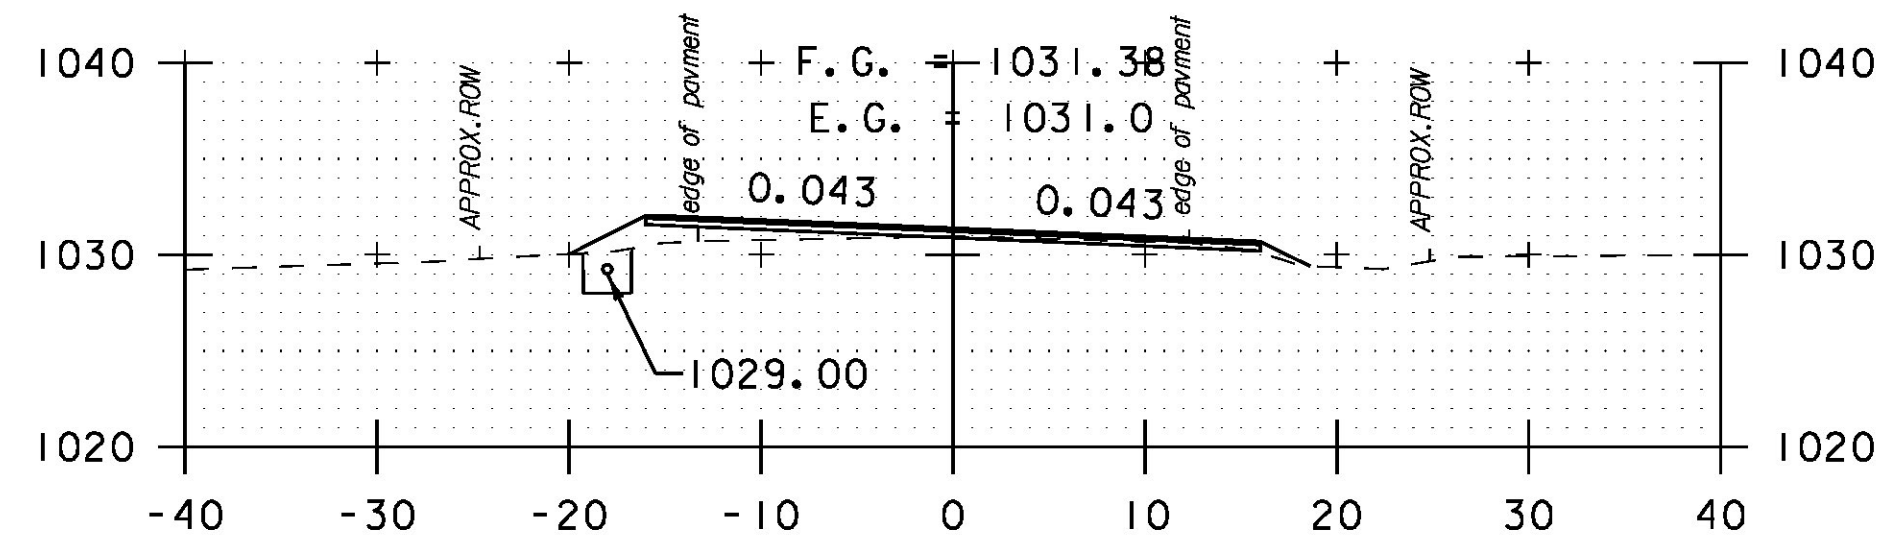


274+00

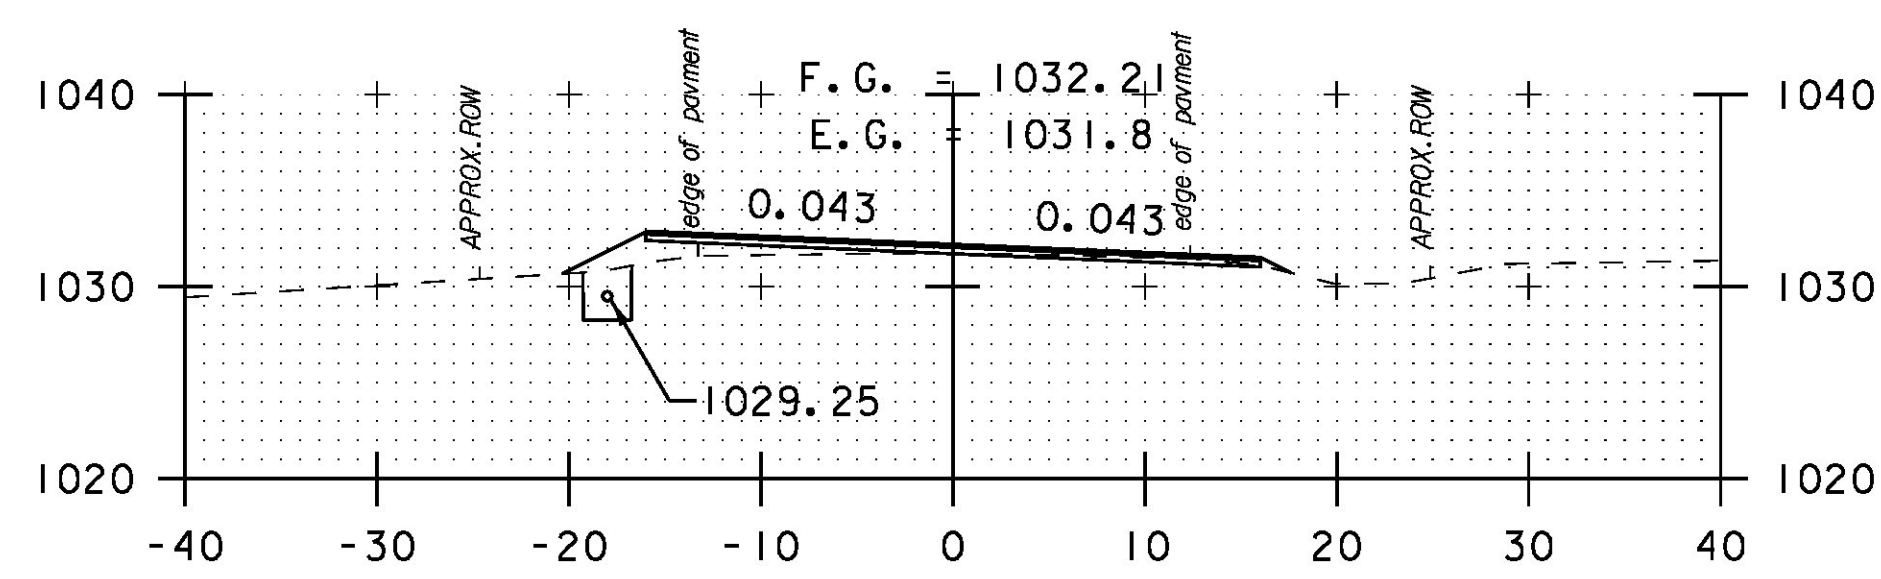


273+50

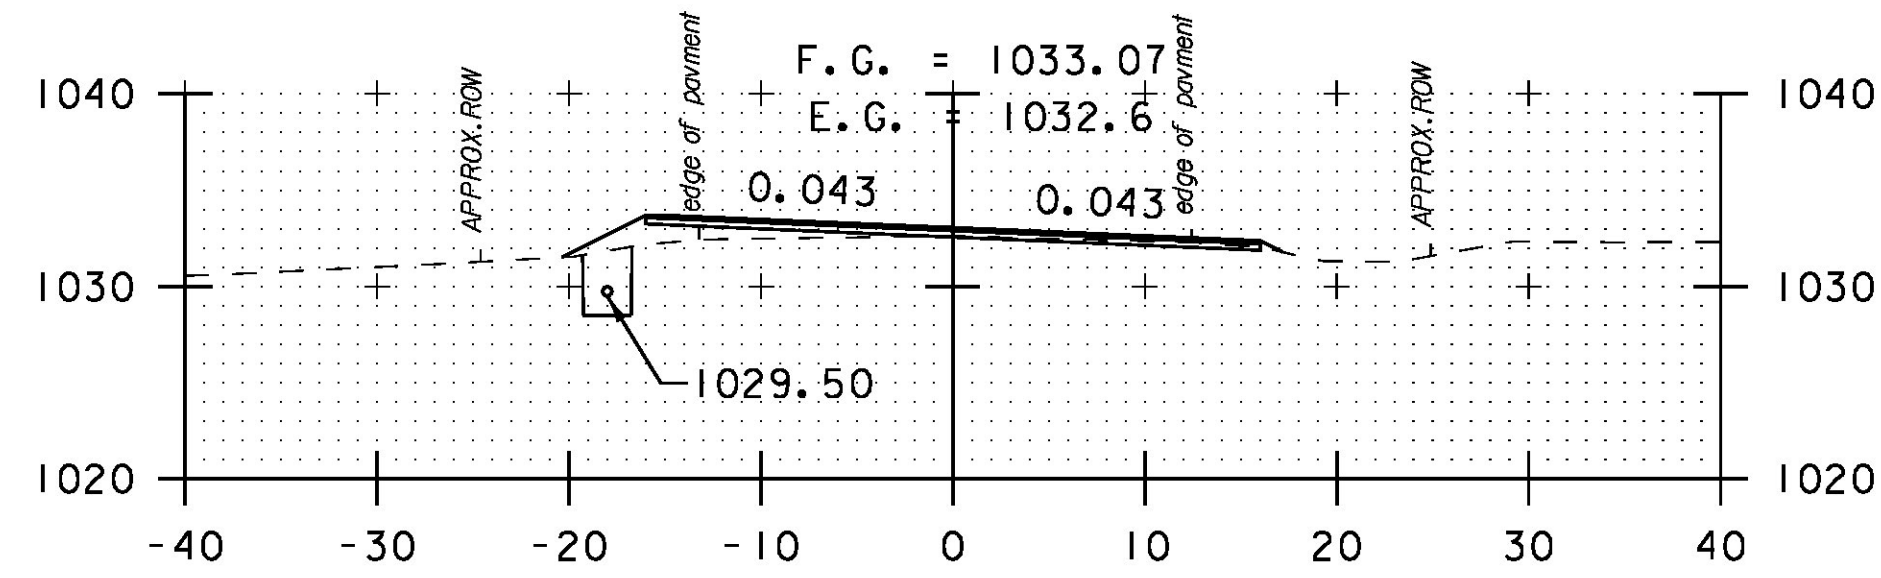


273+00

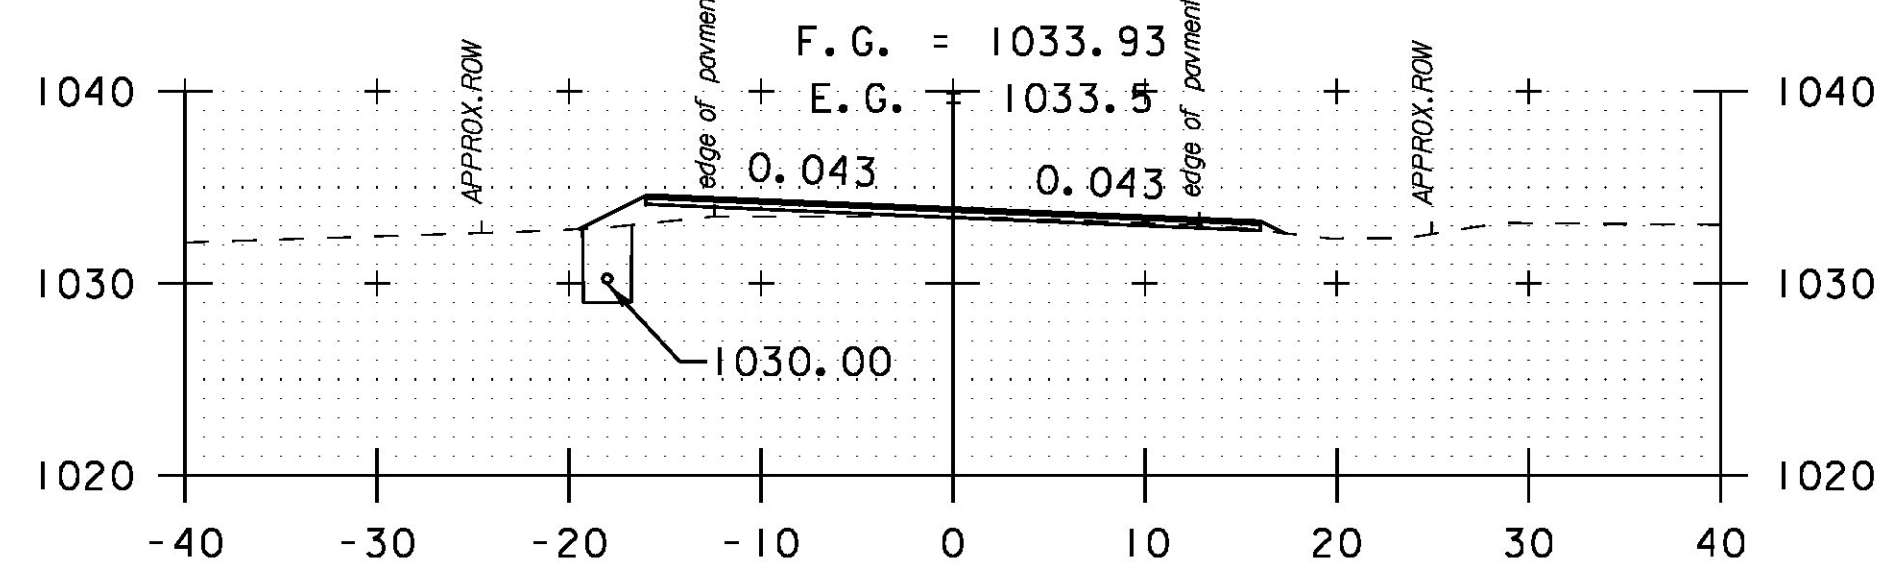


272+50

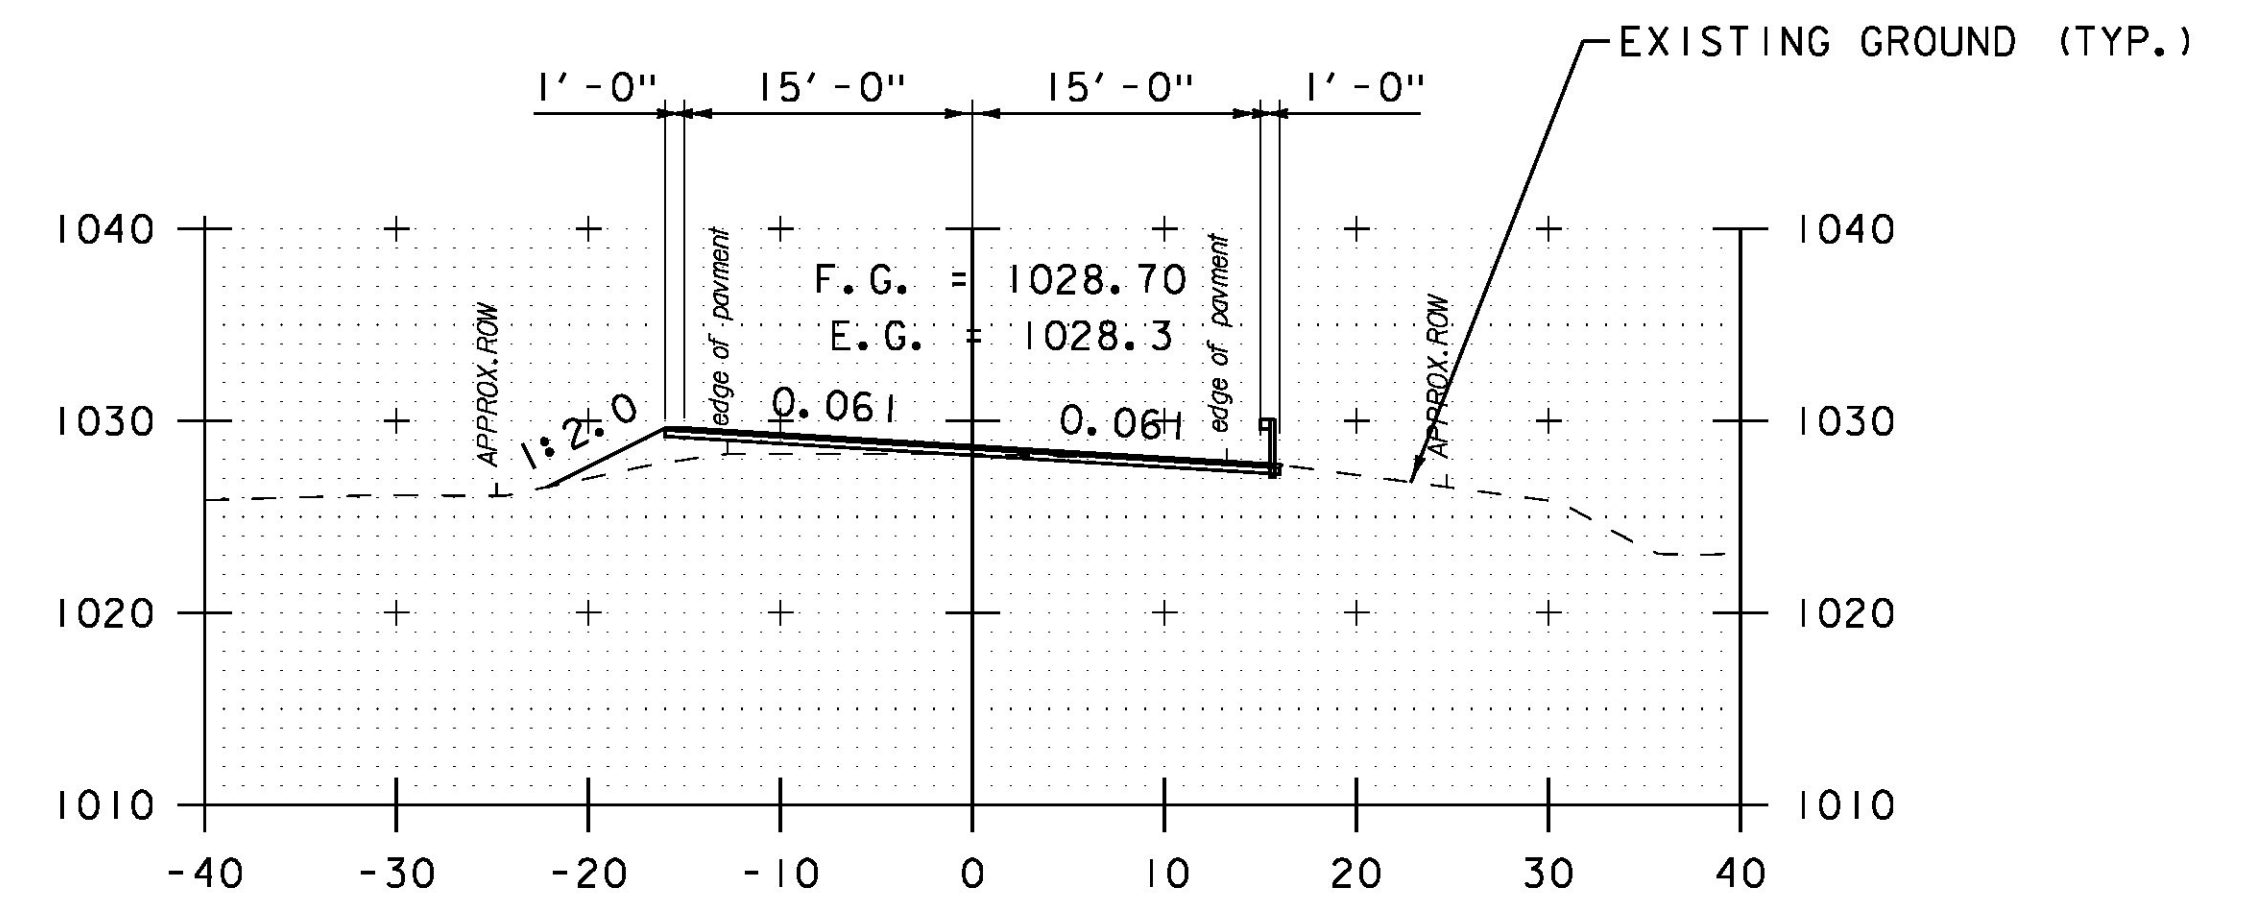


276+00

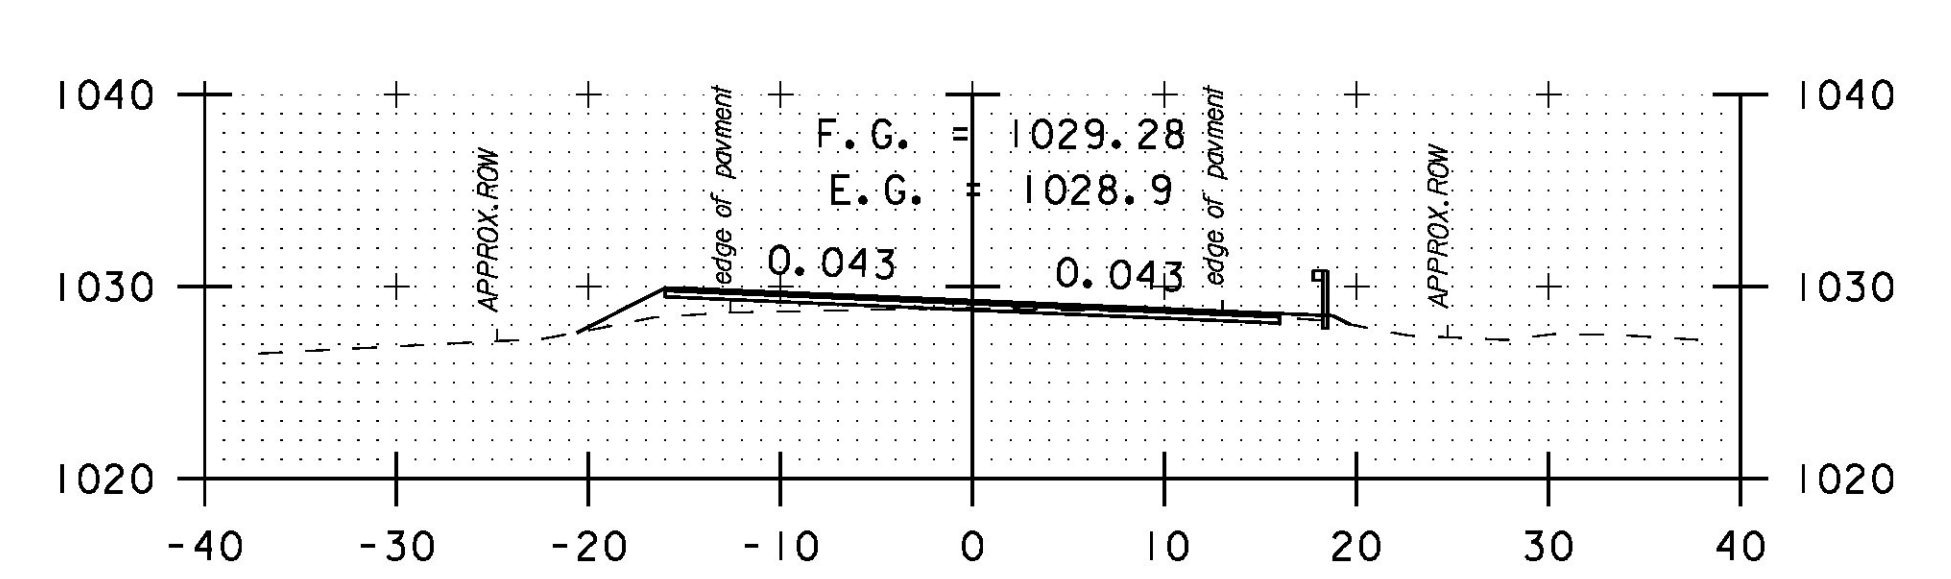

275+50

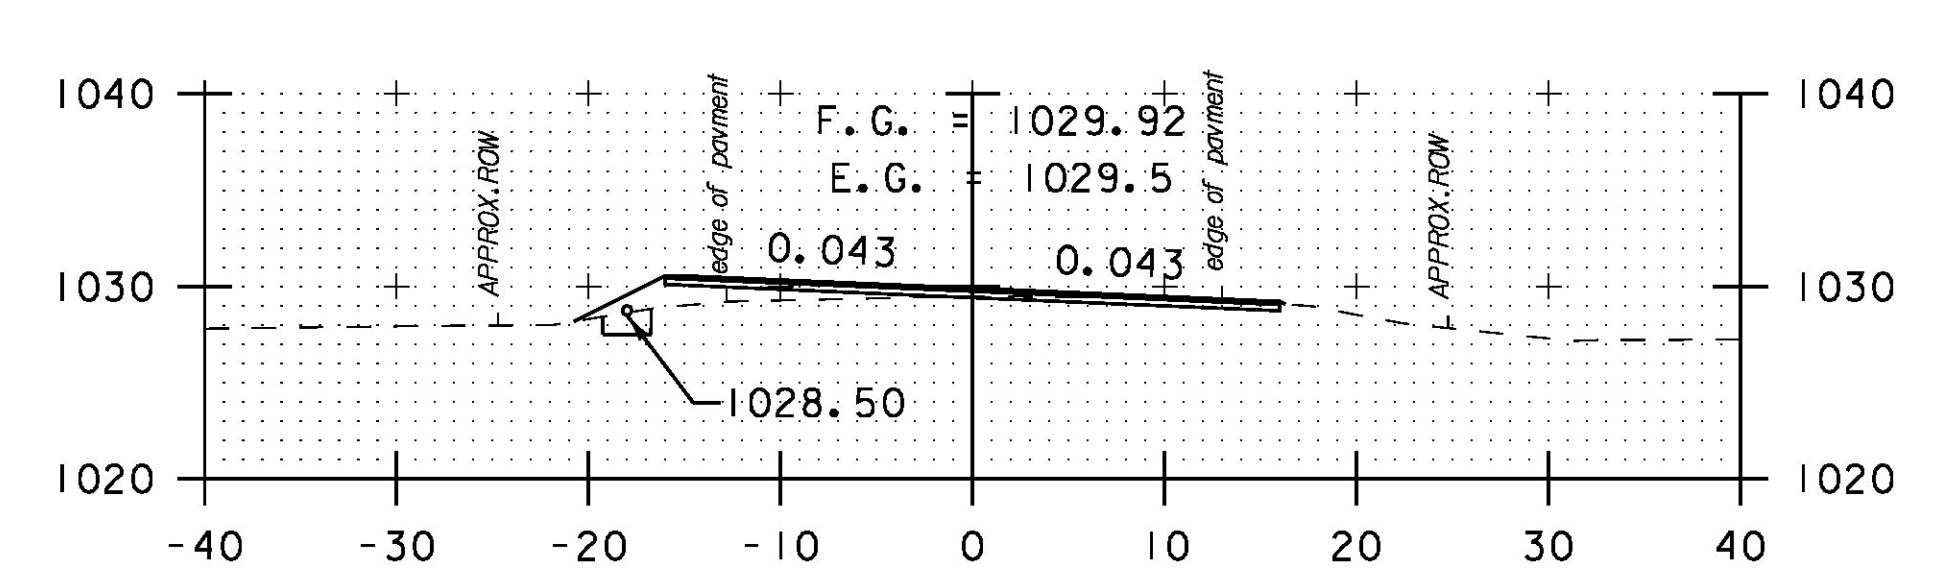

275+00

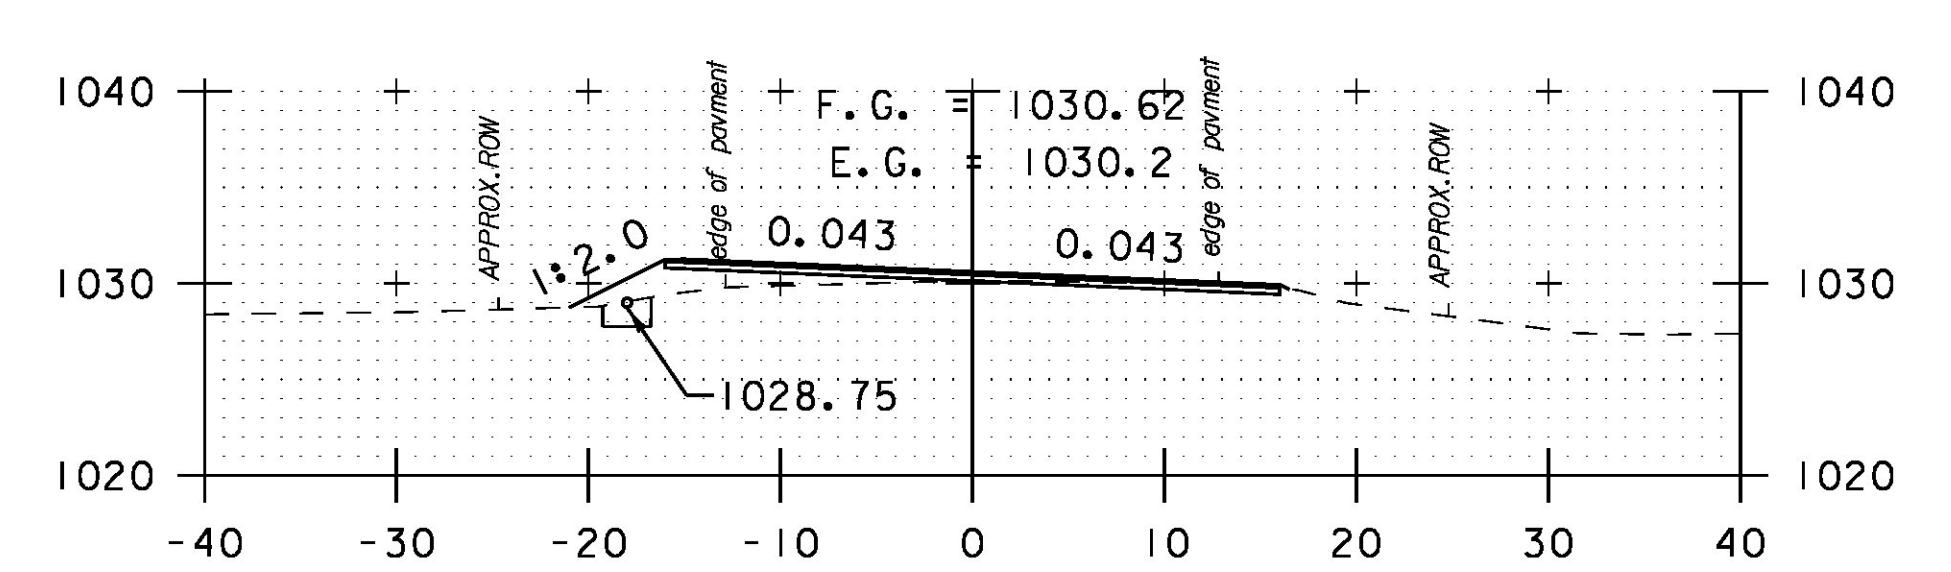

274+50



PROJECT NAME: HANCOCK
PROJECT NUMBER: STP 2923 (1)

FILE NAME: z10c252xs.dgn
PROJECT LEADER: C. LATHROP
DESIGNED BY: B. MARTIN
CROSS SECTION SHEET 51

PLOT DATE: 3/18/2015
DRAWN BY: B. MARTIN
CHECKED BY: C. LATHROP
SHEET 178 OF 207