




277+50

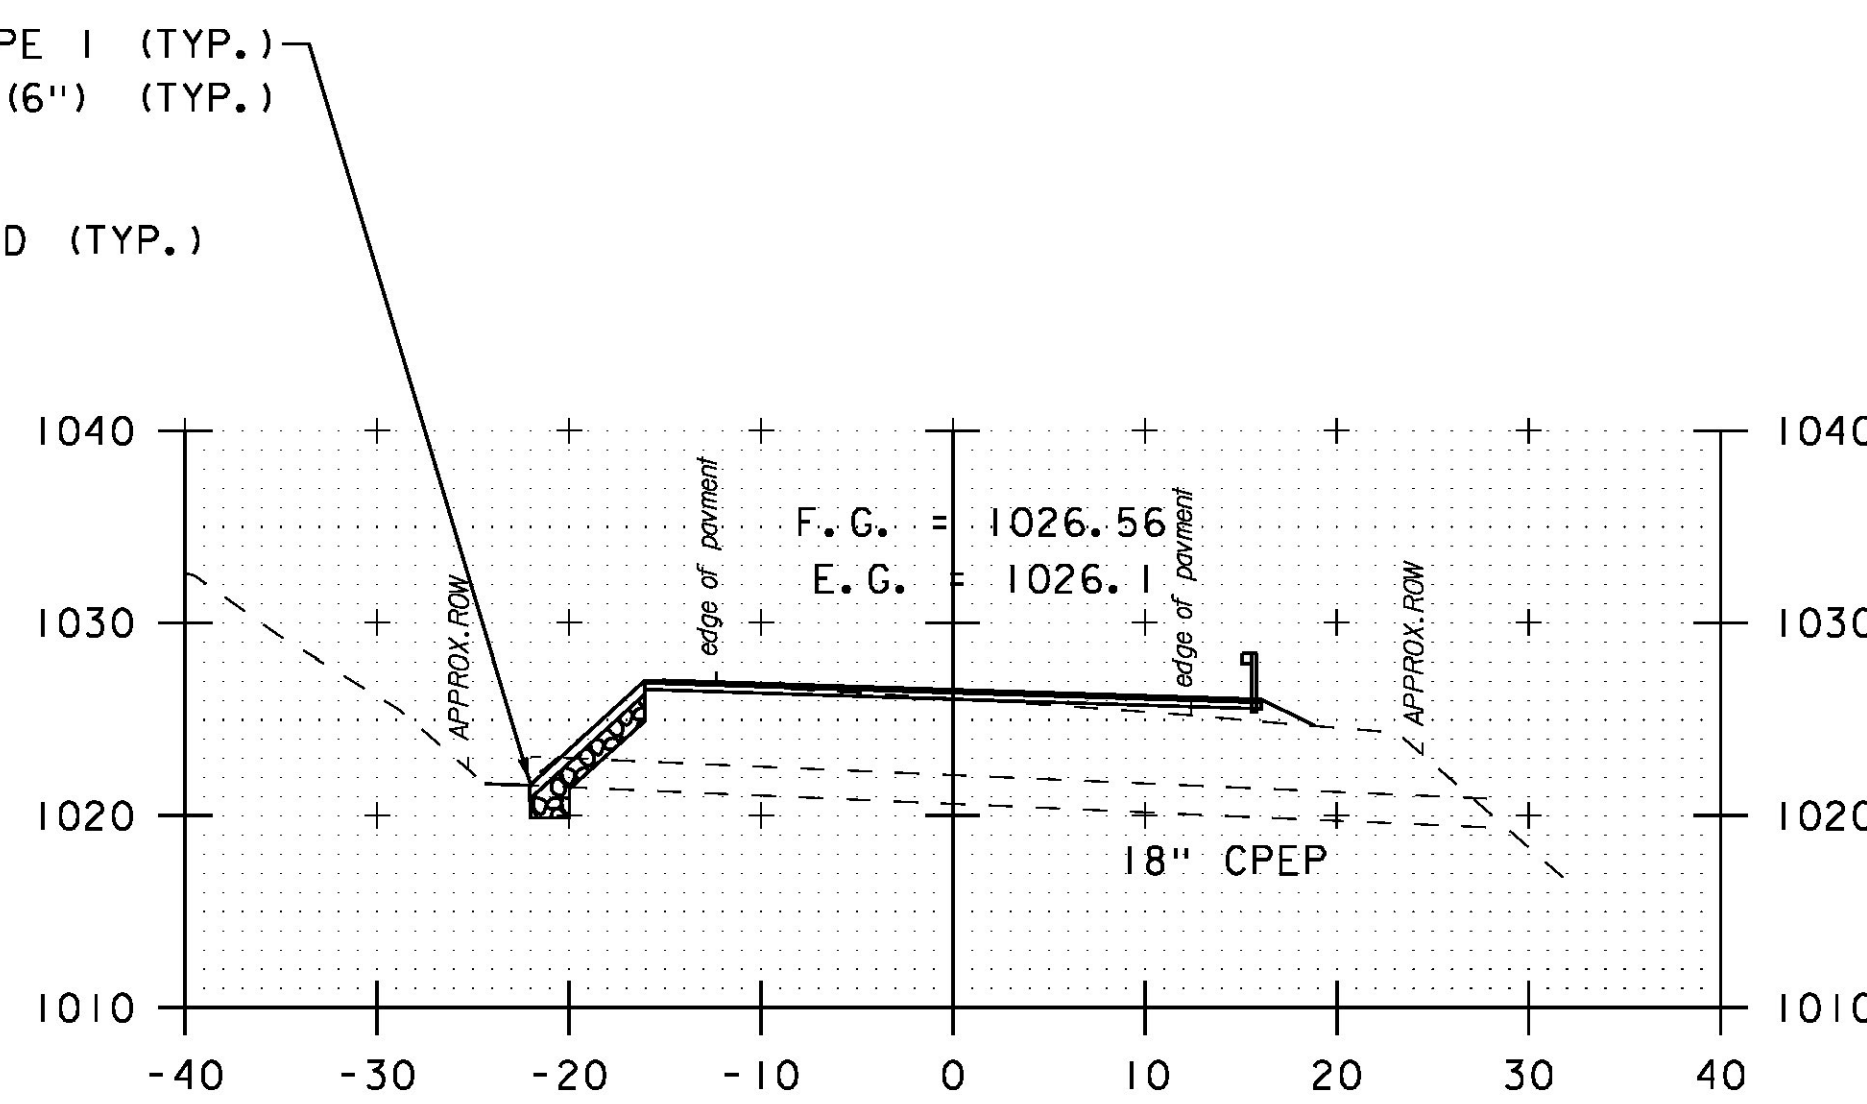


278+90  
SKEWED

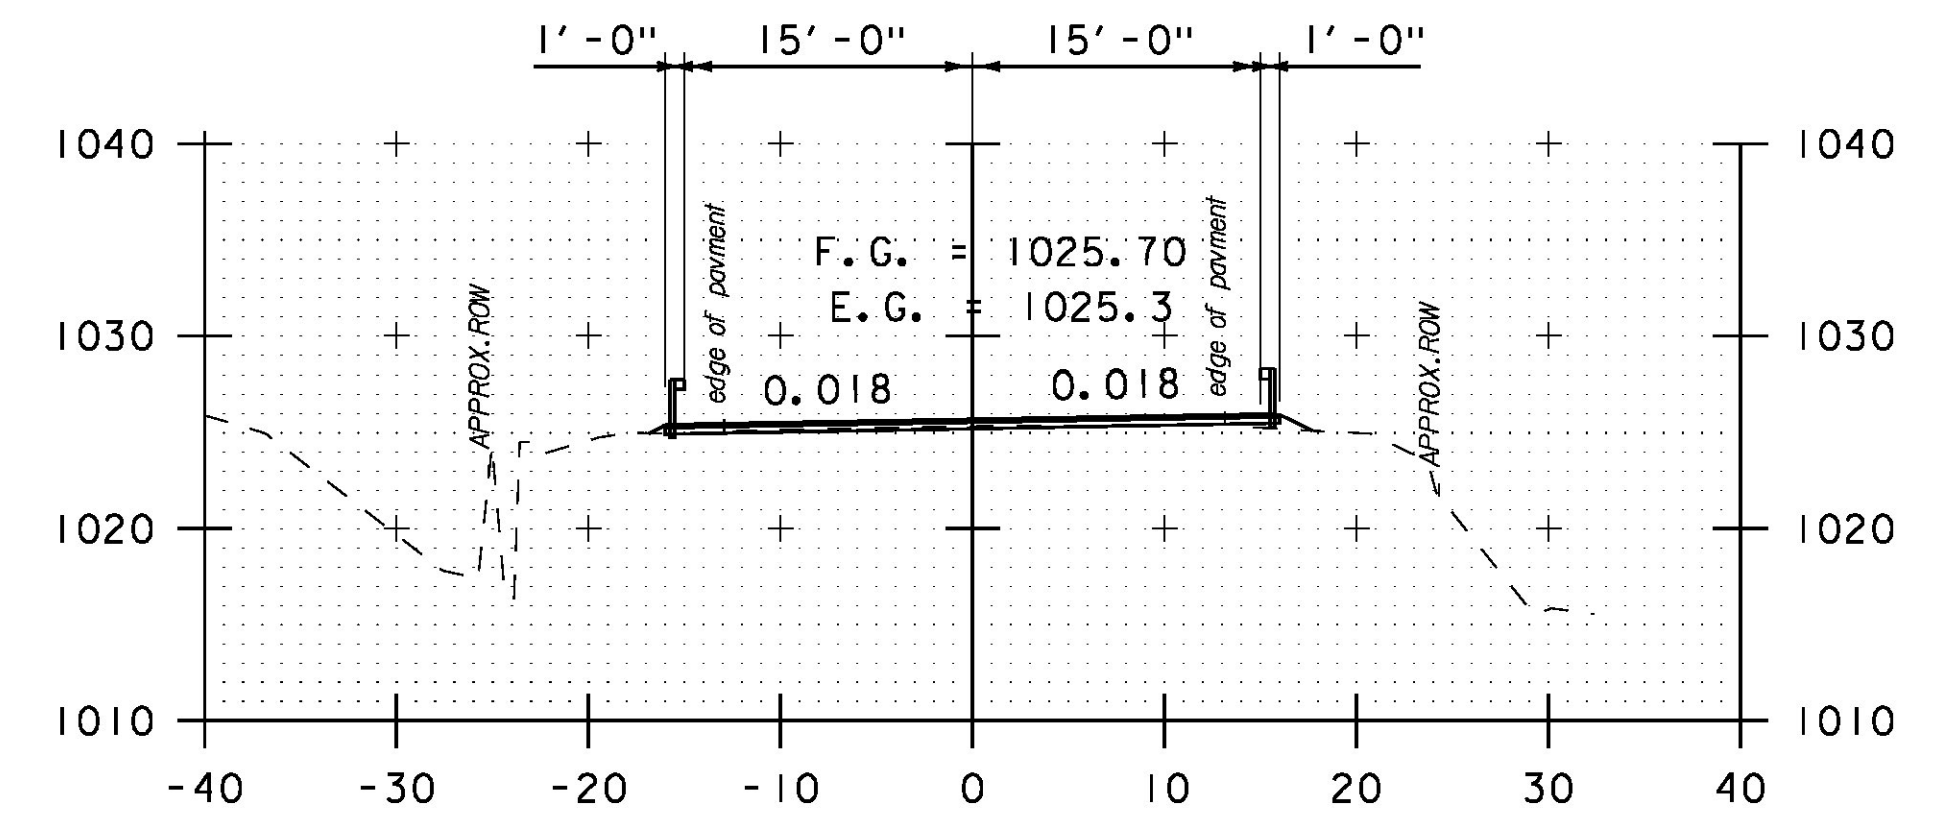


280+00

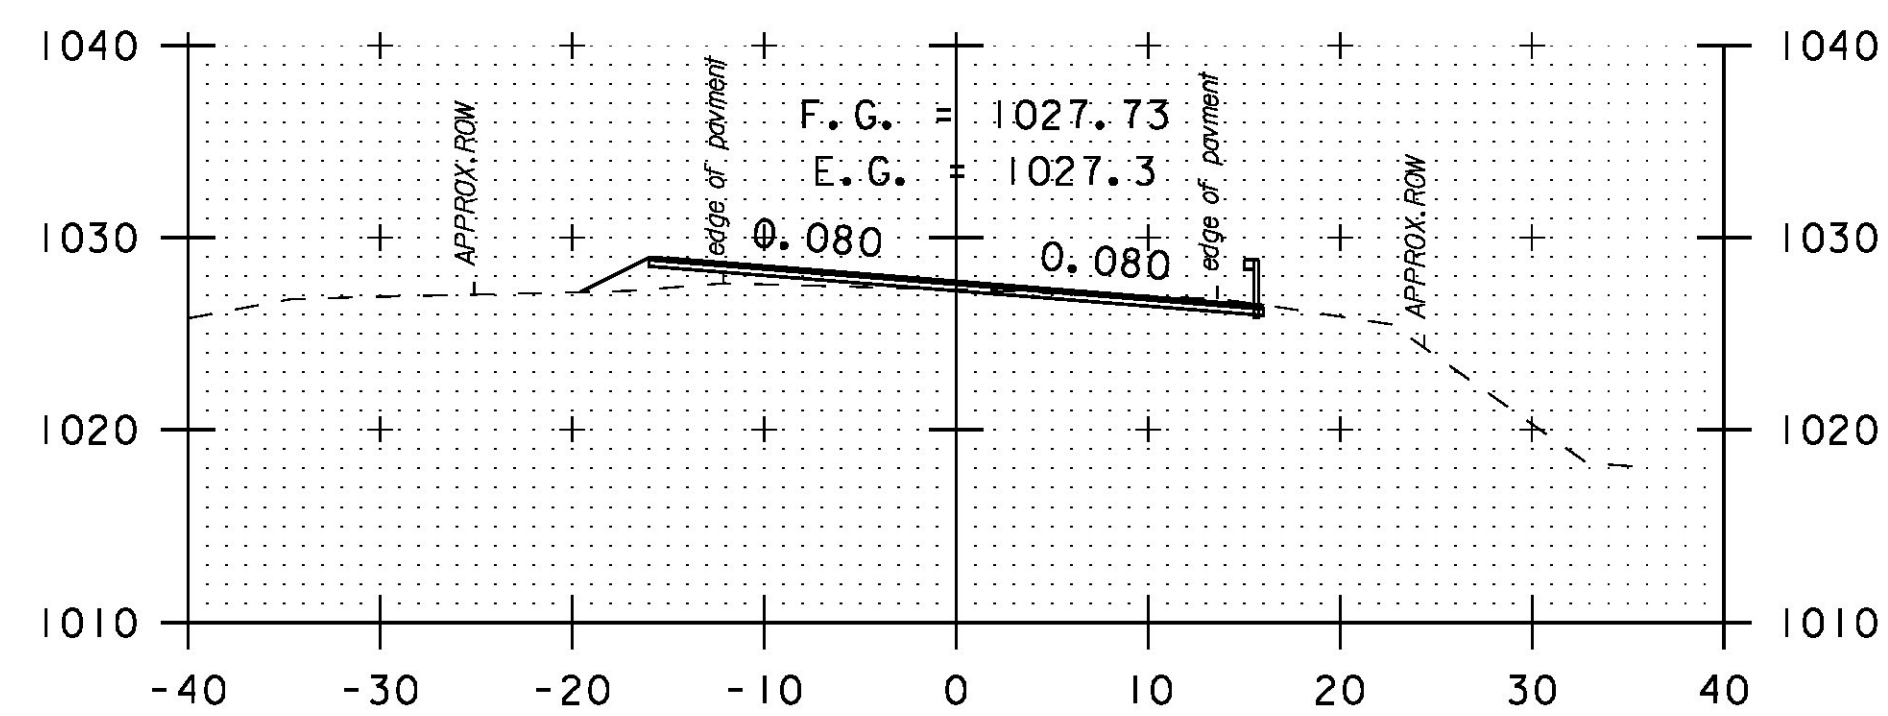


277+00

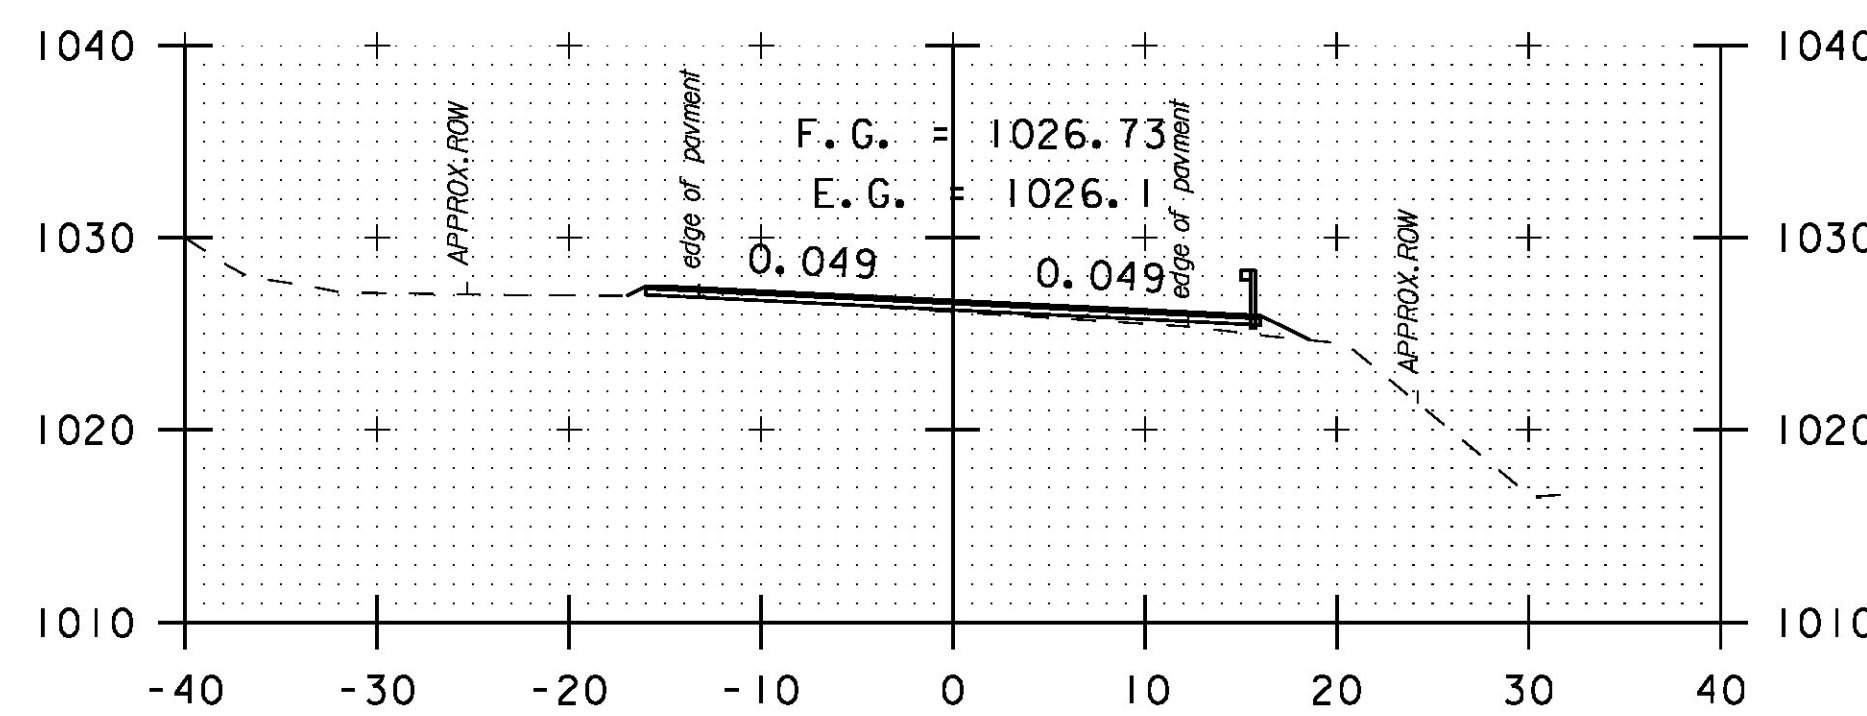


278+50

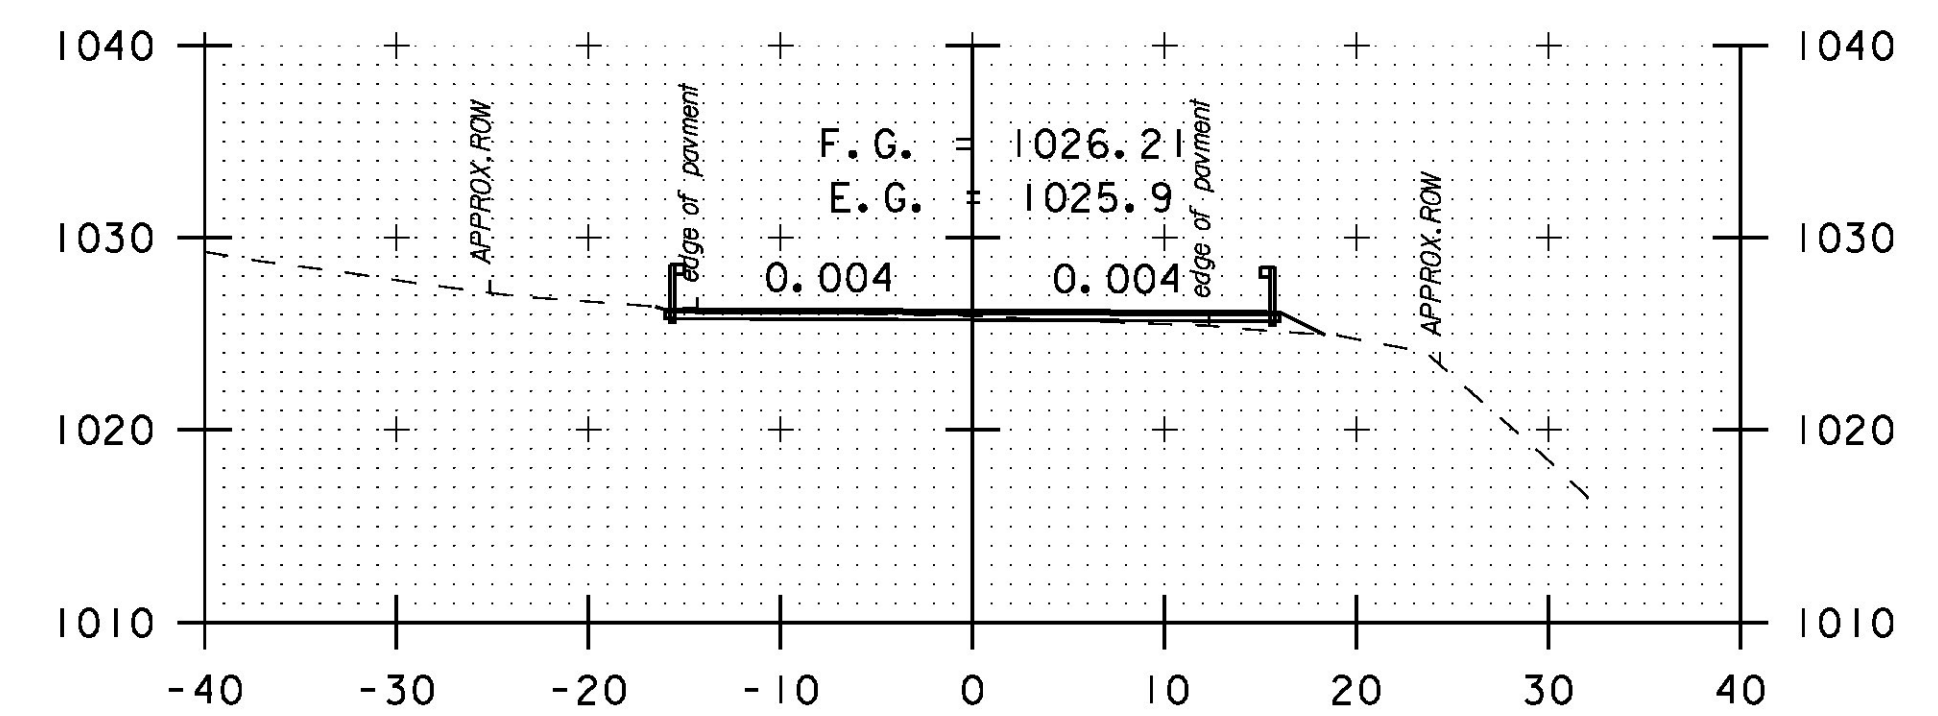


279+50  
TH #16 LT

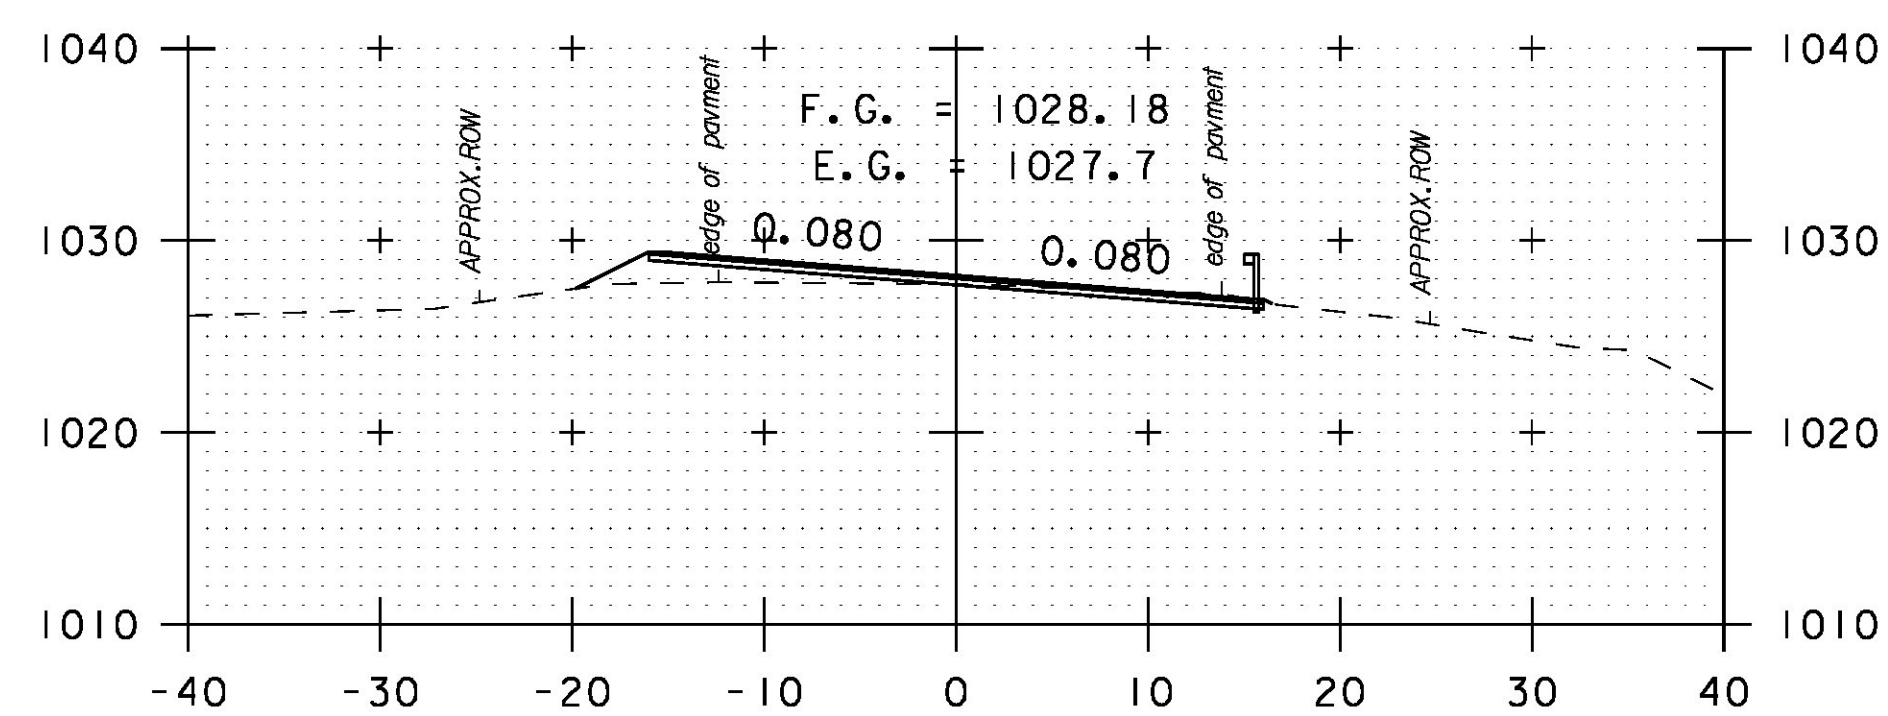


276+50

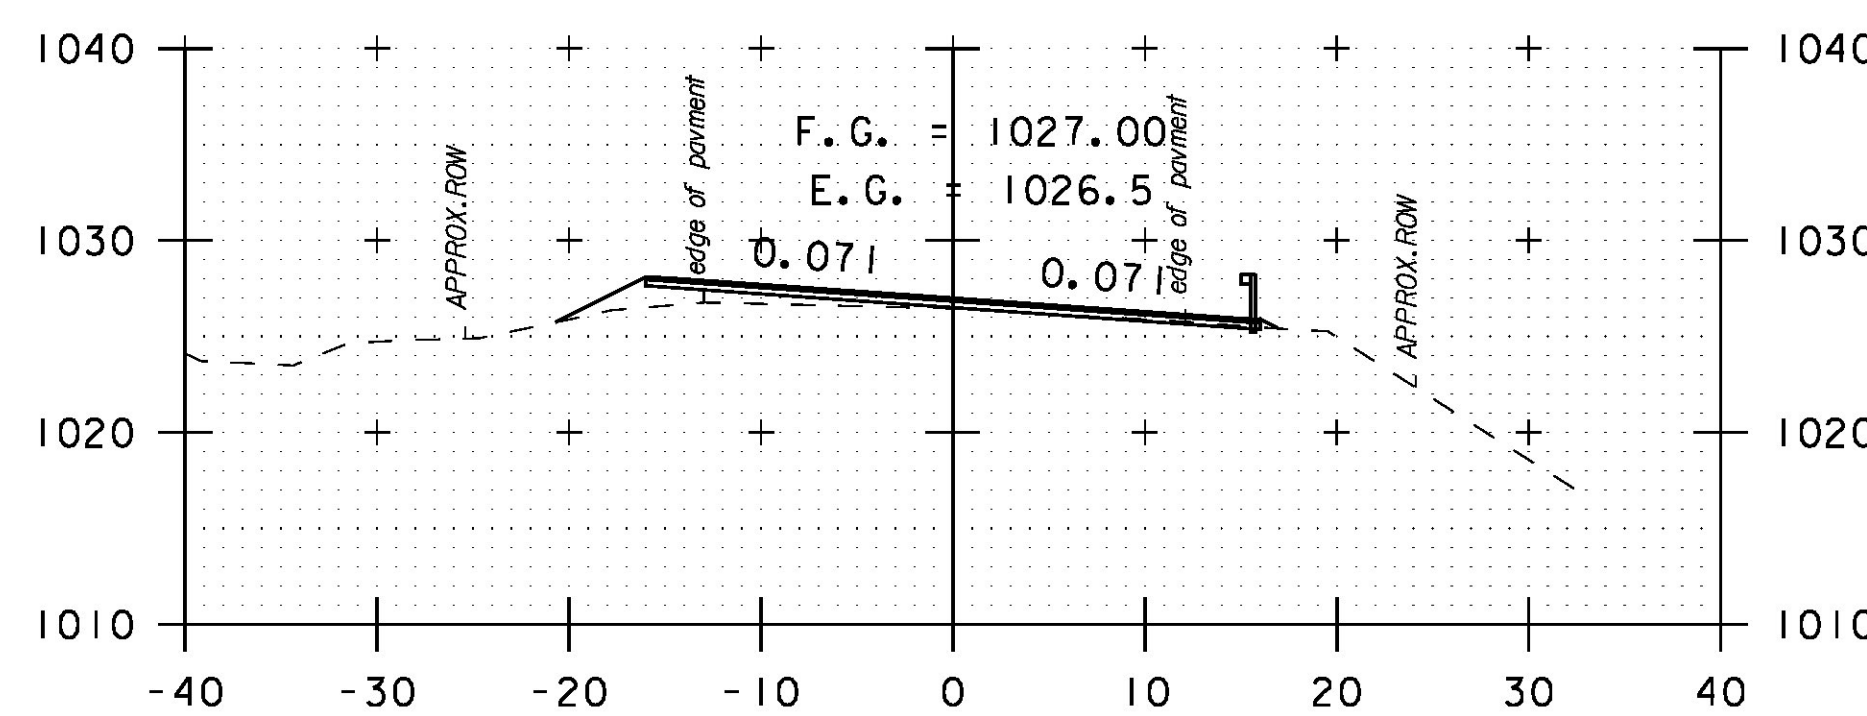

278+00

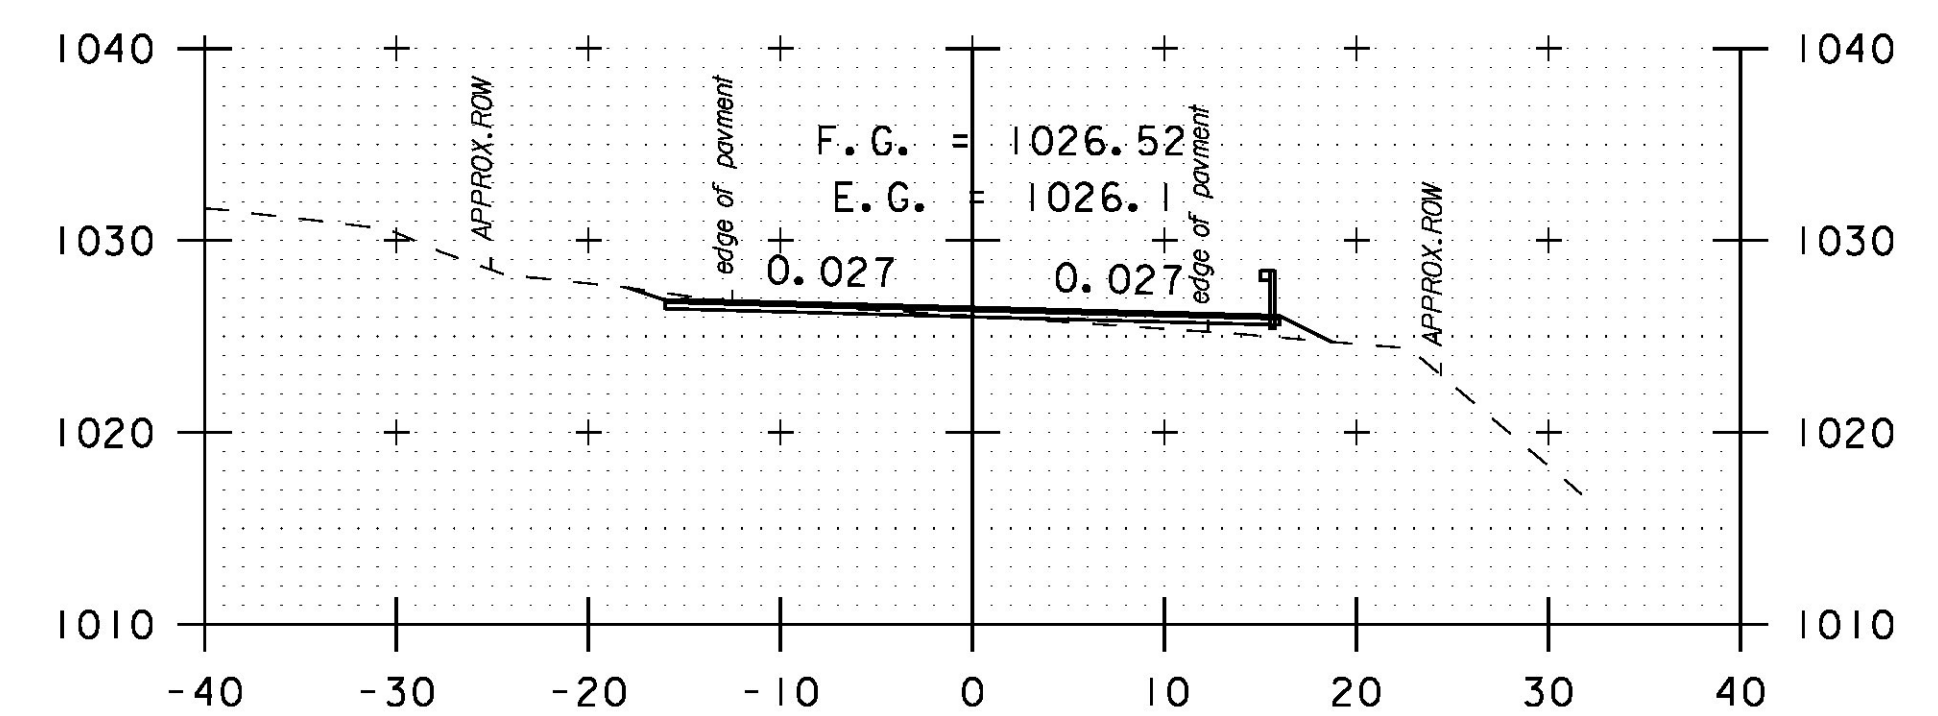

279+00

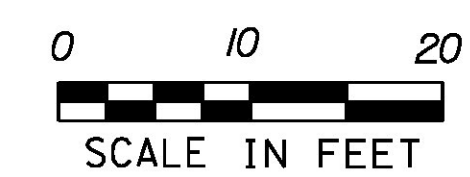

PROJECT NAME:	HANCOCK
PROJECT NUMBER:	STP 2923 (1)
FILE NAME:	z10c252xs.dgn
PROJECT LEADER:	C. LATHROP
DESIGNED BY:	B. MARTIN
CROSS SECTION SHEET:	52
PLOT DATE:	3/18/2015
DRAWN BY:	B. MARTIN
CHECKED BY:	C. LATHROP
SHEET:	179 OF 207