




281+00

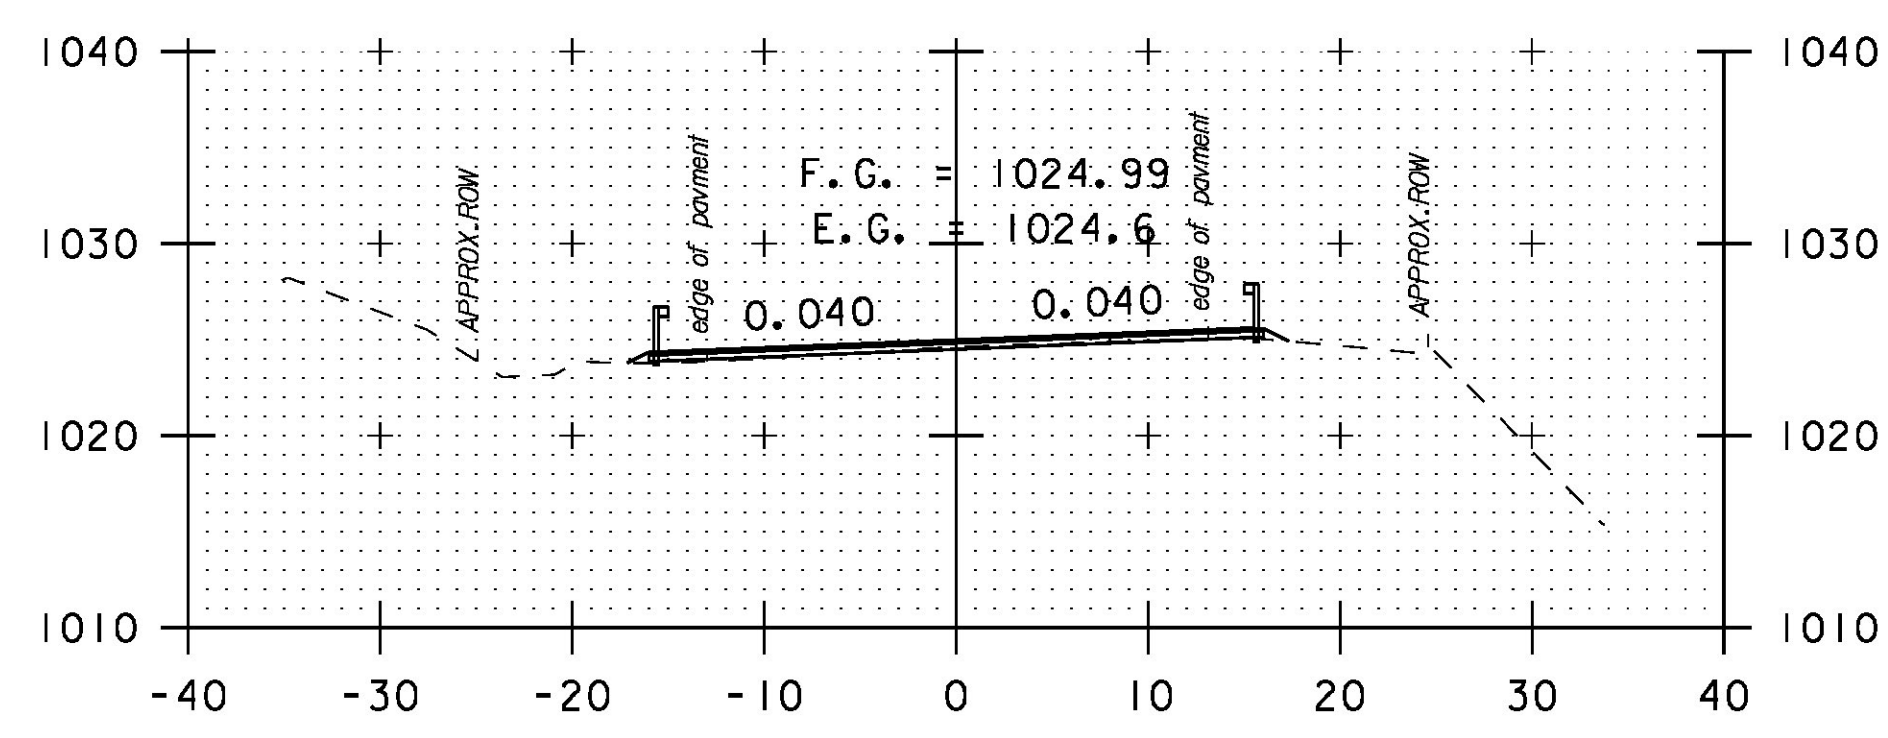


280+50

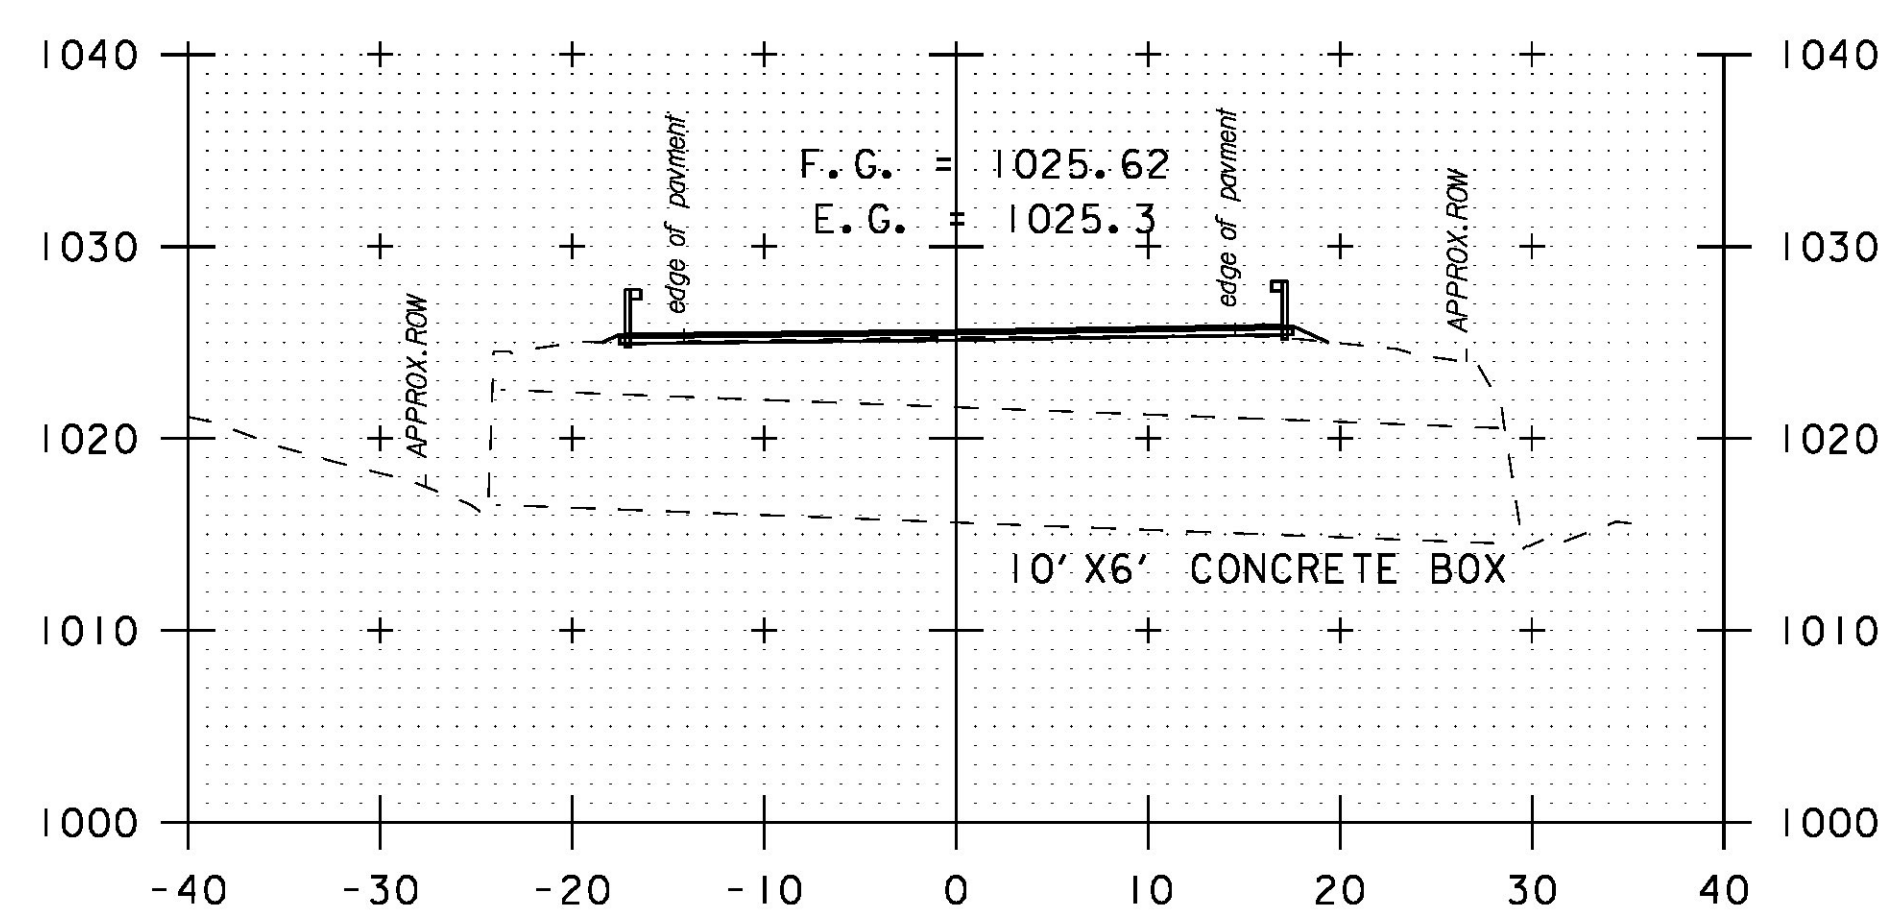


280+07
BRIDGE #24

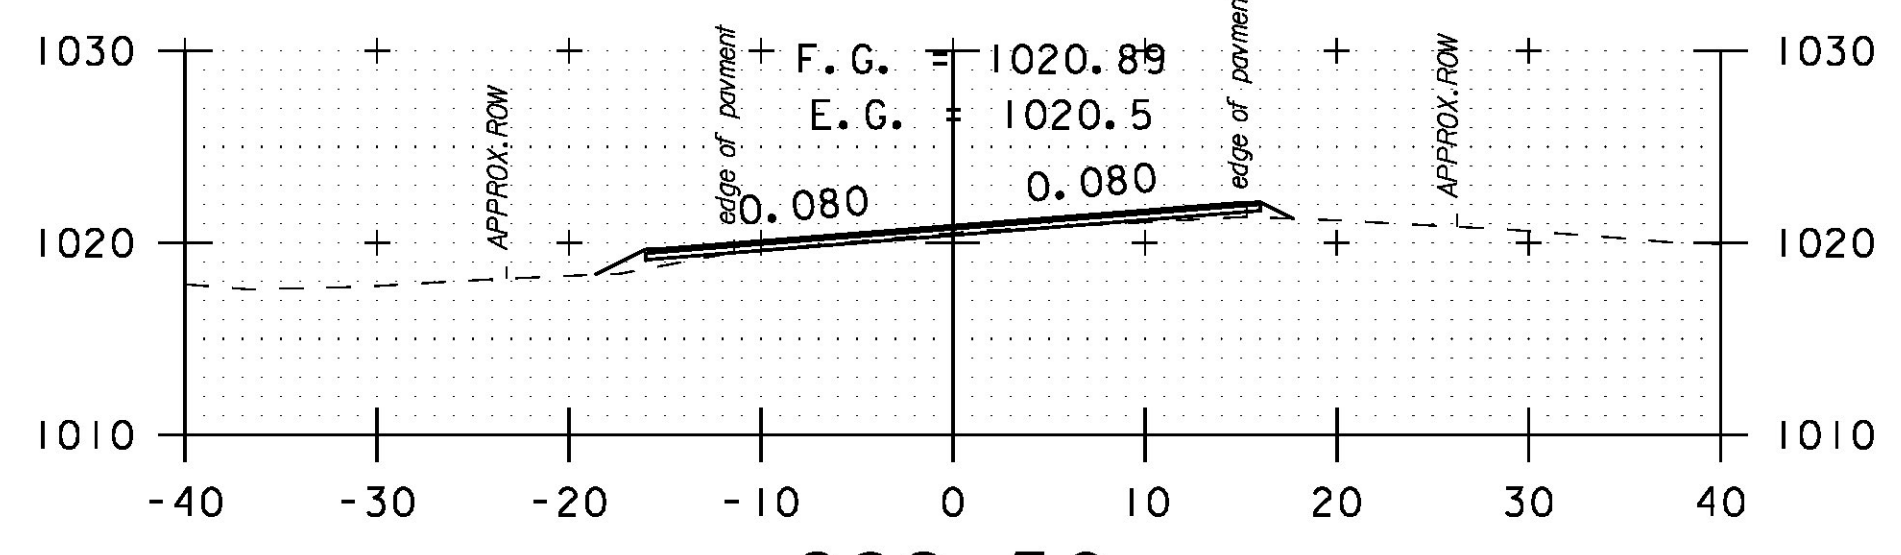


282+50
DRIVE RT

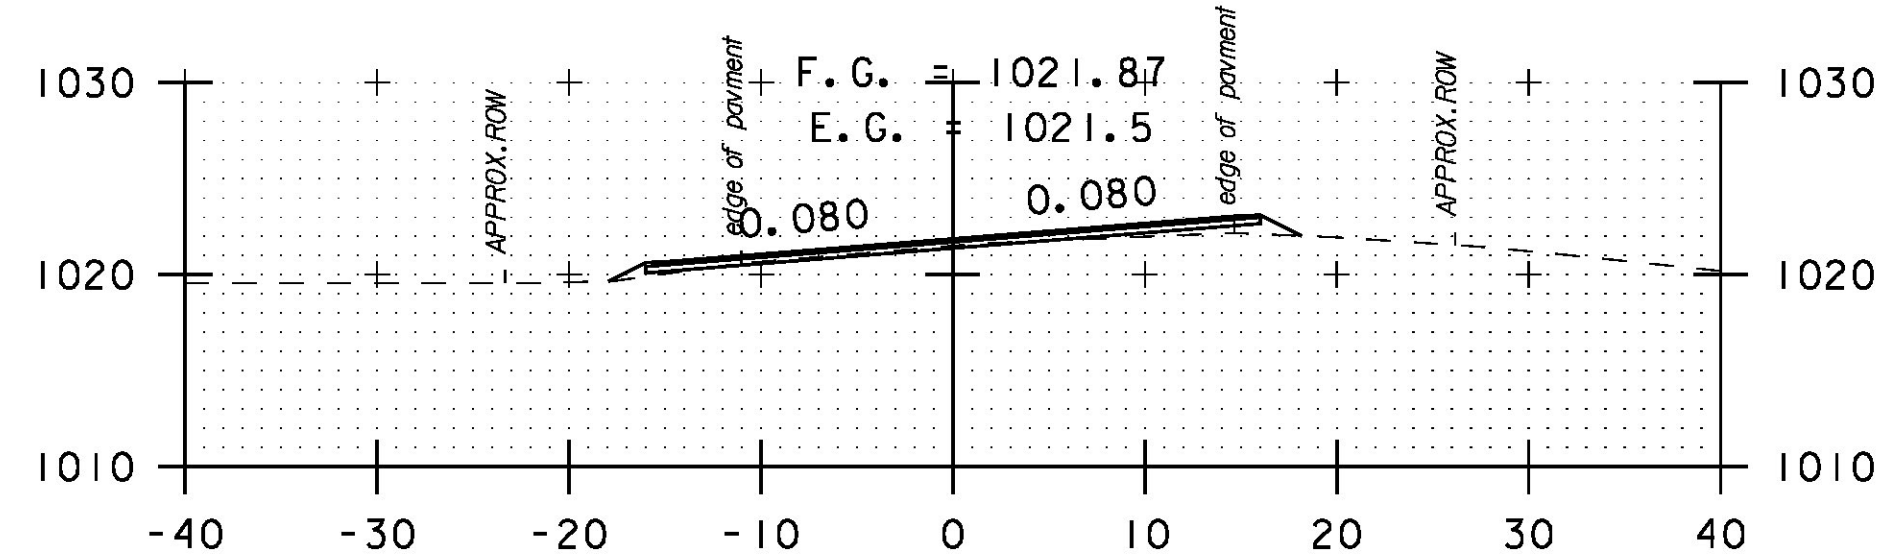


282+00
DRIVE LT

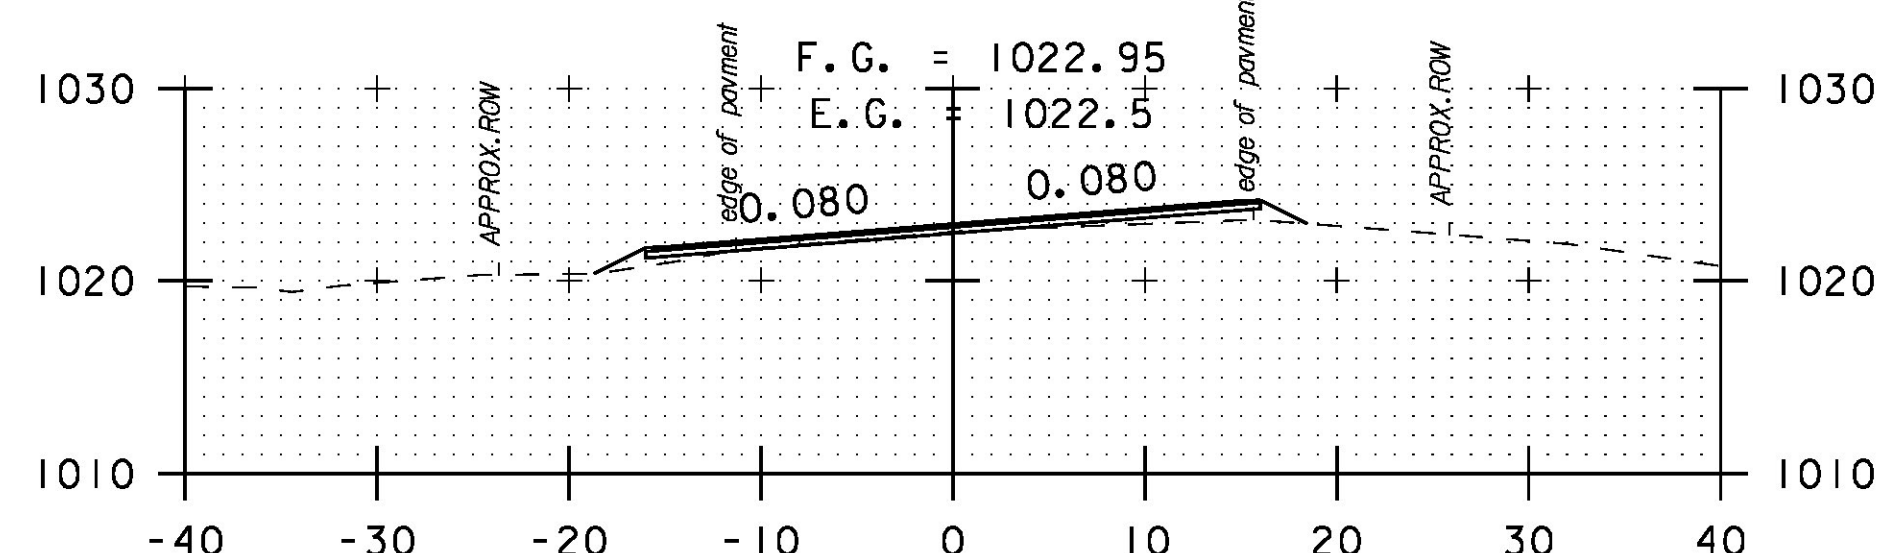


281+50

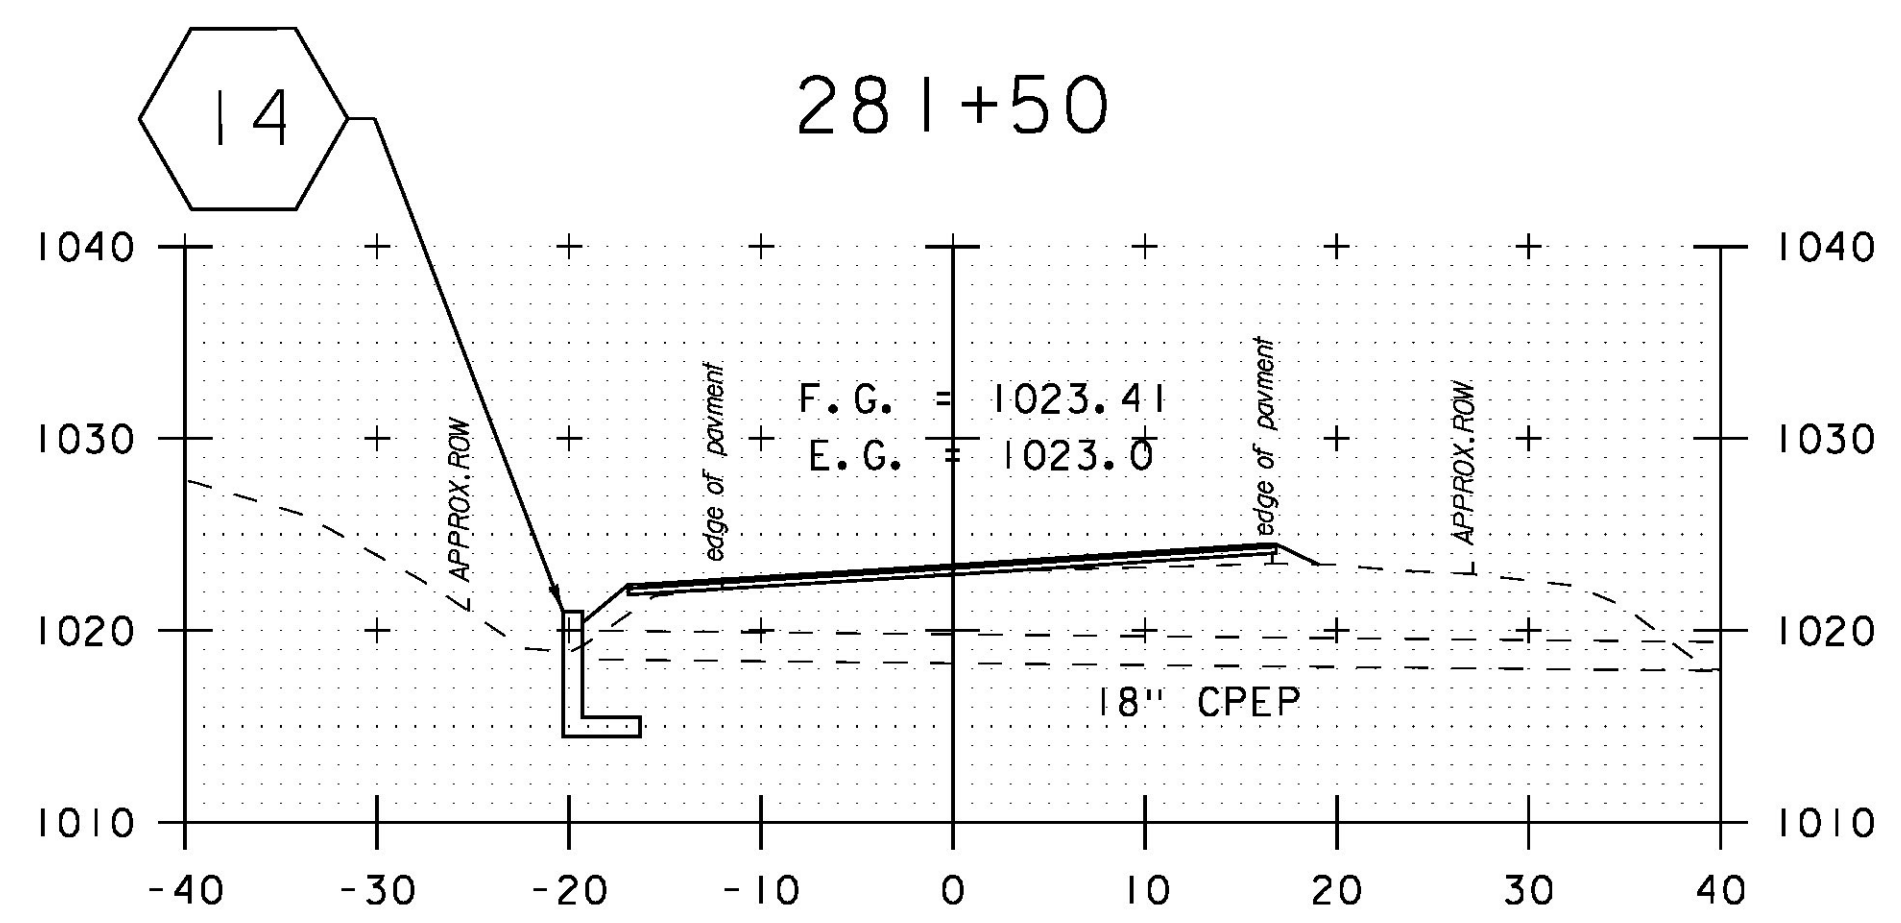


281+30
SKEWED

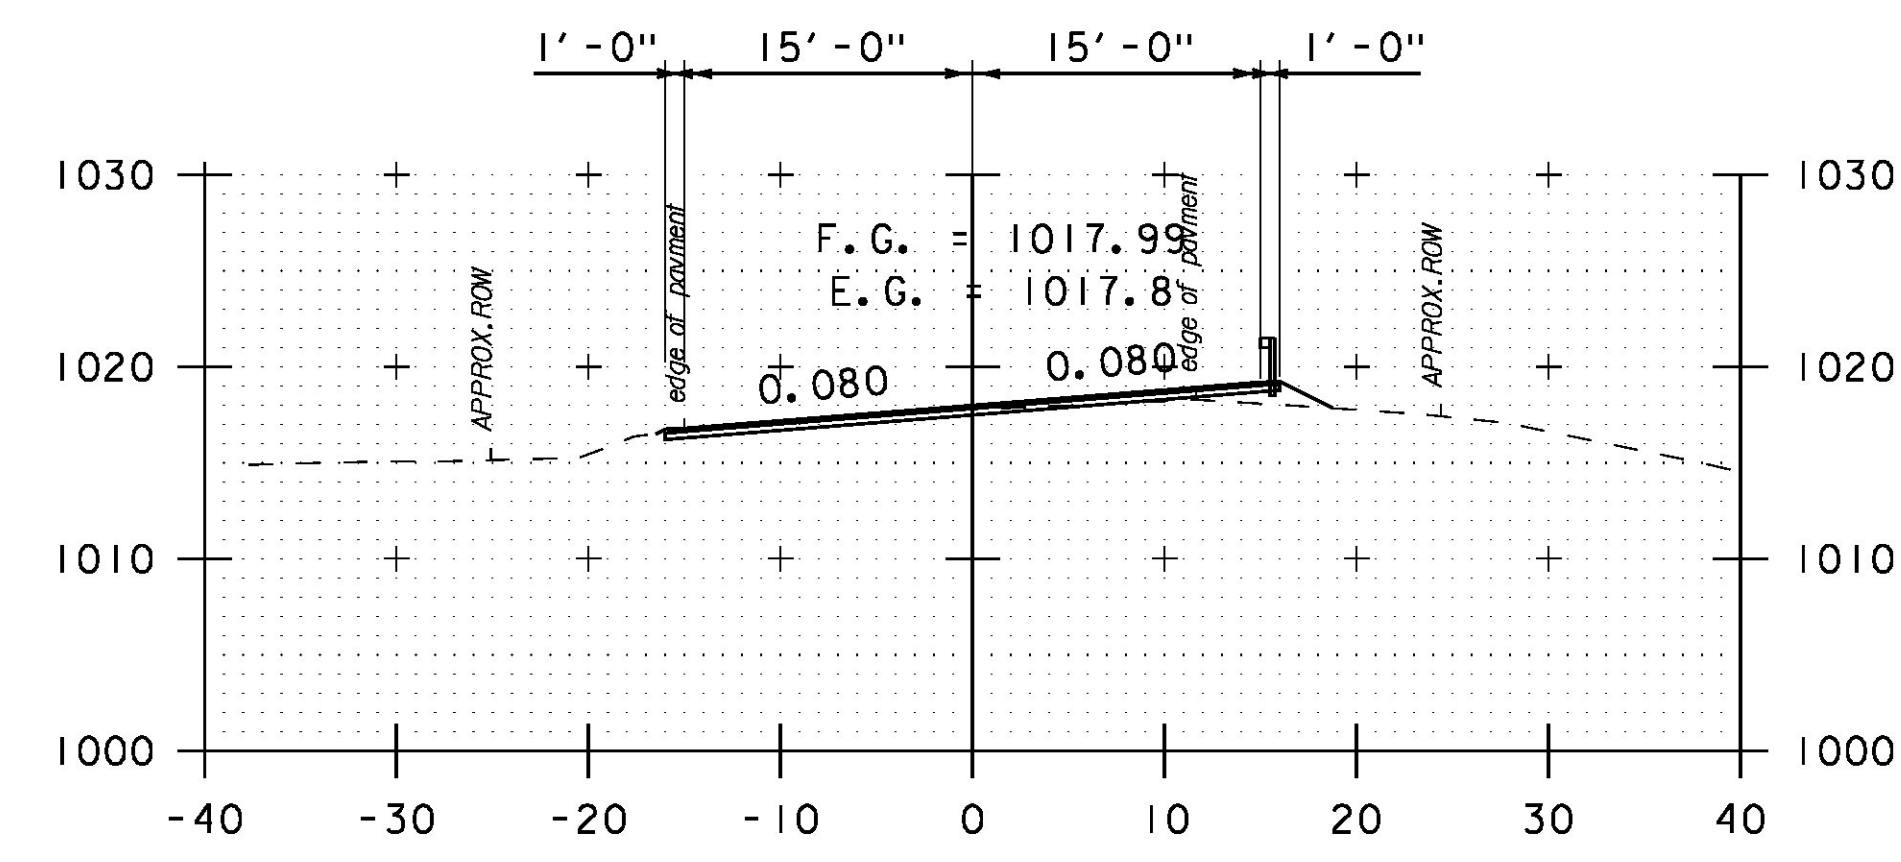


284+50

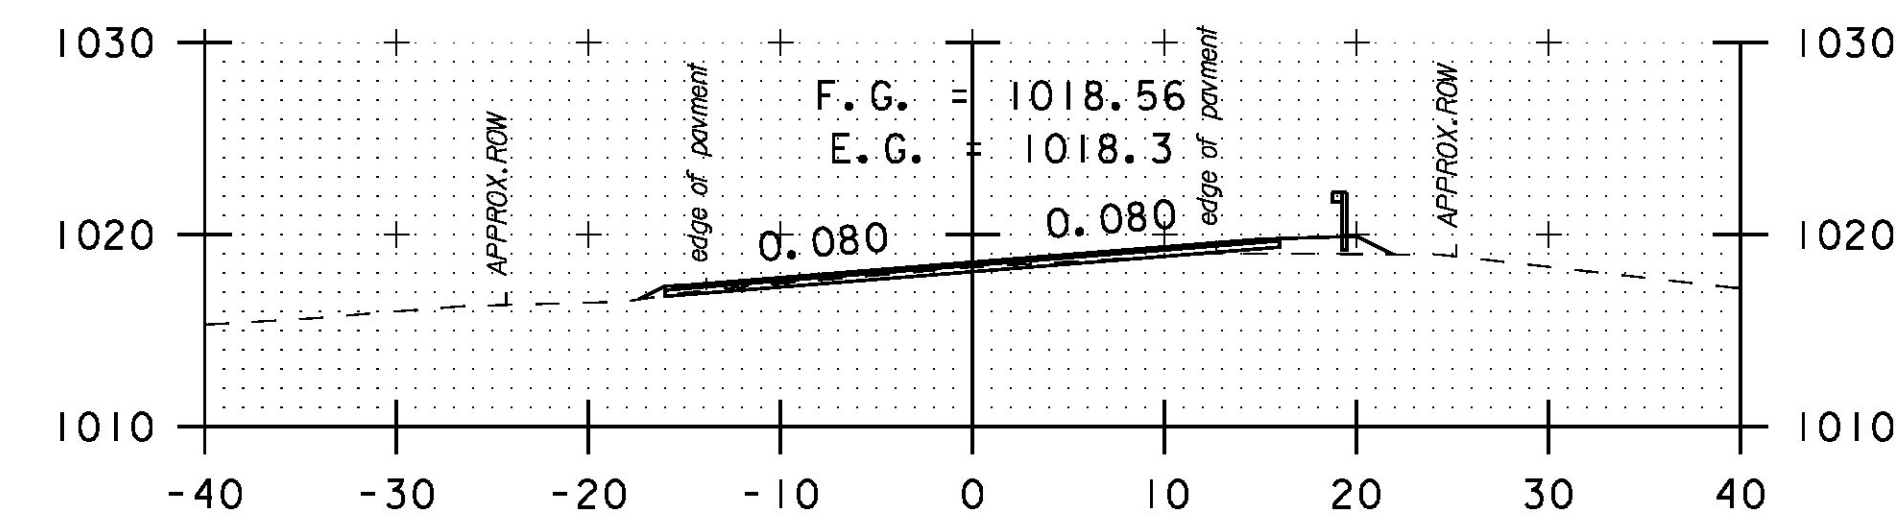

284+00

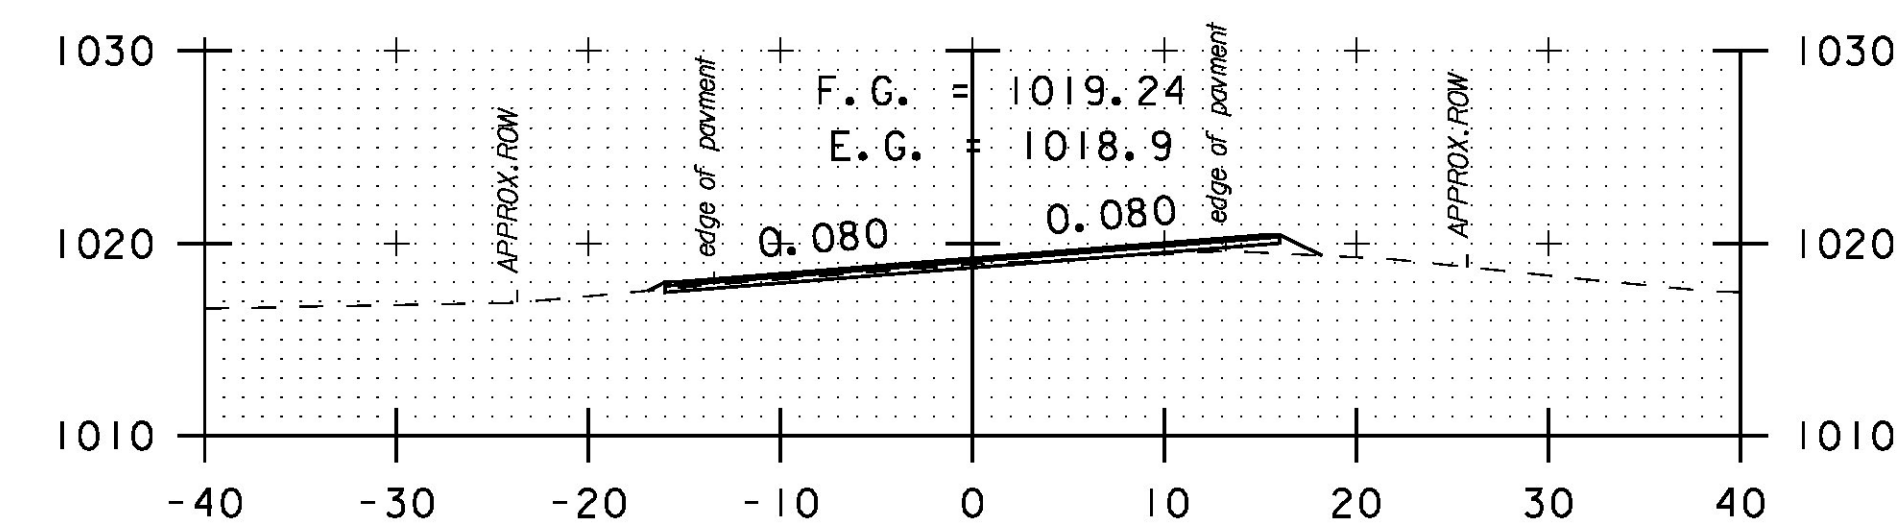


283+50
DRIVE LT

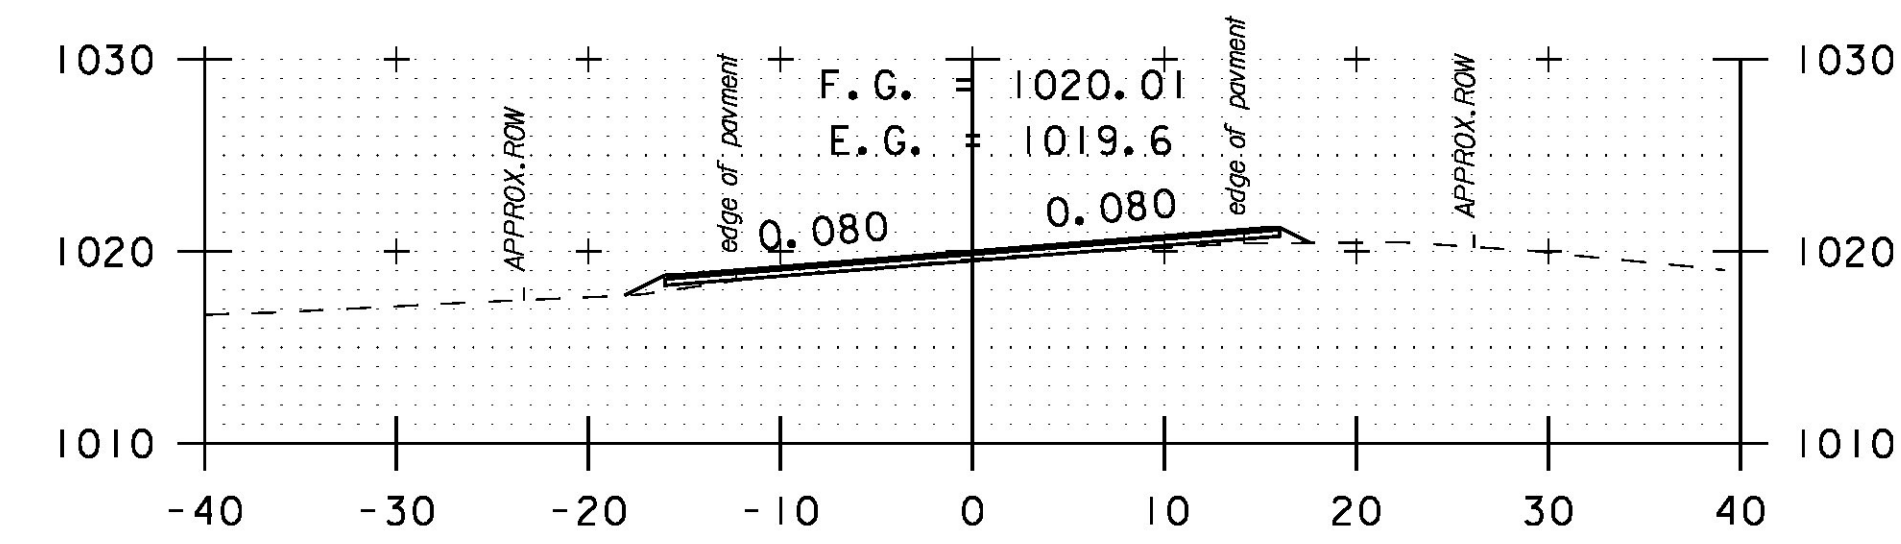

283+00

14

STA. 281+23.78 LT 19.2' TO
STA. 281+42.37 RT 37.44'
CONSTRUCT CONCRETE REINFORCED
HEADWALL PER STD. D-33 FOR
18" PIPE, LT
INV. IN = 1018.49'
INV. OUT = 1017.91'

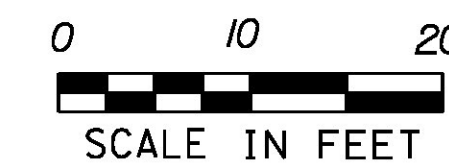

PROJECT NAME: HANCOCK
PROJECT NUMBER: STP 2923 (1)

FILE NAME: z10c252xs.dgn
PROJECT LEADER: C. LATHROP
DESIGNED BY: B. MARTIN
CROSS SECTION SHEET 53

PLOT DATE: 3/18/2015
DRAWN BY: B. MARTIN
CHECKED BY: C. LATHROP
SHEET 180 OF 207