




290+00

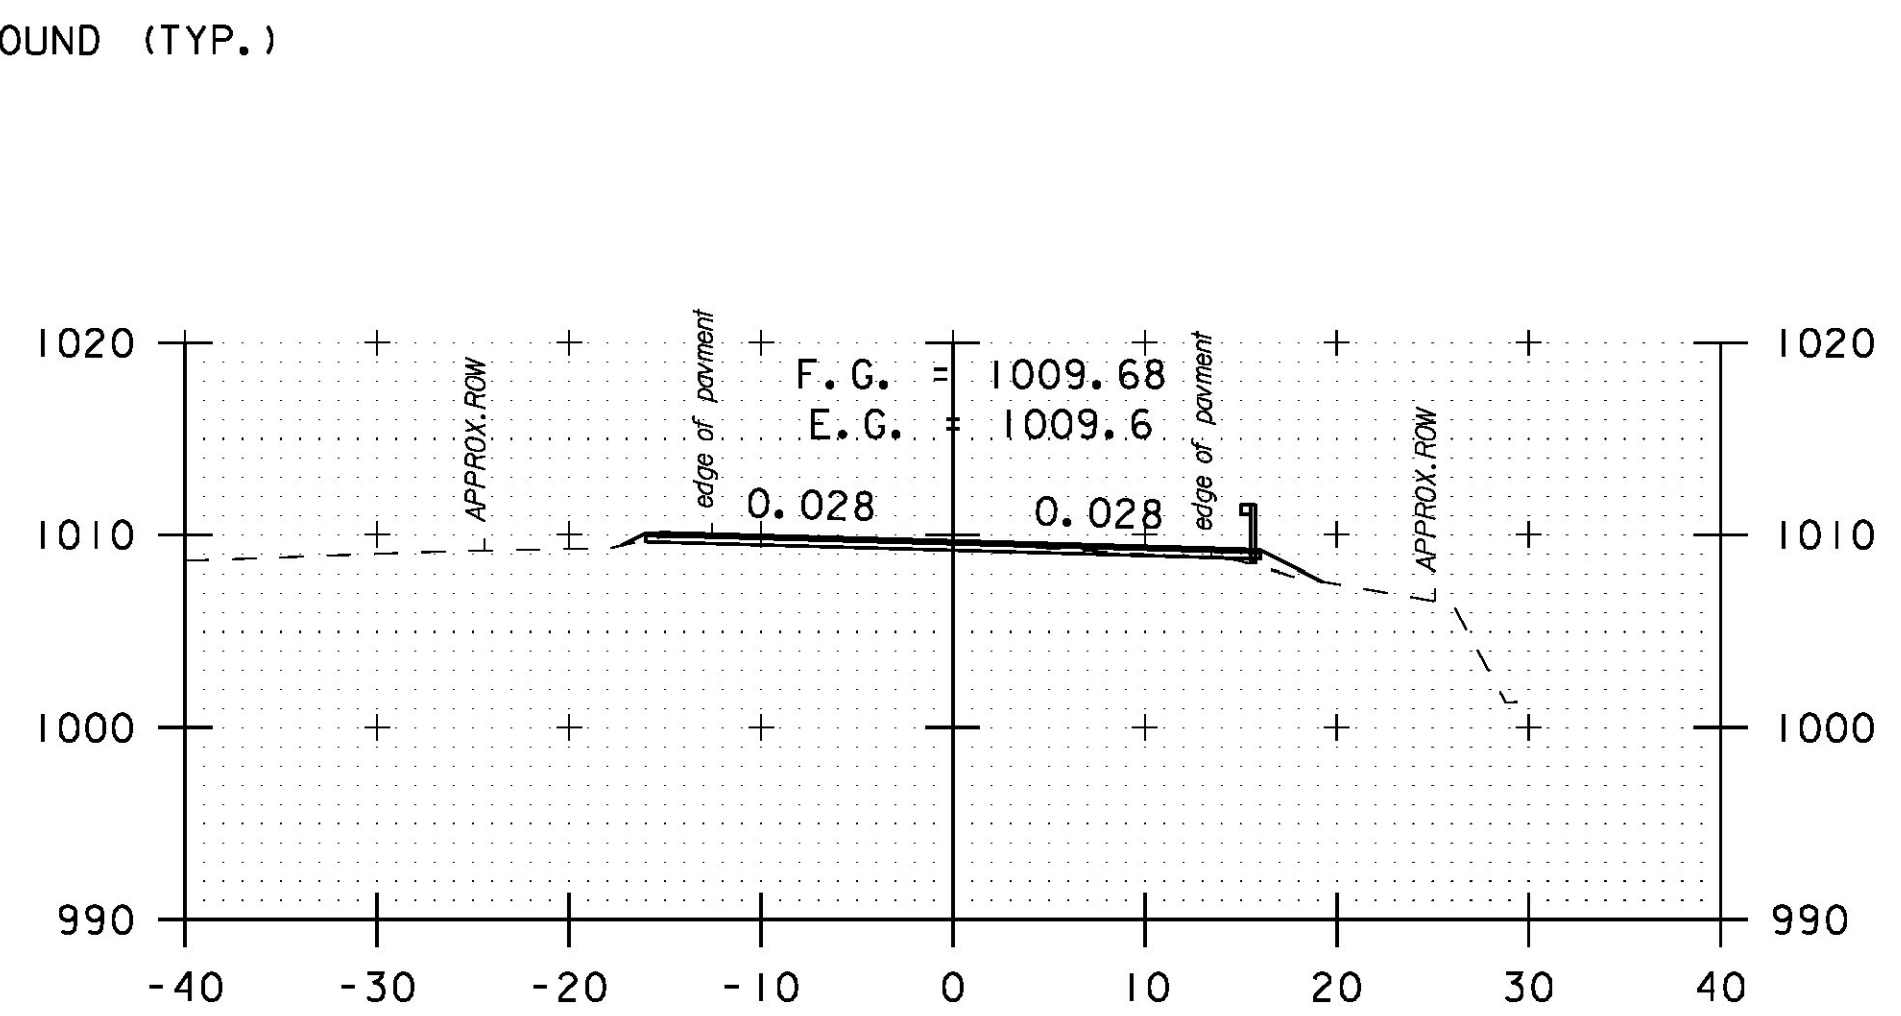


291+50

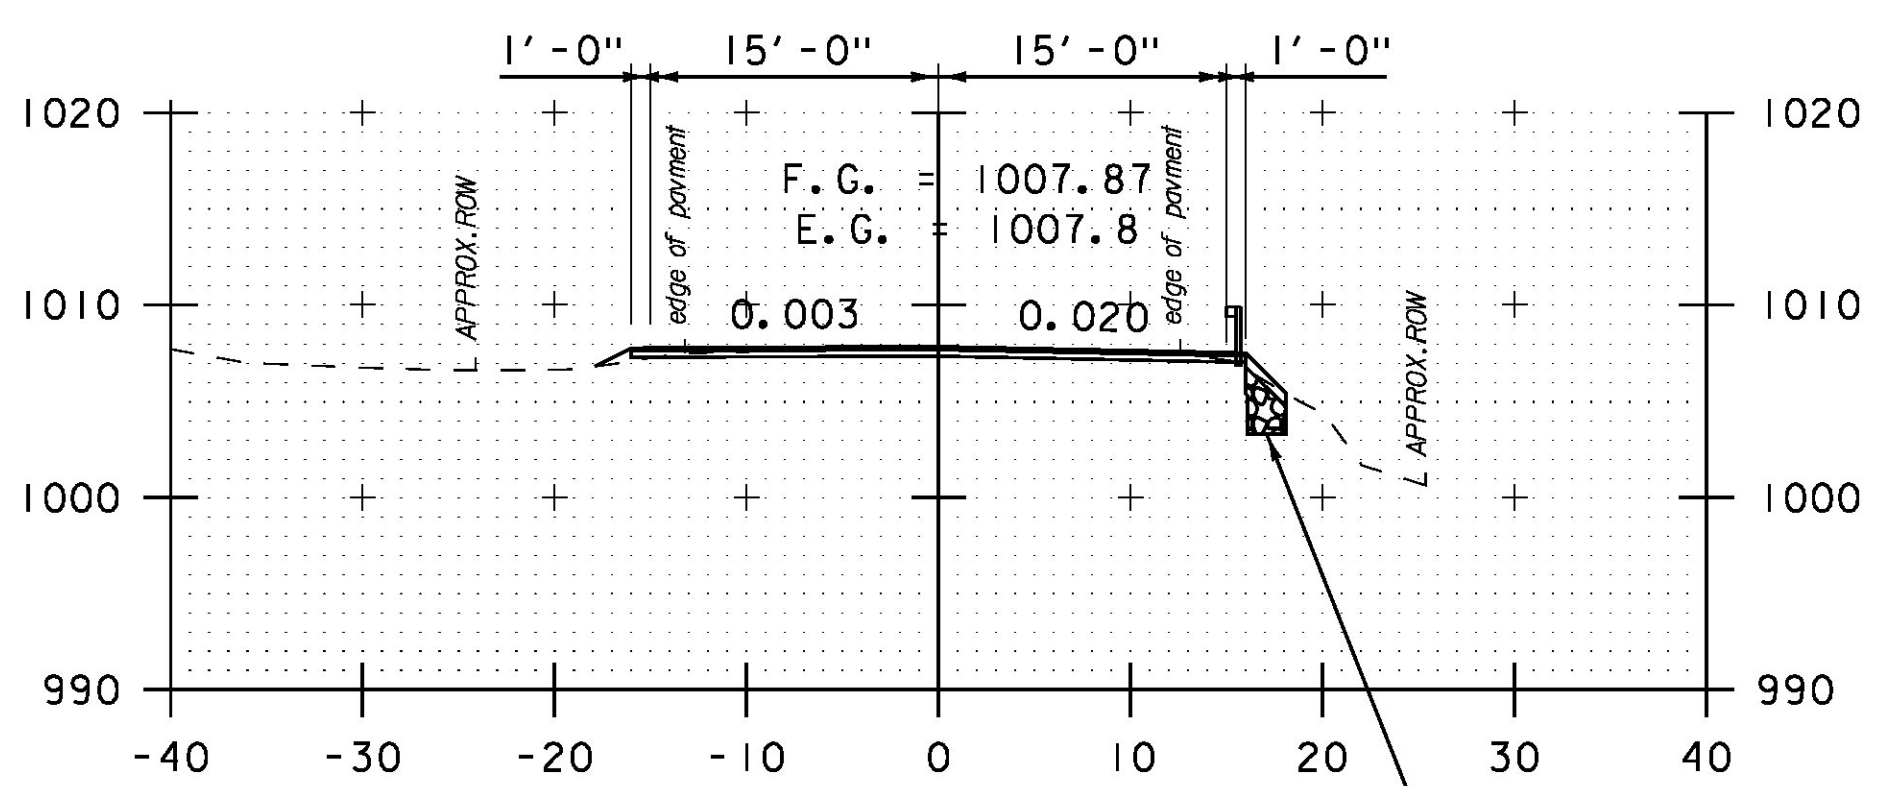


293+00

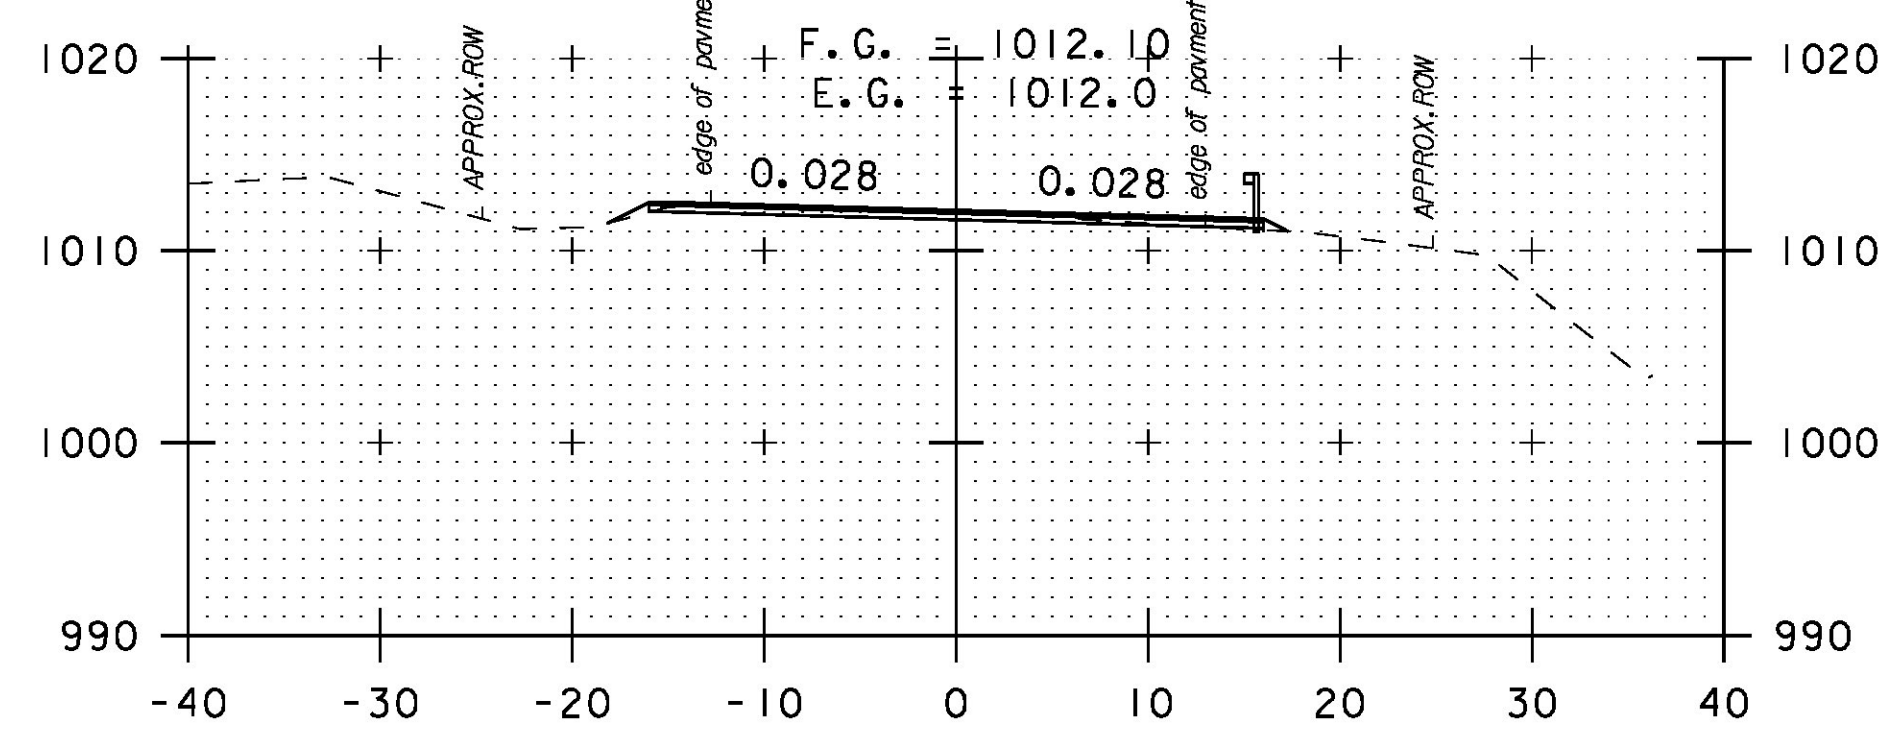


289+50

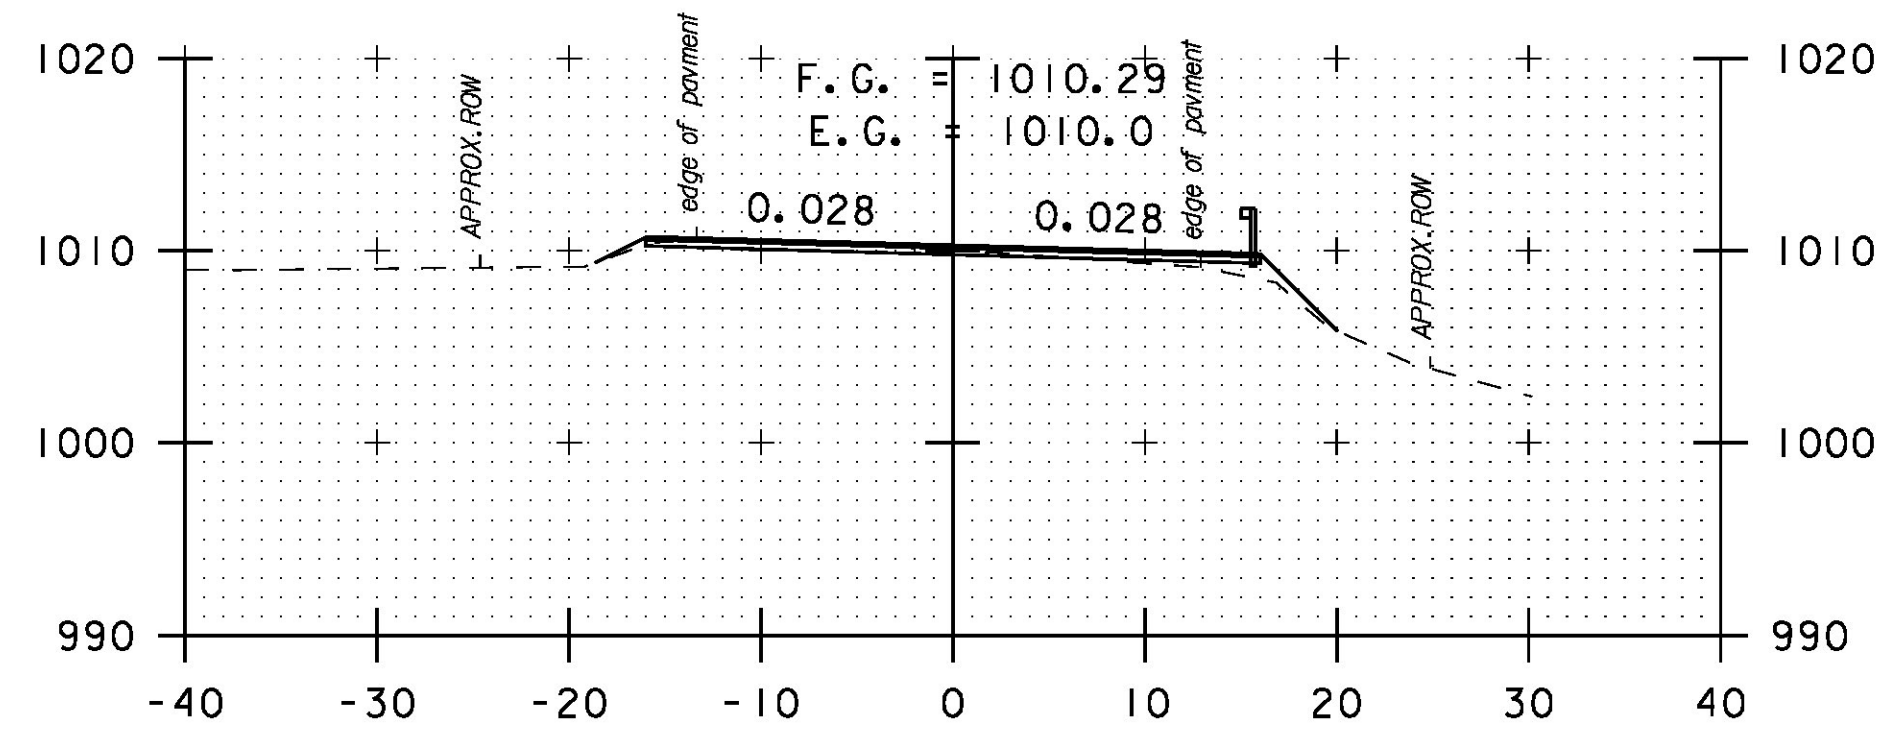


291+00

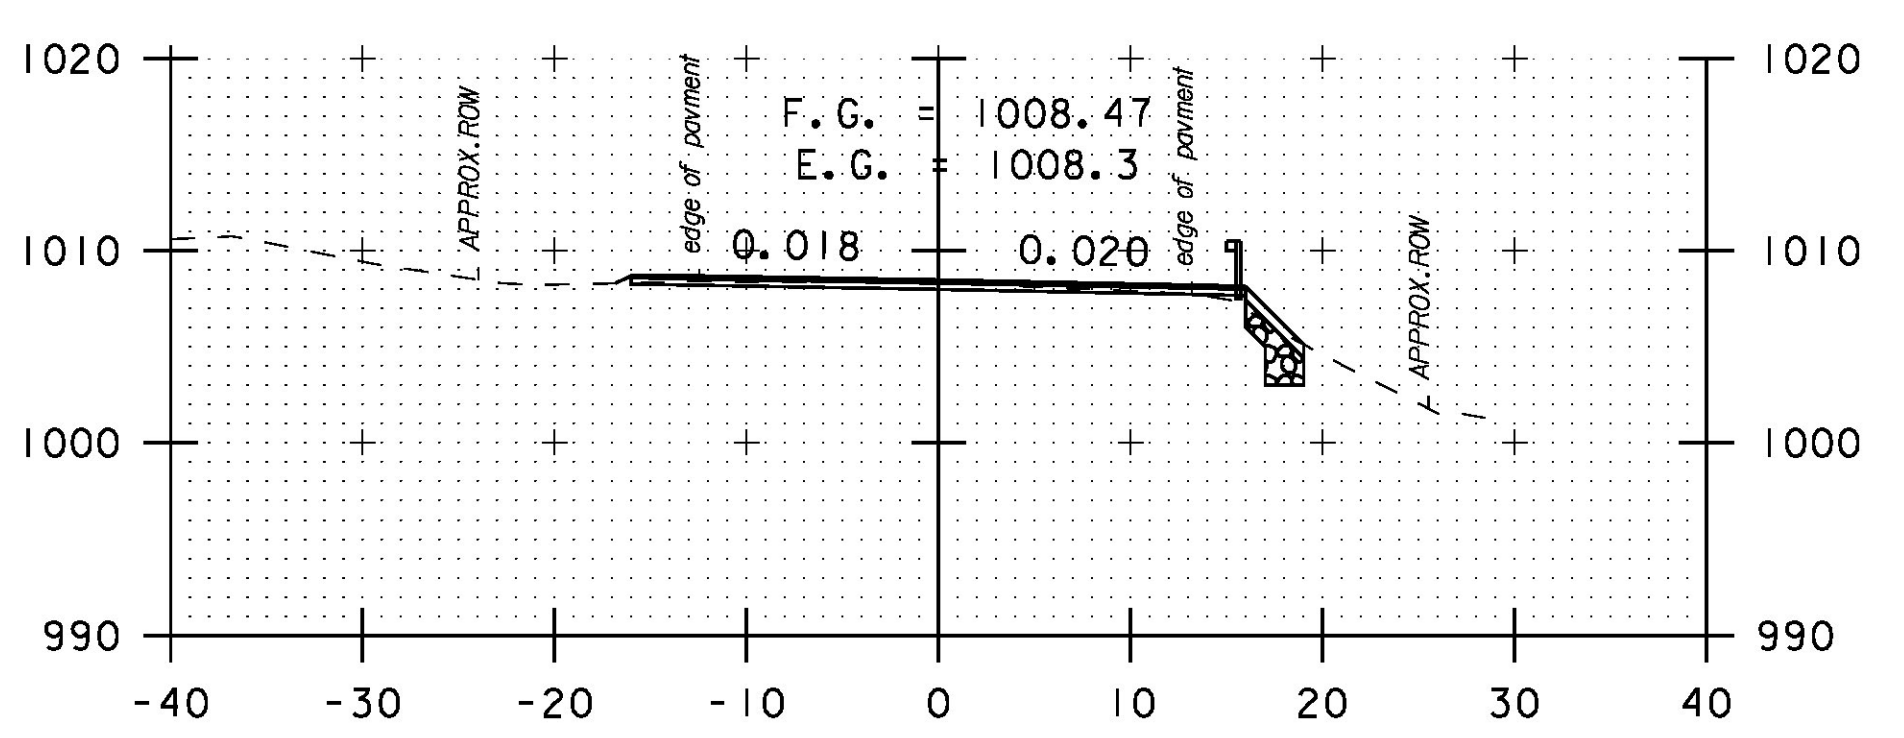


292+50

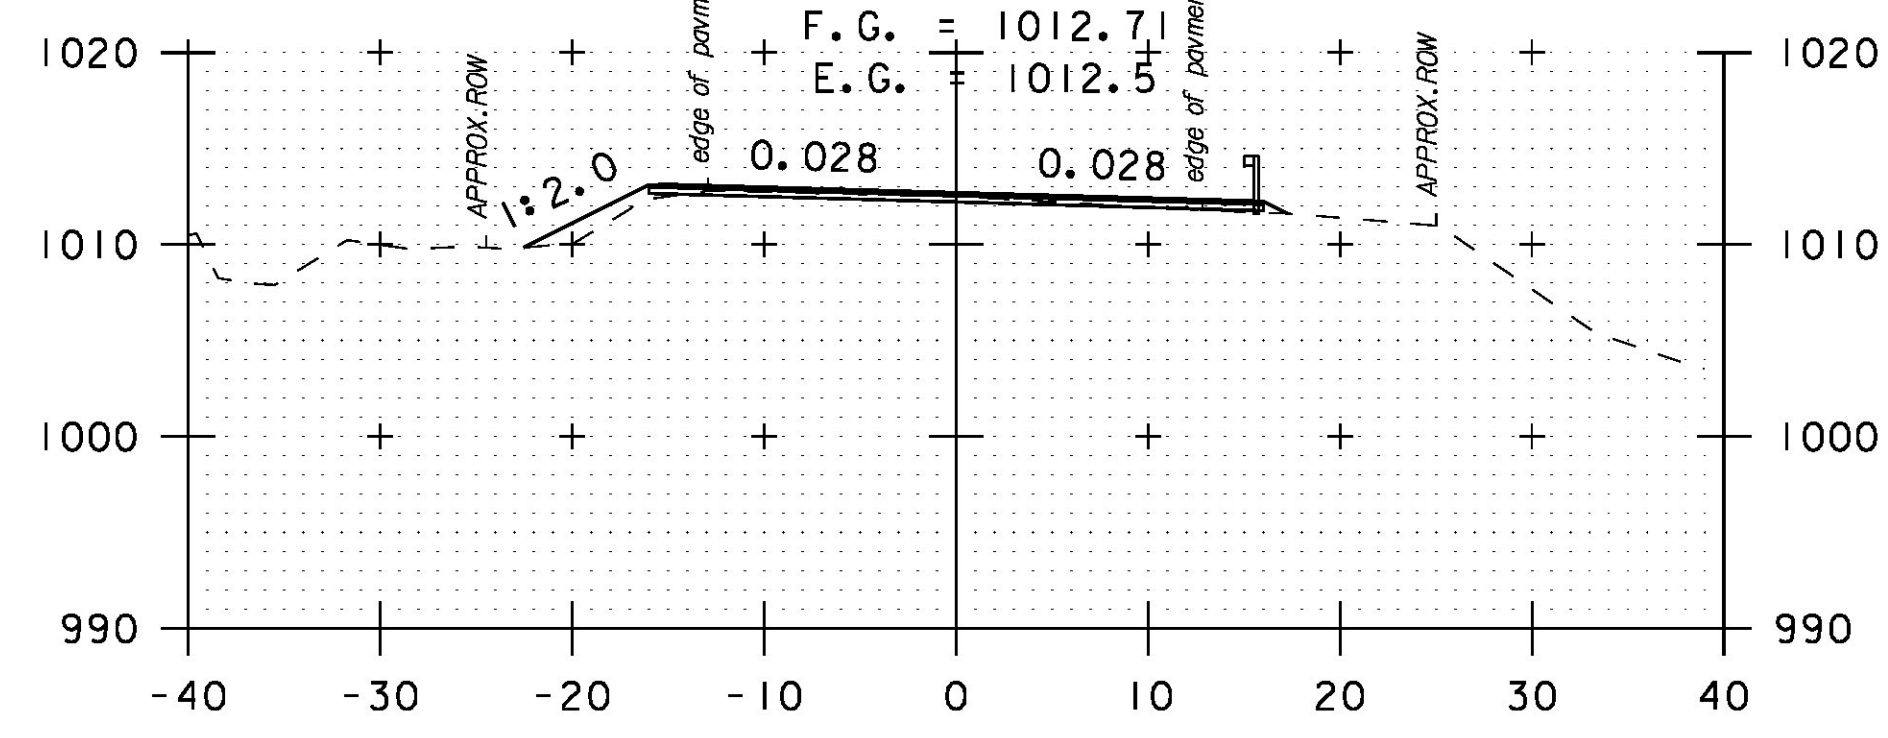

289+00

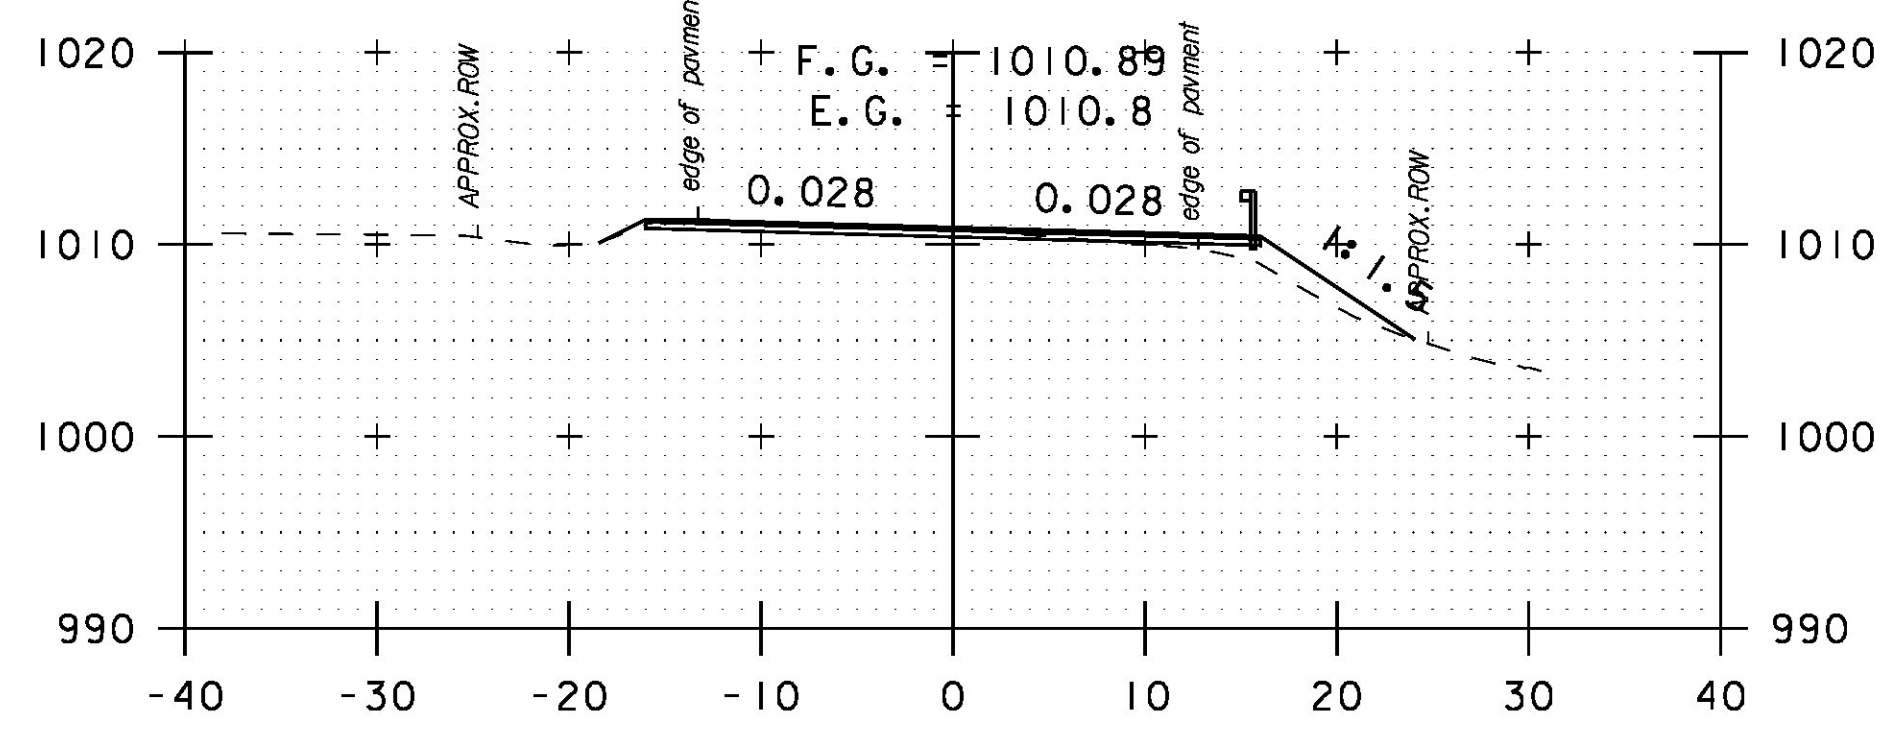

290+50

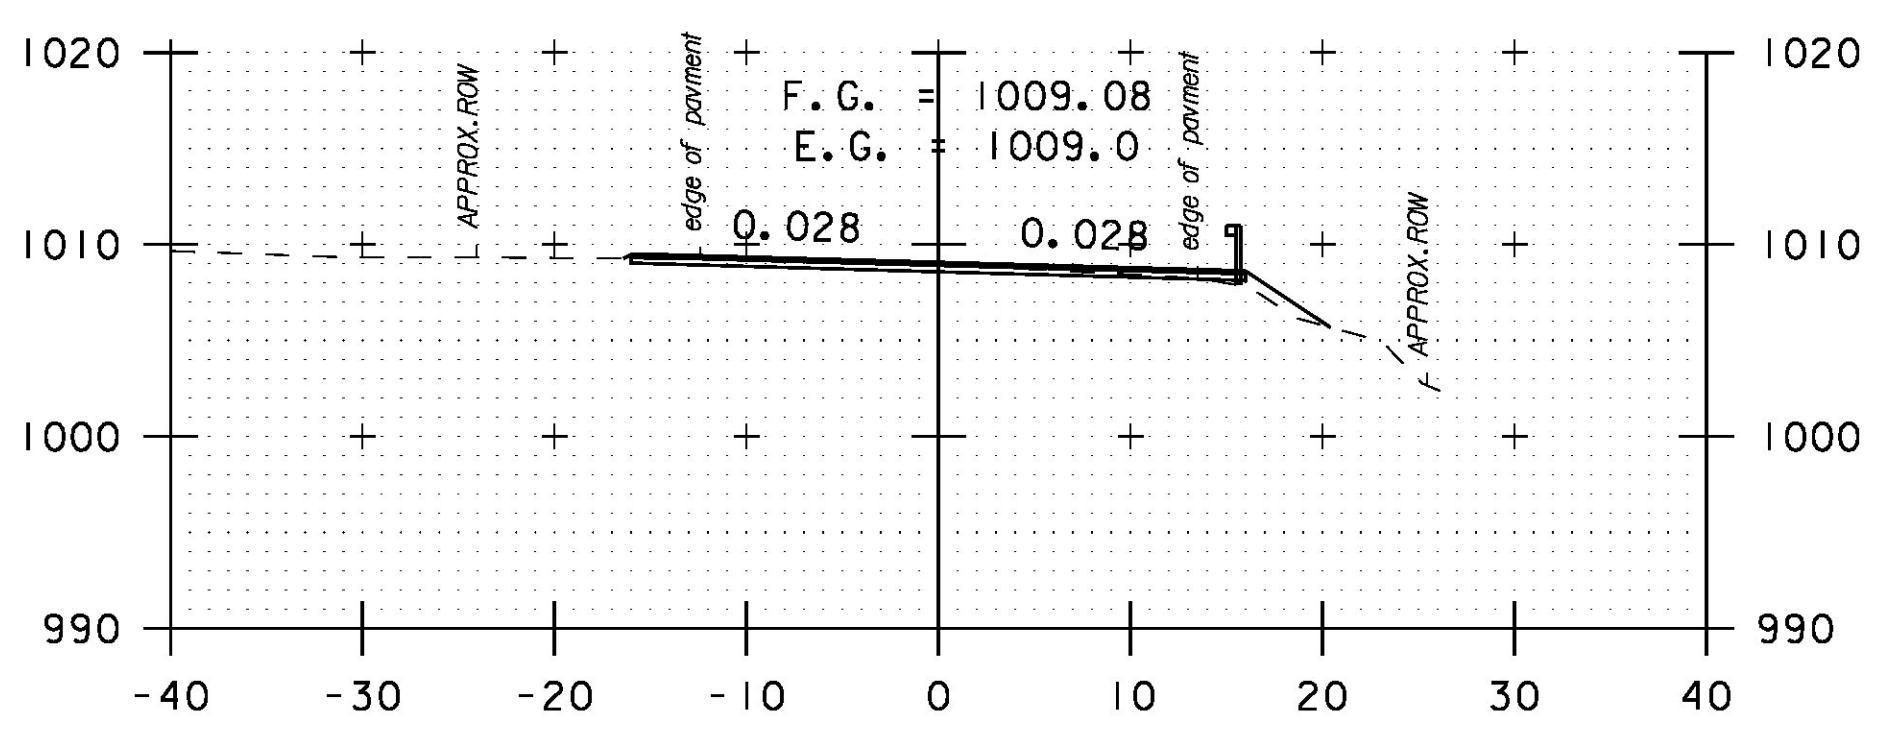

292+00

DRIVE LT



PROJECT NAME: HANCOCK	PLOT DATE: 3/18/2015
PROJECT NUMBER: STP 2923 (1)	DRAWN BY: B. MARTIN
FILE NAME: z10c252xs.dgn	CHECKED BY: C. LATHROP
PROJECT LEADER: C. LATHROP	SHEET 182 OF 207
DESIGNED BY: B. MARTIN	
CROSS SECTION SHEET 55	