


19

STA. 305+63.88 RT 26.13' TO
STA. 305+63.91 LT 23.87'
ASKEW ANGLE = 89.8494° RT
REMOVE EXISTING PIPE
INSTALL 18" CPEP (50'-0")
INV. IN = 992.05'
INV. OUT = 991.74'

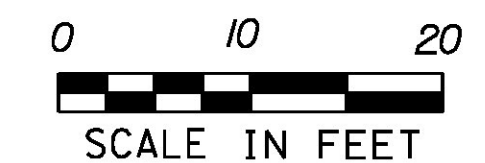

PROJECT NAME: HANCOCK	PLOT DATE: 3/18/2015
PROJECT NUMBER: STP 2923 (1)	DRAWN BY: B. MARTIN
FILE NAME: z10c252xs.dgn	CHECKED BY: C. LATHROP
PROJECT LEADER: C. LATHROP	SHEET 185 OF 207
DESIGNED BY: B. MARTIN	
CROSS SECTION SHEET 58	