




308+50

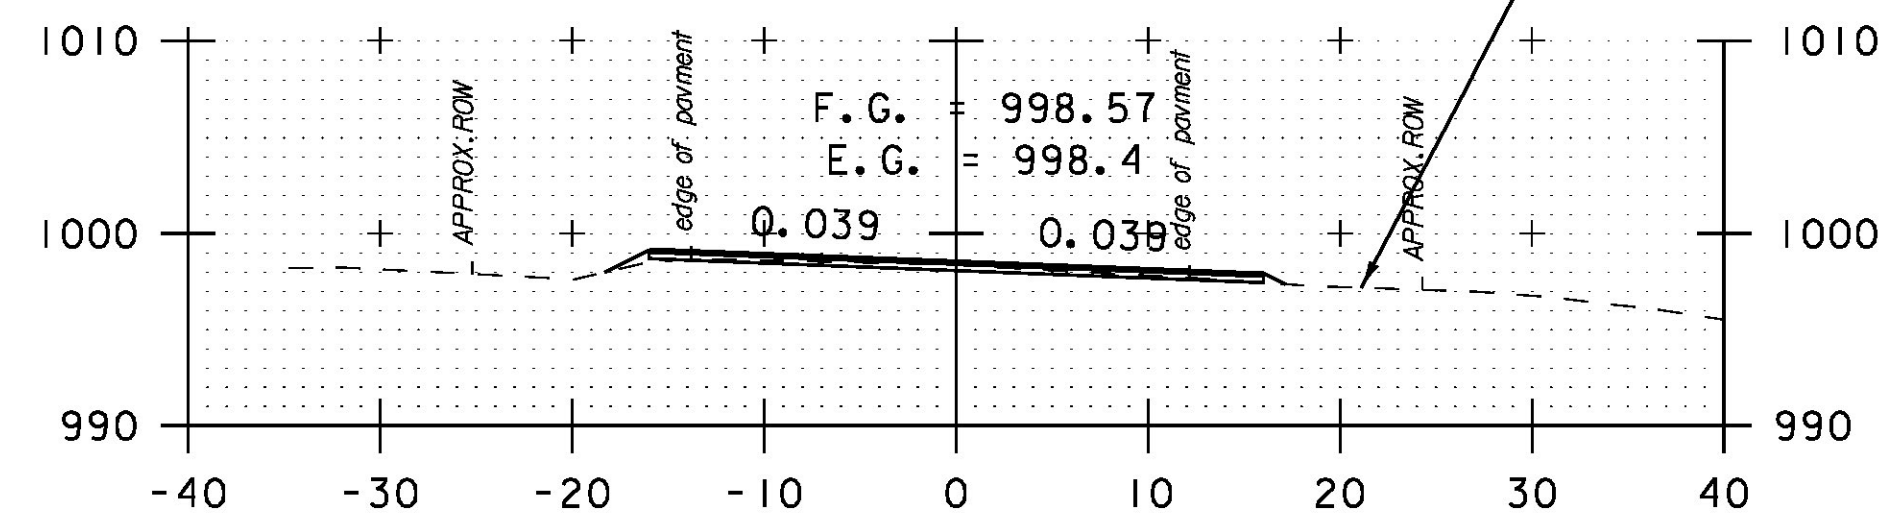


308+00

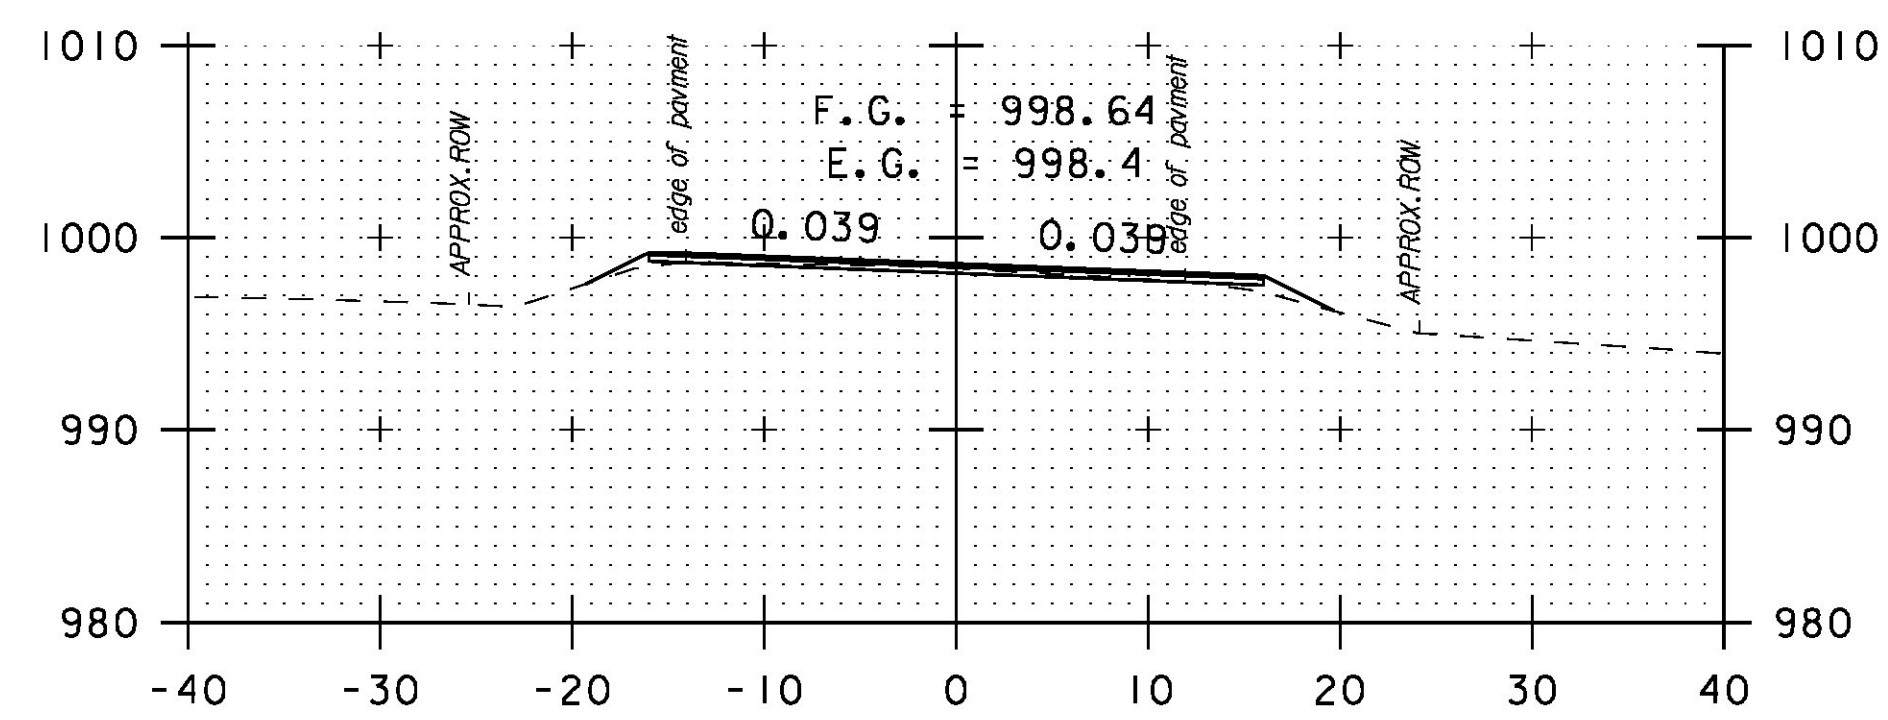


307+50

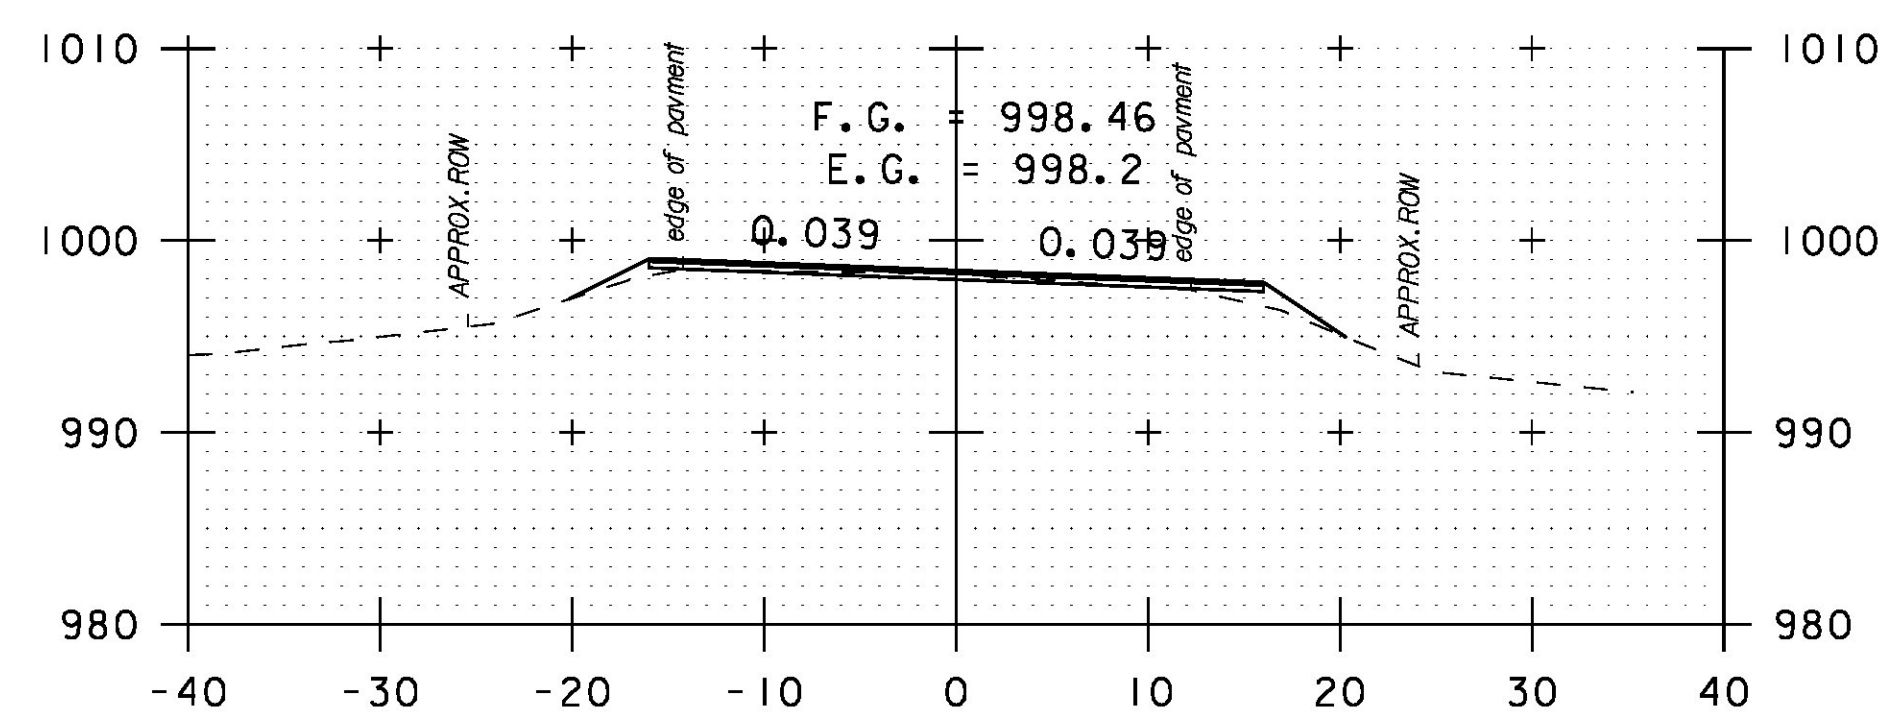


307+00

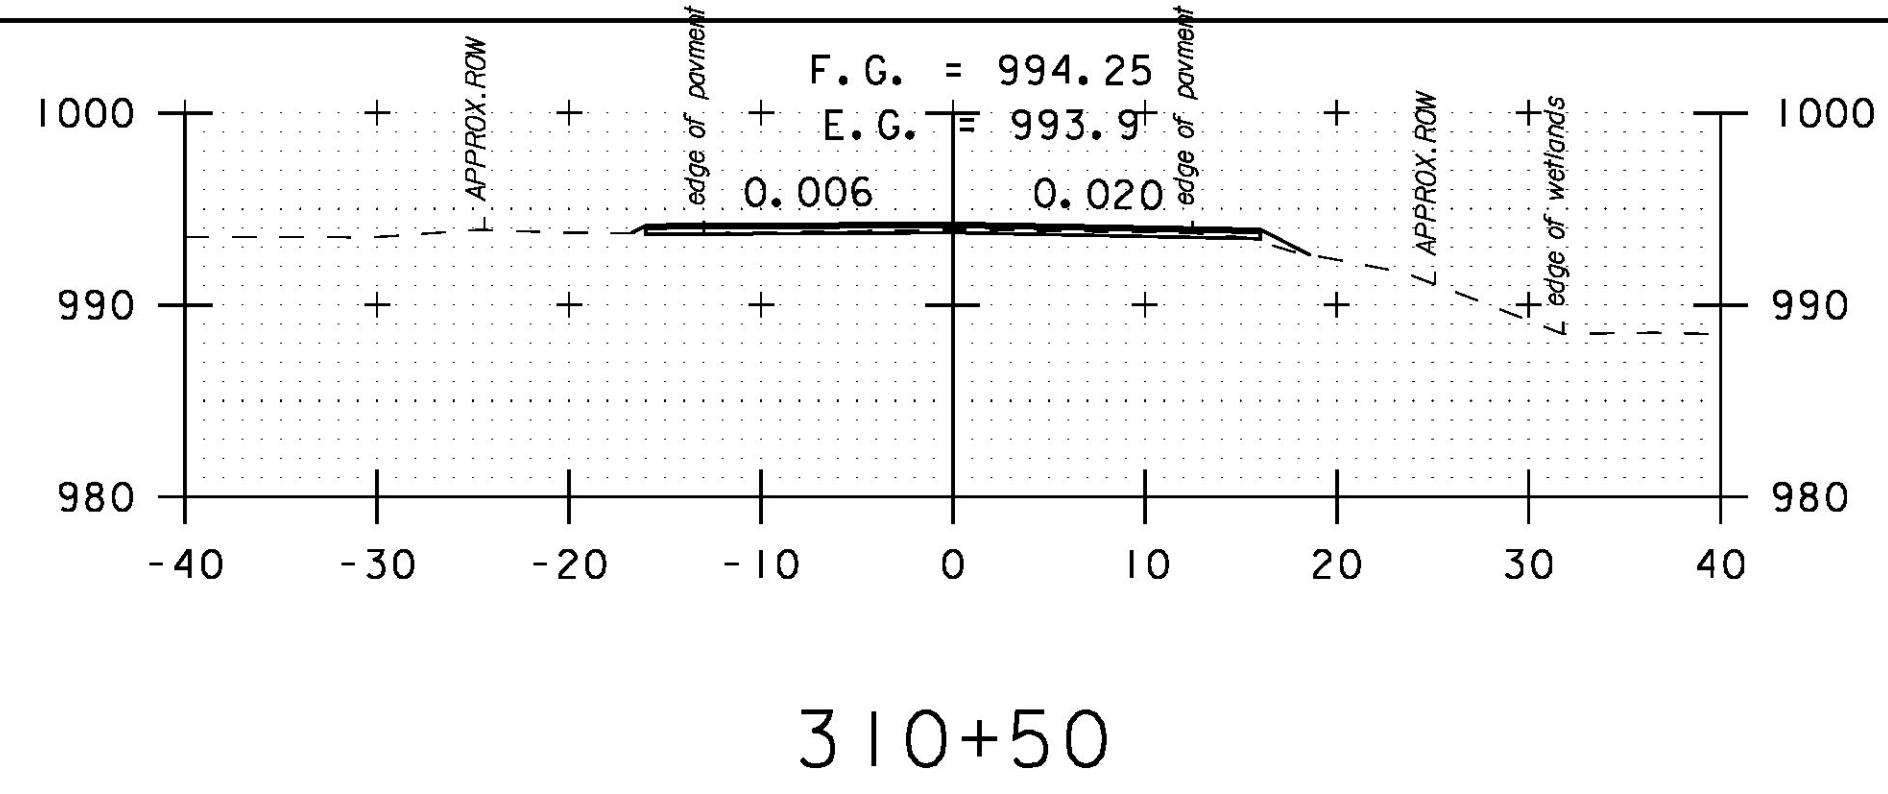


310+50

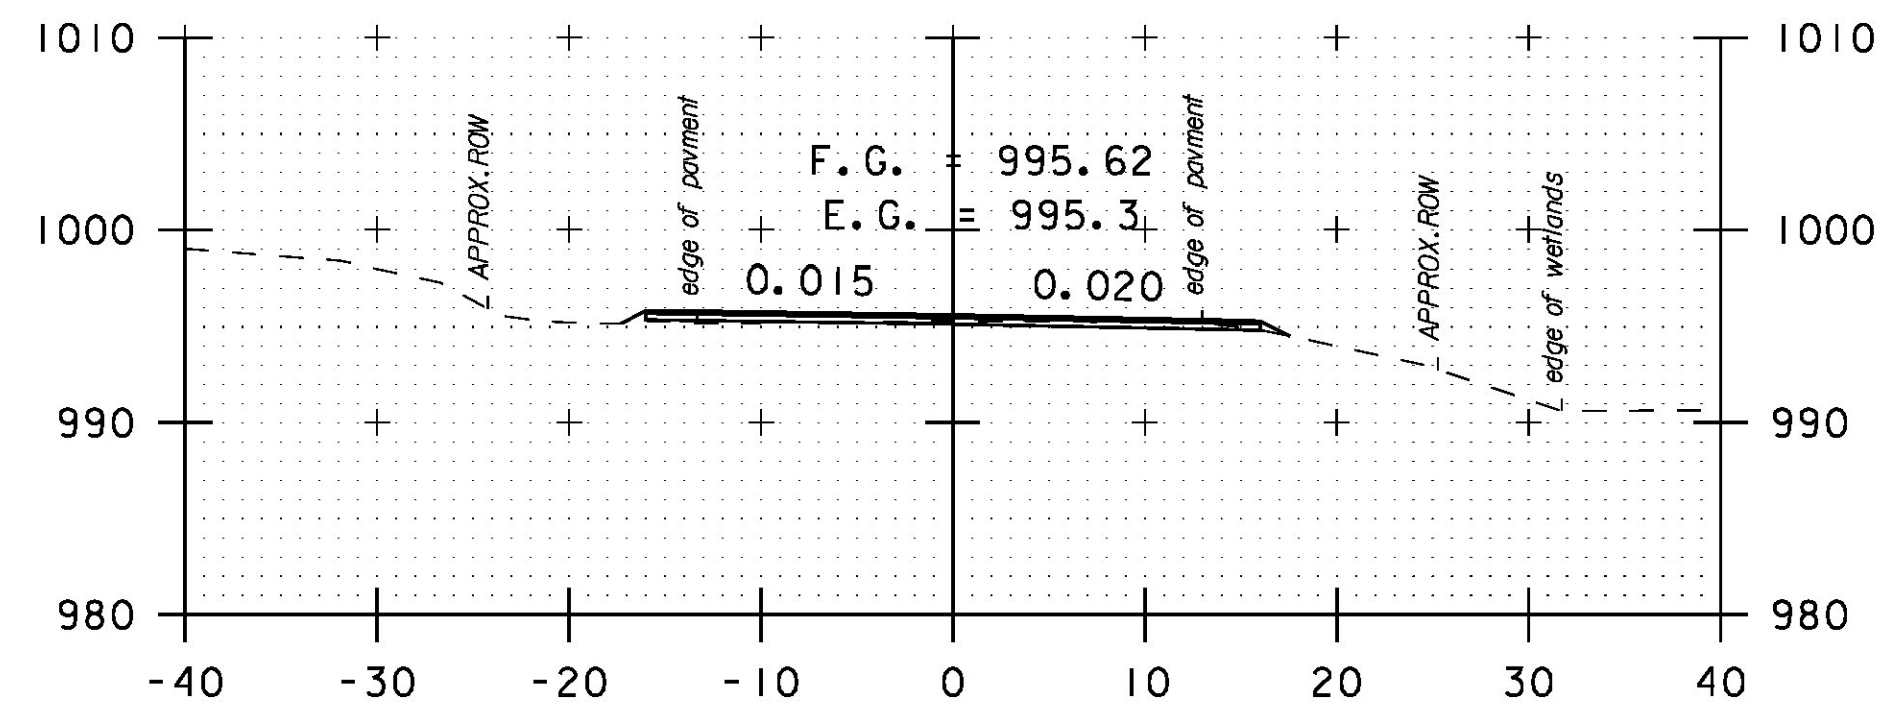


310+00

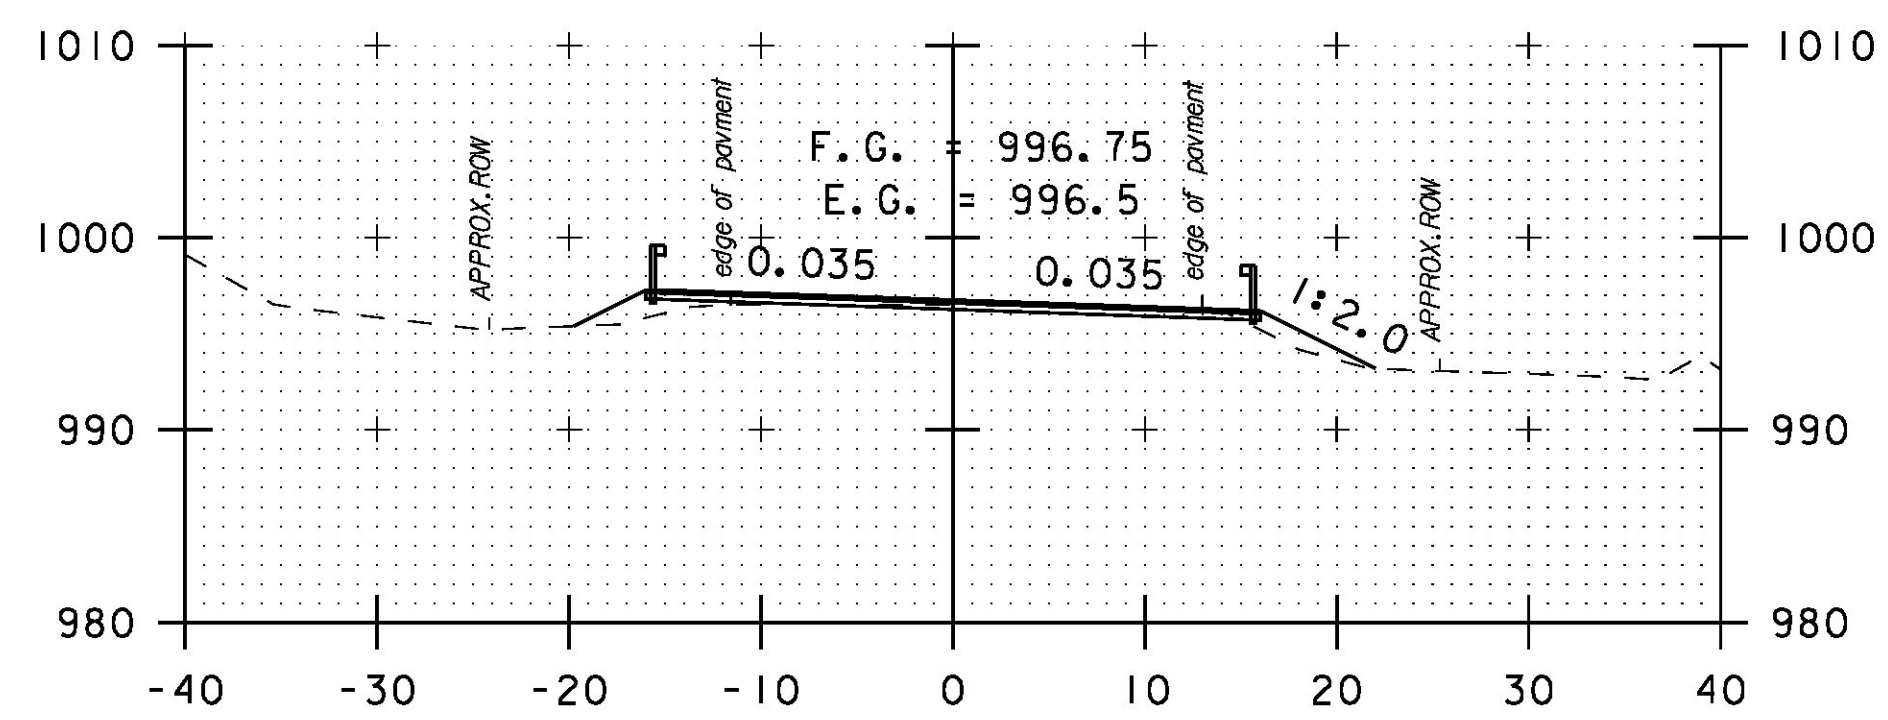


309+50

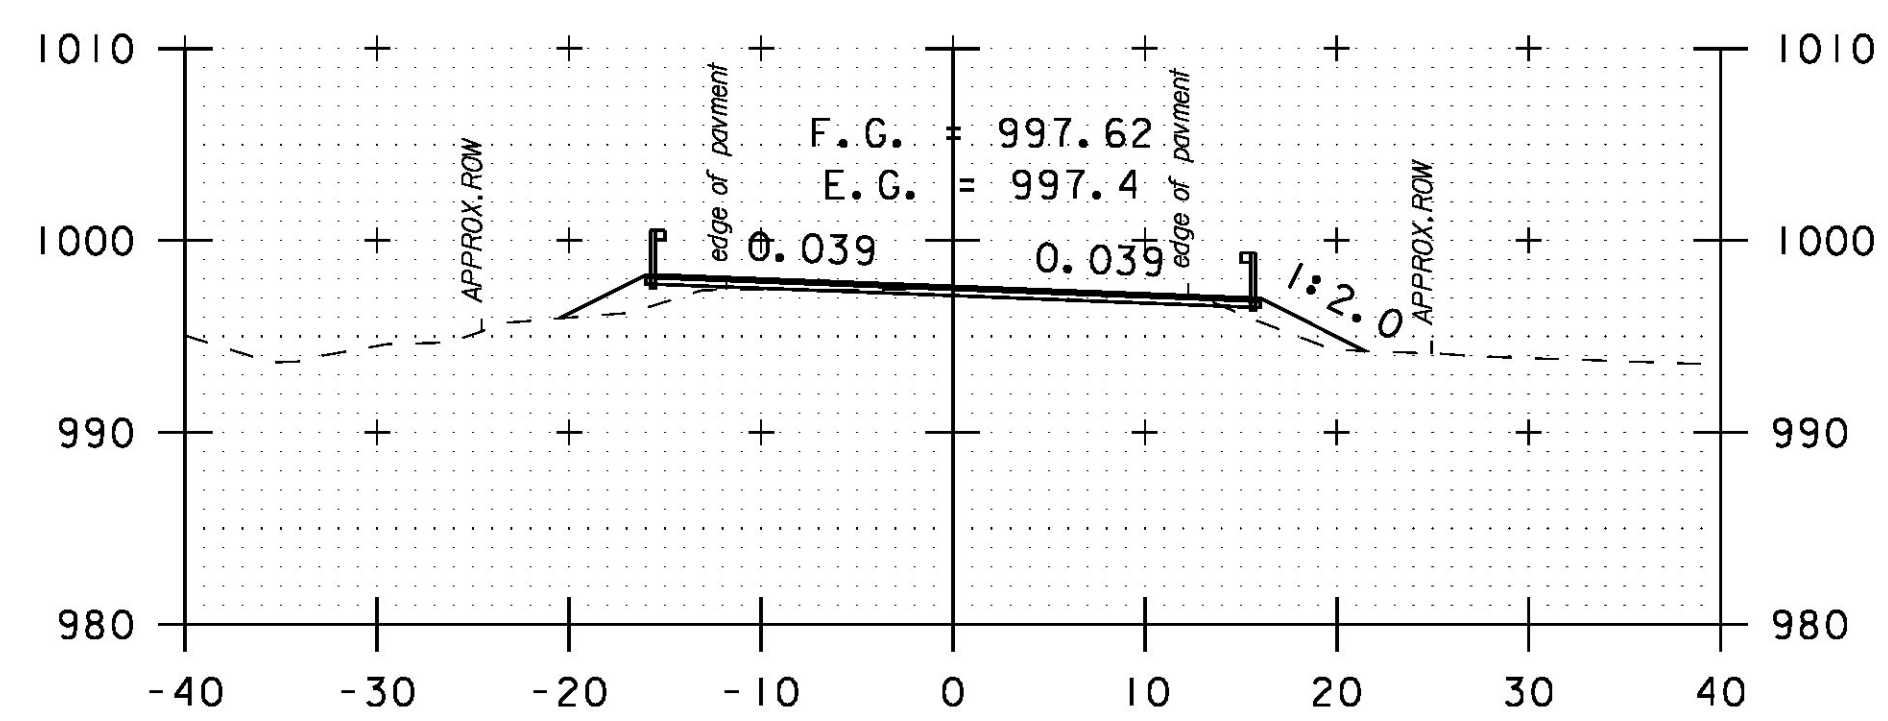


309+00

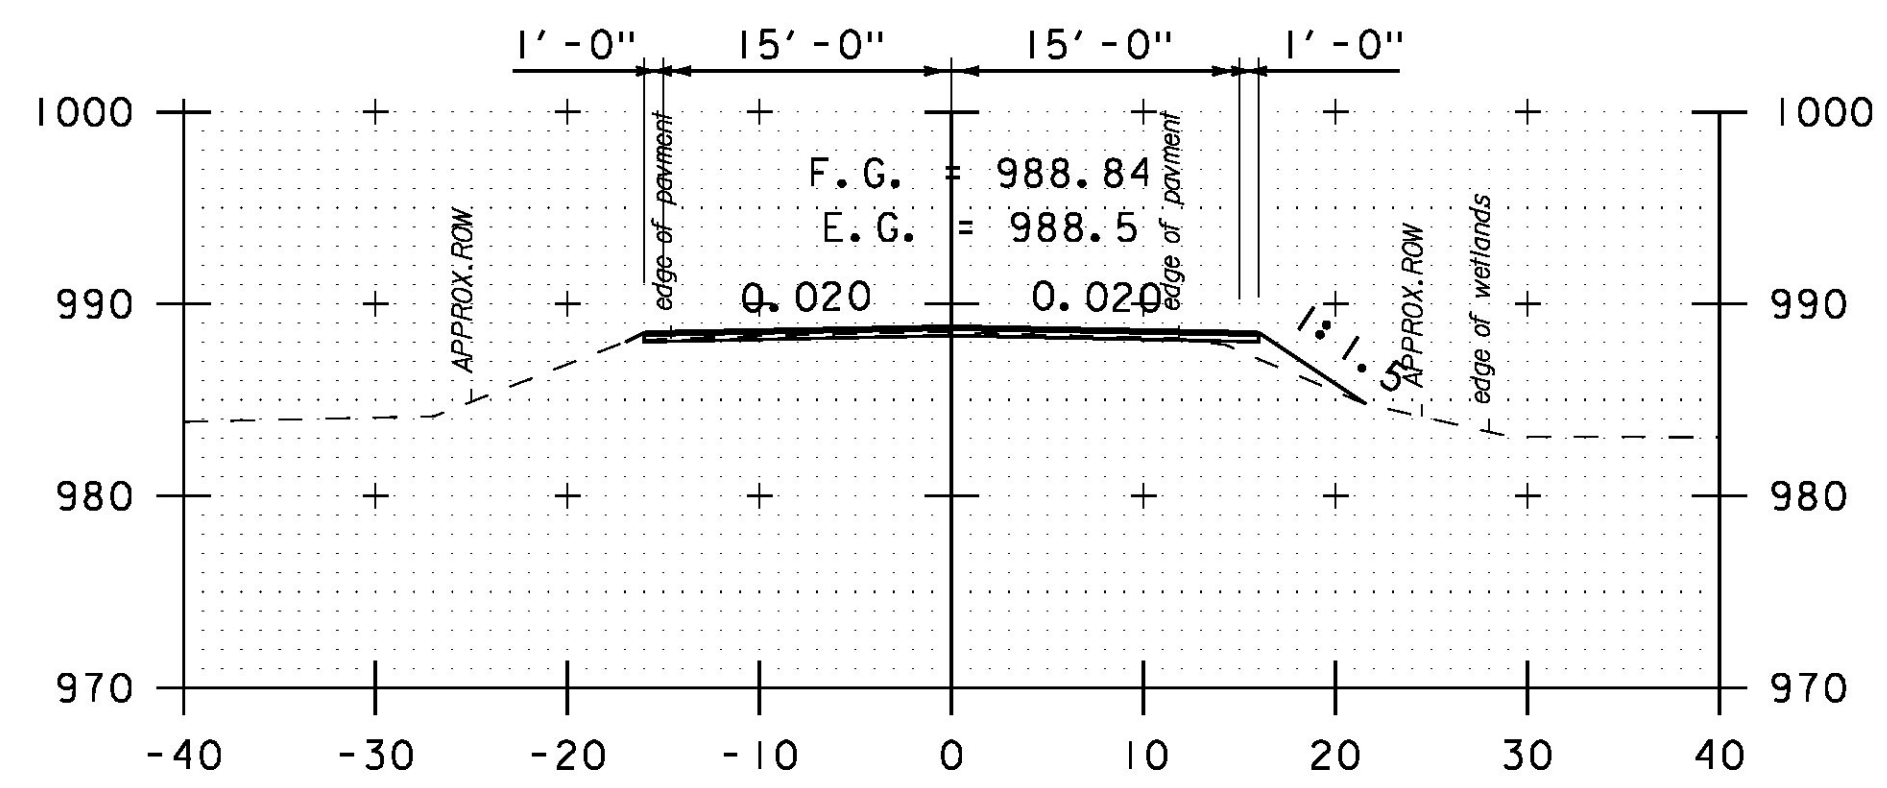


312+50

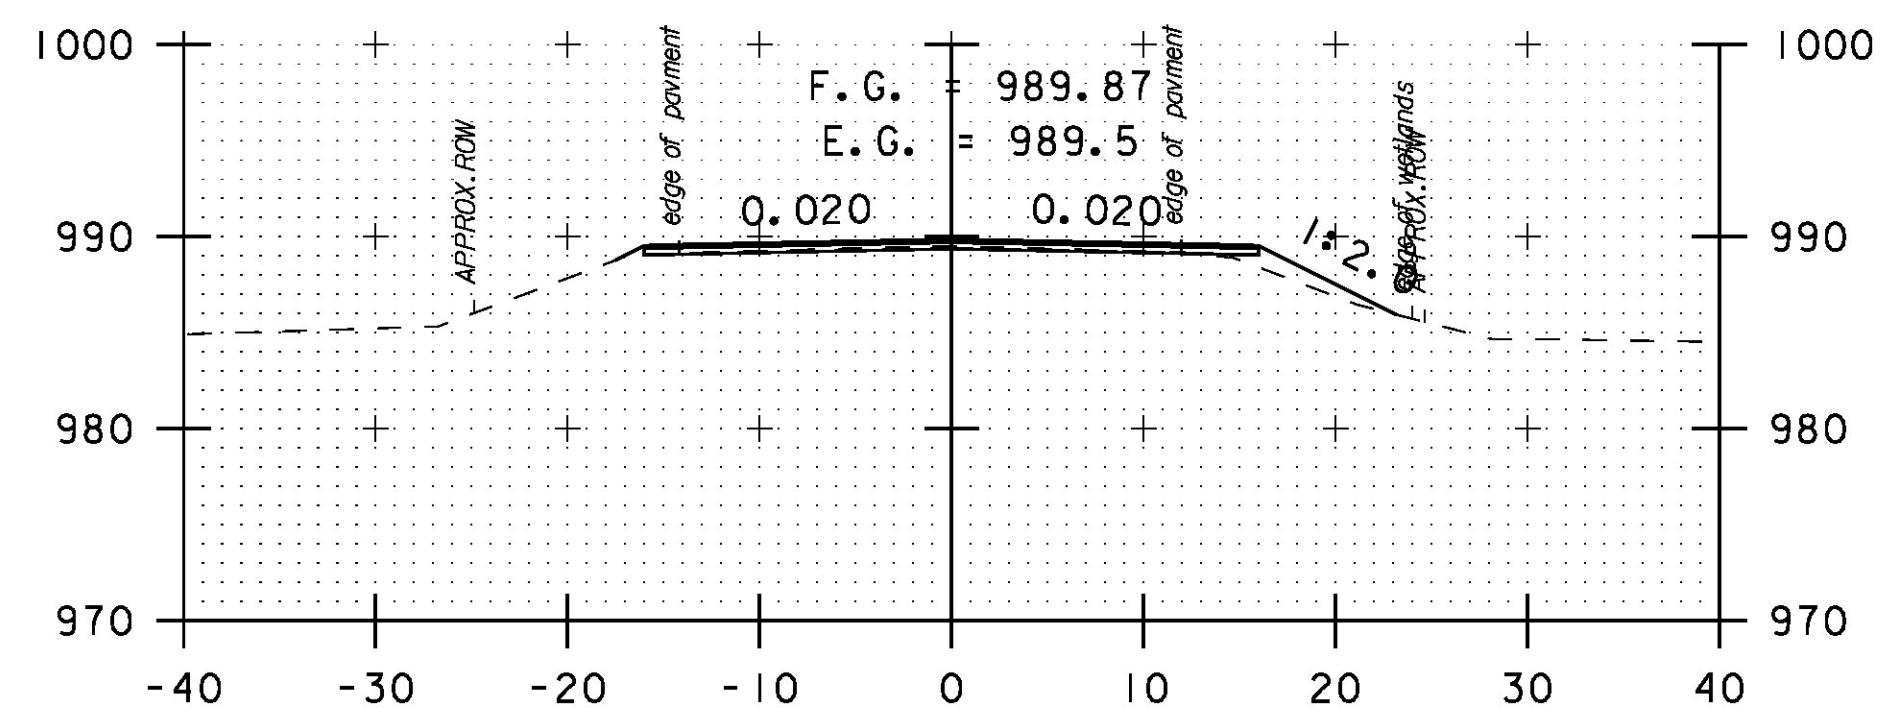

312+00

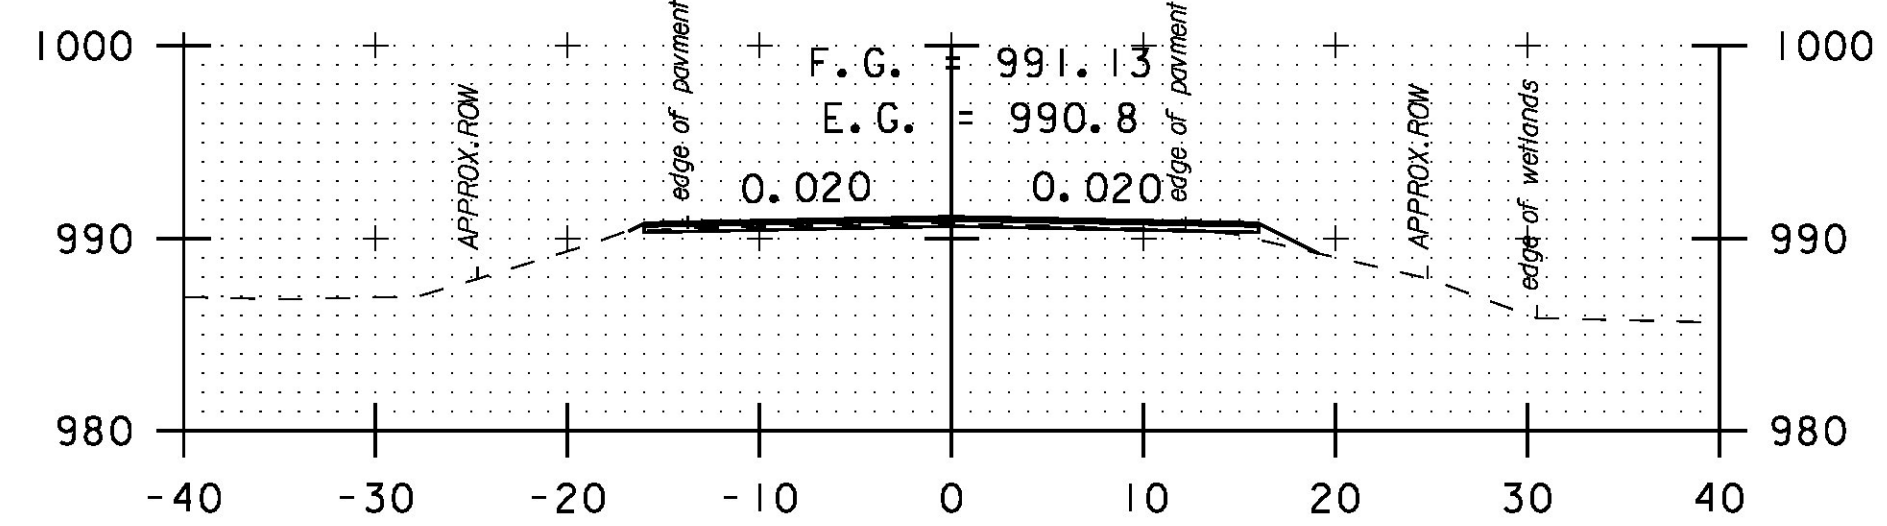

311+50

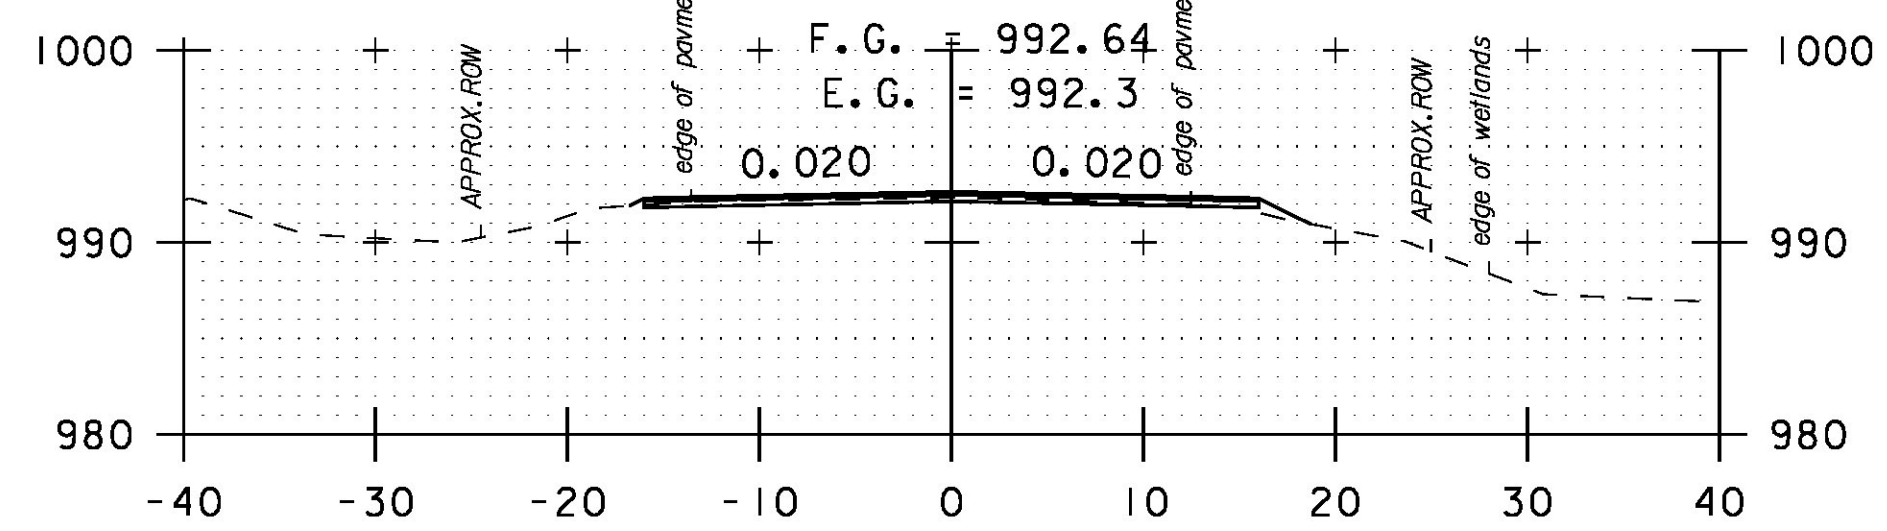

311+00

EXISTING GROUND (TYP.)



SCALE IN FEET

PROJECT NAME: HANCOCK
PROJECT NUMBER: STP 2923 (1)

FILE NAME: z10c252xs.dgn
PROJECT LEADER: C. LATHROP
DESIGNED BY: B. MARTIN
CROSS SECTION SHEET 59

PLOT DATE: 3/18/2015
DRAWN BY: B. MARTIN
CHECKED BY: C. LATHROP
SHEET 186 OF 207