




313+50

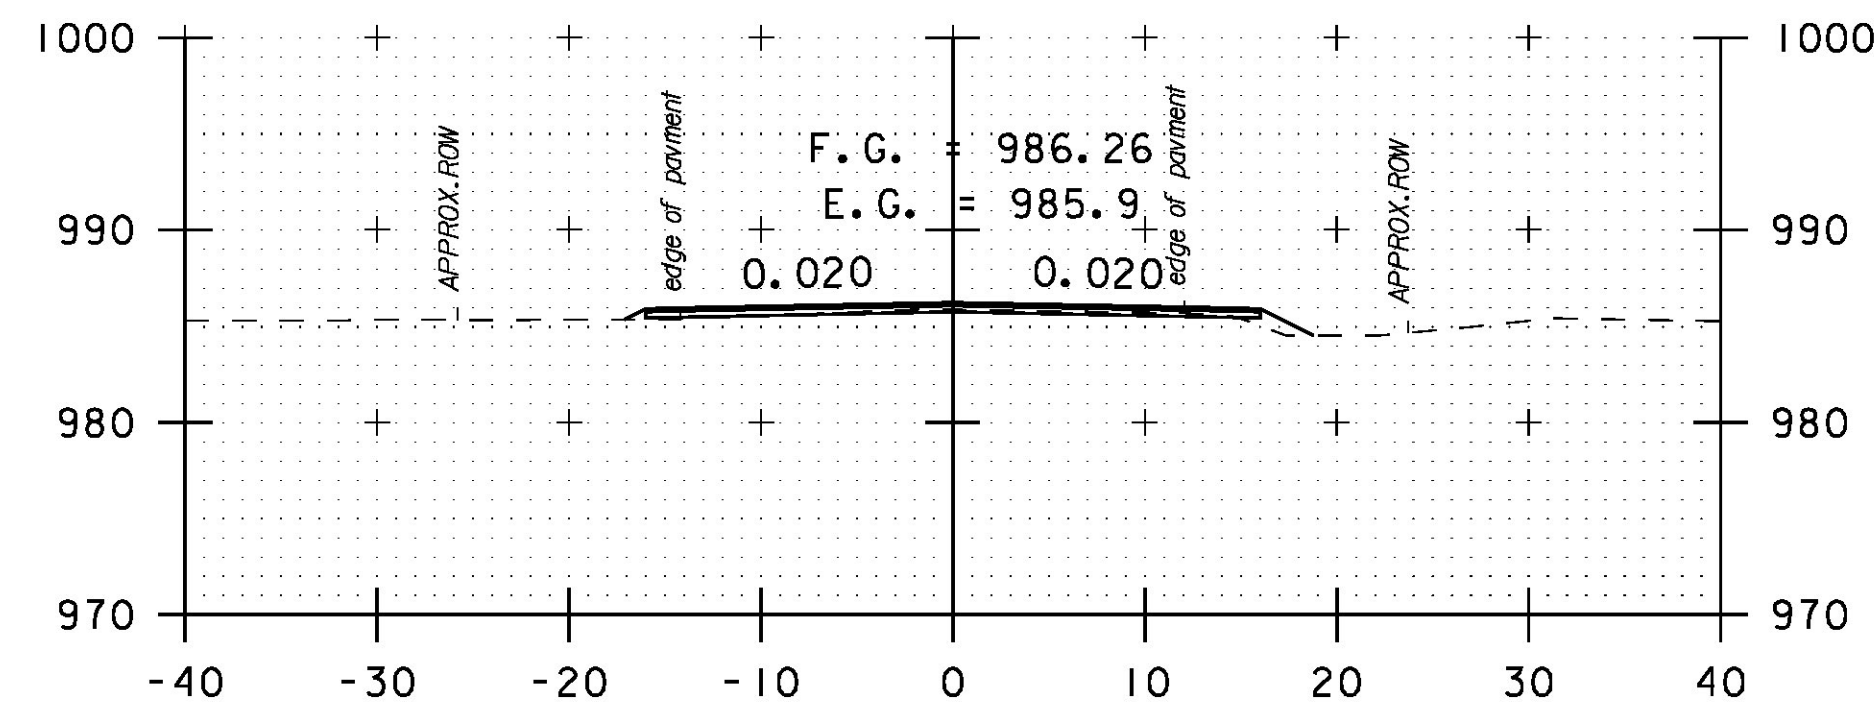


315+00
DRIVE LT

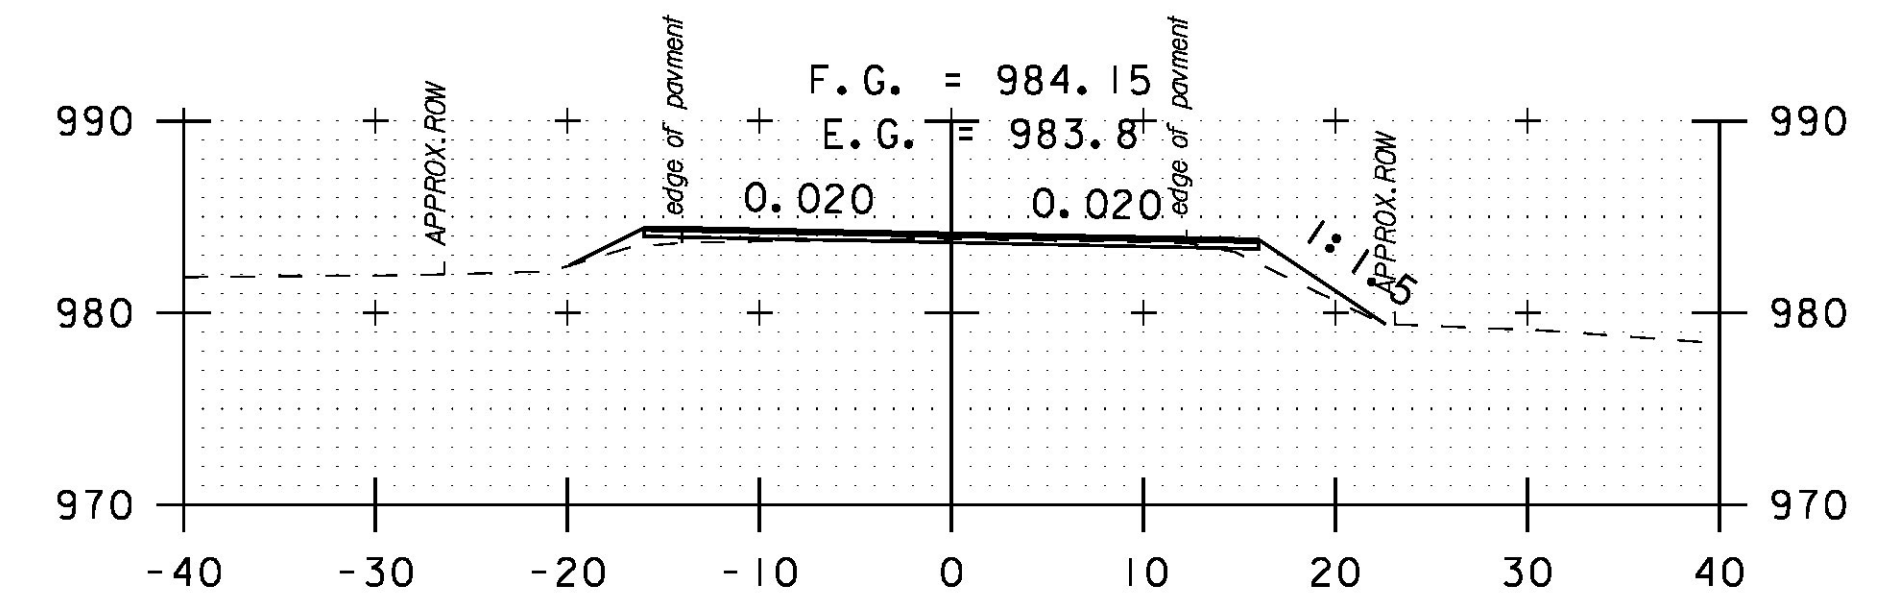


317+00

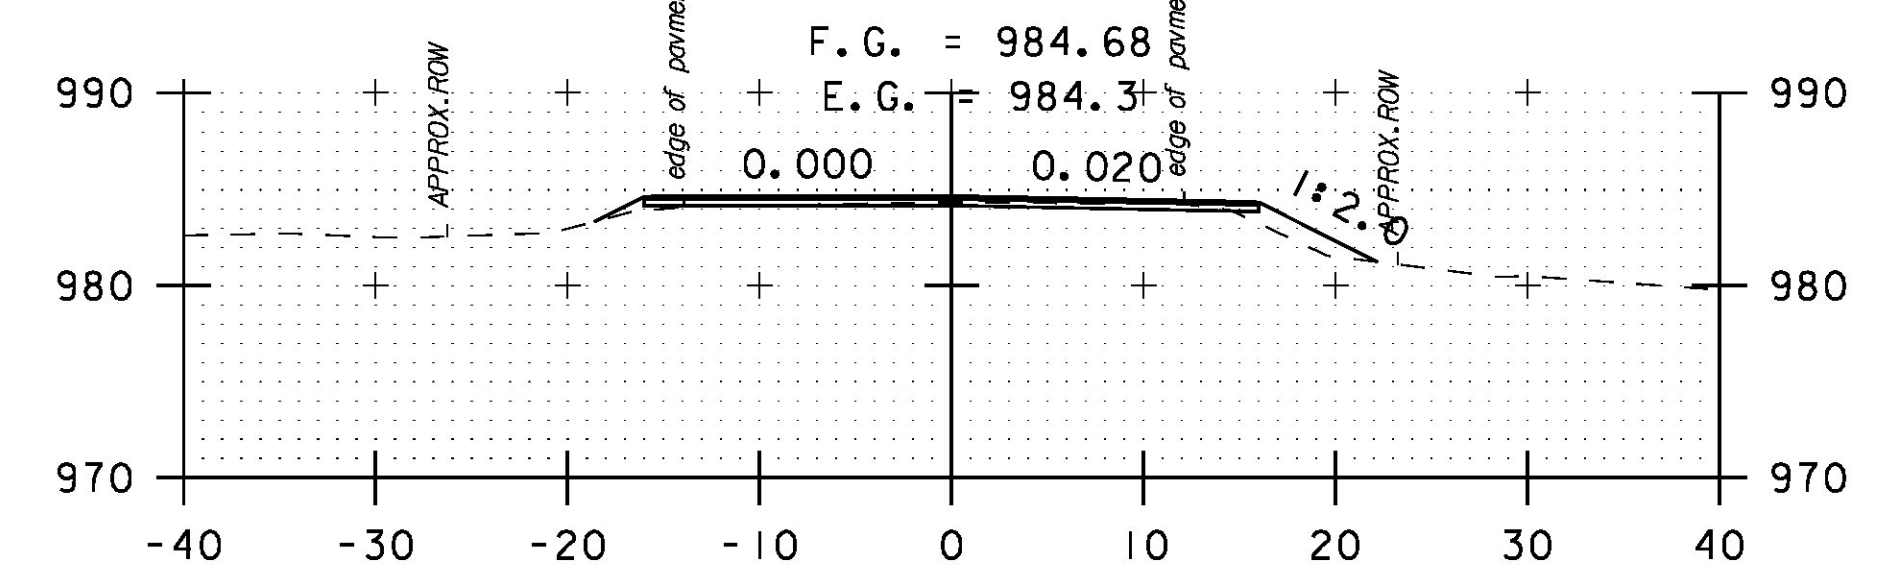


316+50

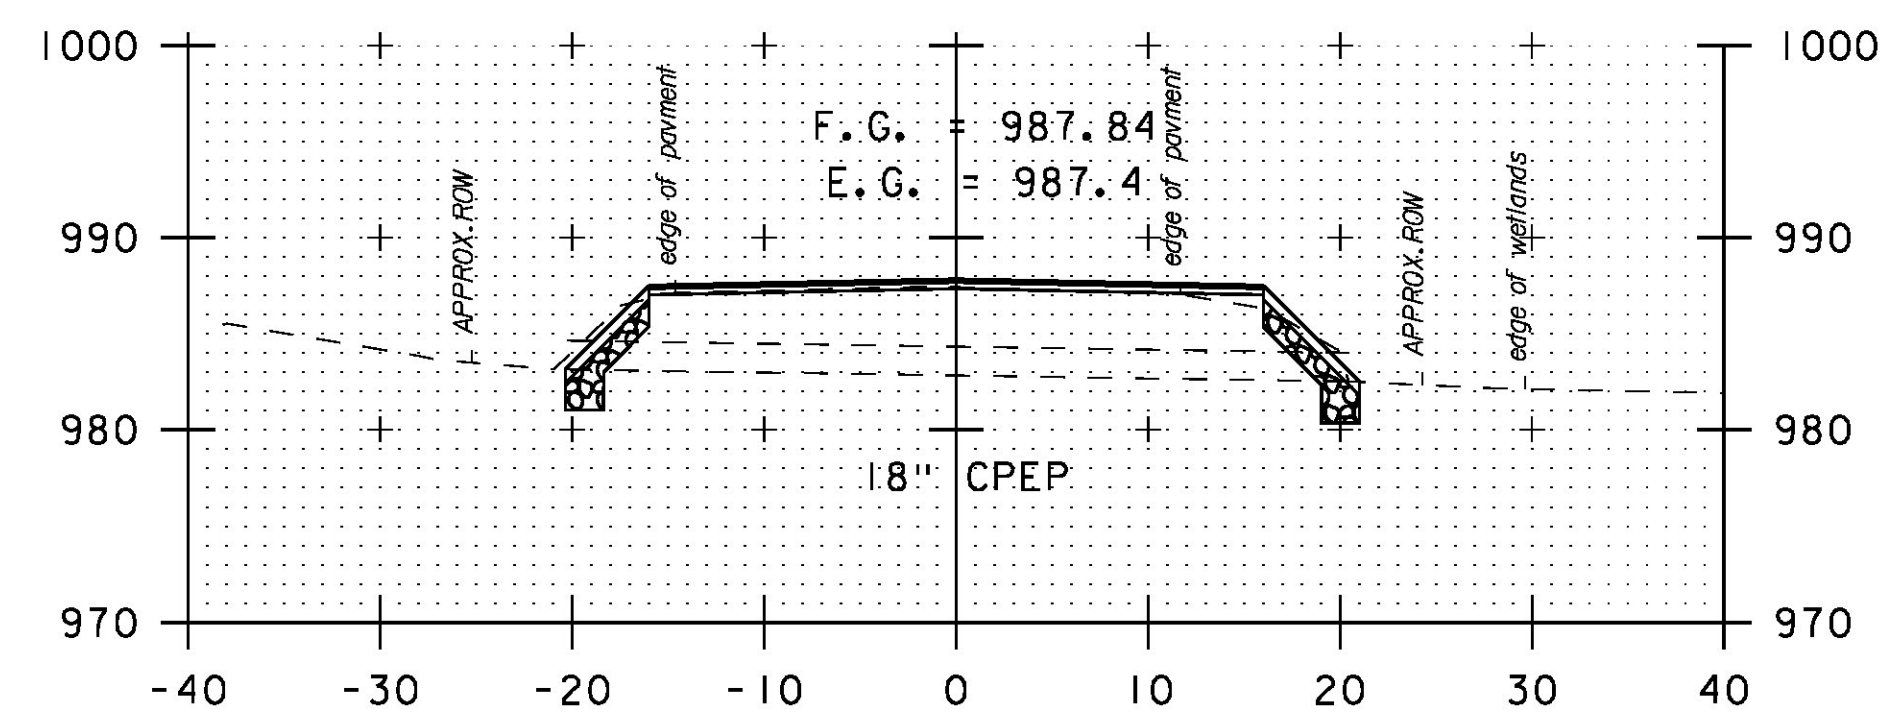


313+17
SKEWED

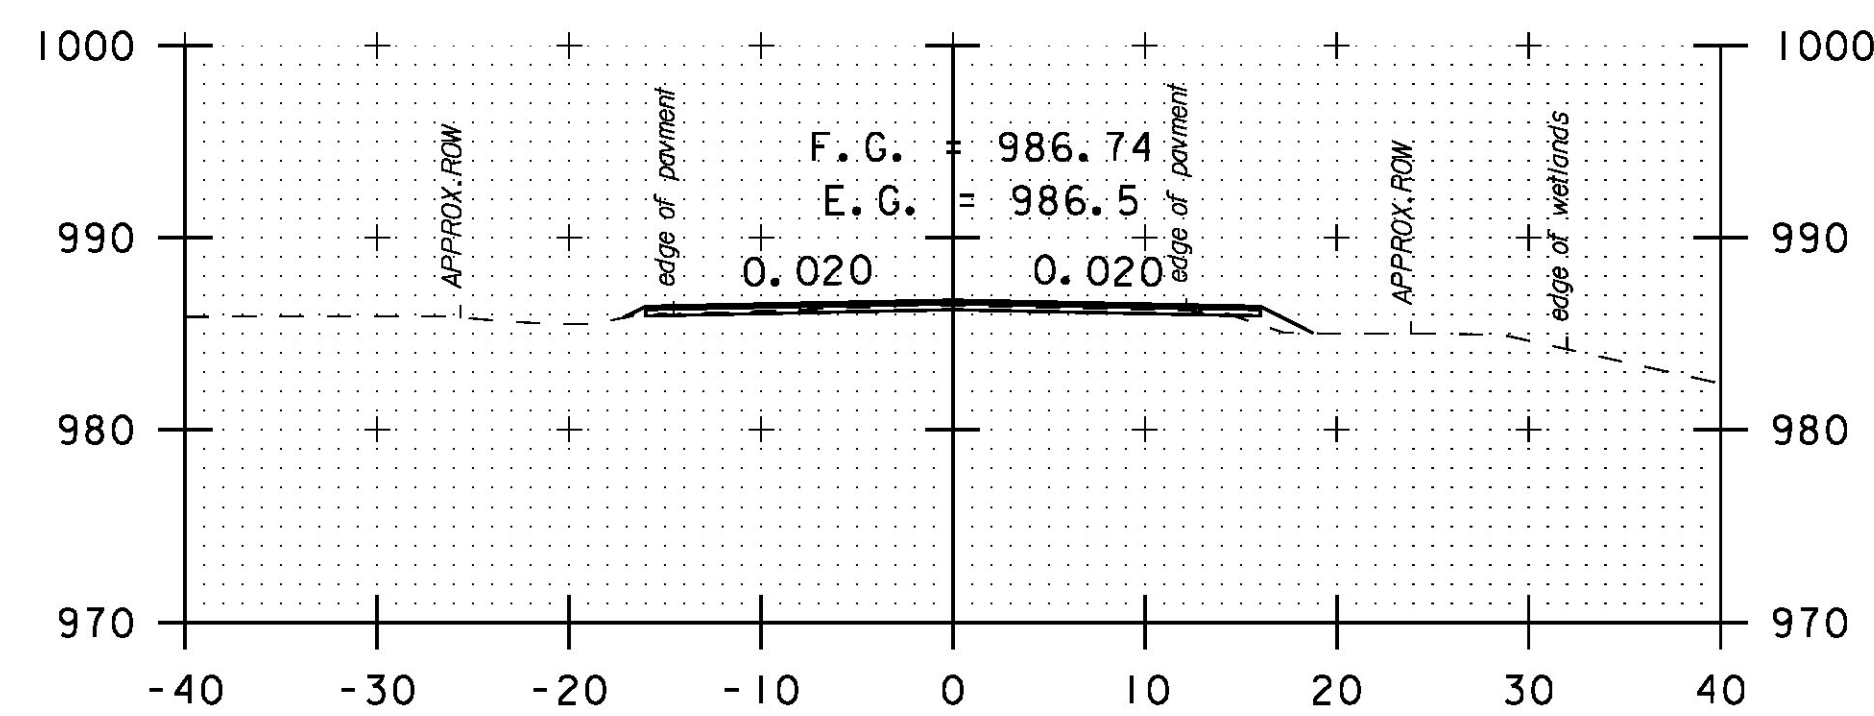


314+50

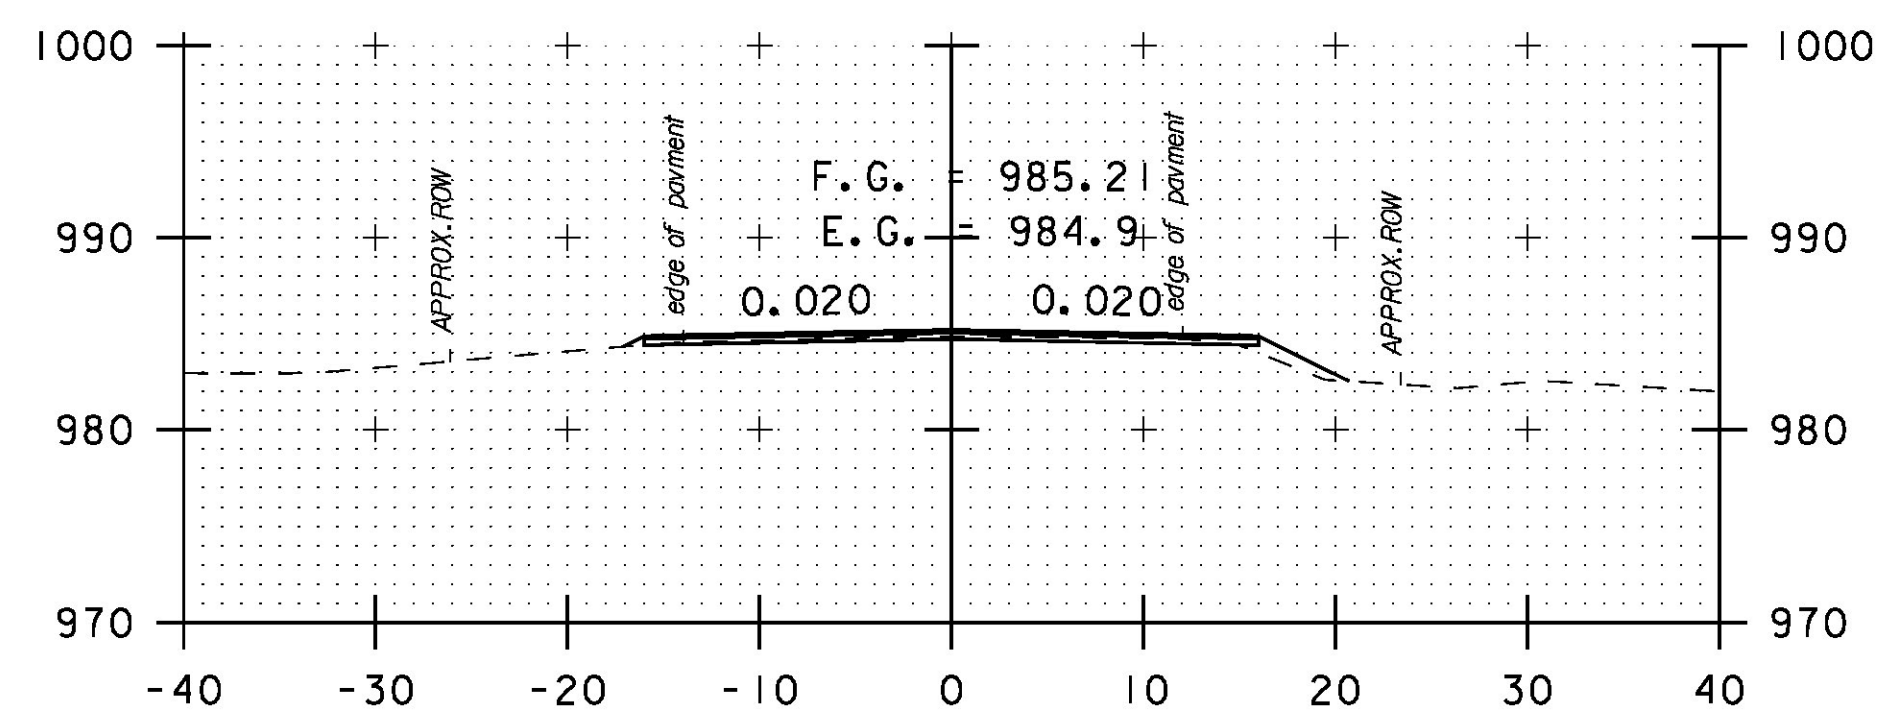


316+00

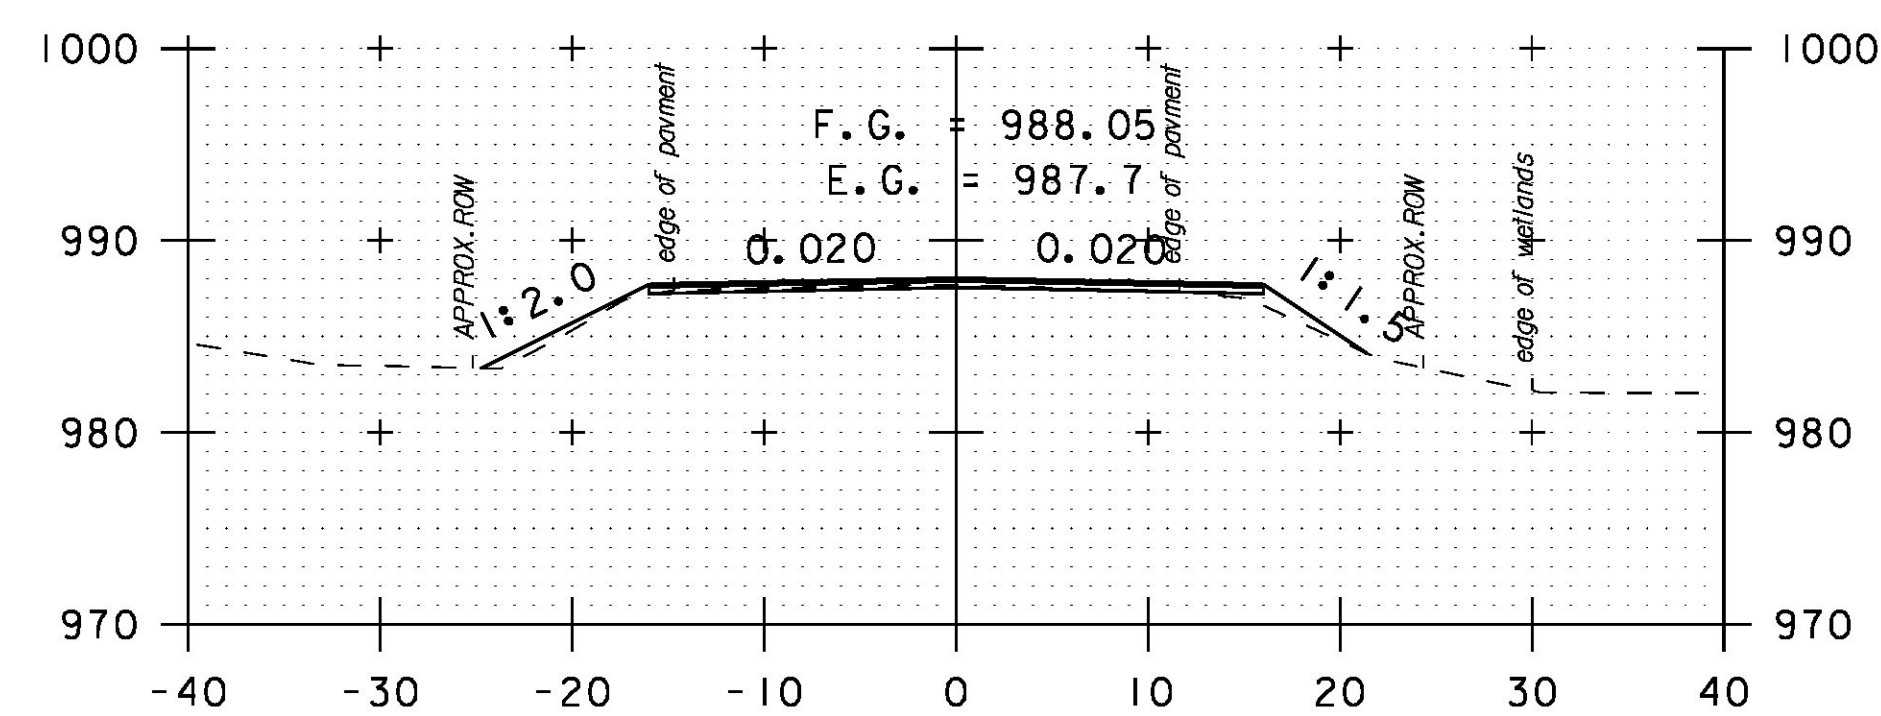


313+00

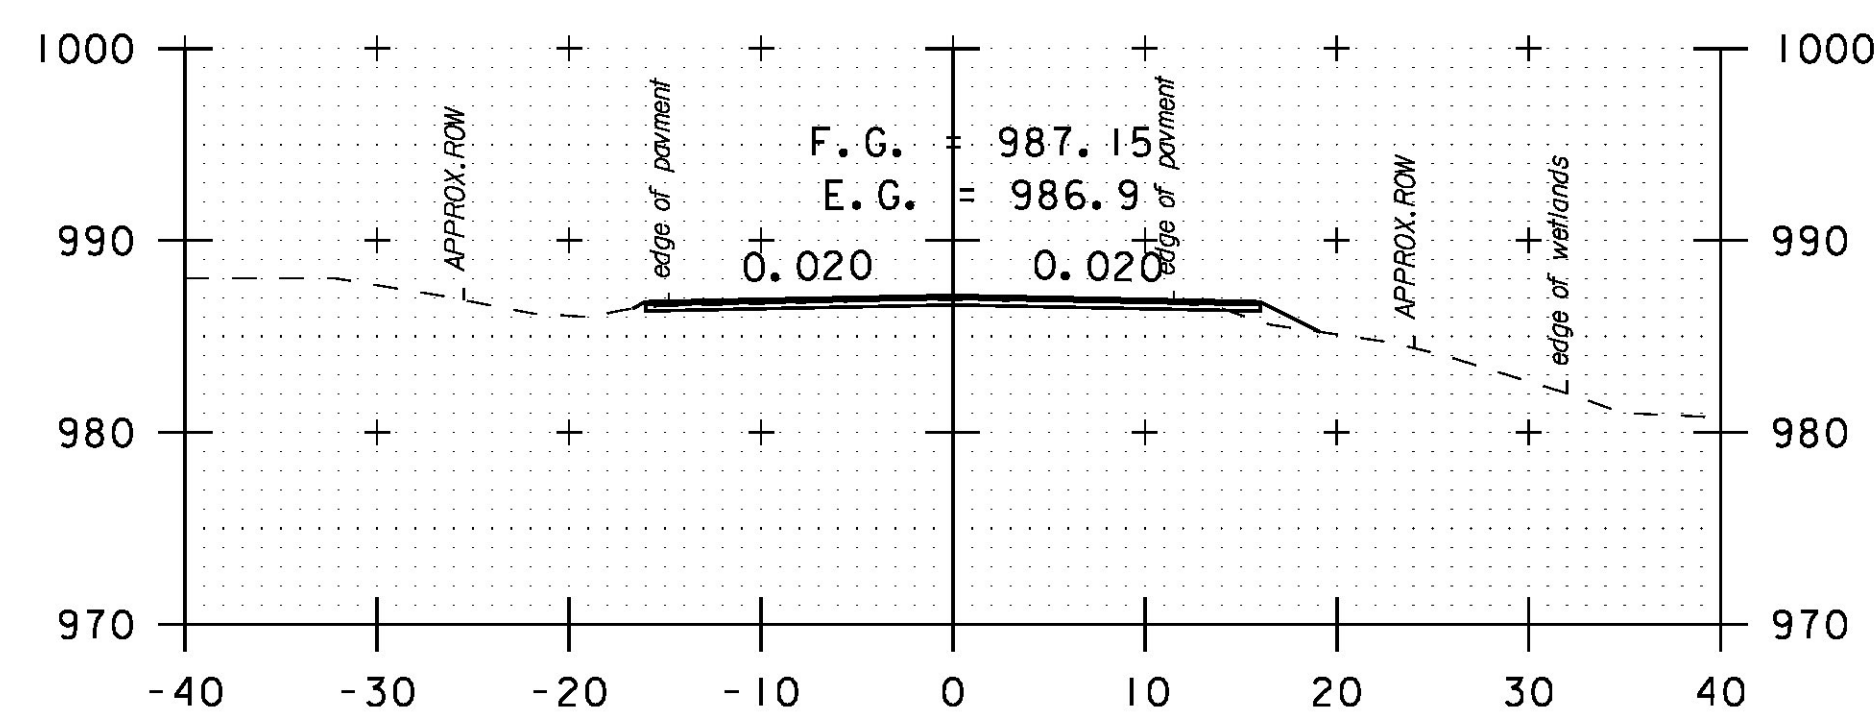

314+00

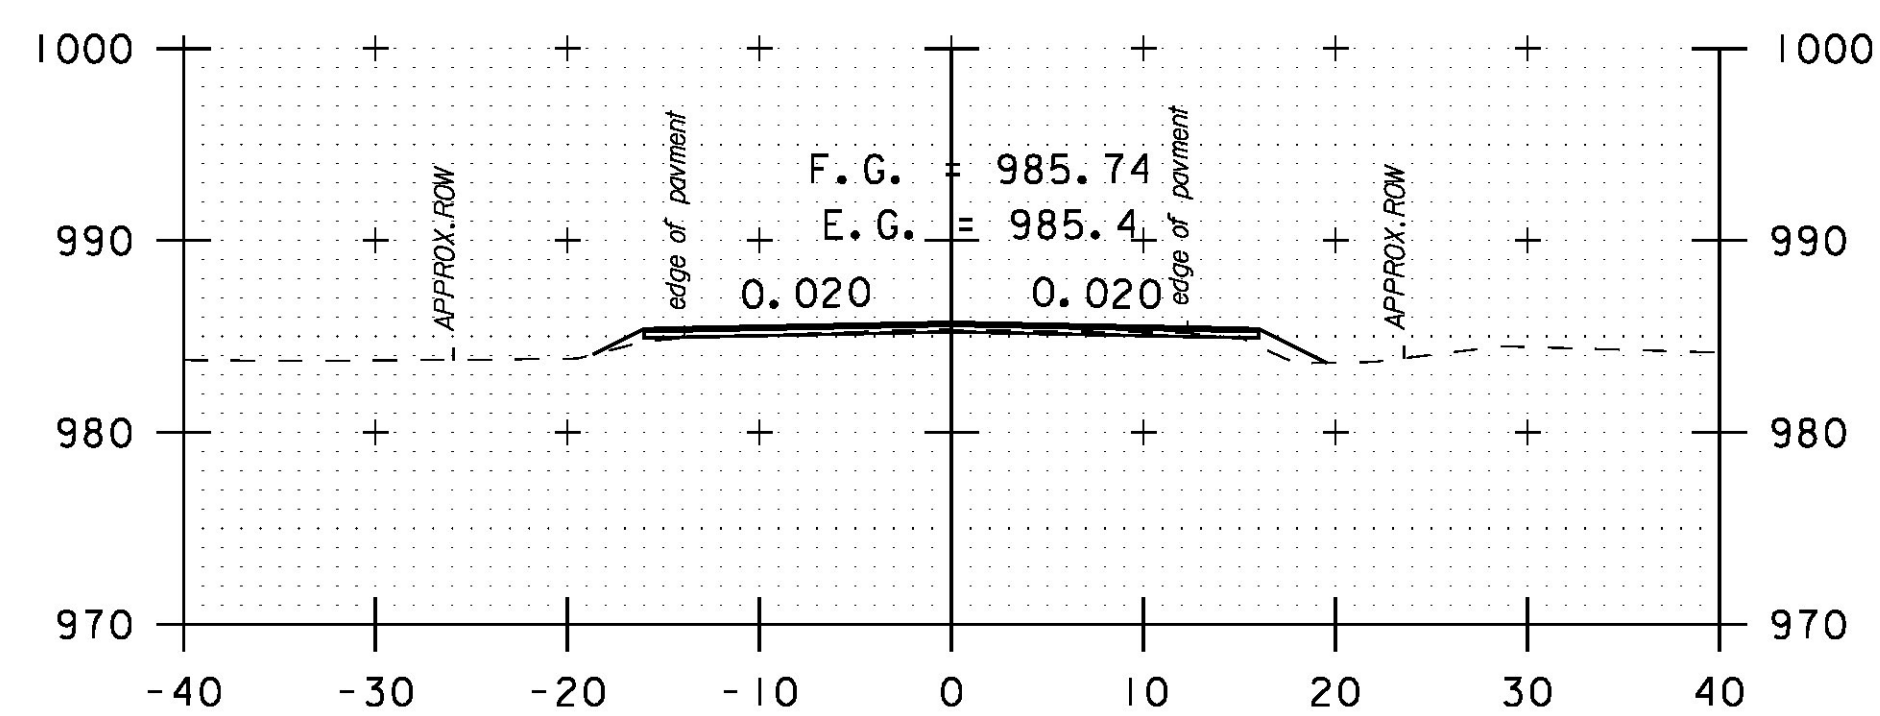

315+50

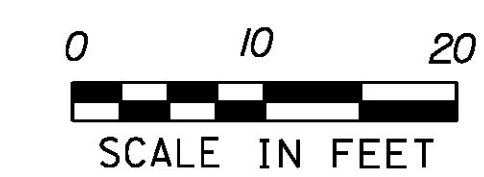

PROJECT NAME: HANCOCK	PLOT DATE: 3/18/2015
PROJECT NUMBER: STP 2923 (1)	DRAWN BY: B. MARTIN
FILE NAME: z10c252xs.dgn	CHECKED BY: C. LATHROP
PROJECT LEADER: C. LATHROP	SHEET 187 OF 207
DESIGNED BY: B. MARTIN	
CROSS SECTION SHEET 60	