




319+00
TH #5 LT

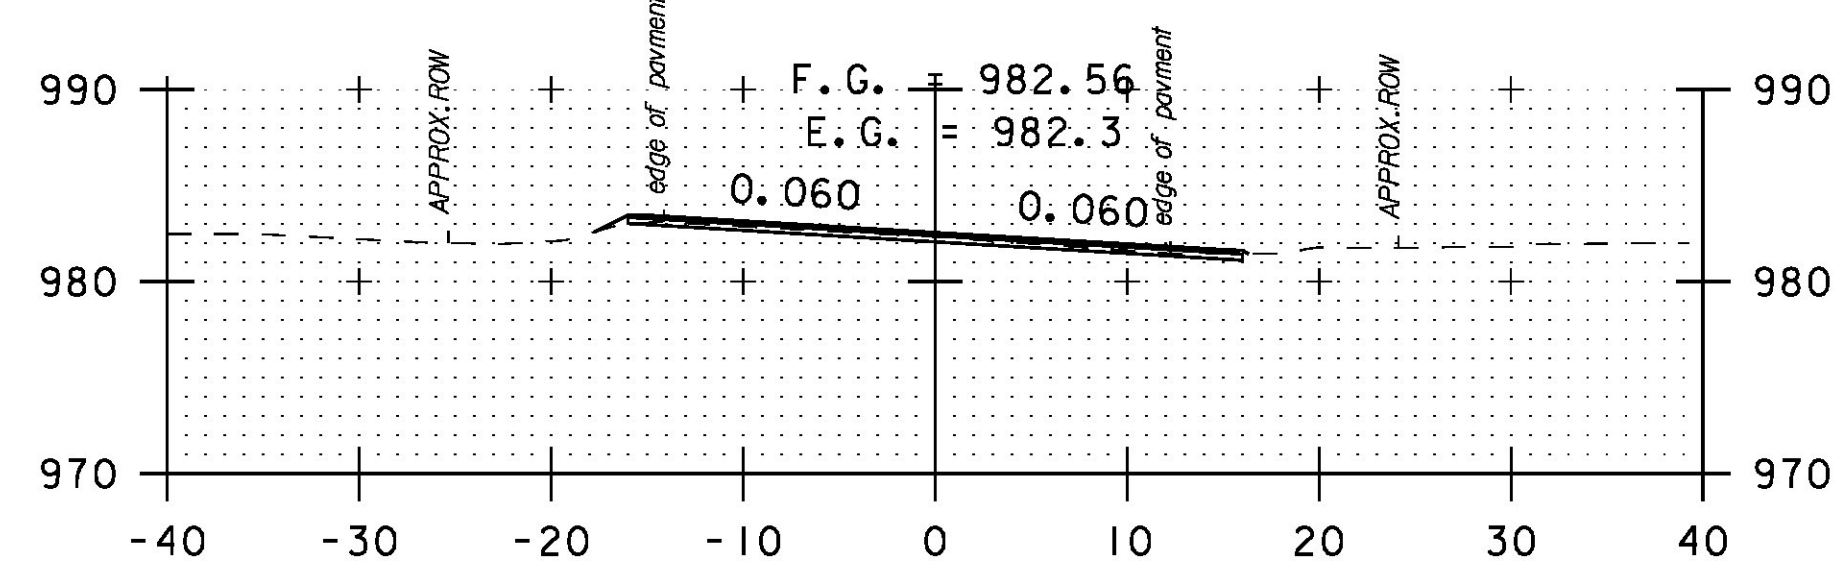


318+50

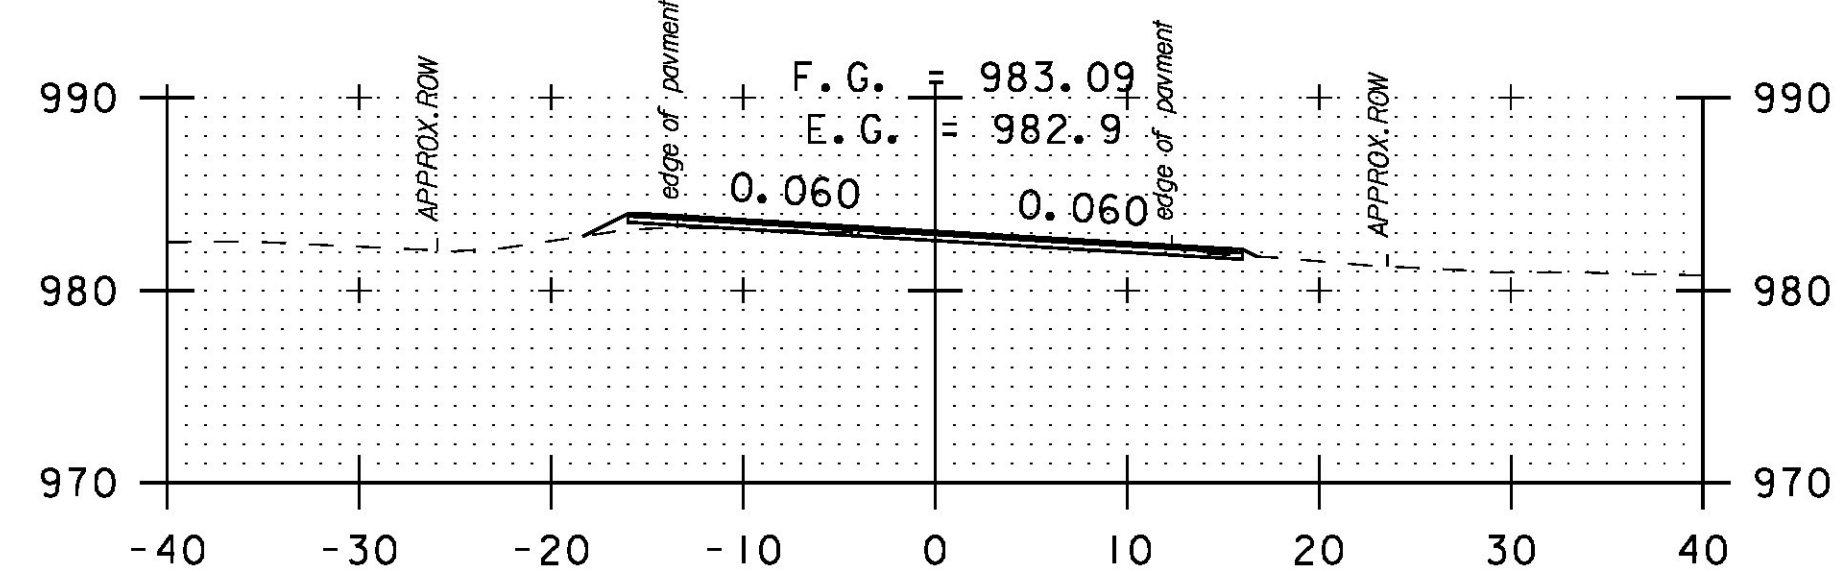


318+00
DRIVE RT

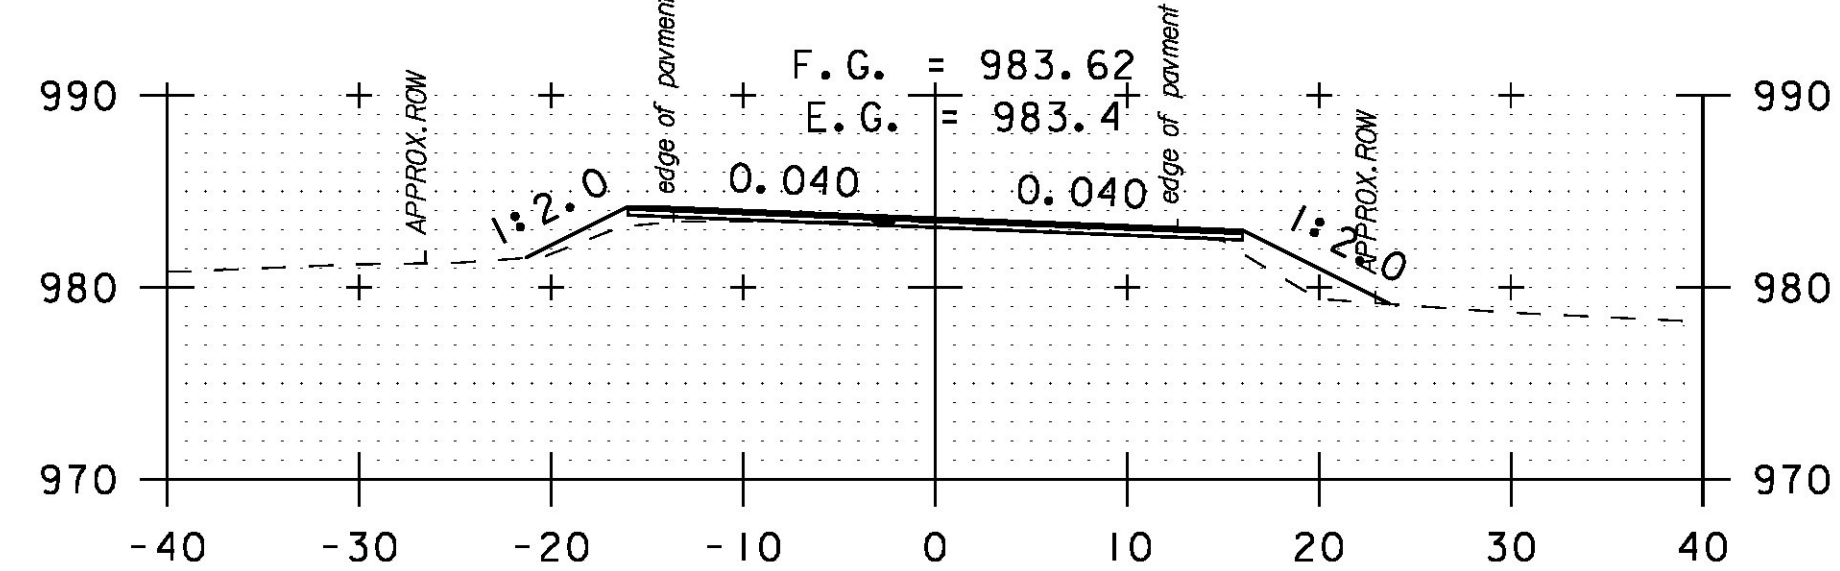

317+50

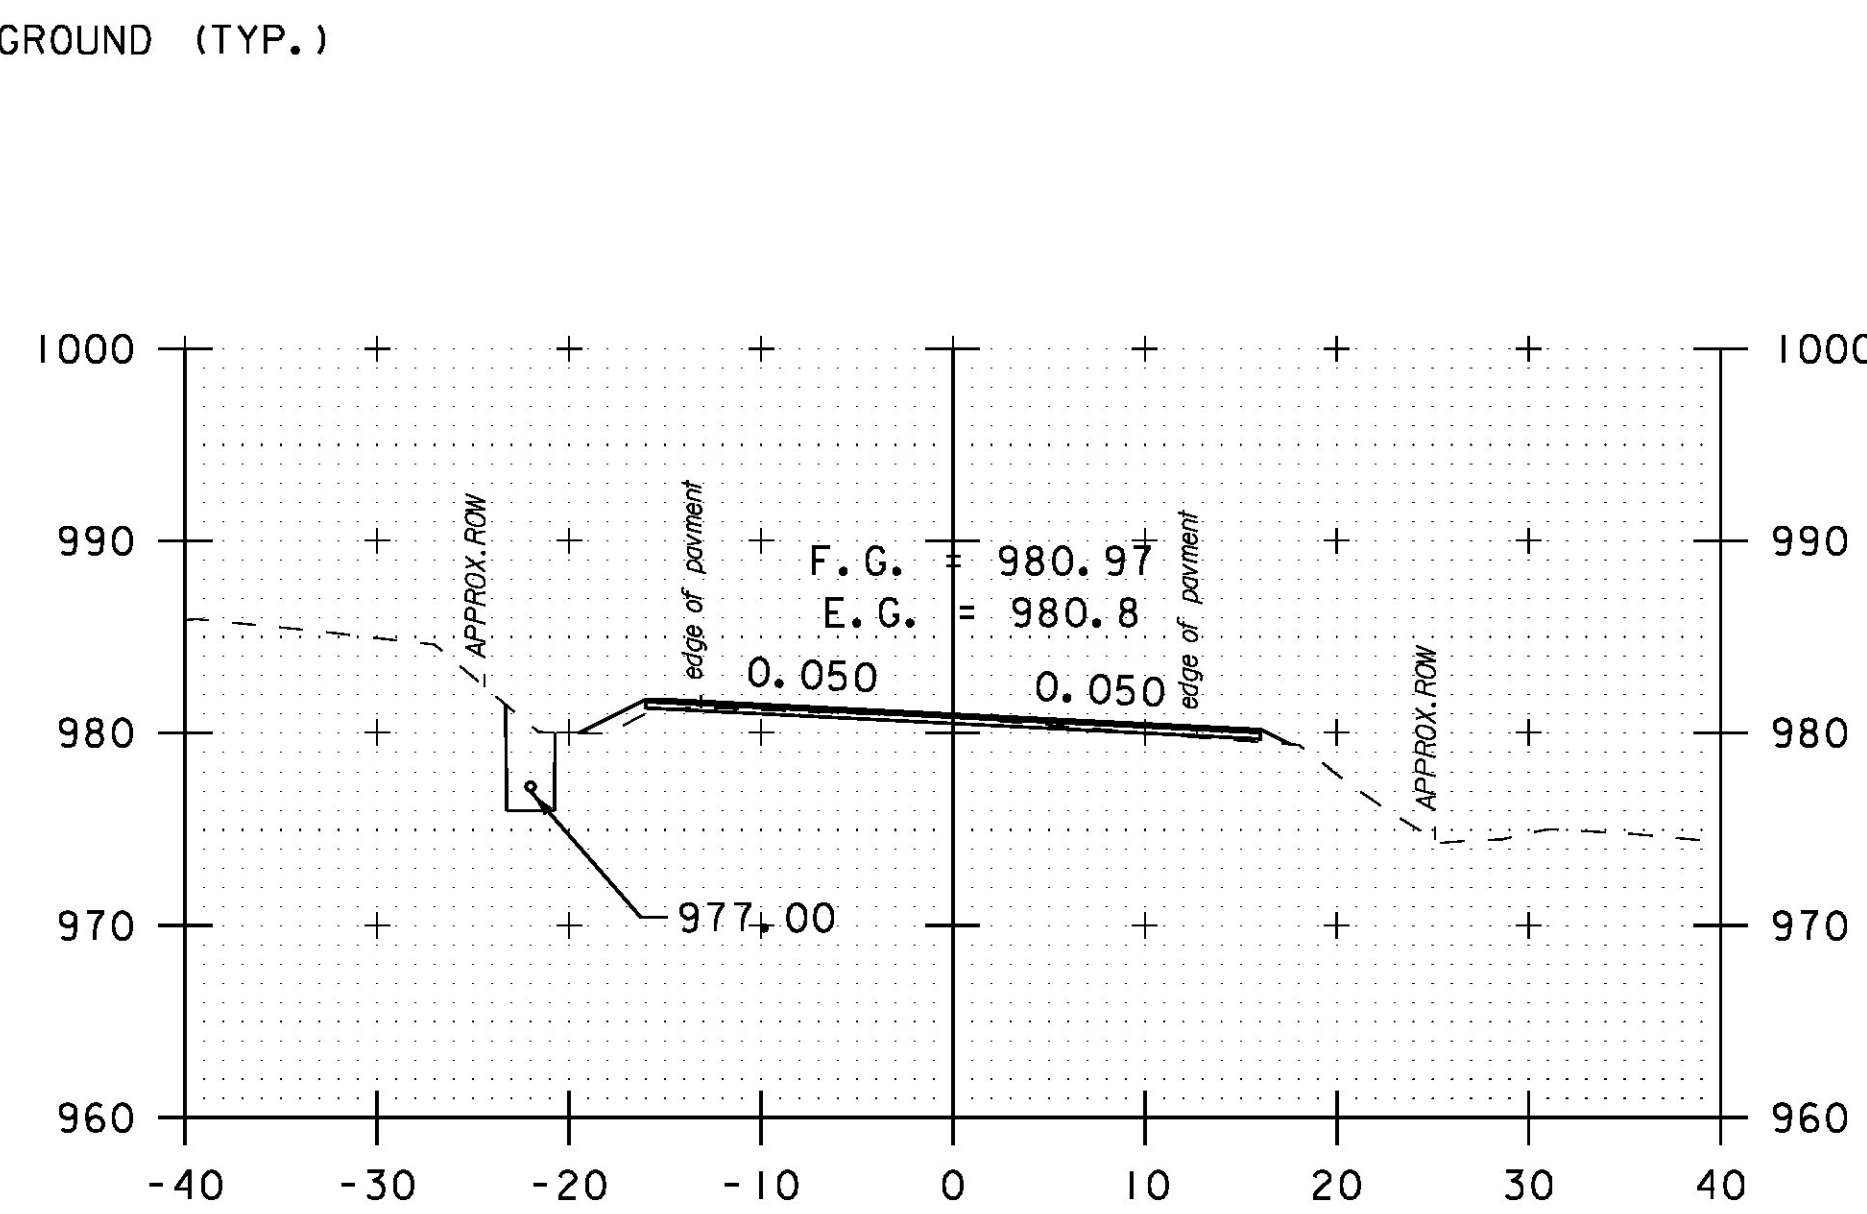


320+00

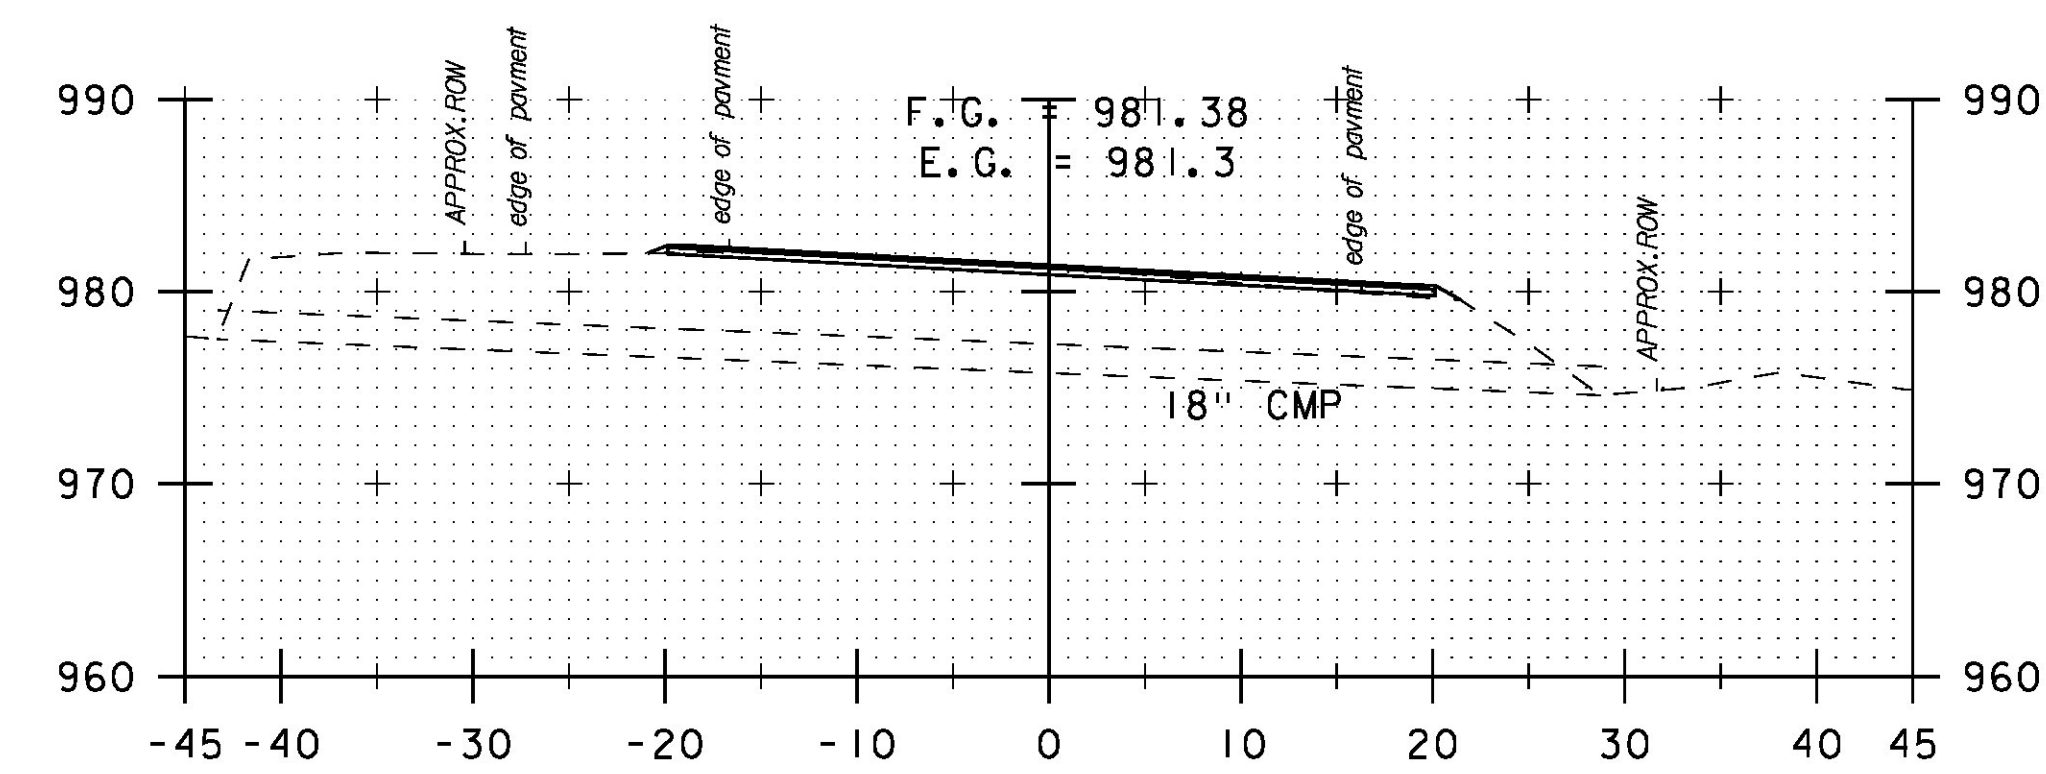


319+62


TH #5 LT / SKEWED

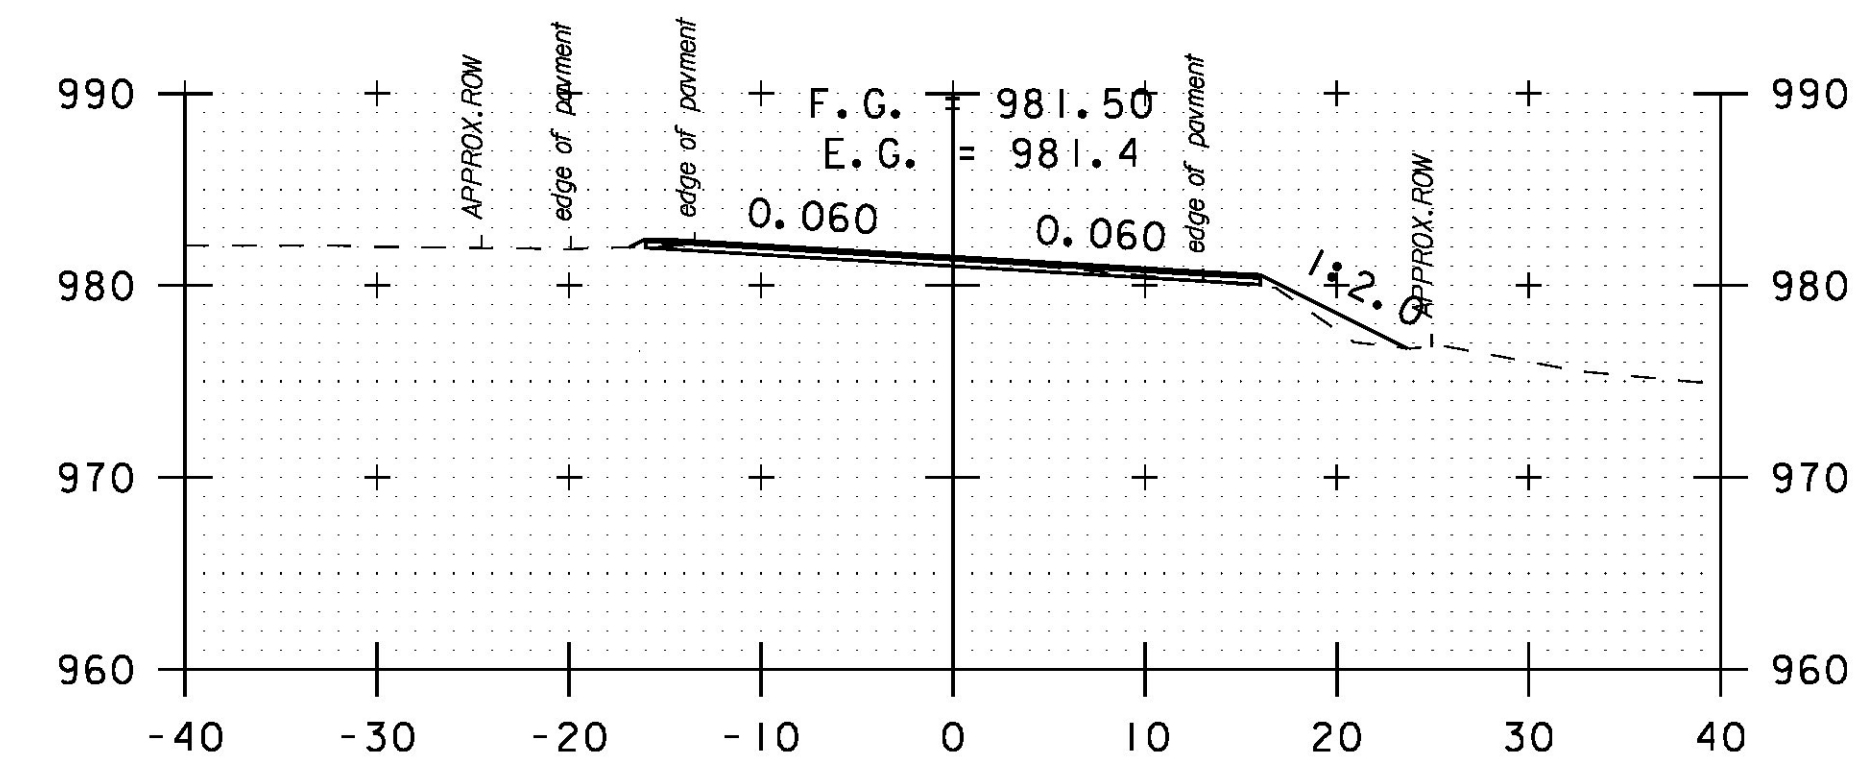


319+50
TH #5 LT

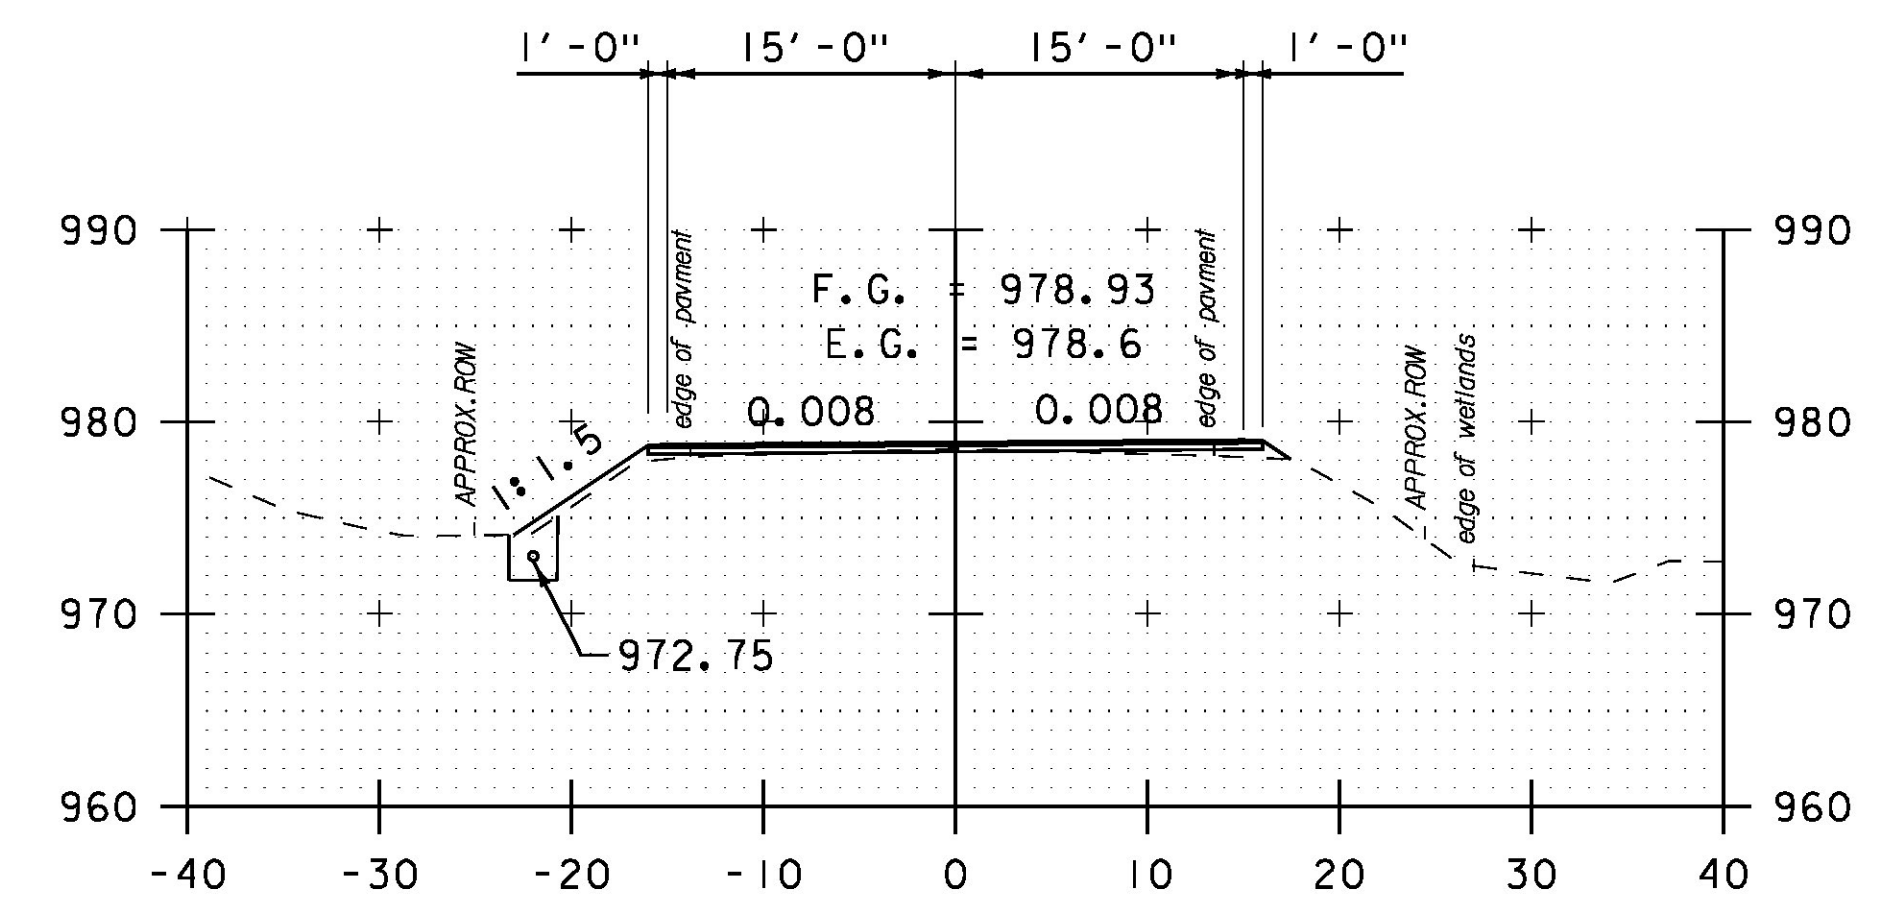

321+50

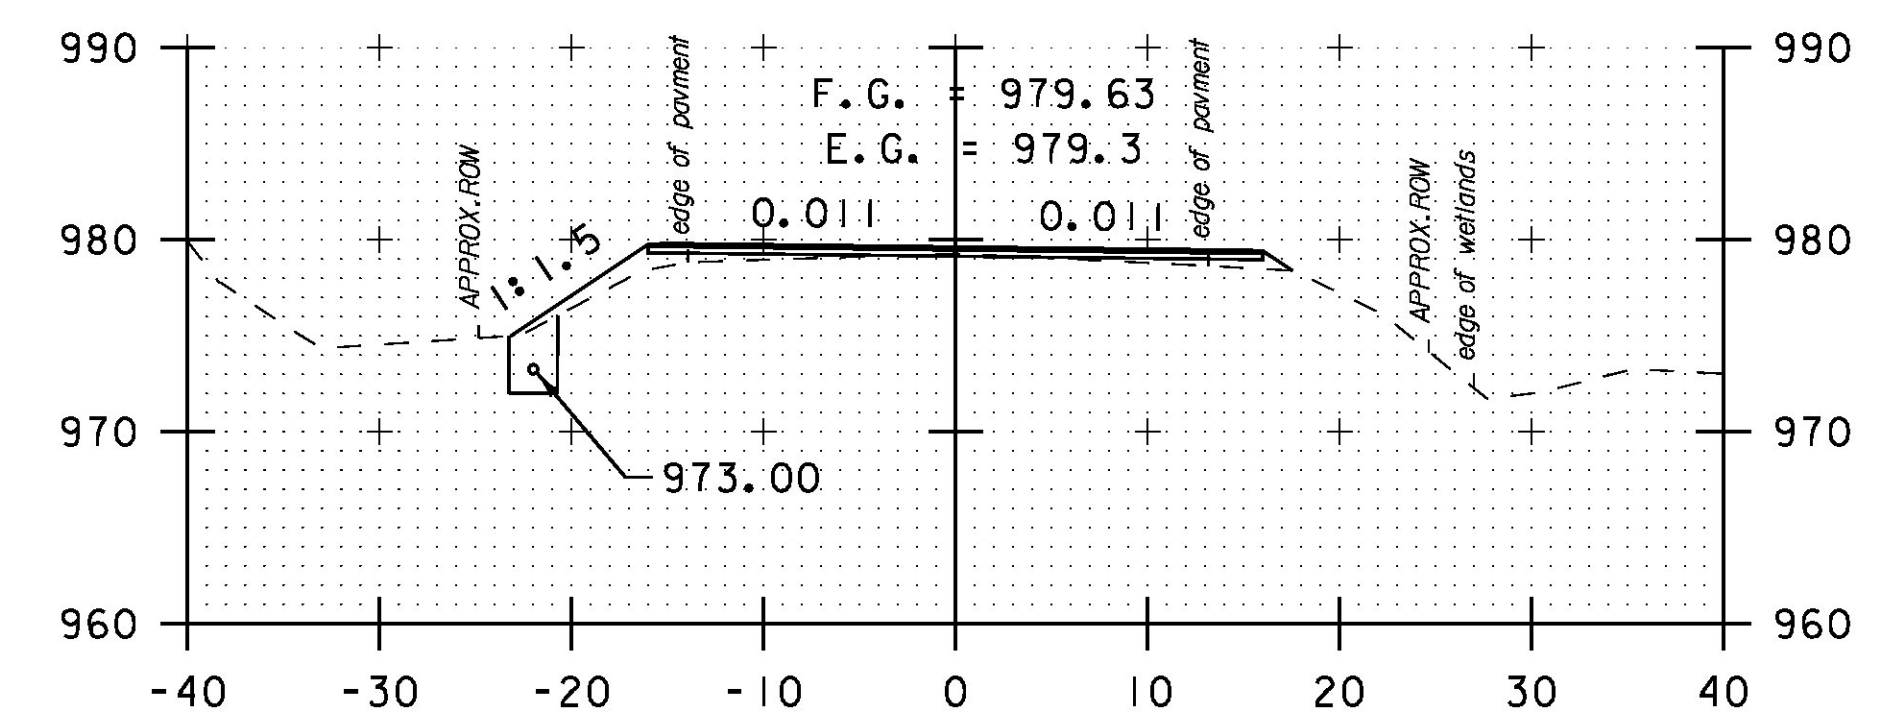

321+00

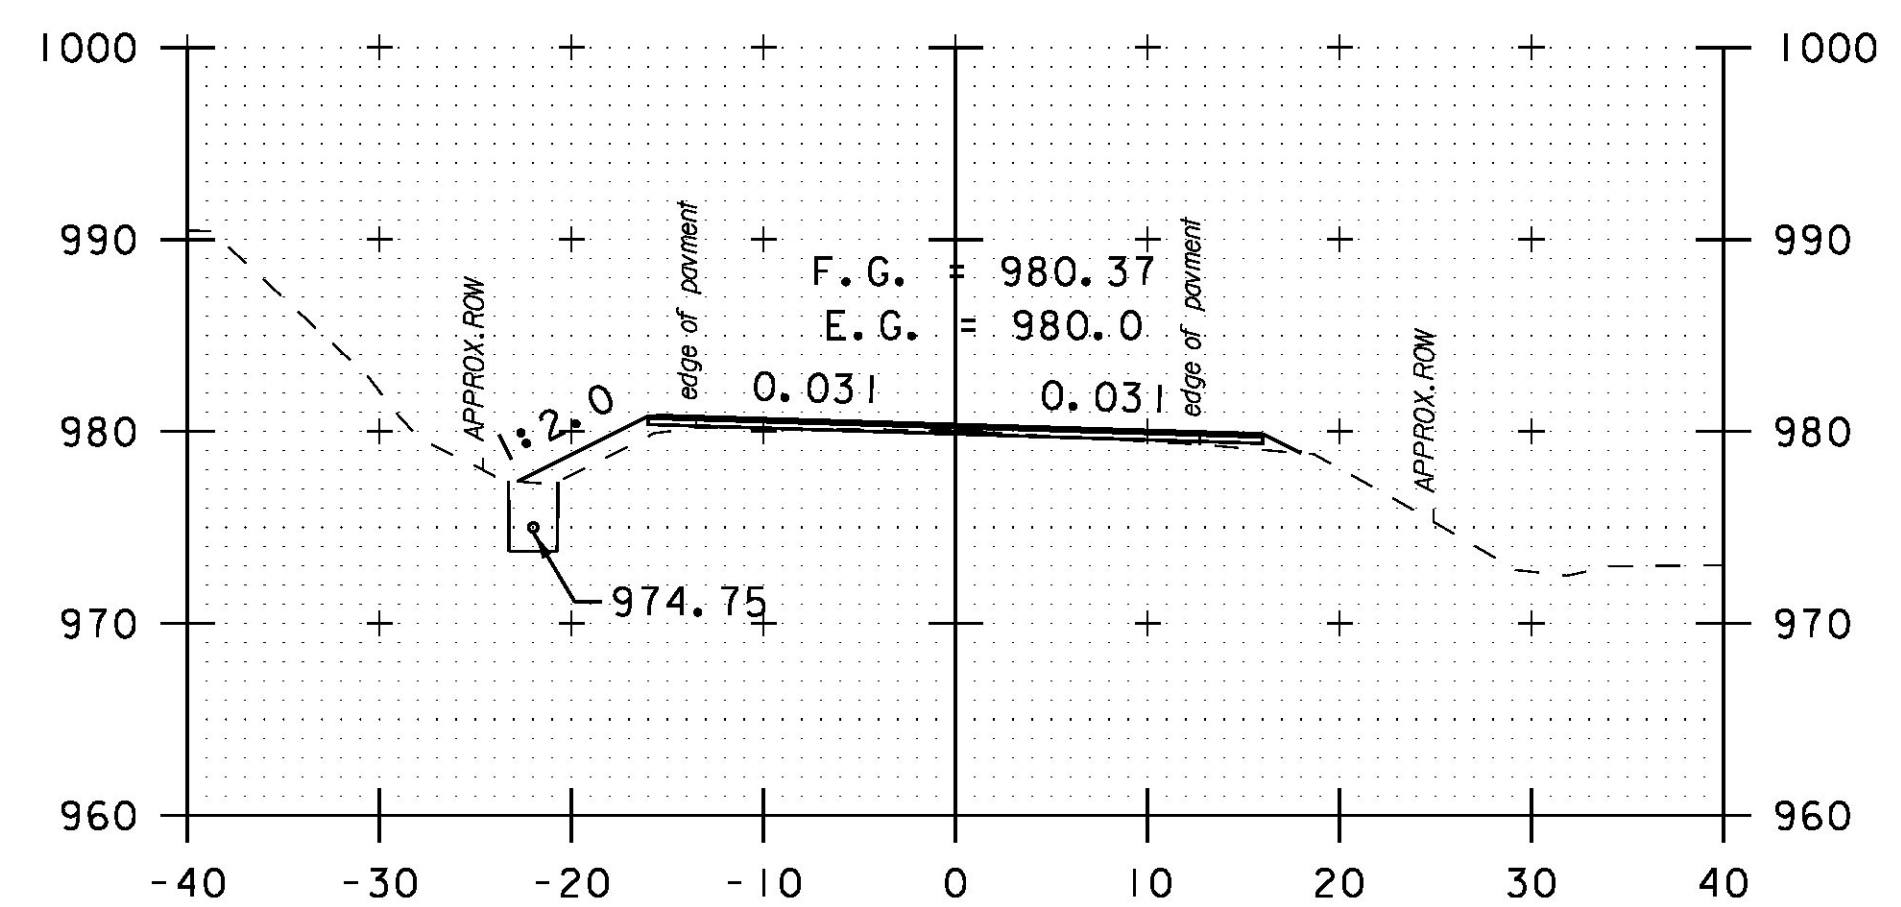

320+50



PROJECT NAME:	HANCOCK	PLOT DATE:	3/18/2015
PROJECT NUMBER:	STP 2923 (1)	DRAWN BY:	B. MARTIN
FILE NAME:	z10c252xs.dgn	DESIGNED BY:	B. MARTIN
PROJECT LEADER:	C. LATHROP	CHECKED BY:	C. LATHROP
CROSS SECTION SHEET:	61	SHEET:	188 OF 207