




327+00

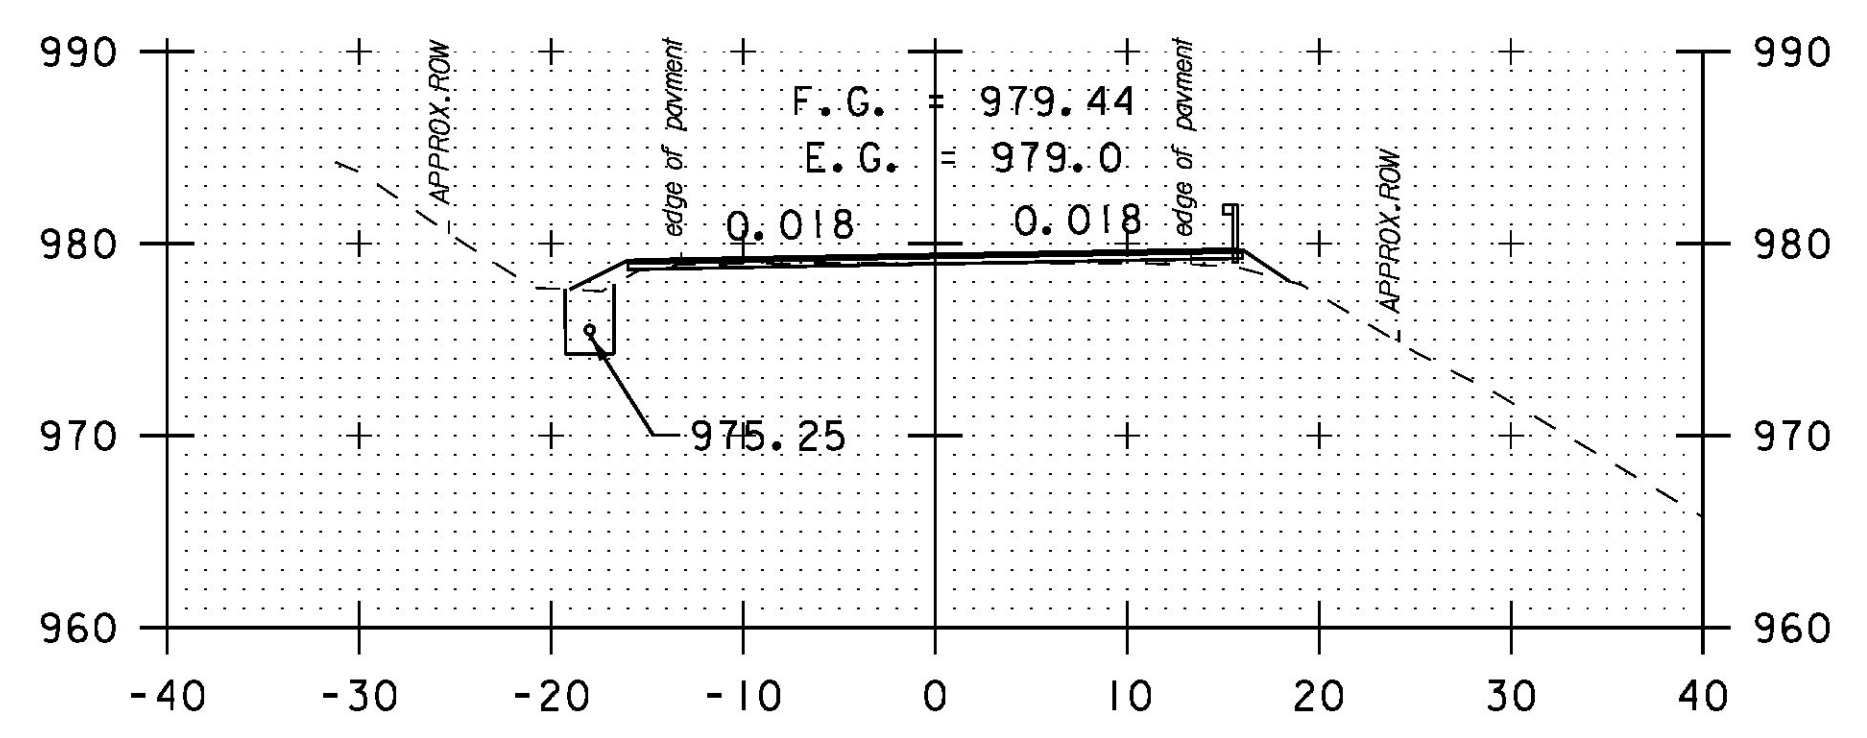


326+50

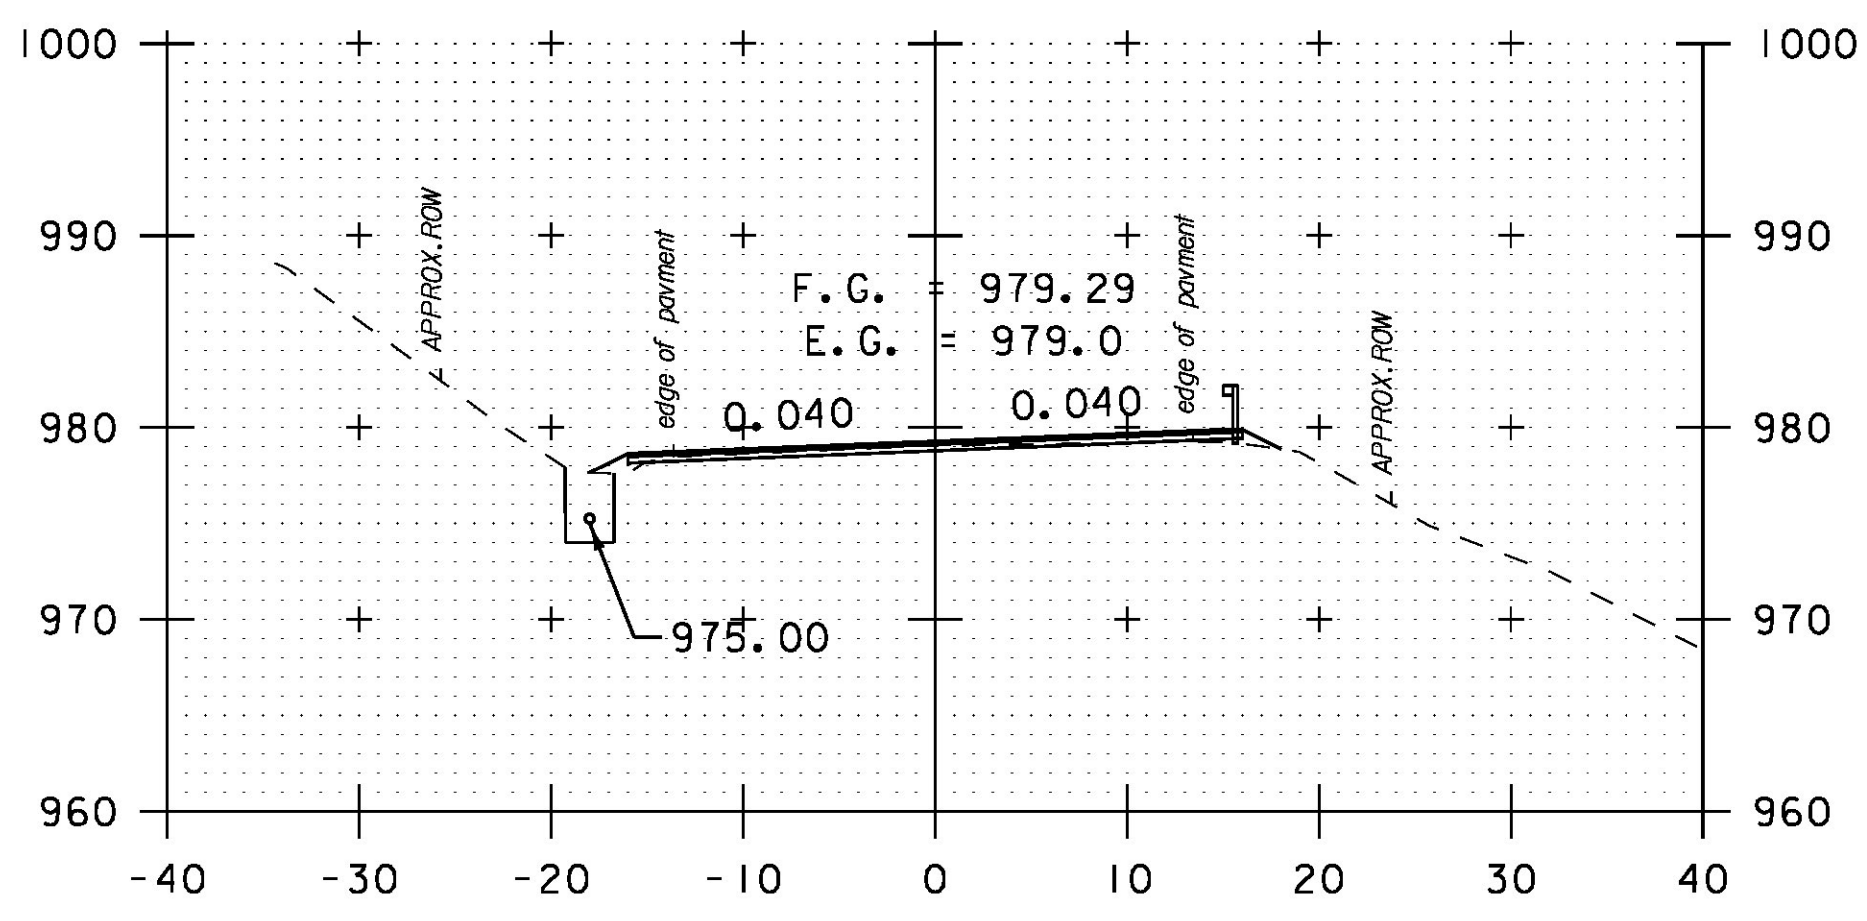

326+00

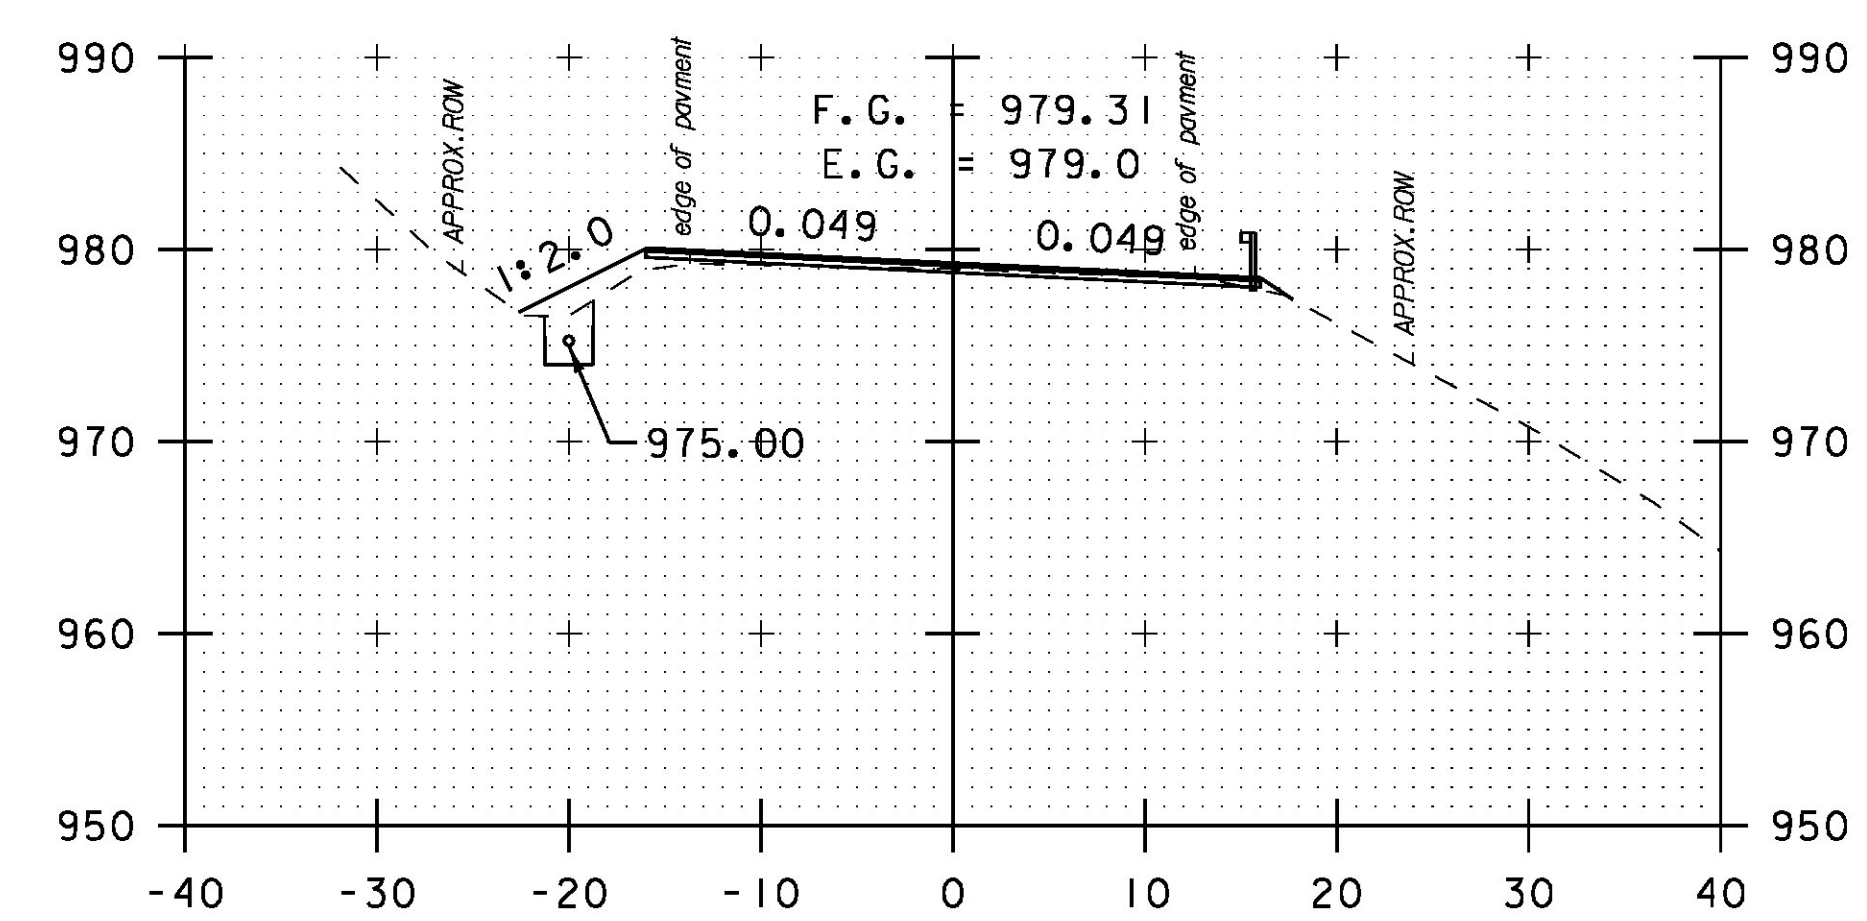


328+00

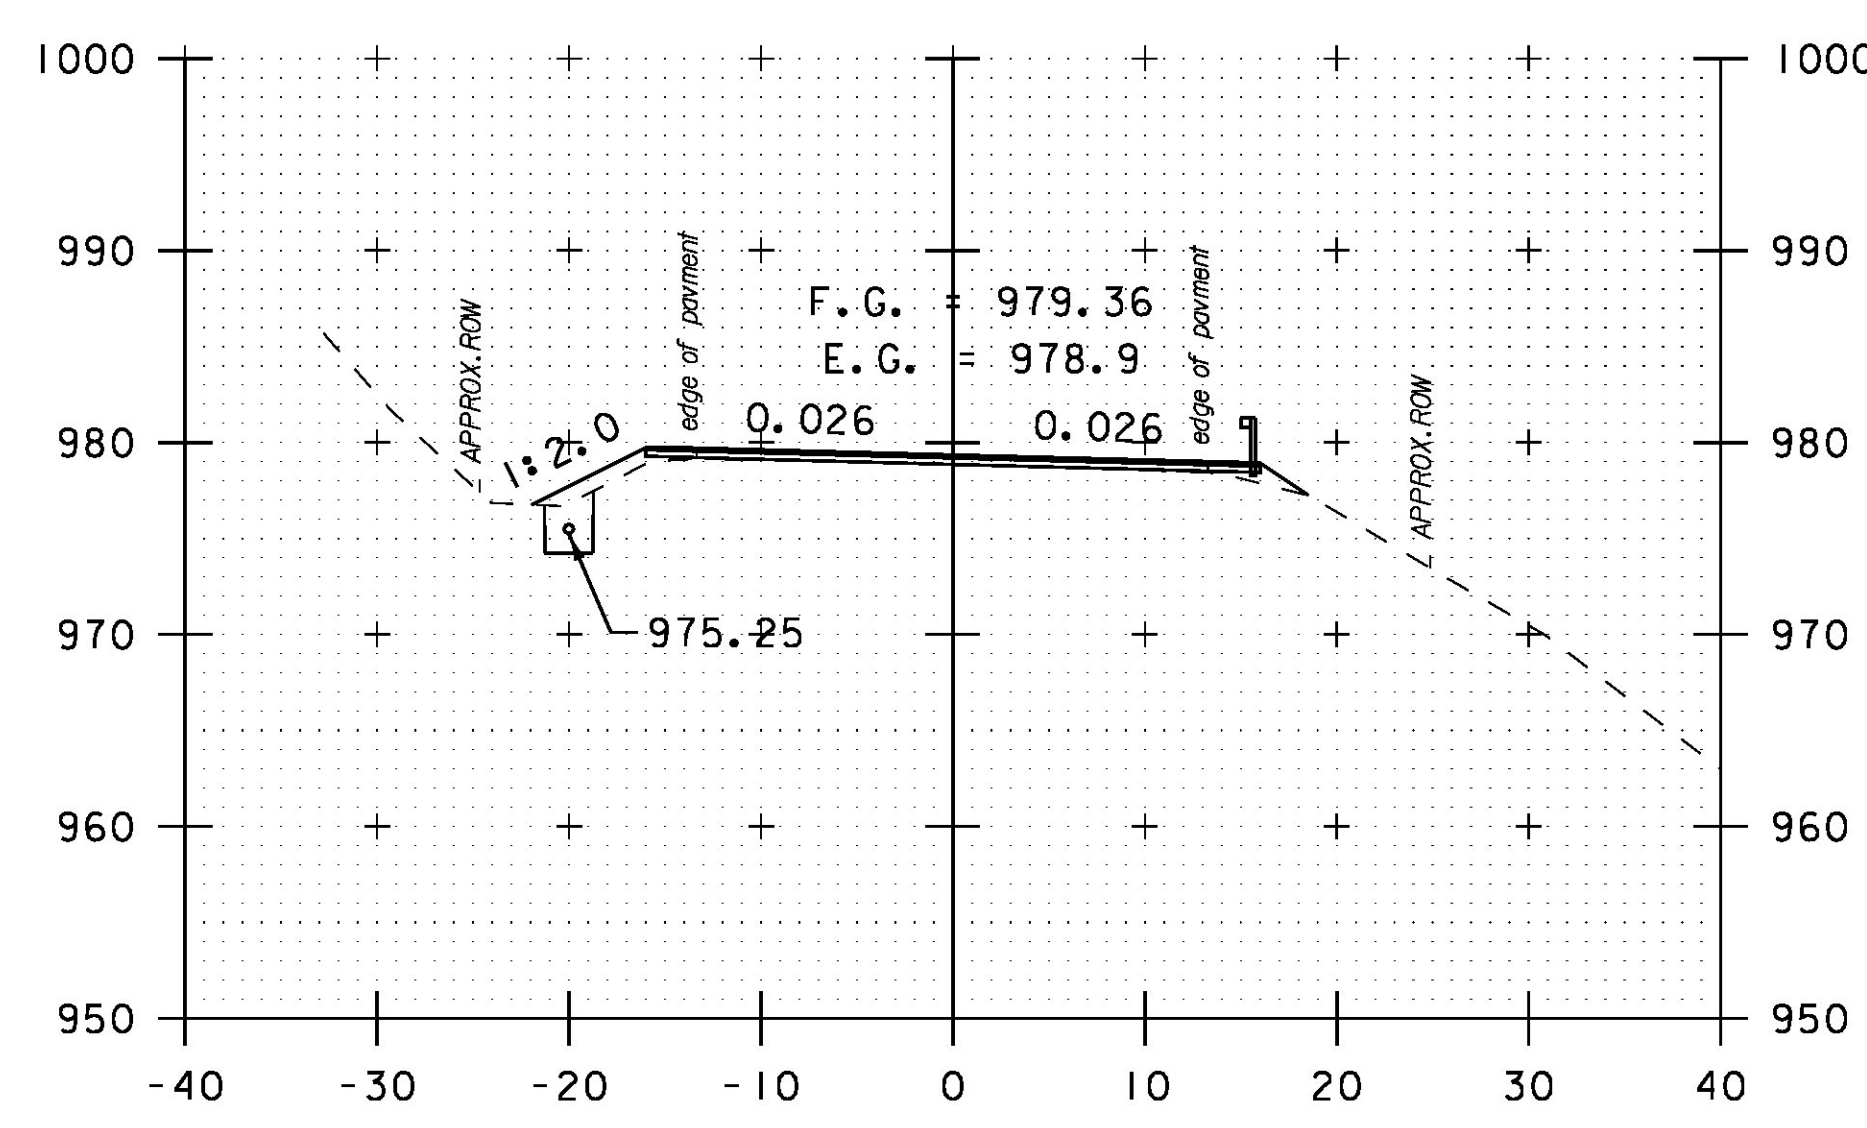


327+50

20


STA. 328+51.49 LT 21.66' TO  
STA. 328+55.09 RT 27.03'  
CONSTRUCT CONCRETE REINFORCED  
HEADWALL PER STD. D-33. USE  
SCHEDULING AND DIMENSIONS FOR  
42" PIPE, LT  
INV. IN = 974.15'  
INV. OUT = 971.79'

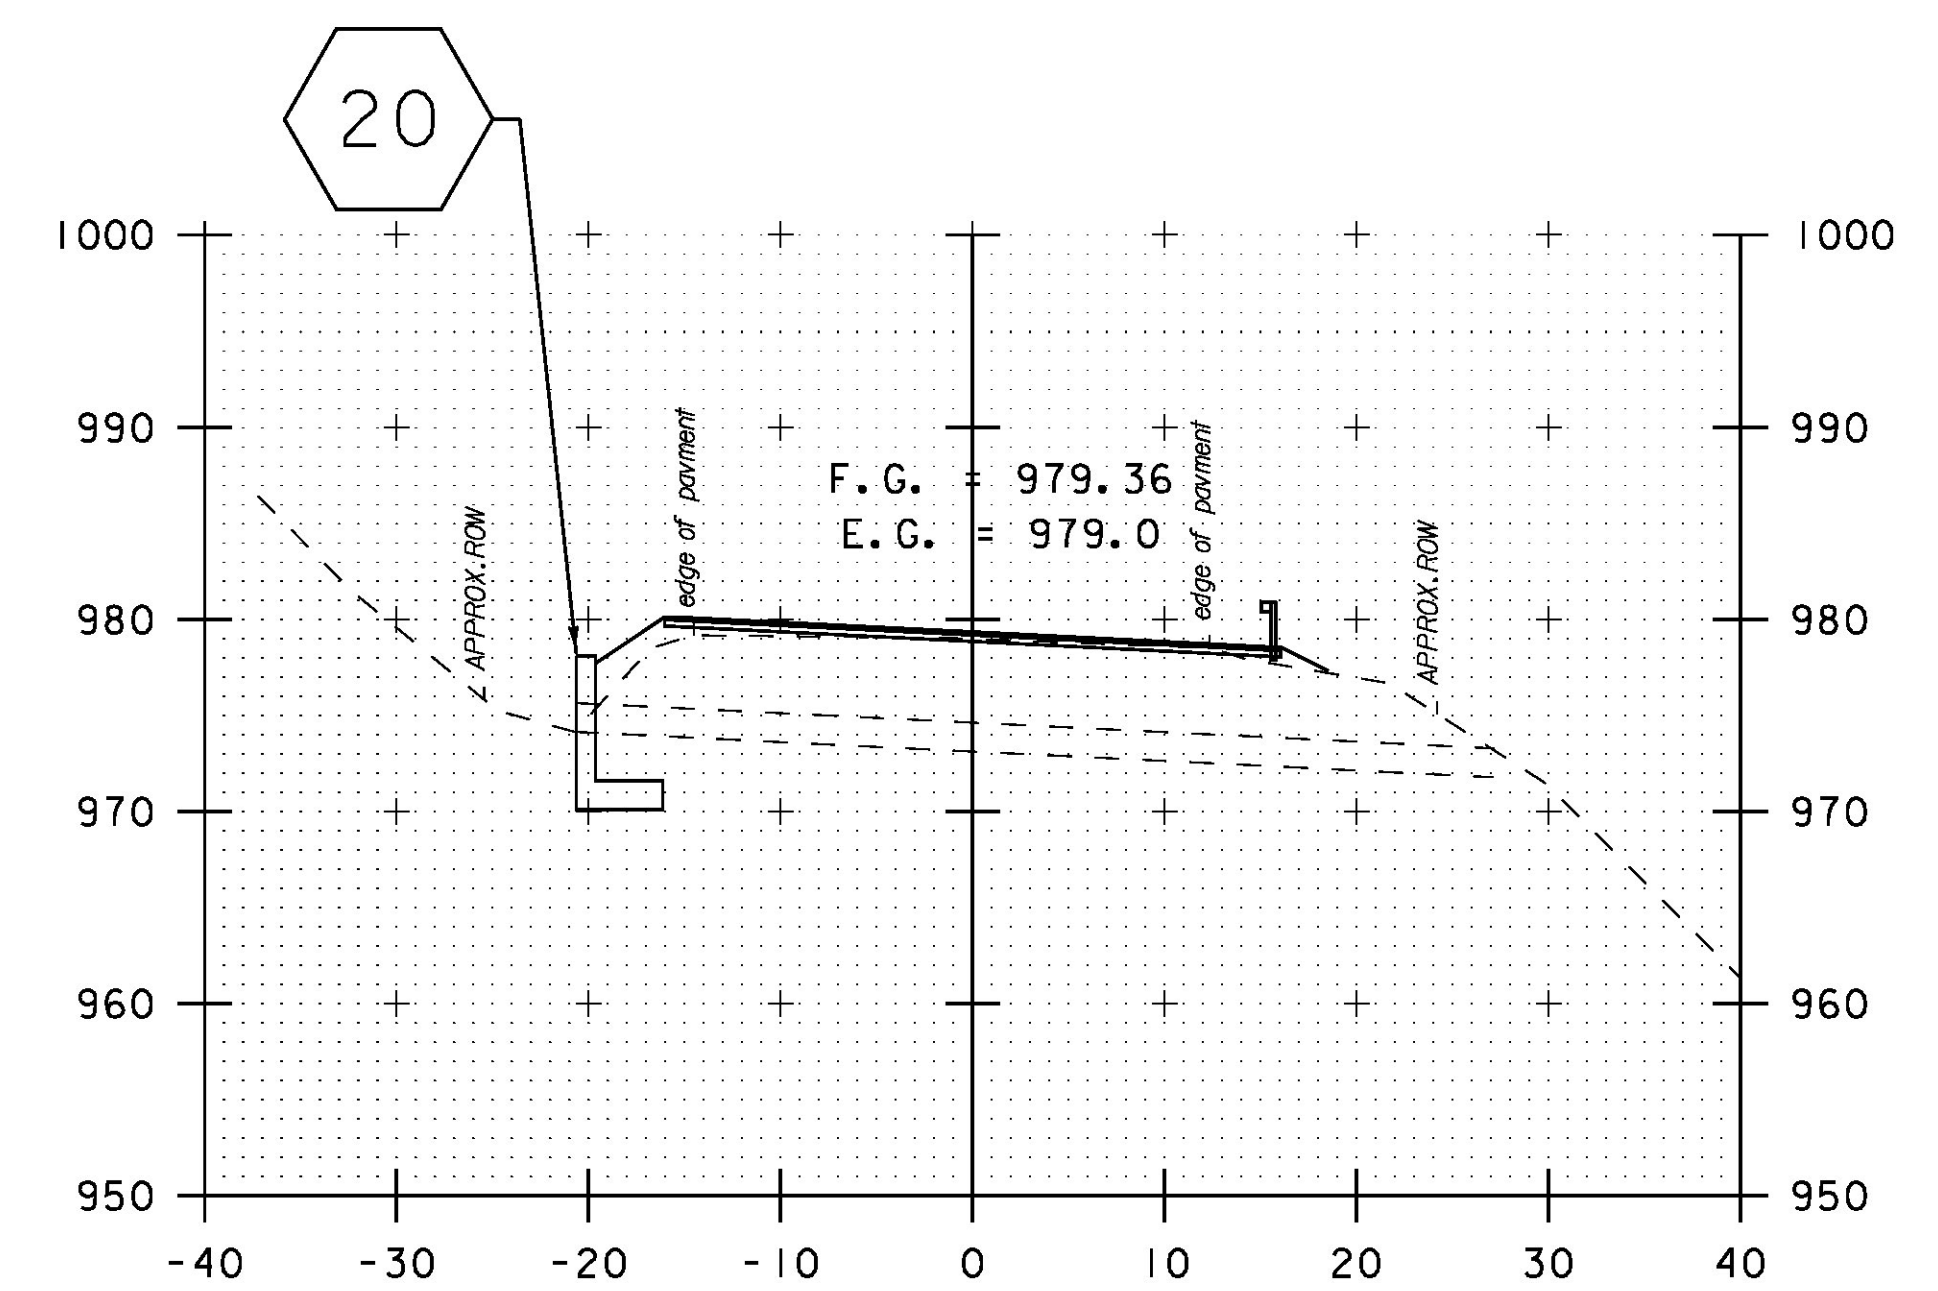

328+53  
SKEWED

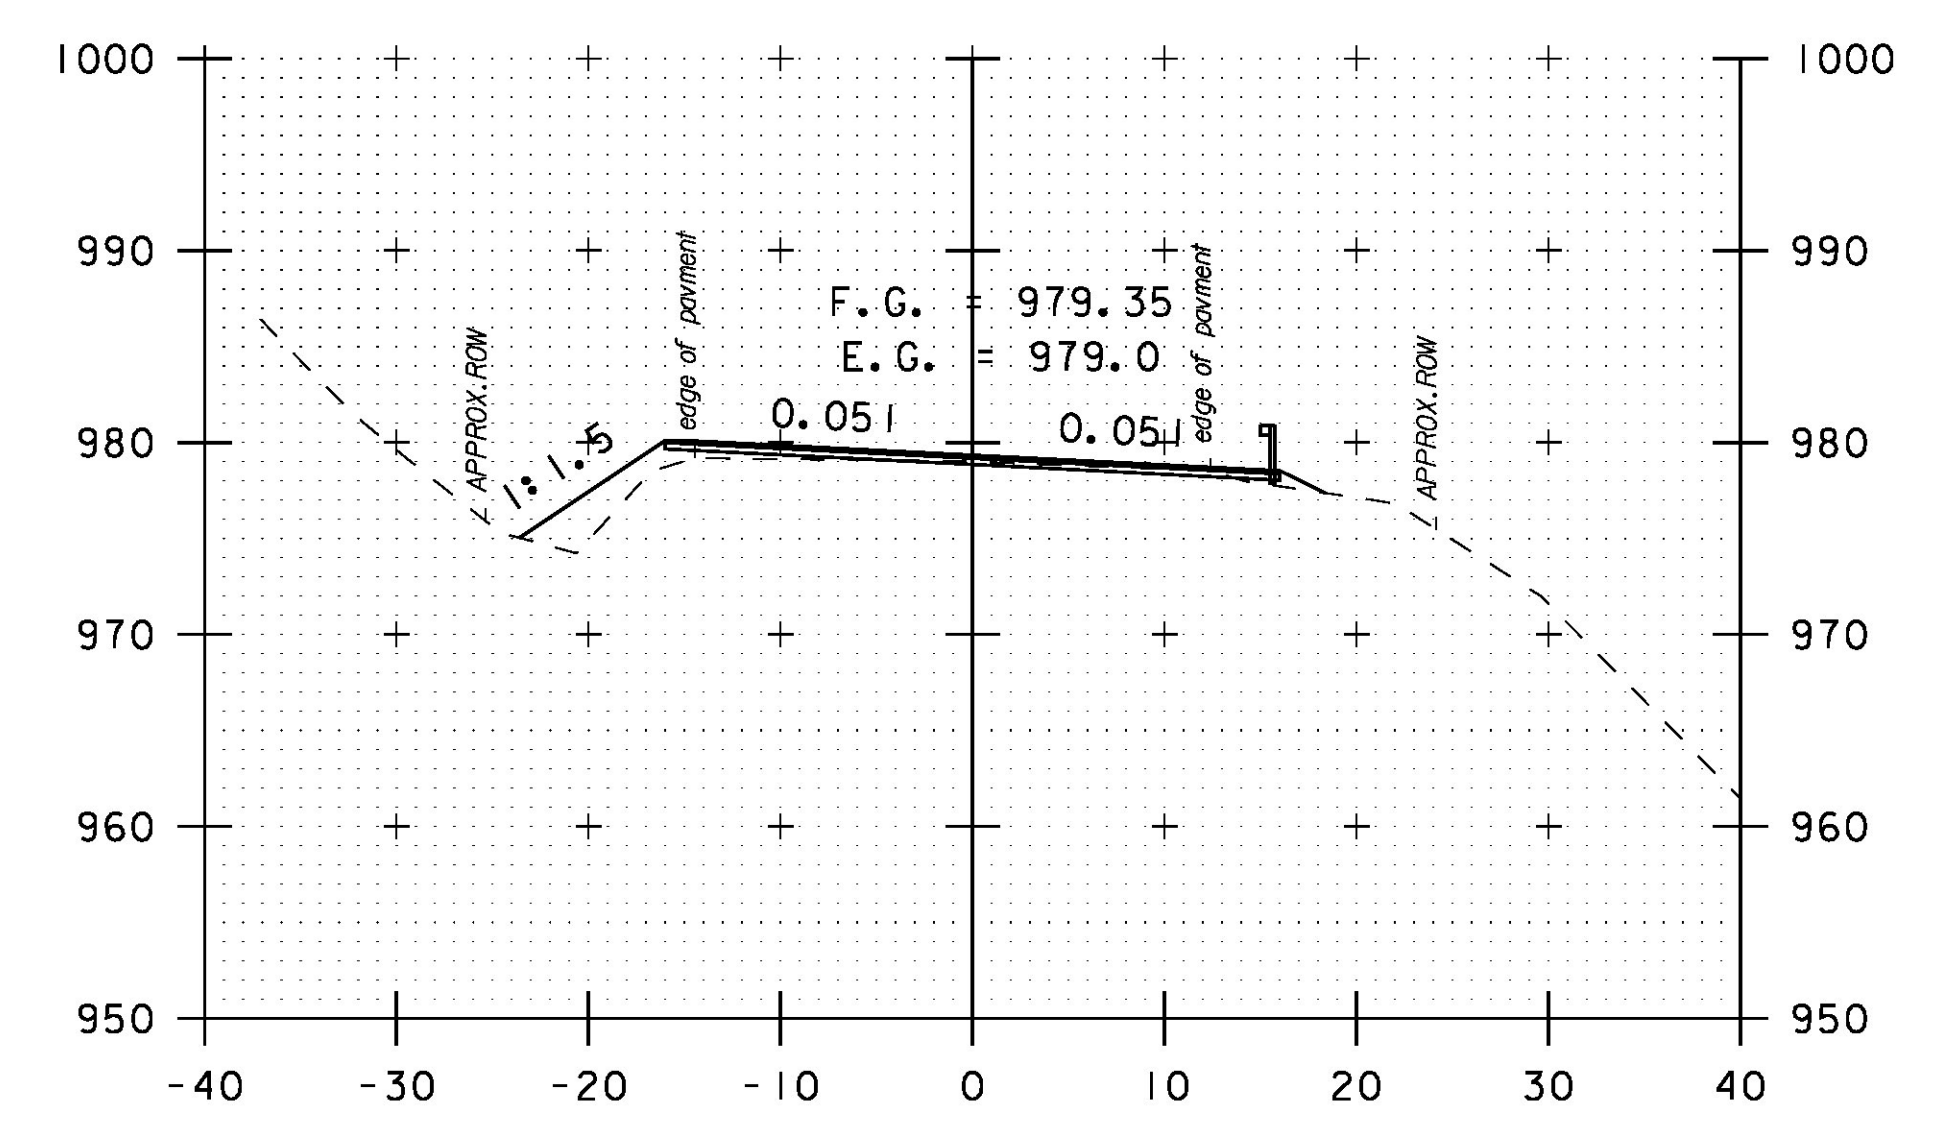

328+50

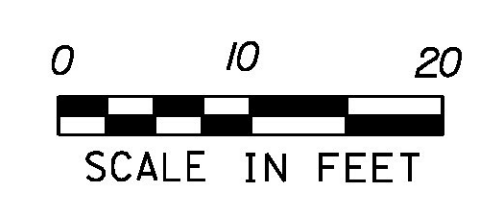

PROJECT NAME:	HANCOCK
PROJECT NUMBER:	STP 2923 (1)
FILE NAME:	z10c252xs.dgn
PROJECT LEADER:	C. LATHROP
DESIGNED BY:	B. MARTIN
CROSS SECTION SHEET:	63
PLOT DATE:	3/18/2015
DRAWN BY:	B. MARTIN
CHECKED BY:	C. LATHROP
SHEET:	190 OF 207