




329+50

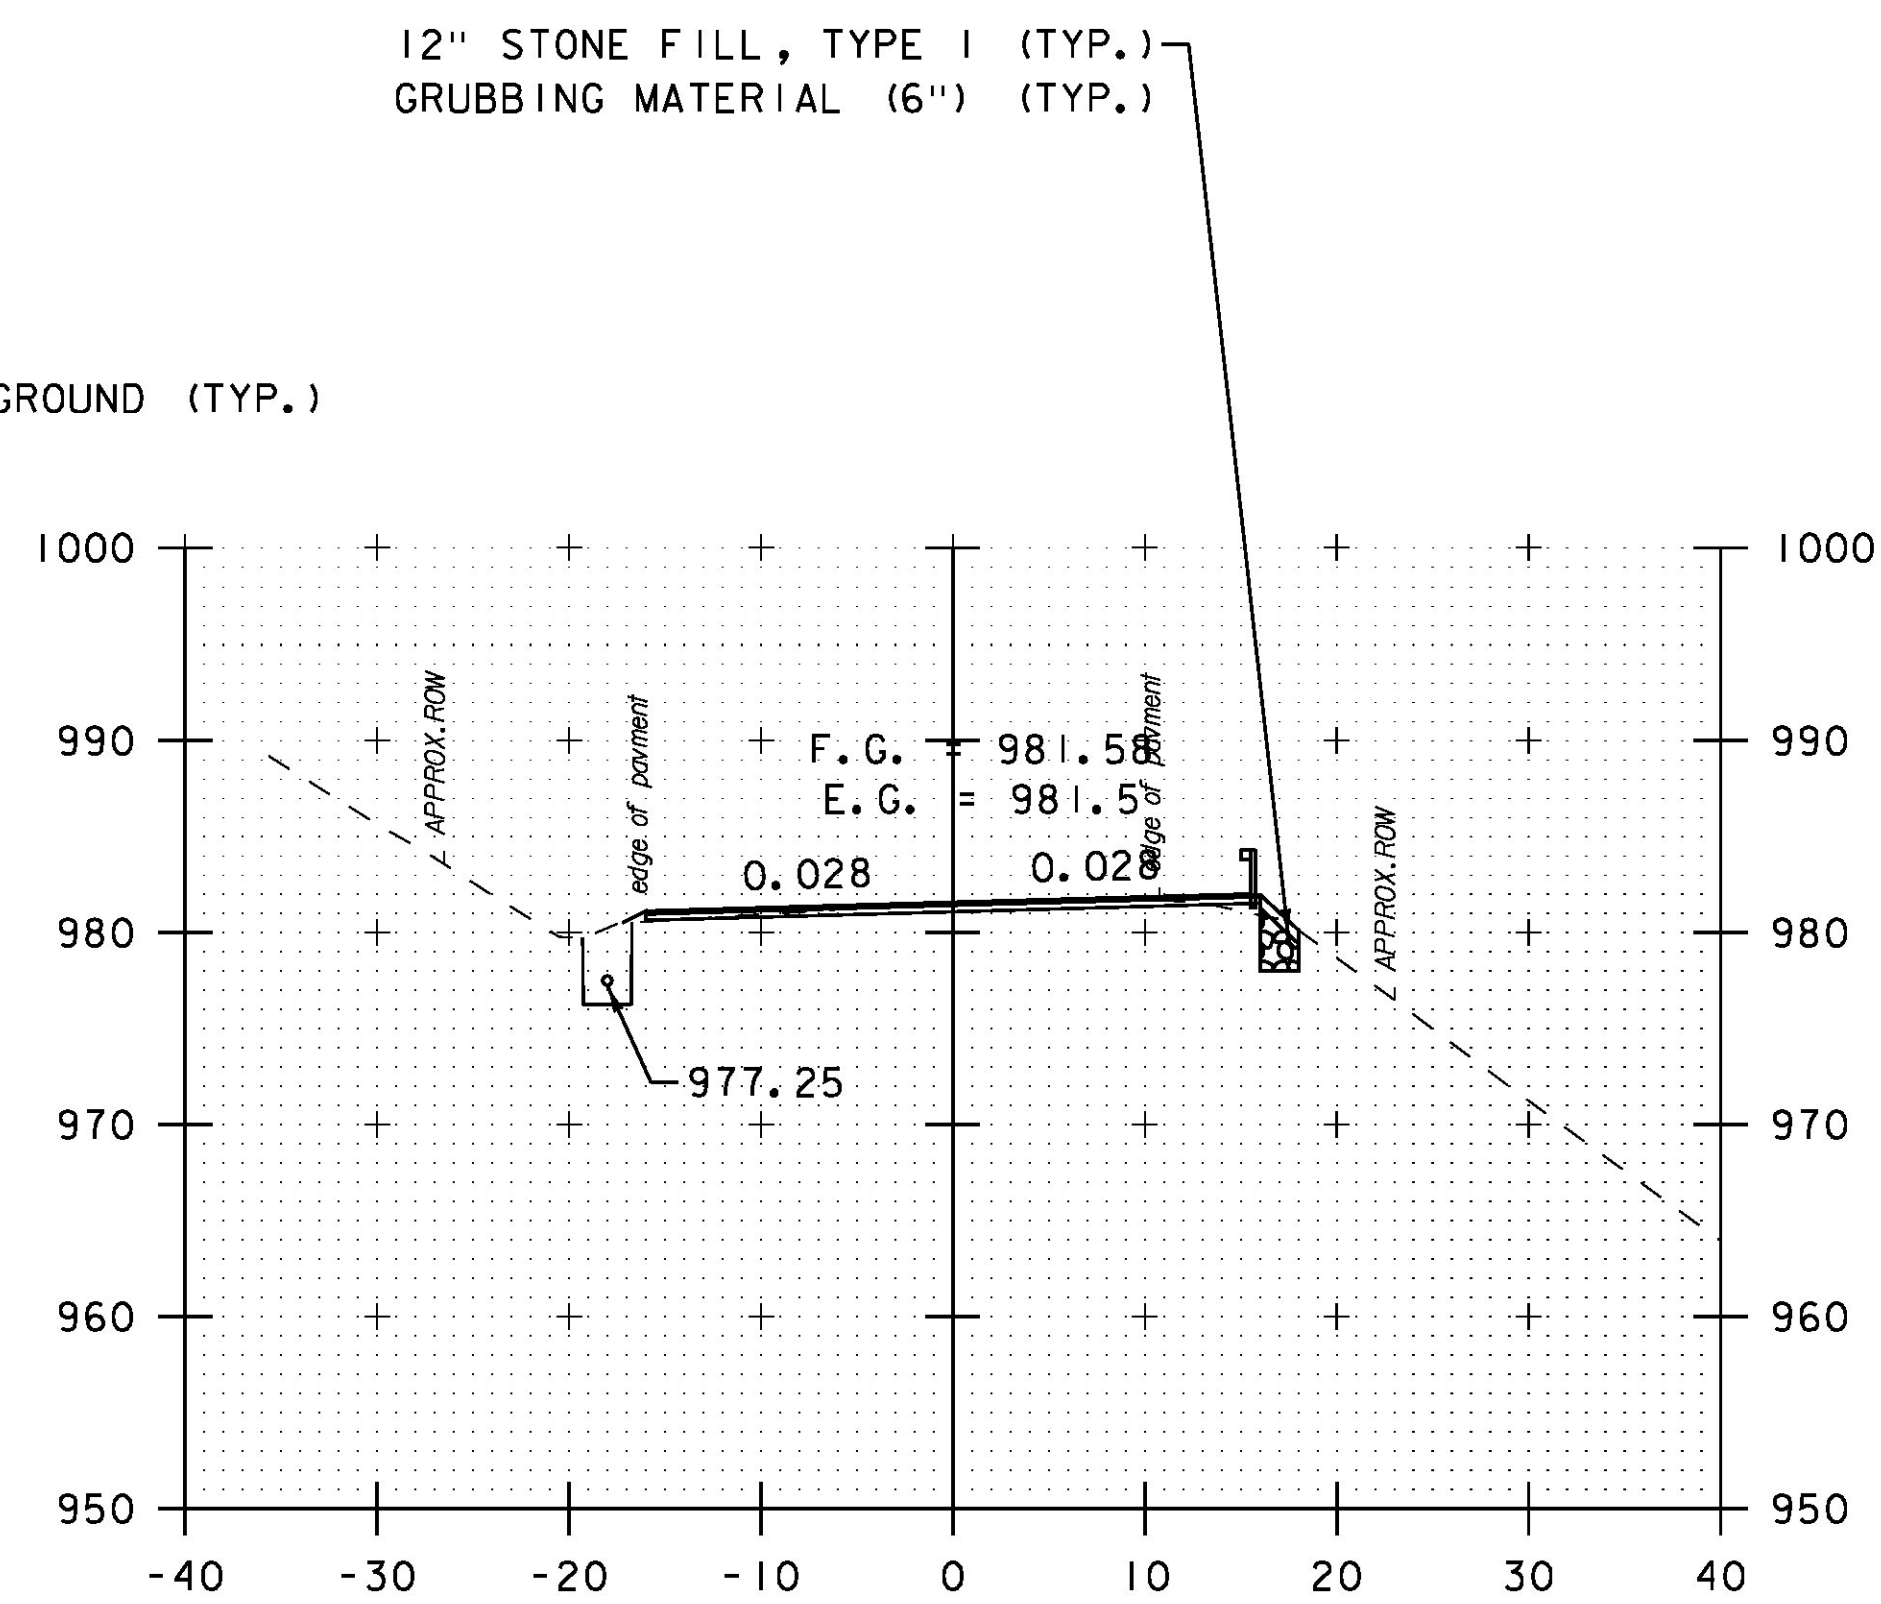


330+50

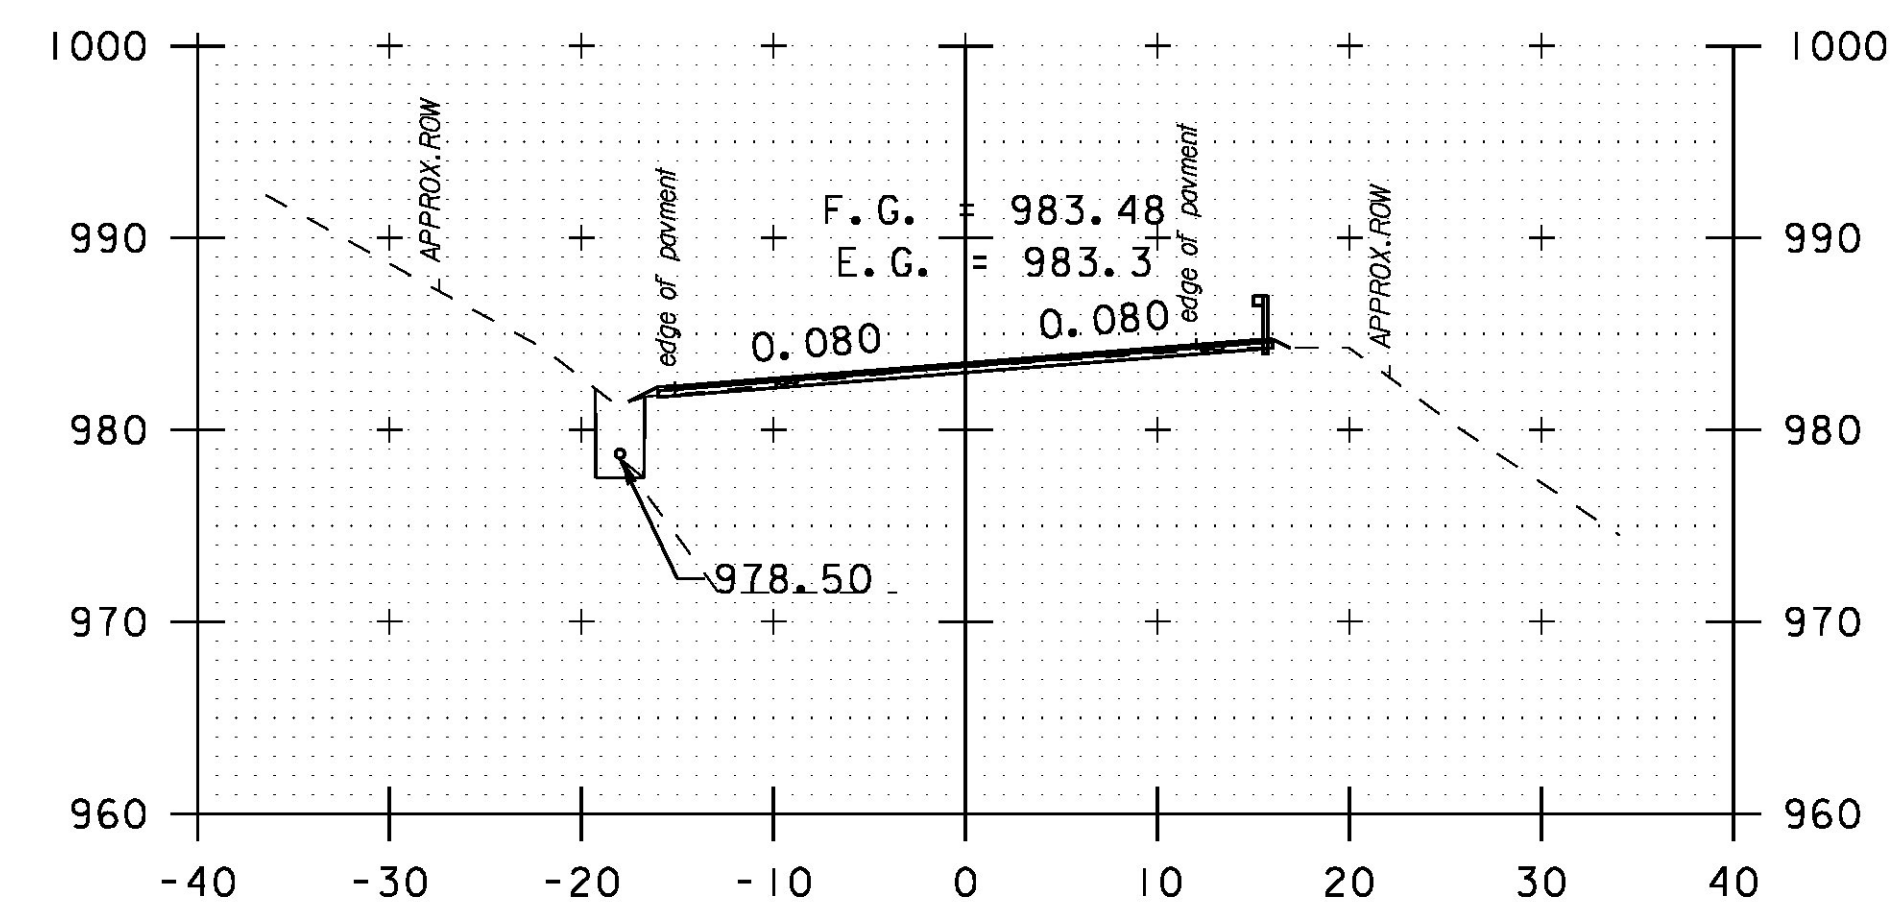


332+00

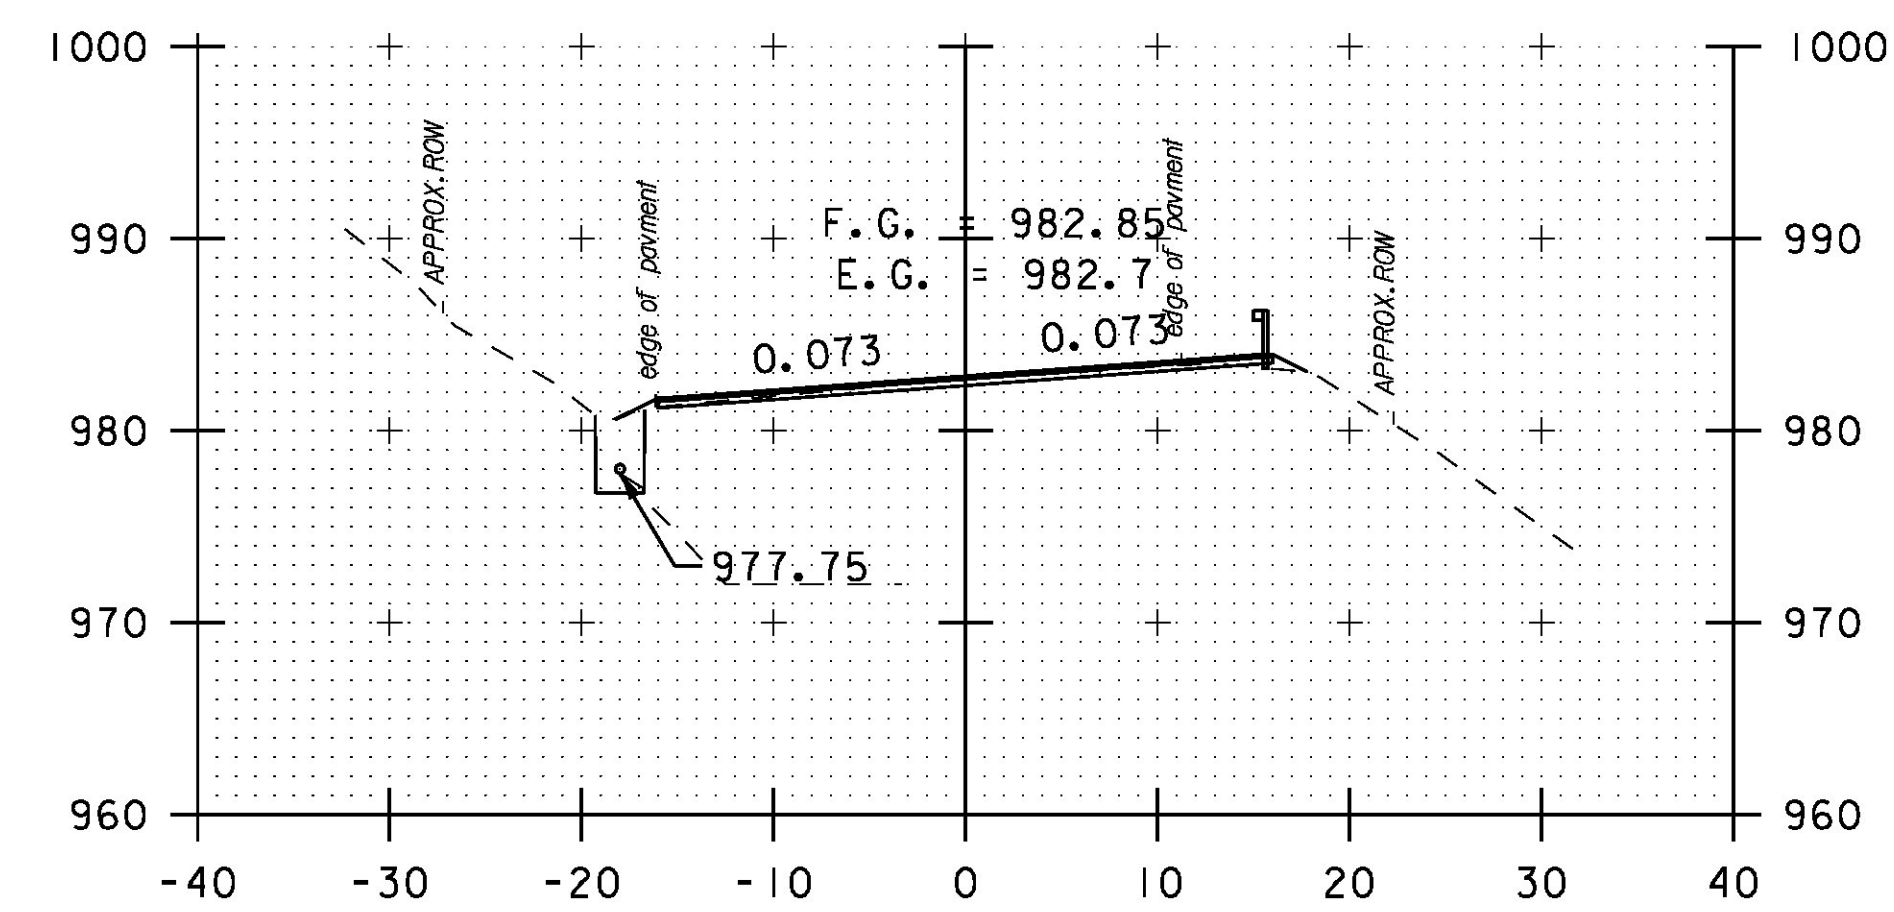


331+50

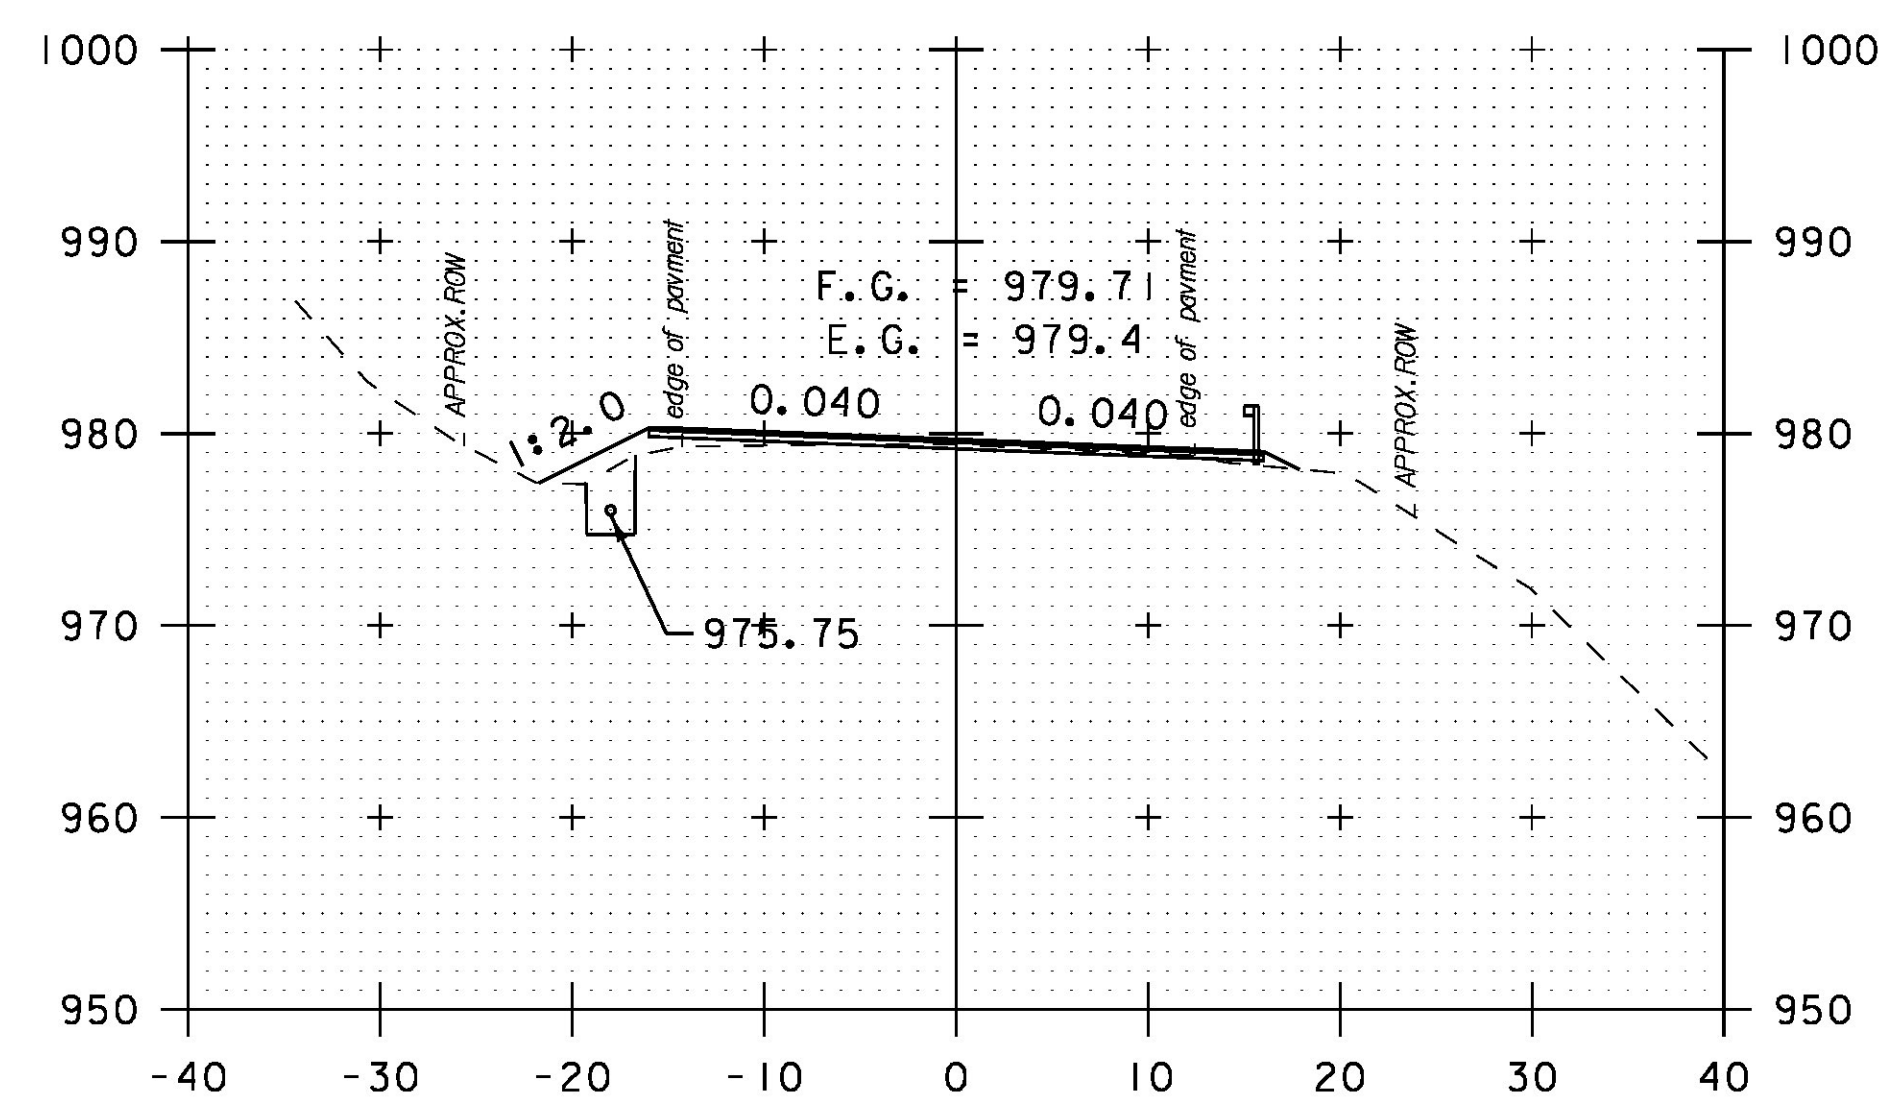

329+00

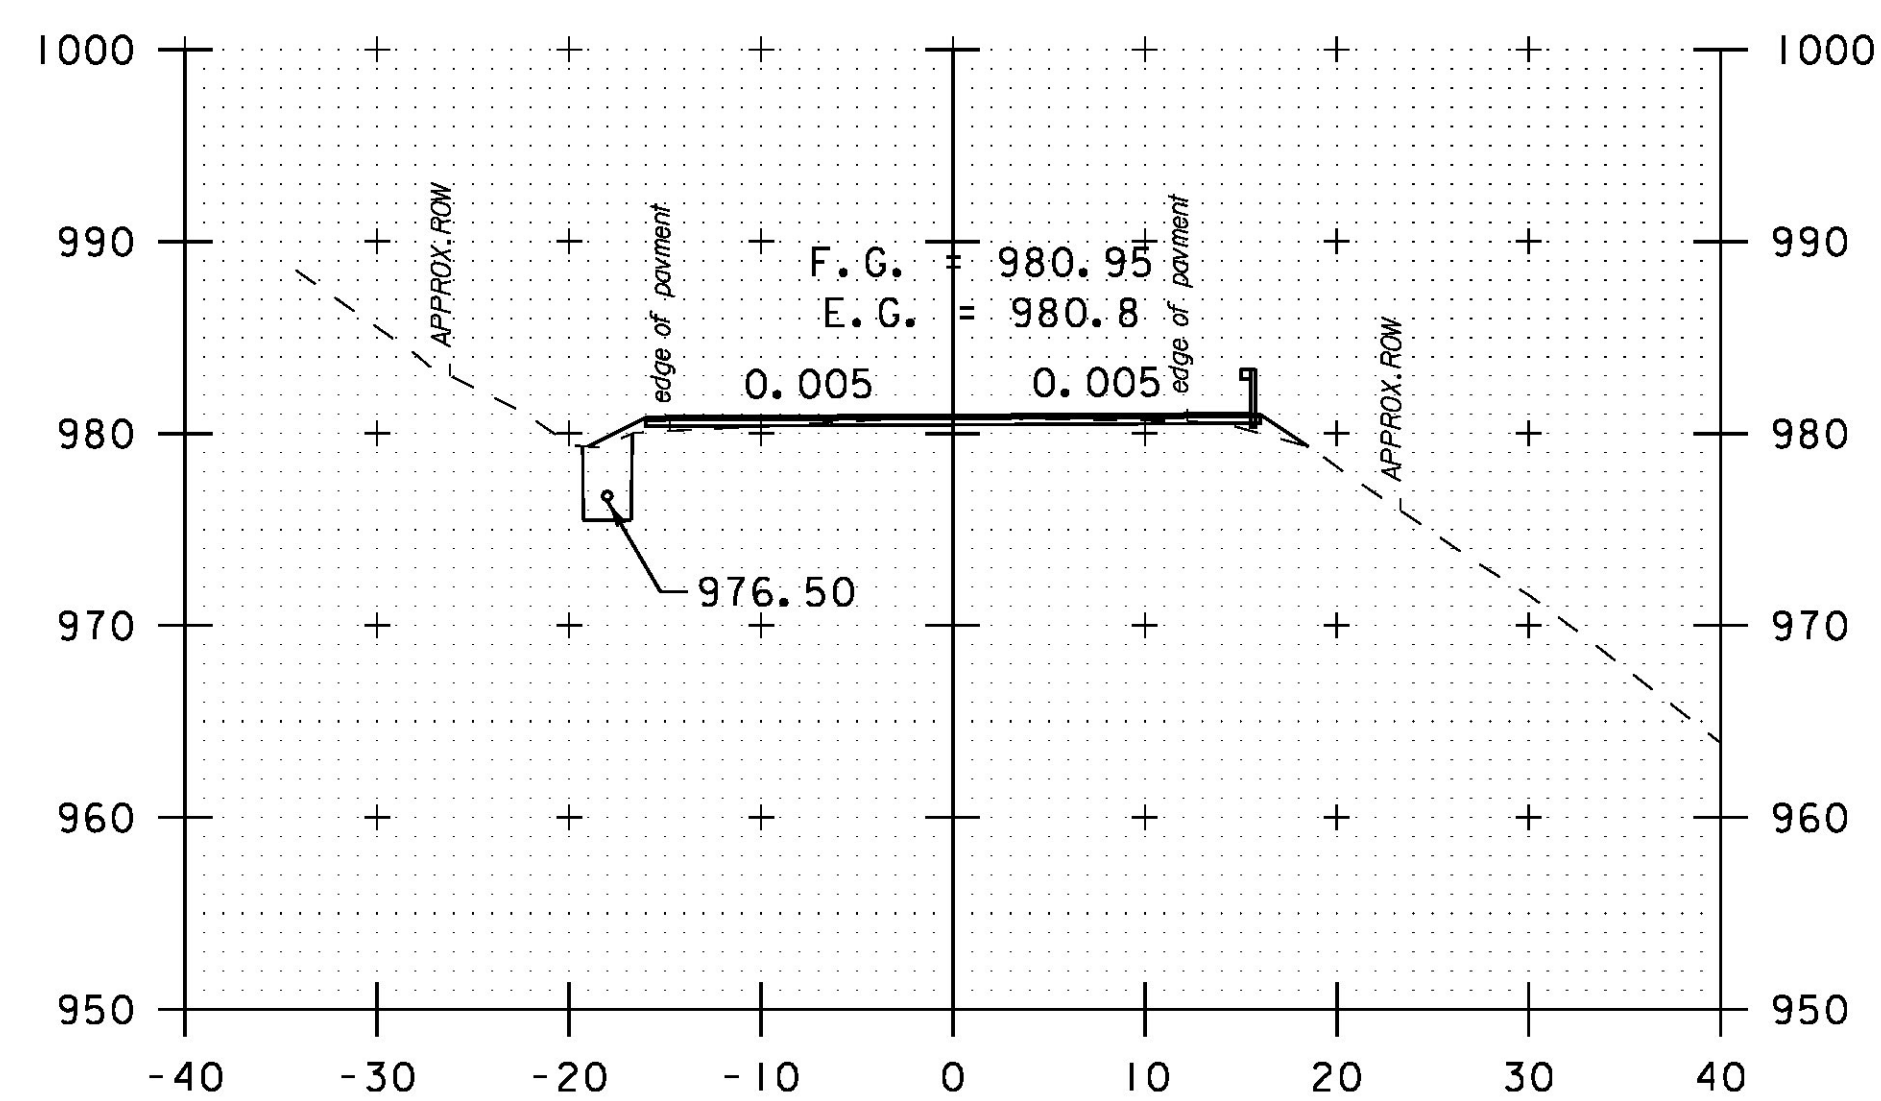

330+00

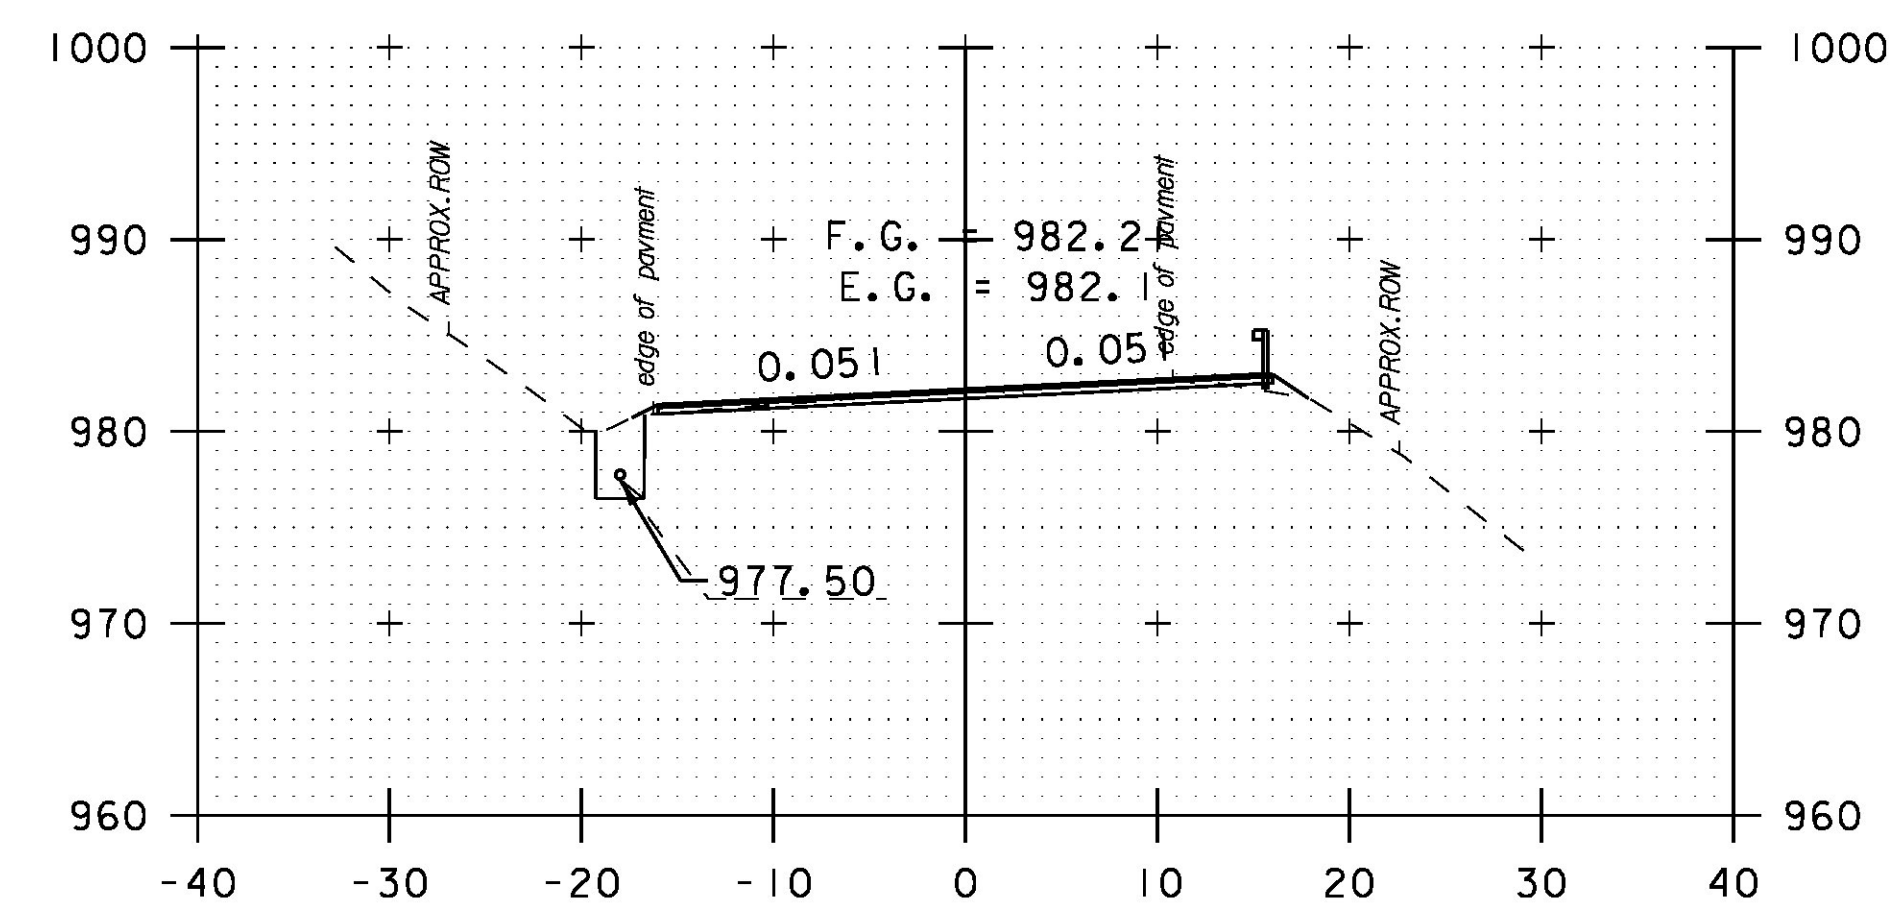

331+00



PROJECT NAME:	HANCOCK	PLOT DATE:	3/18/2015
PROJECT NUMBER:	STP 2923 (1)	DRAWN BY:	B. MARTIN
FILE NAME:	z10c252xs.dgn	CHECKED BY:	C. LATHROP
PROJECT LEADER:	C. LATHROP	CROSS SECTION SHEET:	64
DESIGNED BY:	B. MARTIN	SHEET:	191 OF 207