
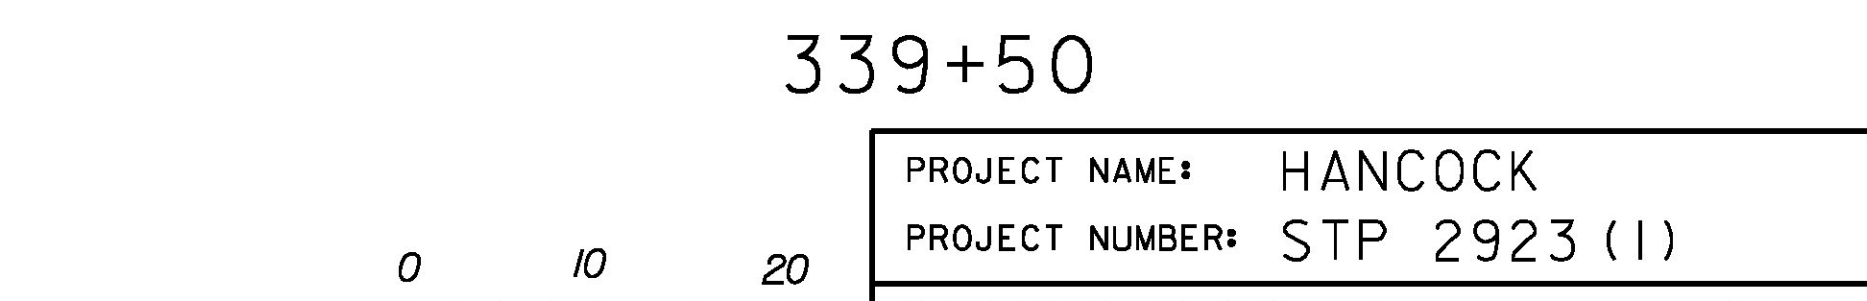
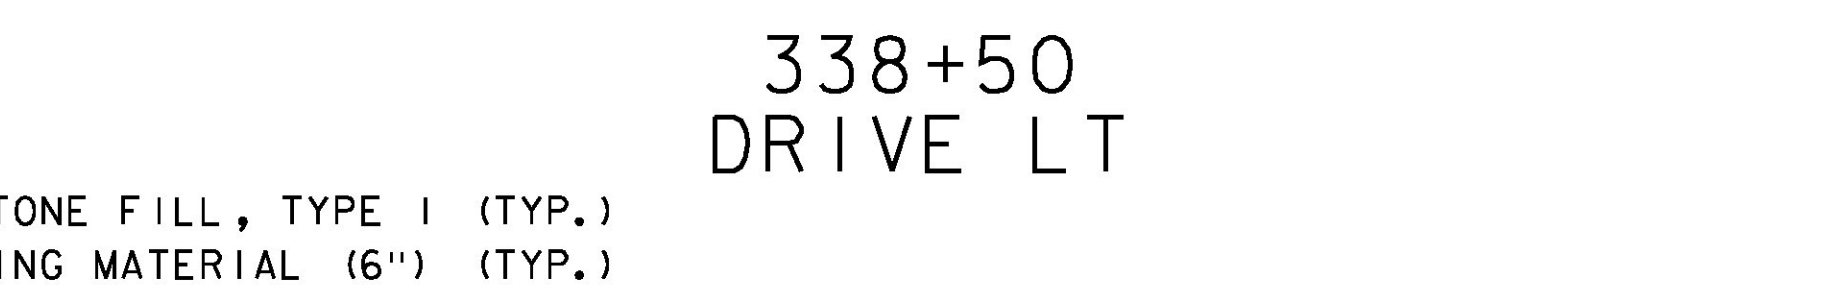
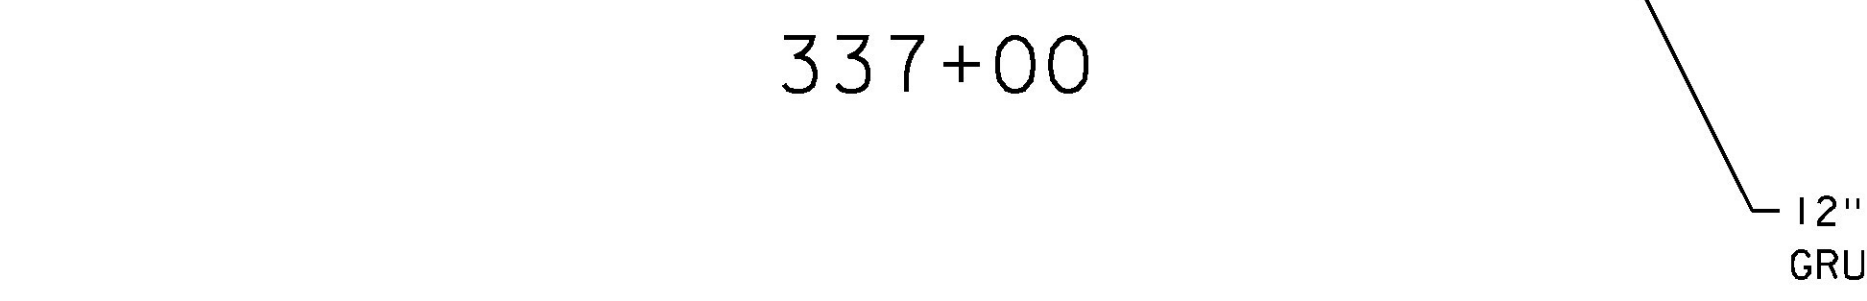
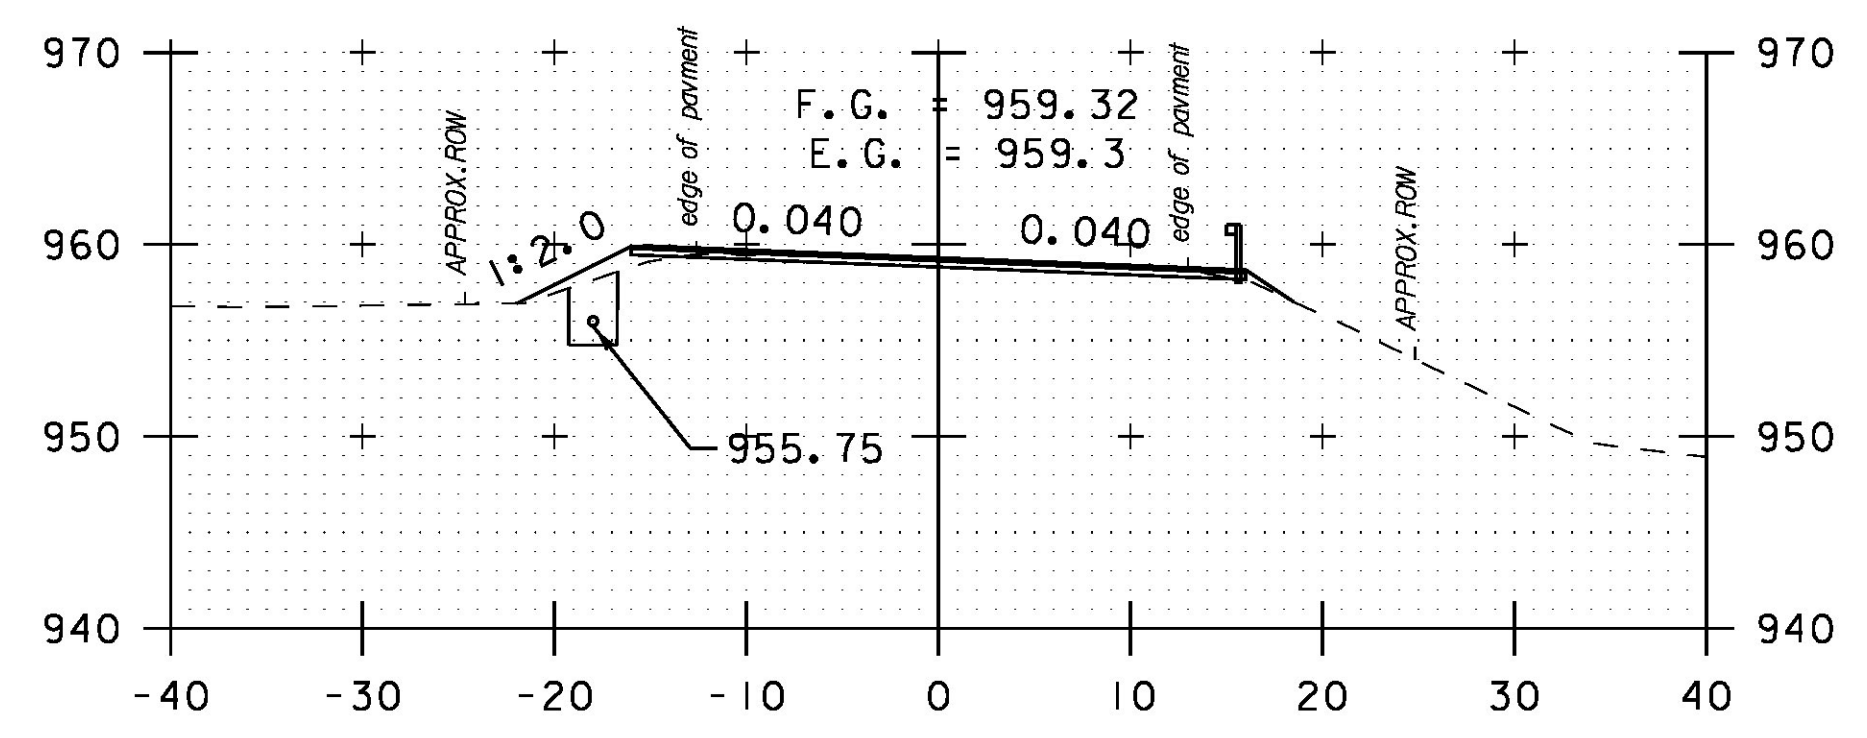
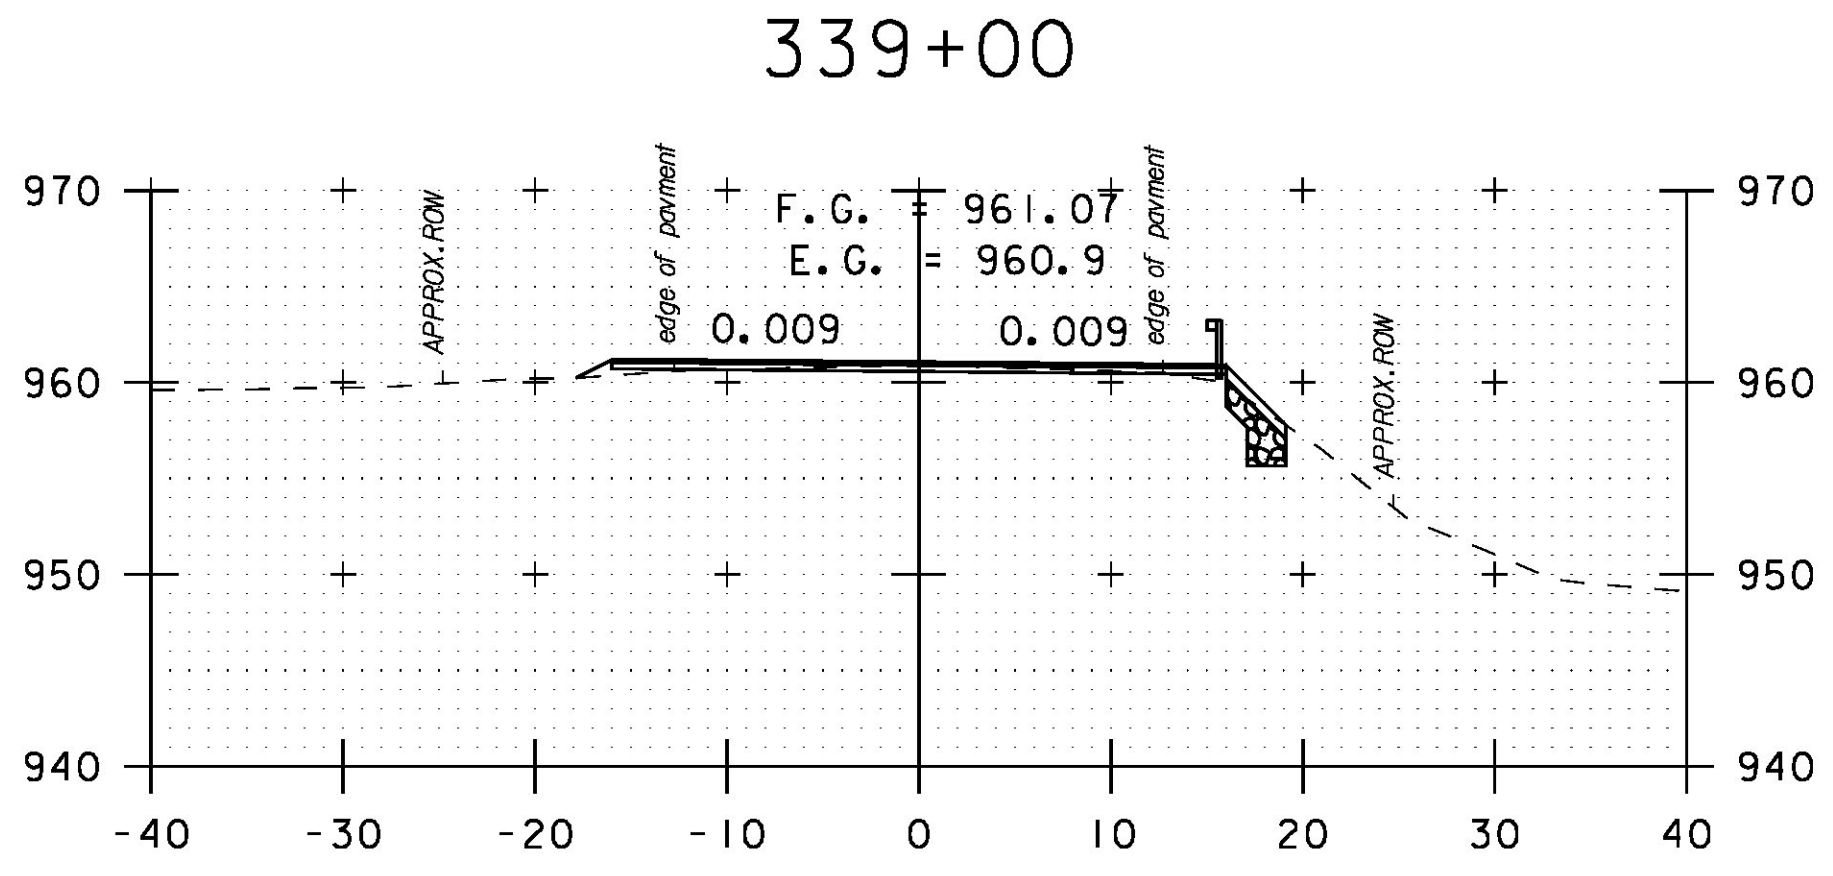
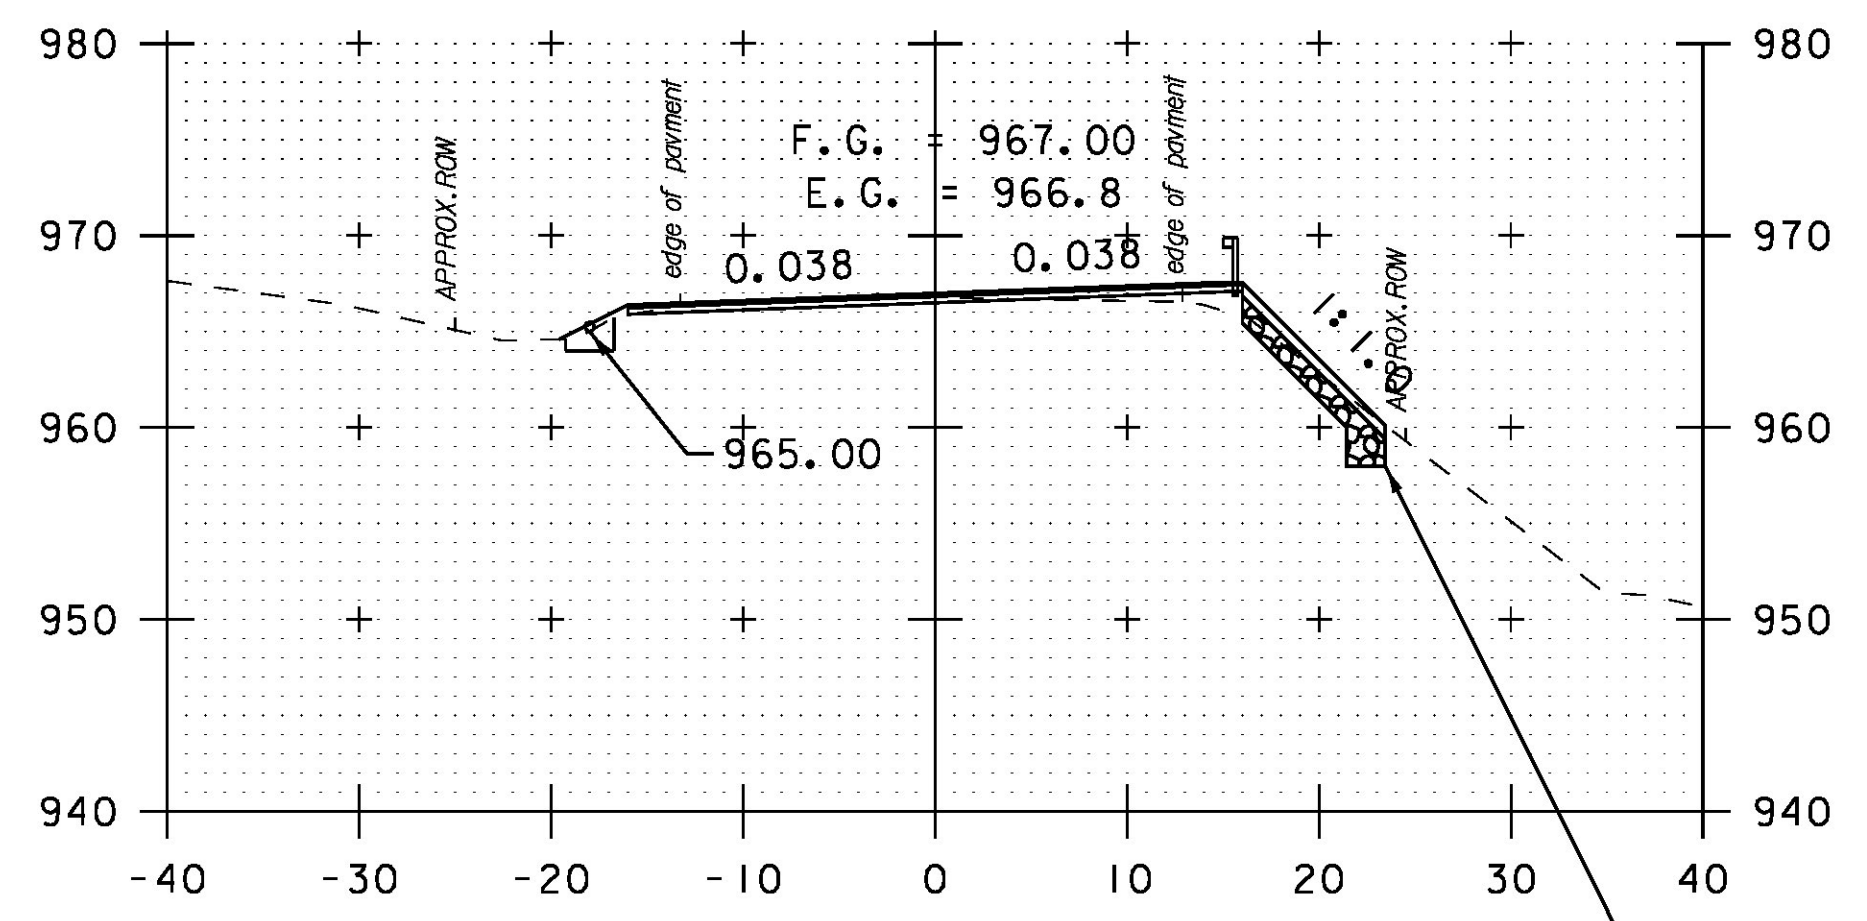
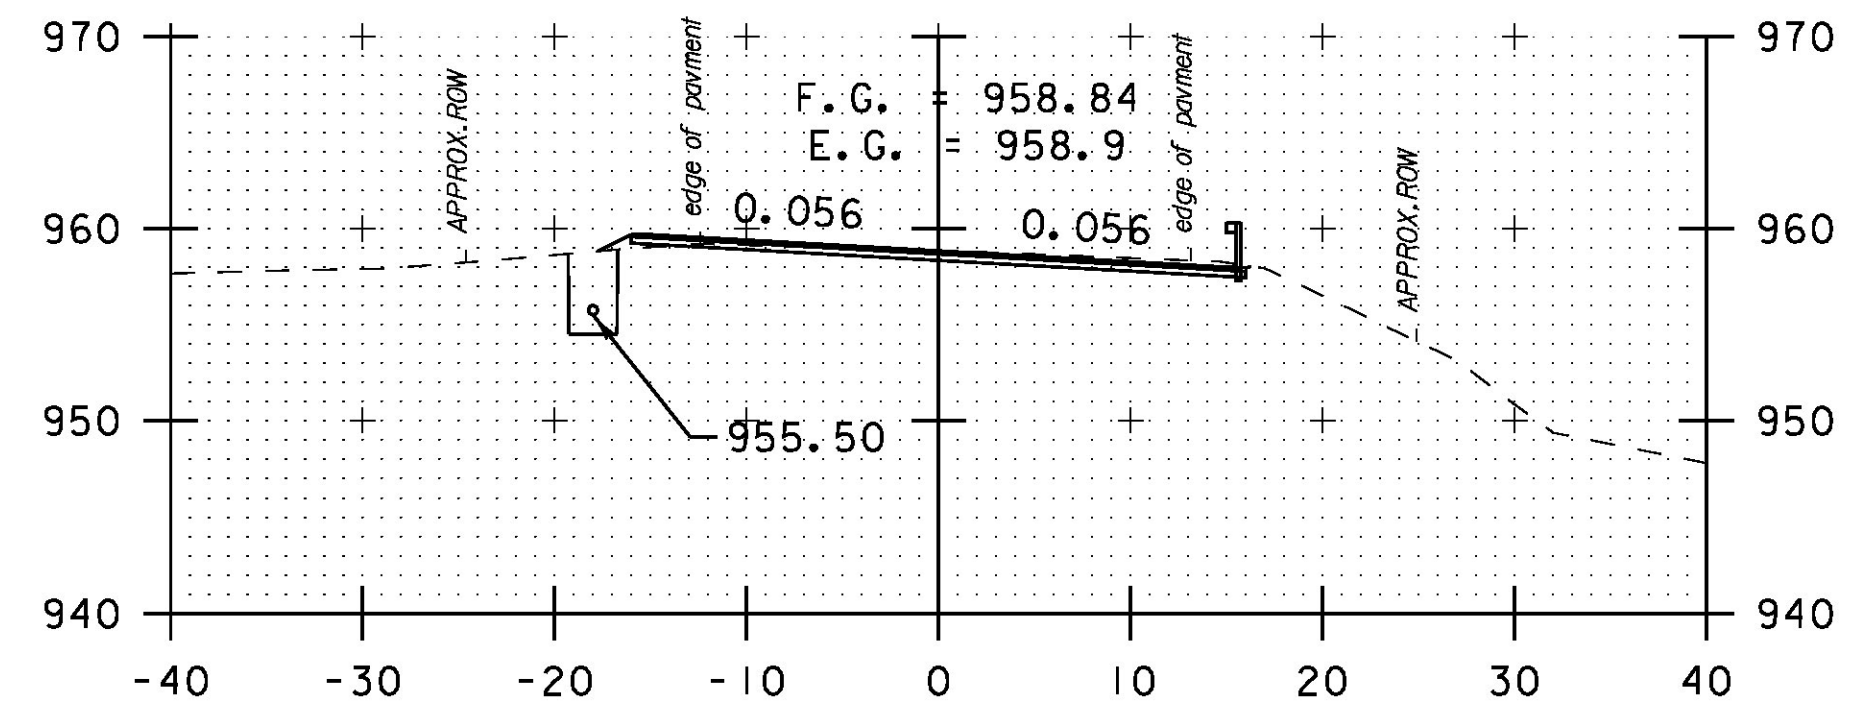
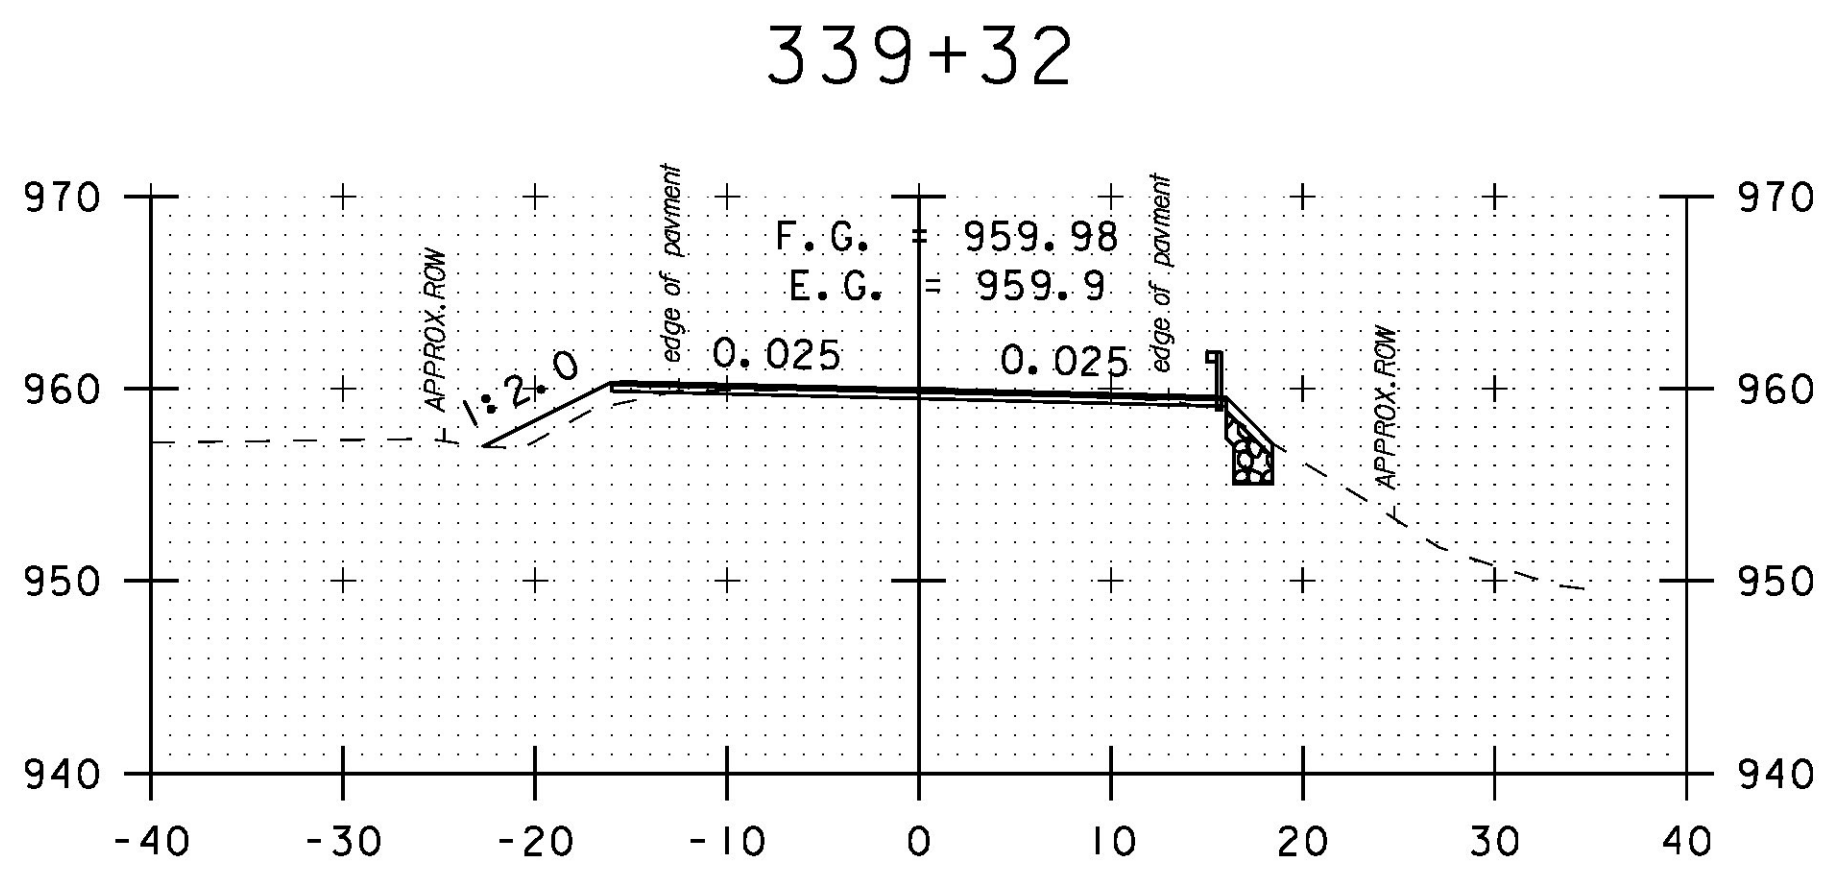
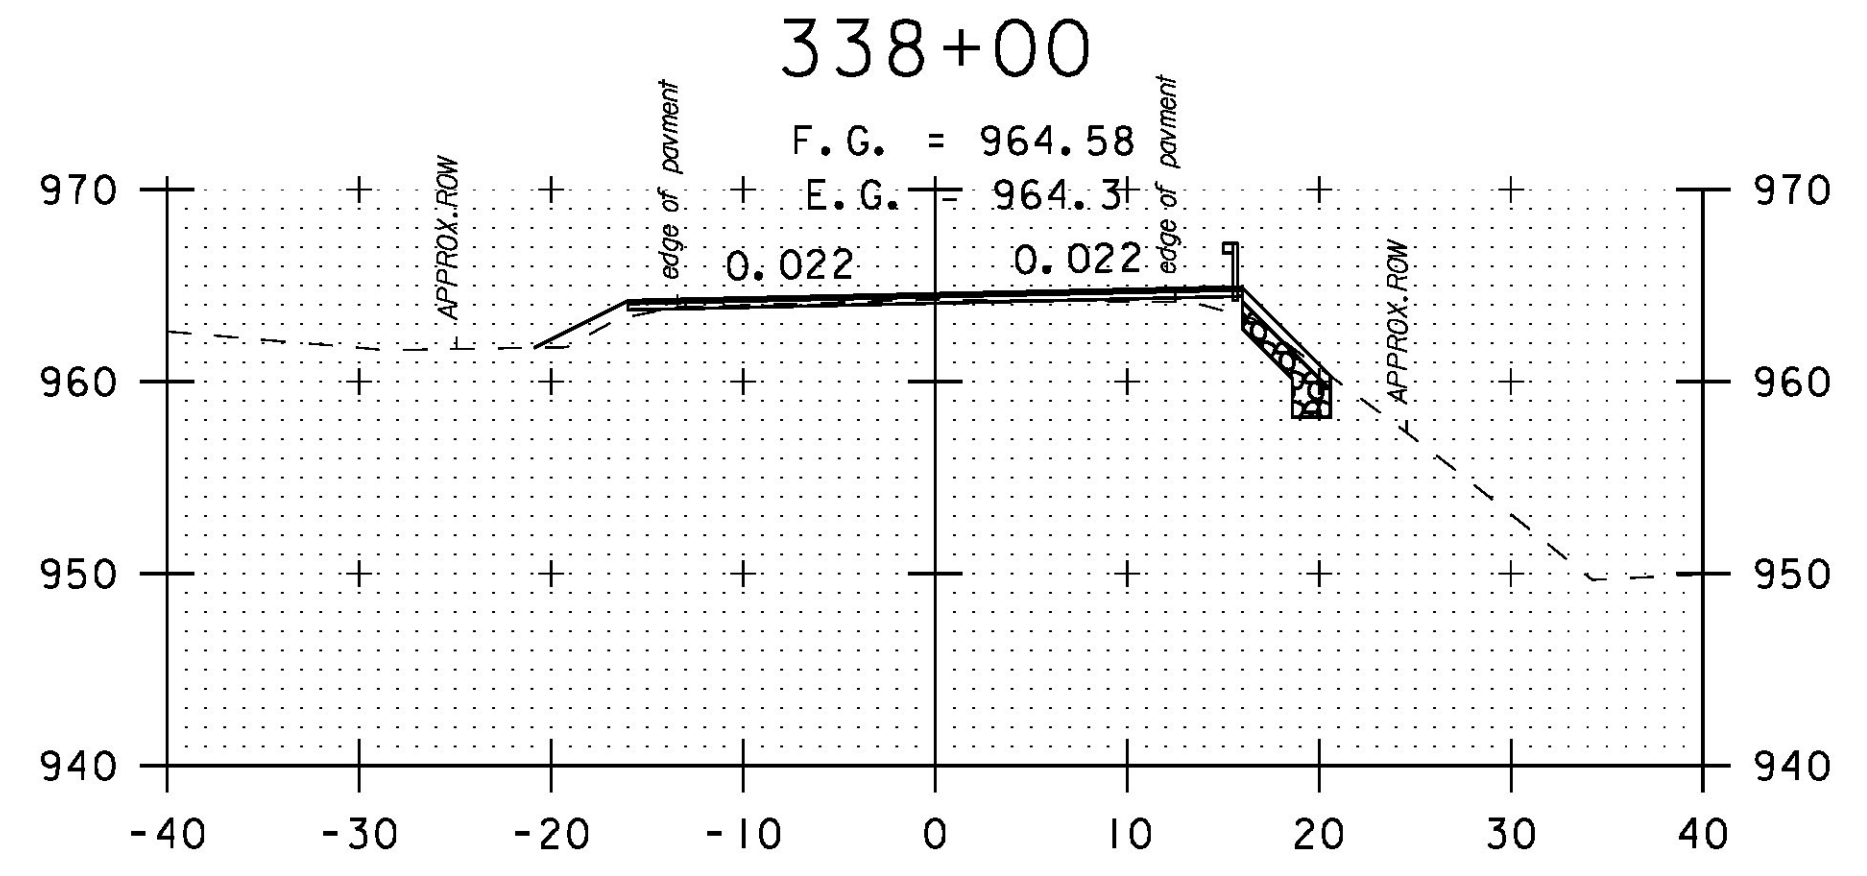
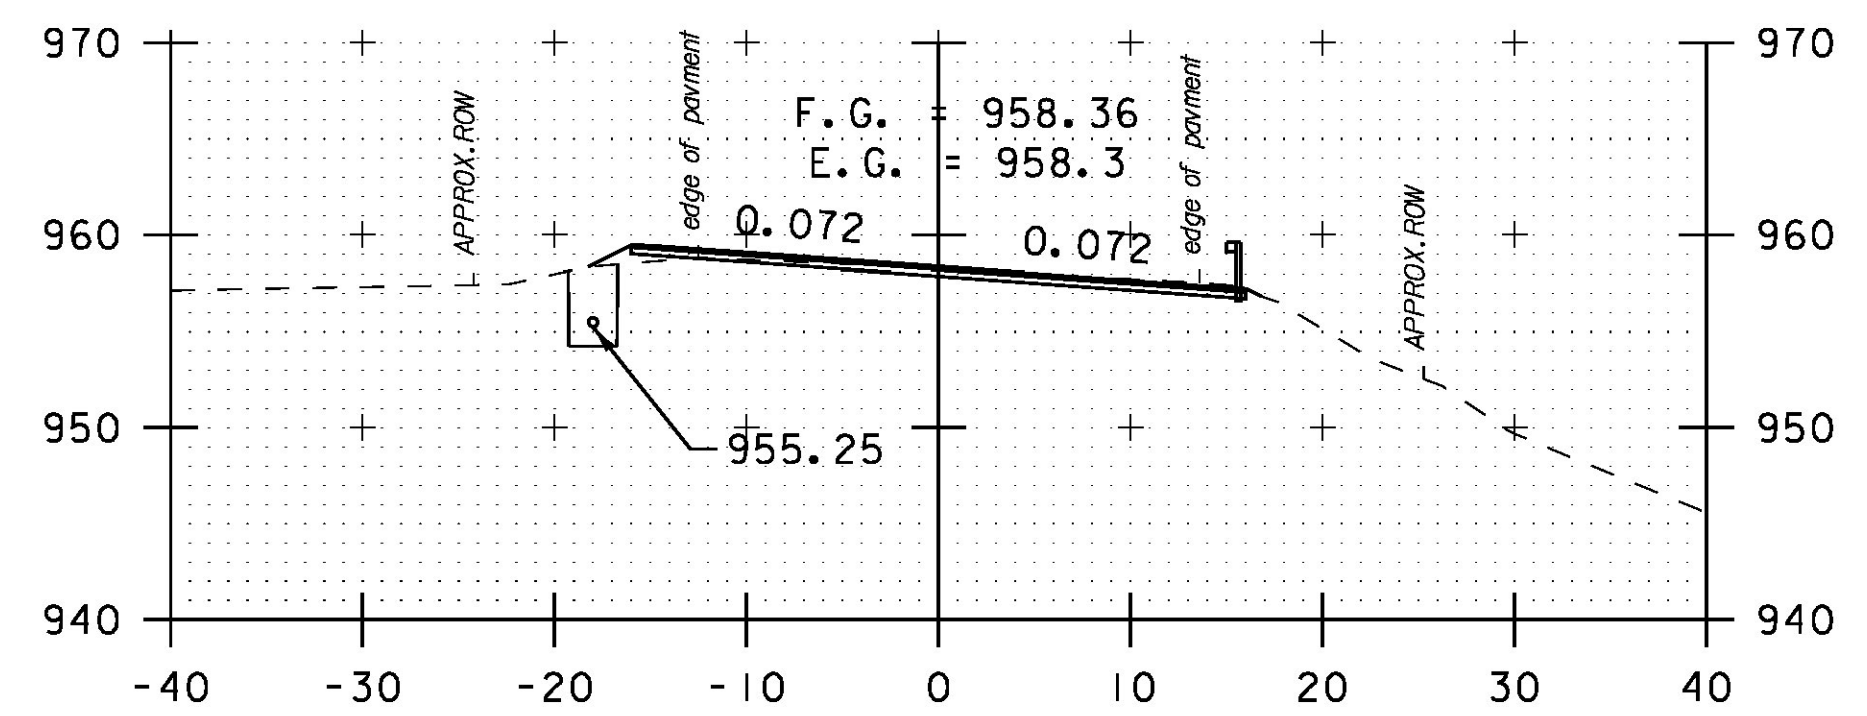
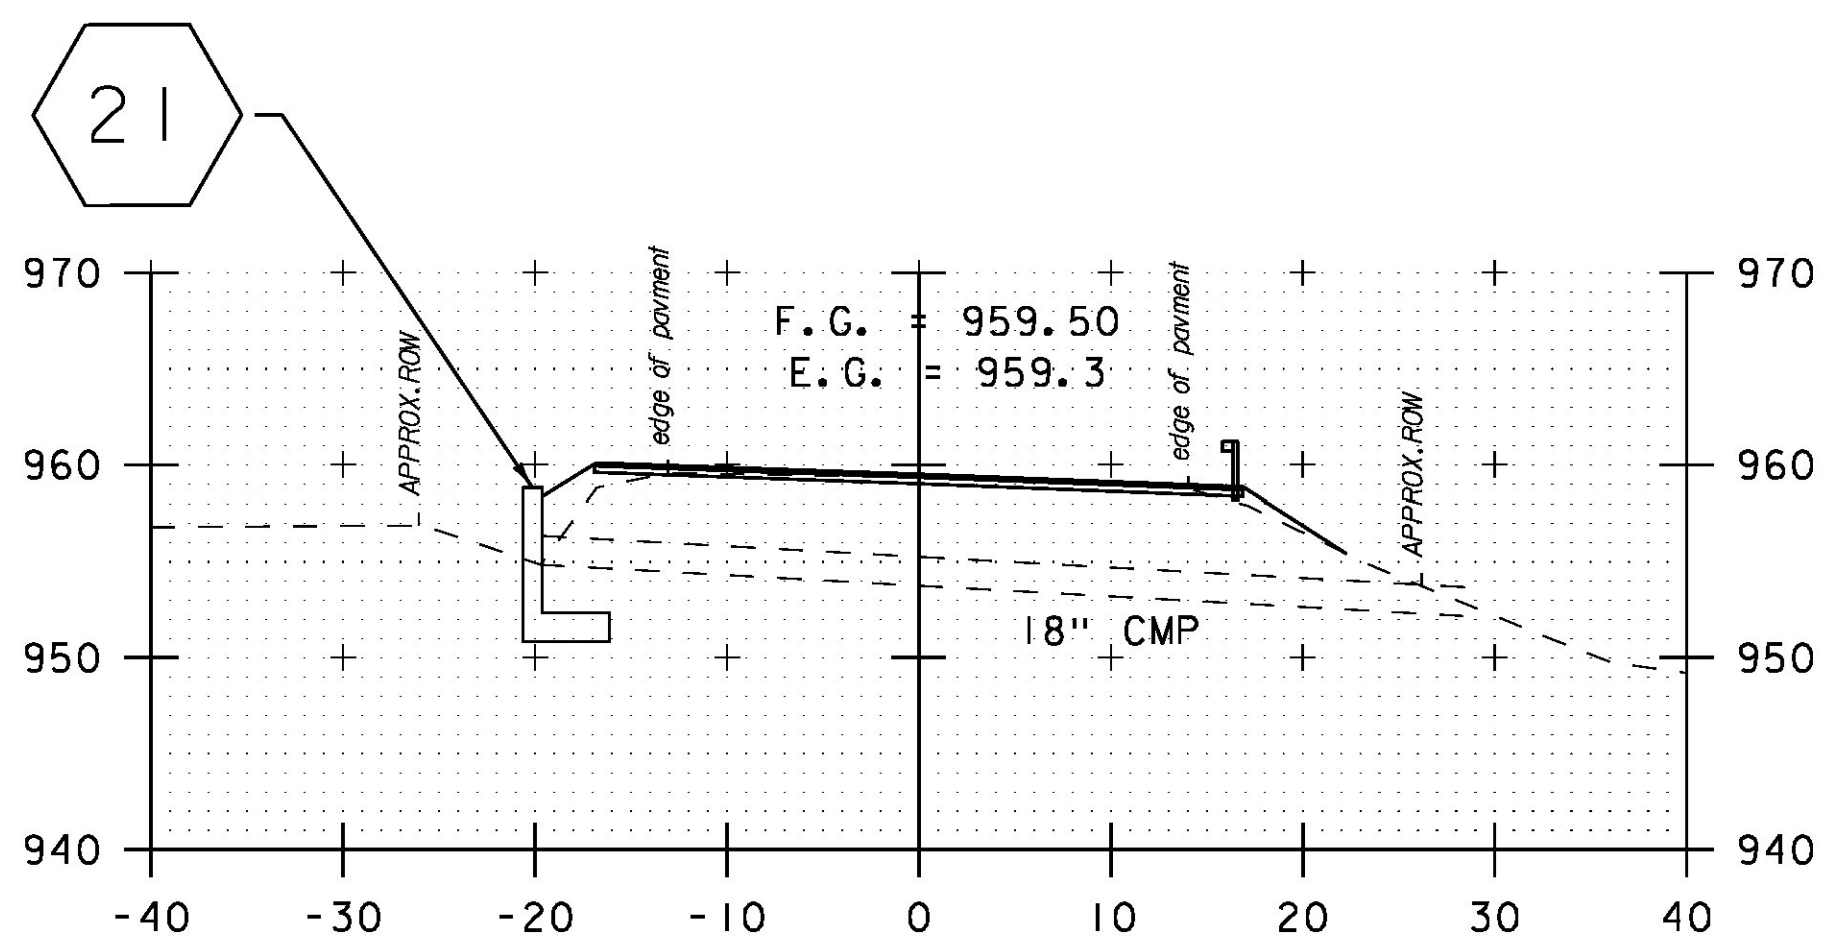


21

STA. 339+25.81 LT 19.64' TO
 STA. 339+41.42 RT 26.89'
 CONSTRUCT CONCRETE REINFORCED
 HEADWALL PER STD. D-33. USE
 SCHEDULING AND DIMENSIONS FOR
 42" PIPE, LT
 INV. IN = 954.84'
 INV. OUT = 952.18'

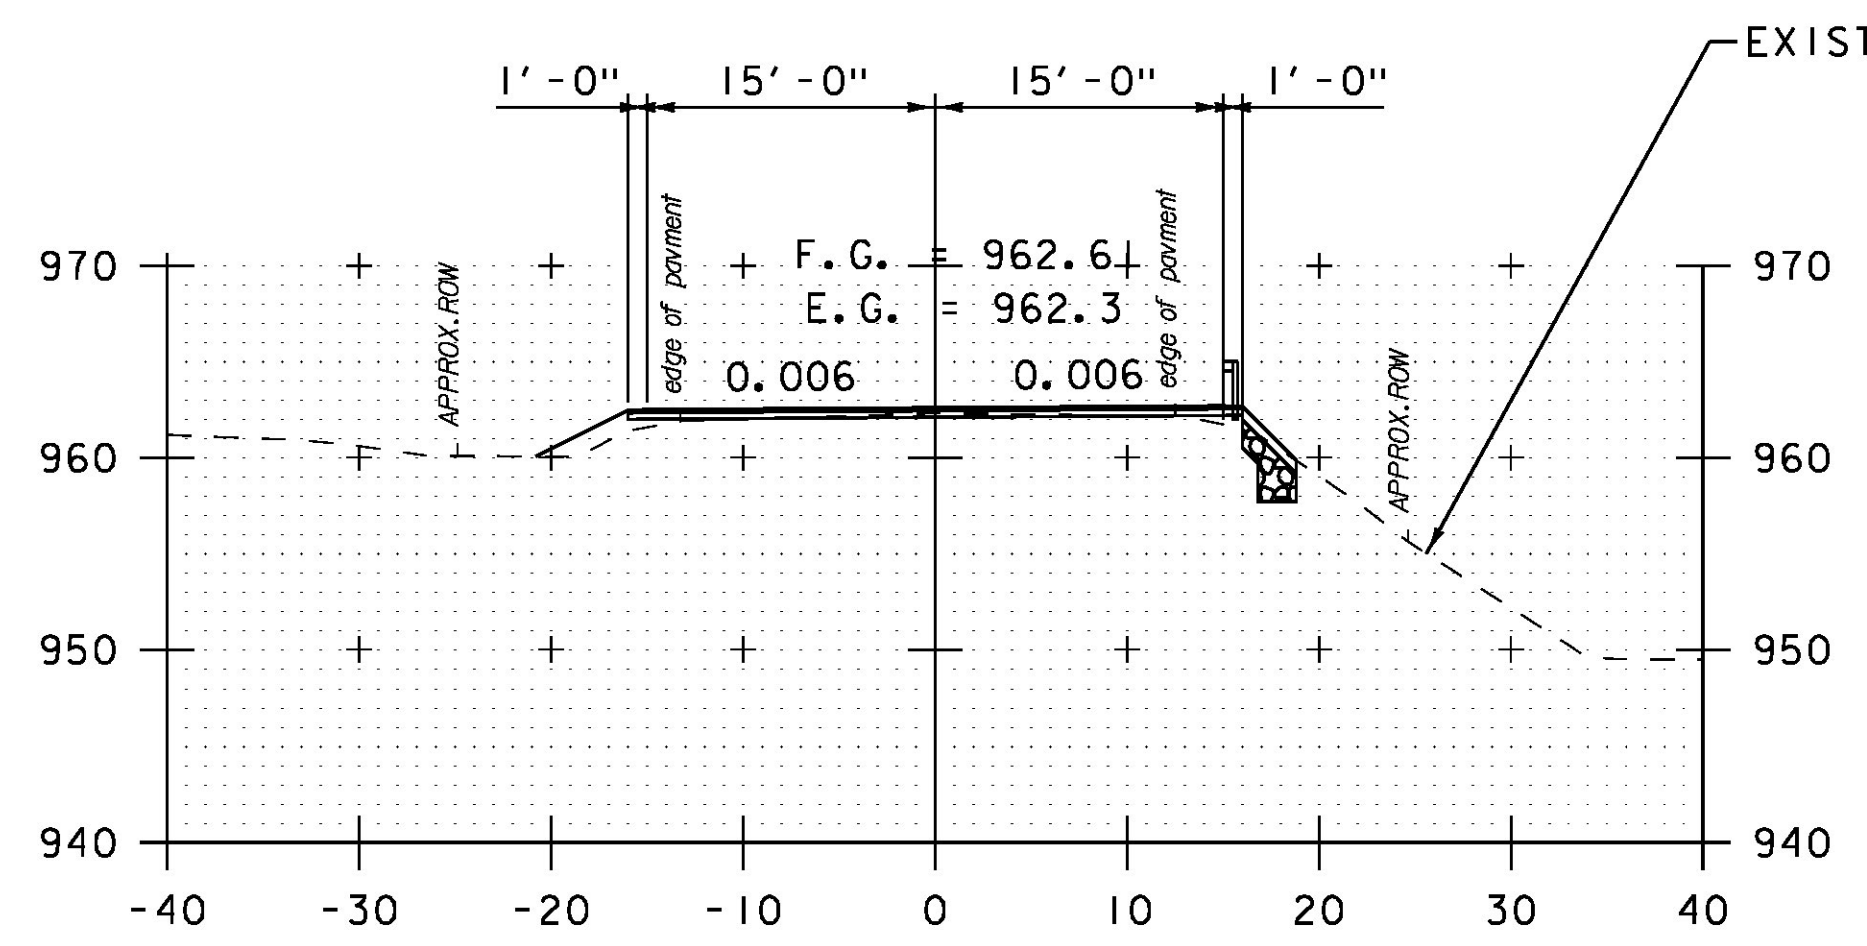

PROJECT NAME: HANCOCK	PLOT DATE: 3/18/2015
PROJECT NUMBER: STP 2923 (1)	DRAWN BY: B. MARTIN
FILE NAME: z10c252xs.dgn	CHECKED BY: C. LATHROP
PROJECT LEADER: C. LATHROP	SHEET 193 OF 207
DESIGNED BY: B. MARTIN	
CROSS SECTION SHEET 66	