




342+00

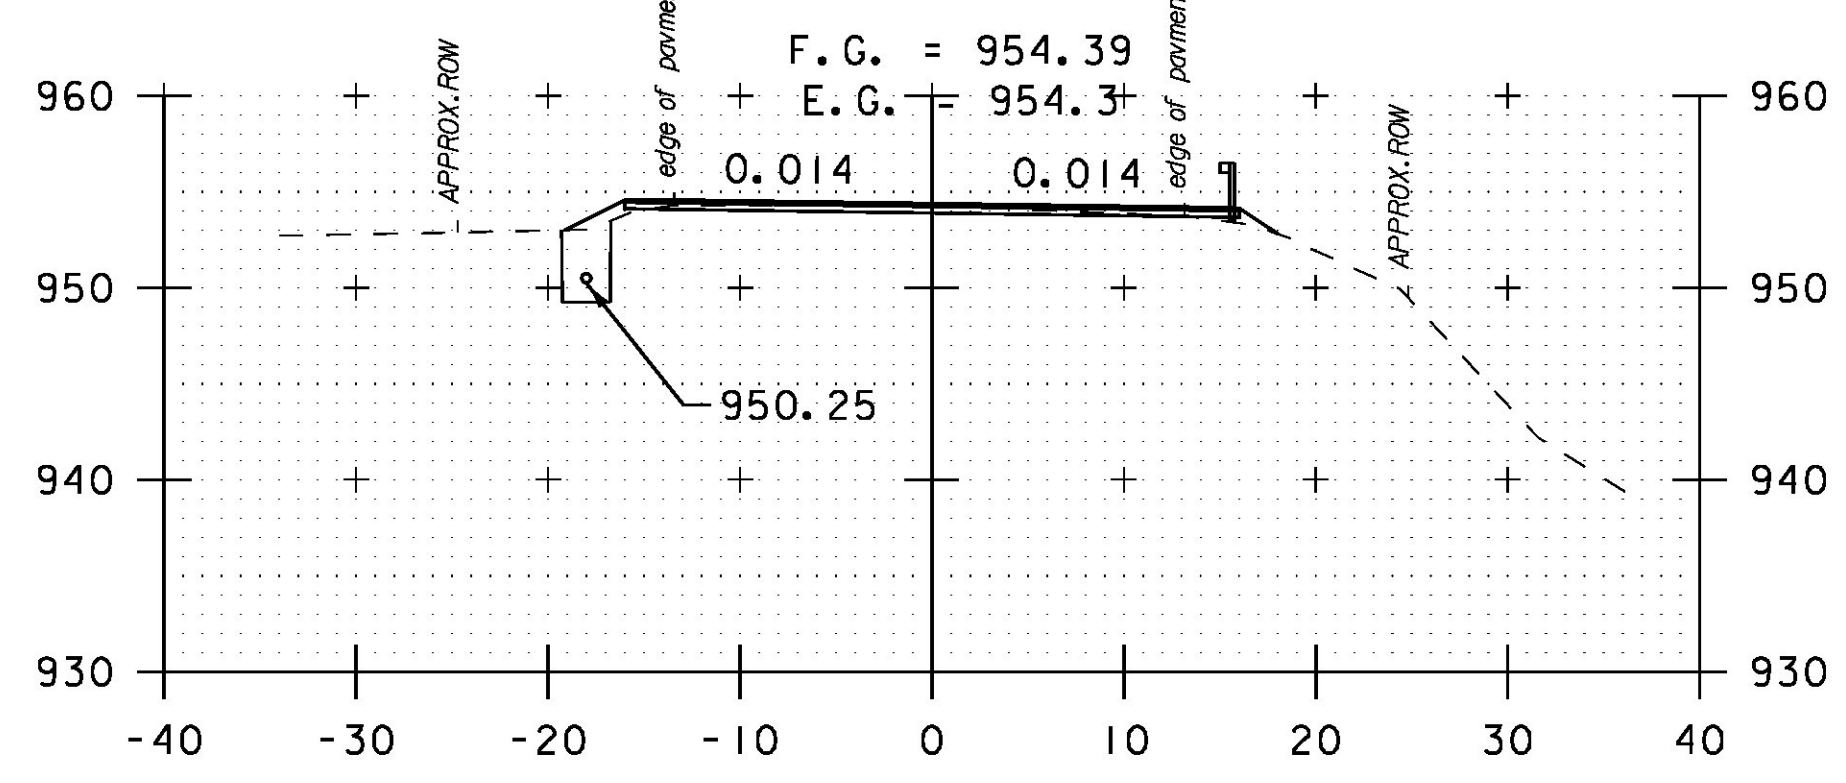


343+50

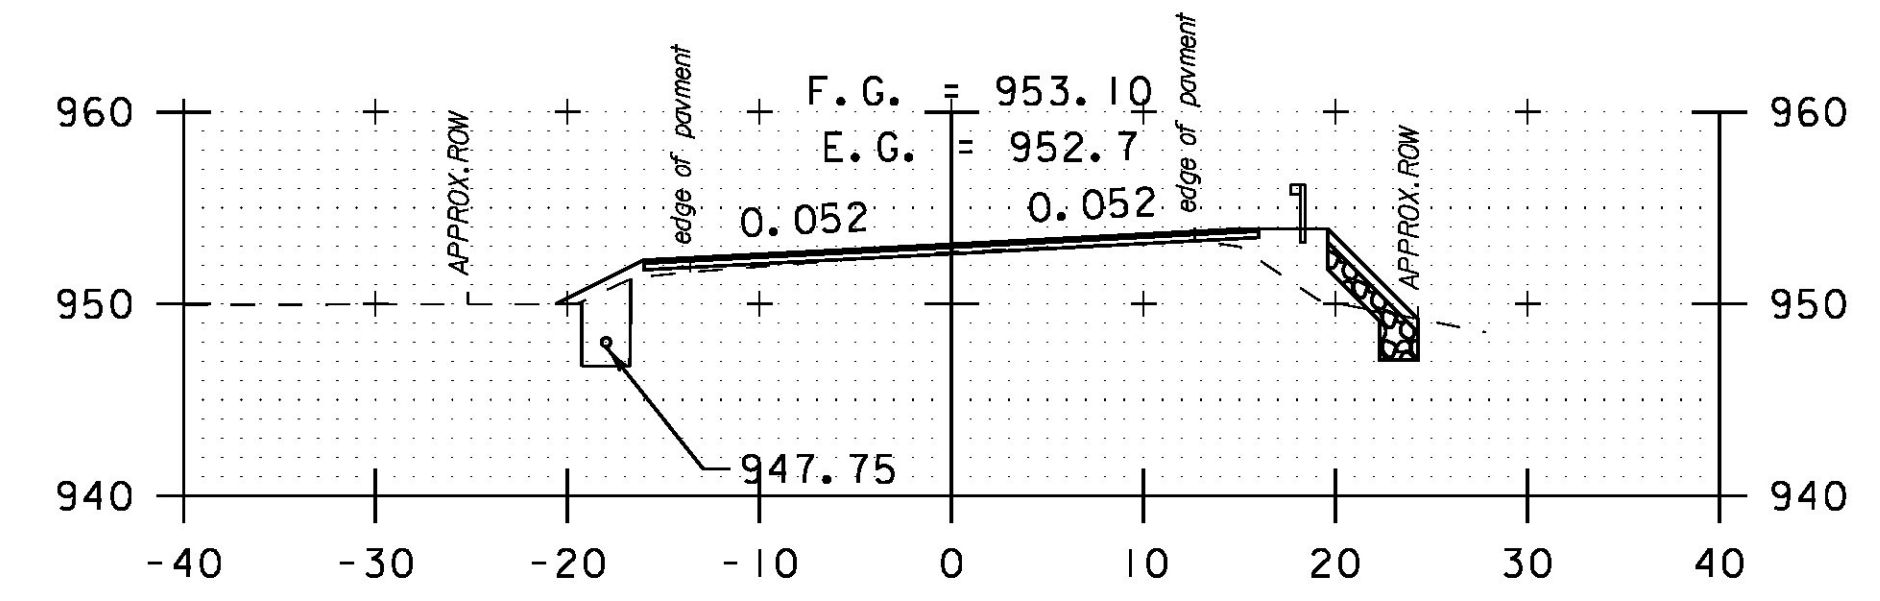


345+00

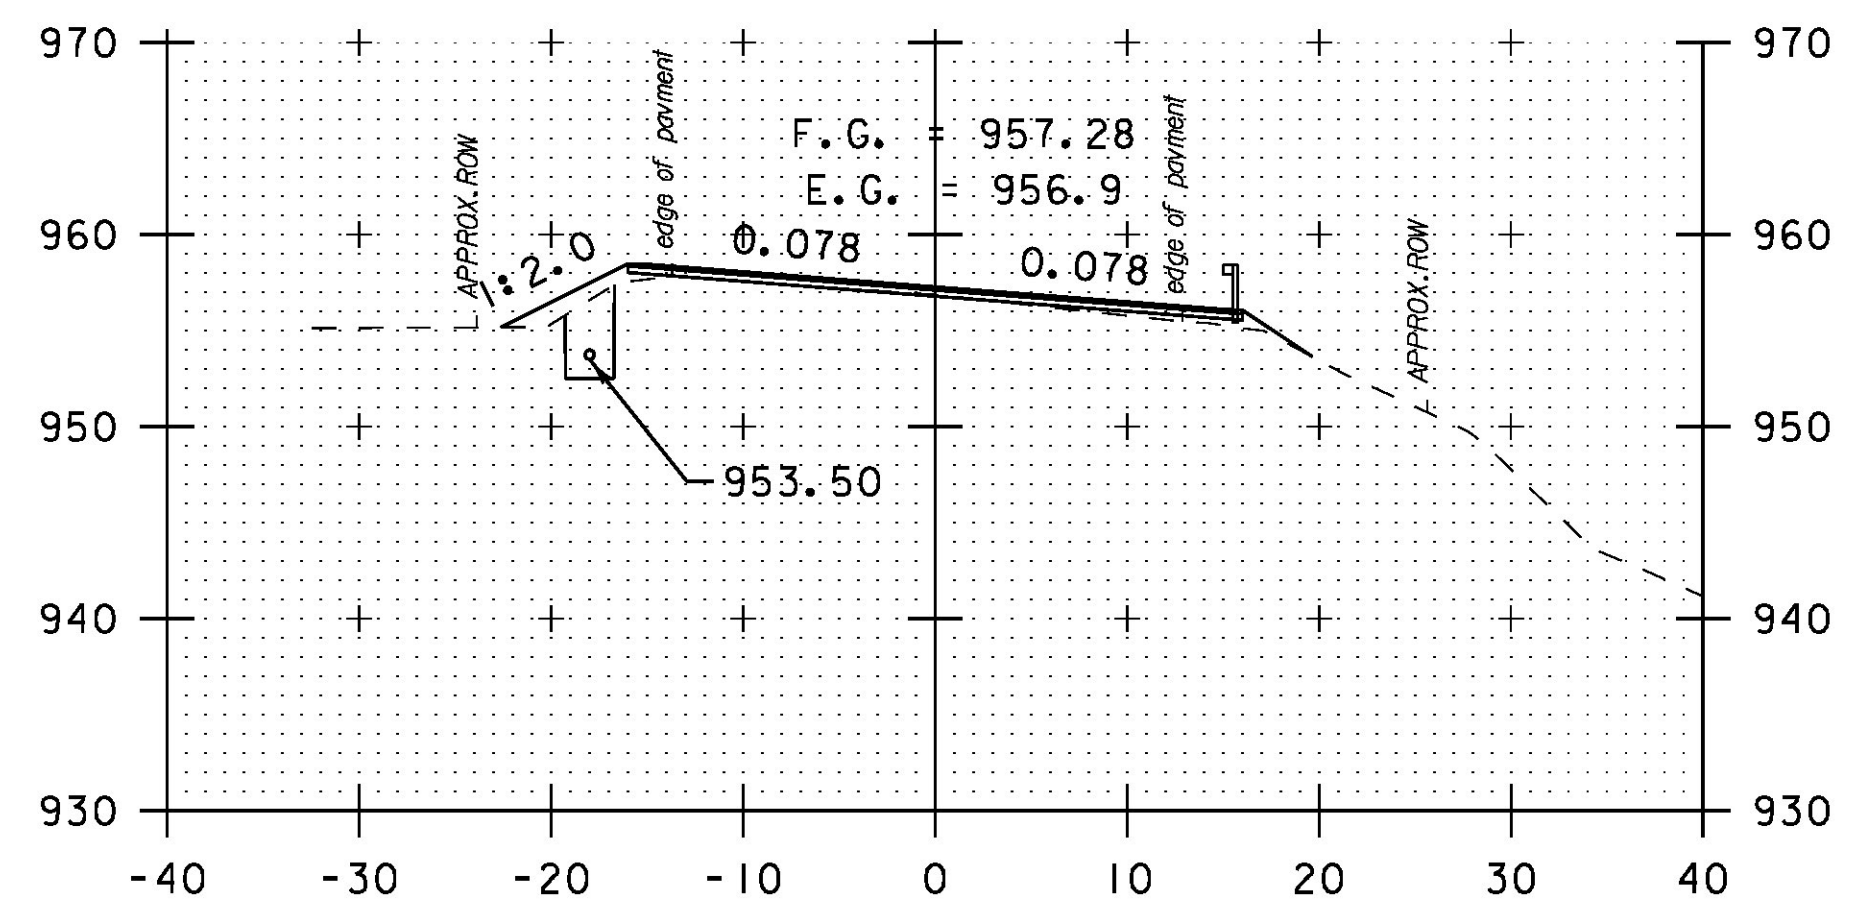


341+50

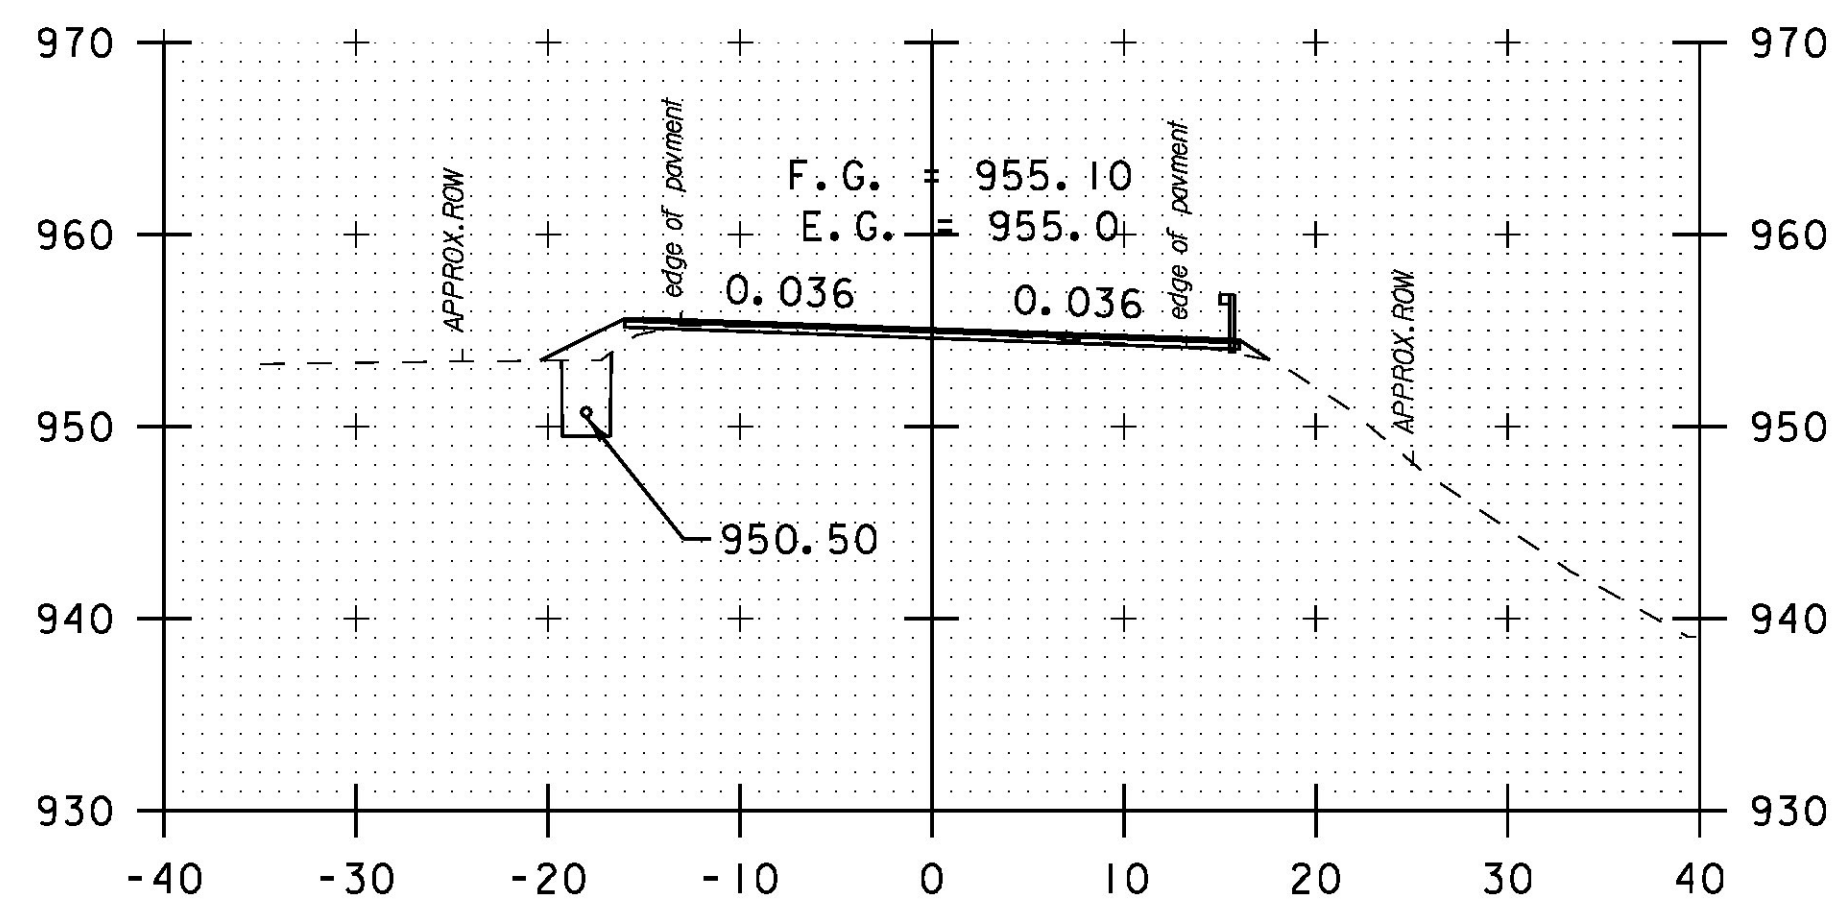


343+00

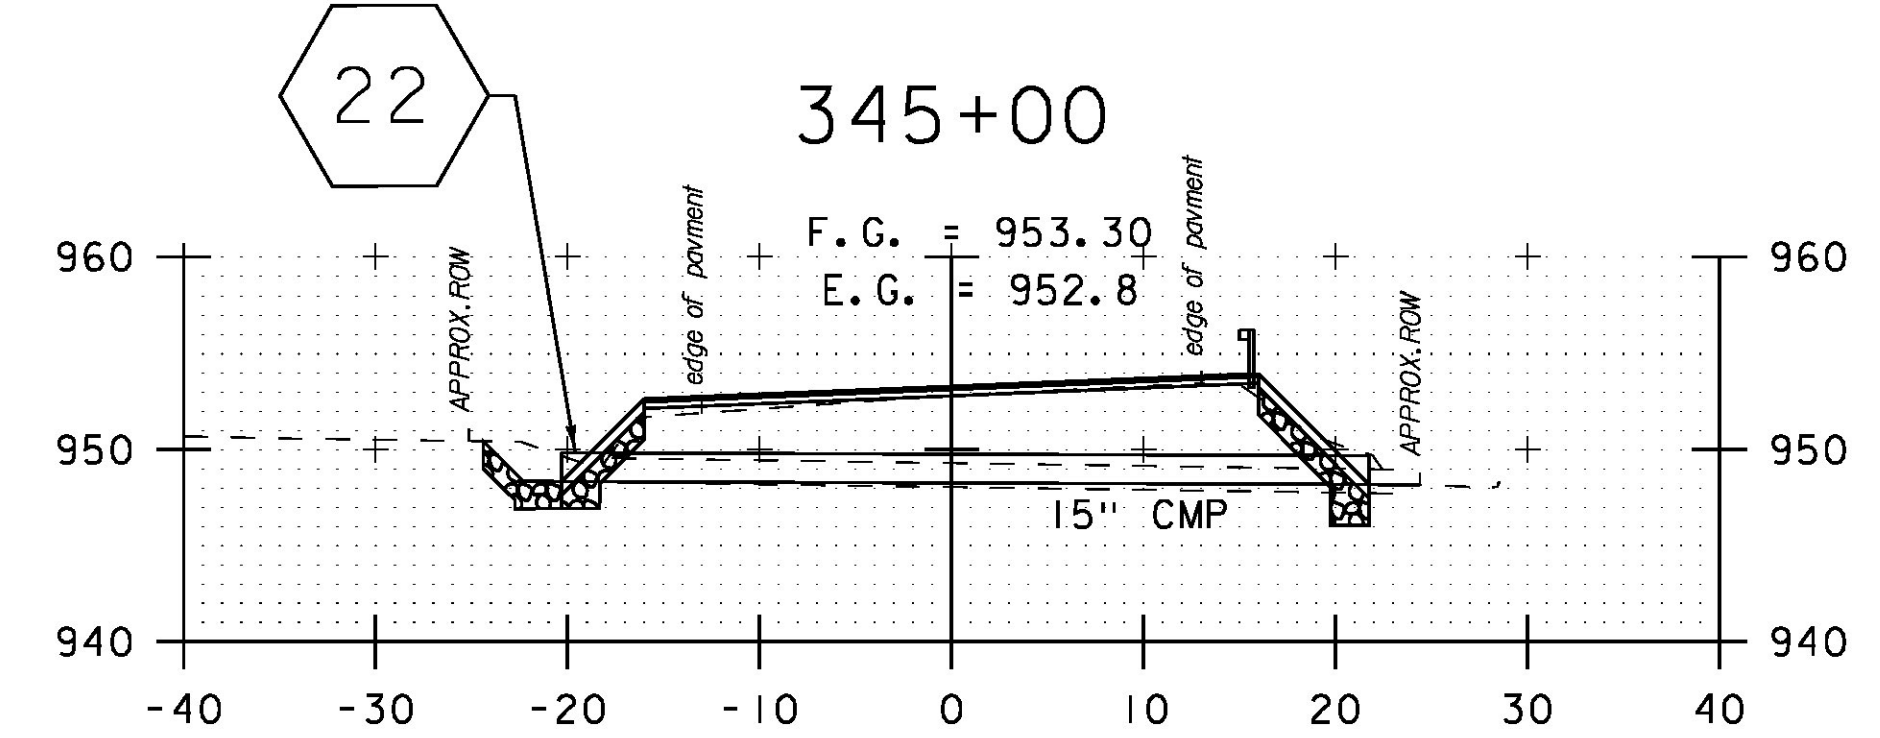


344+76
SKEWED

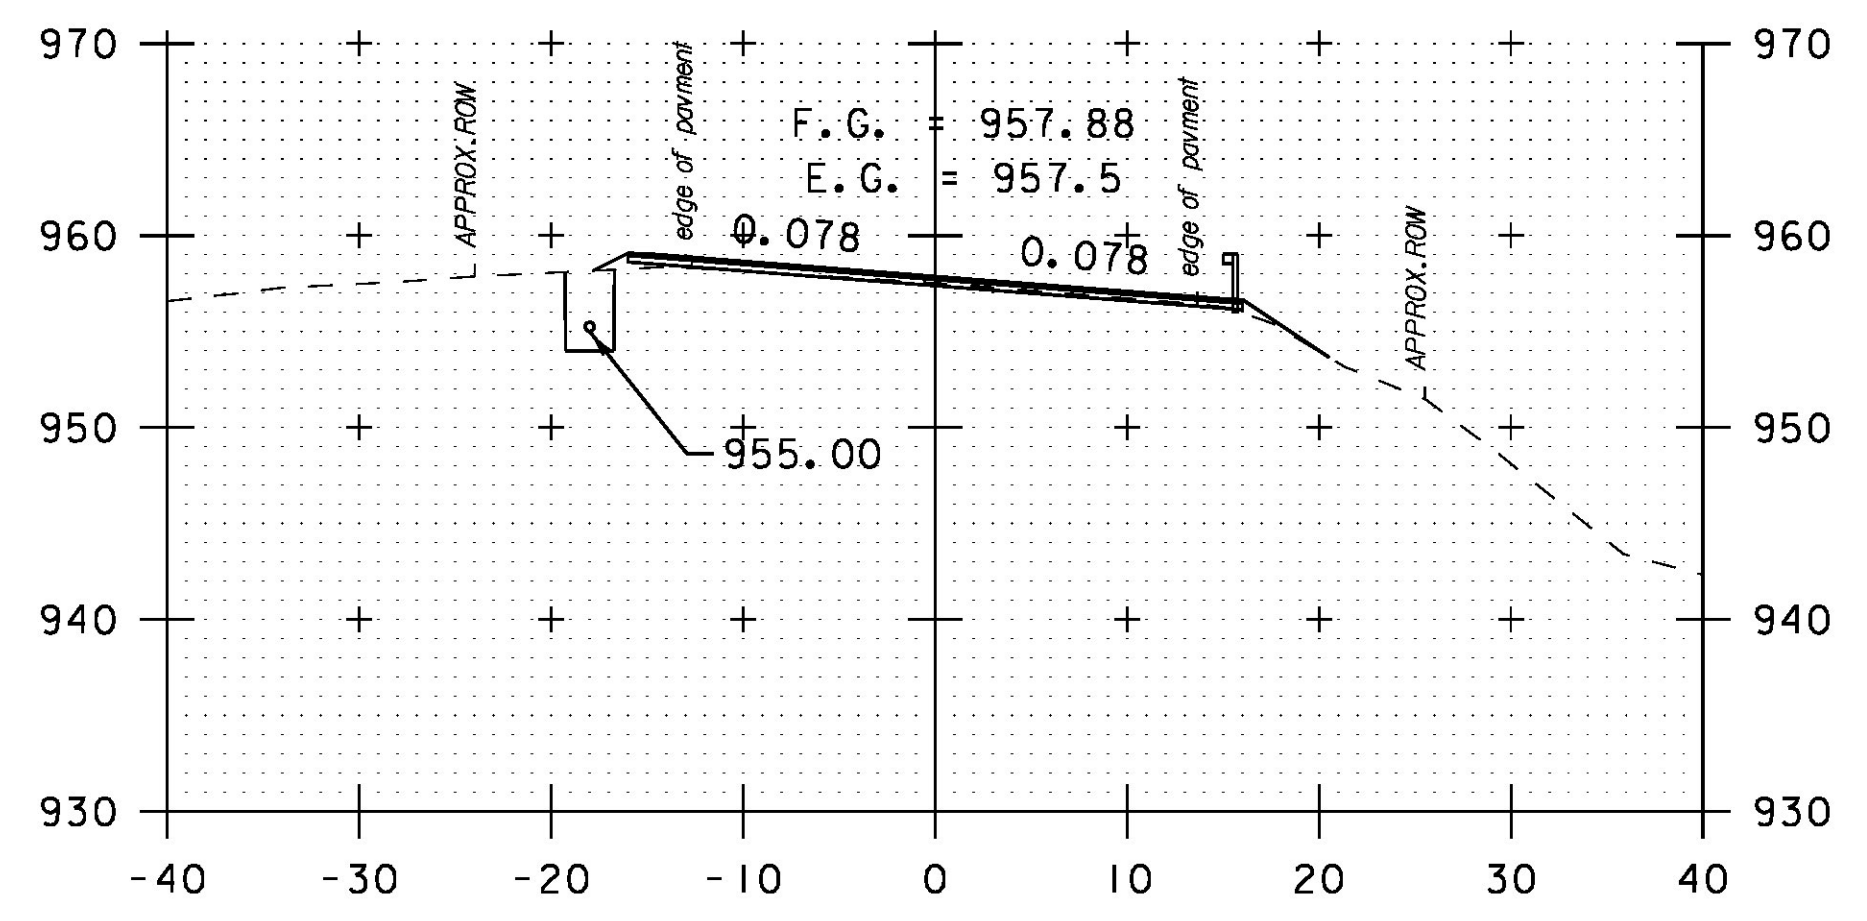


341+00
SKEWED

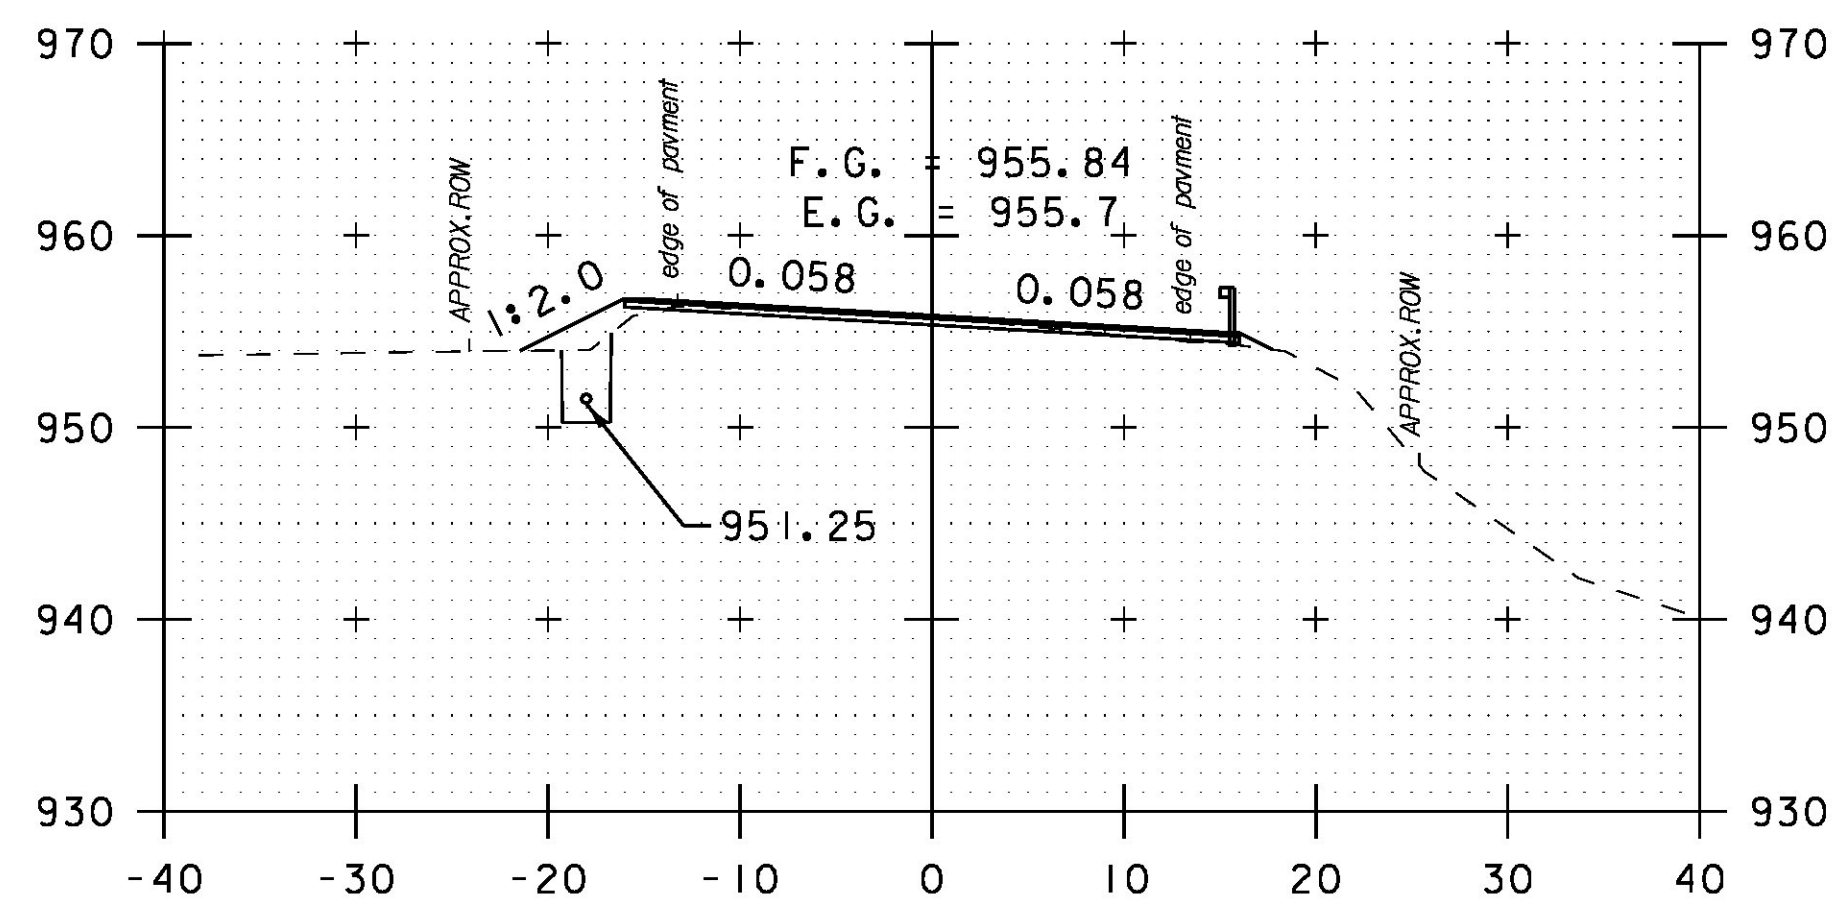

342+50

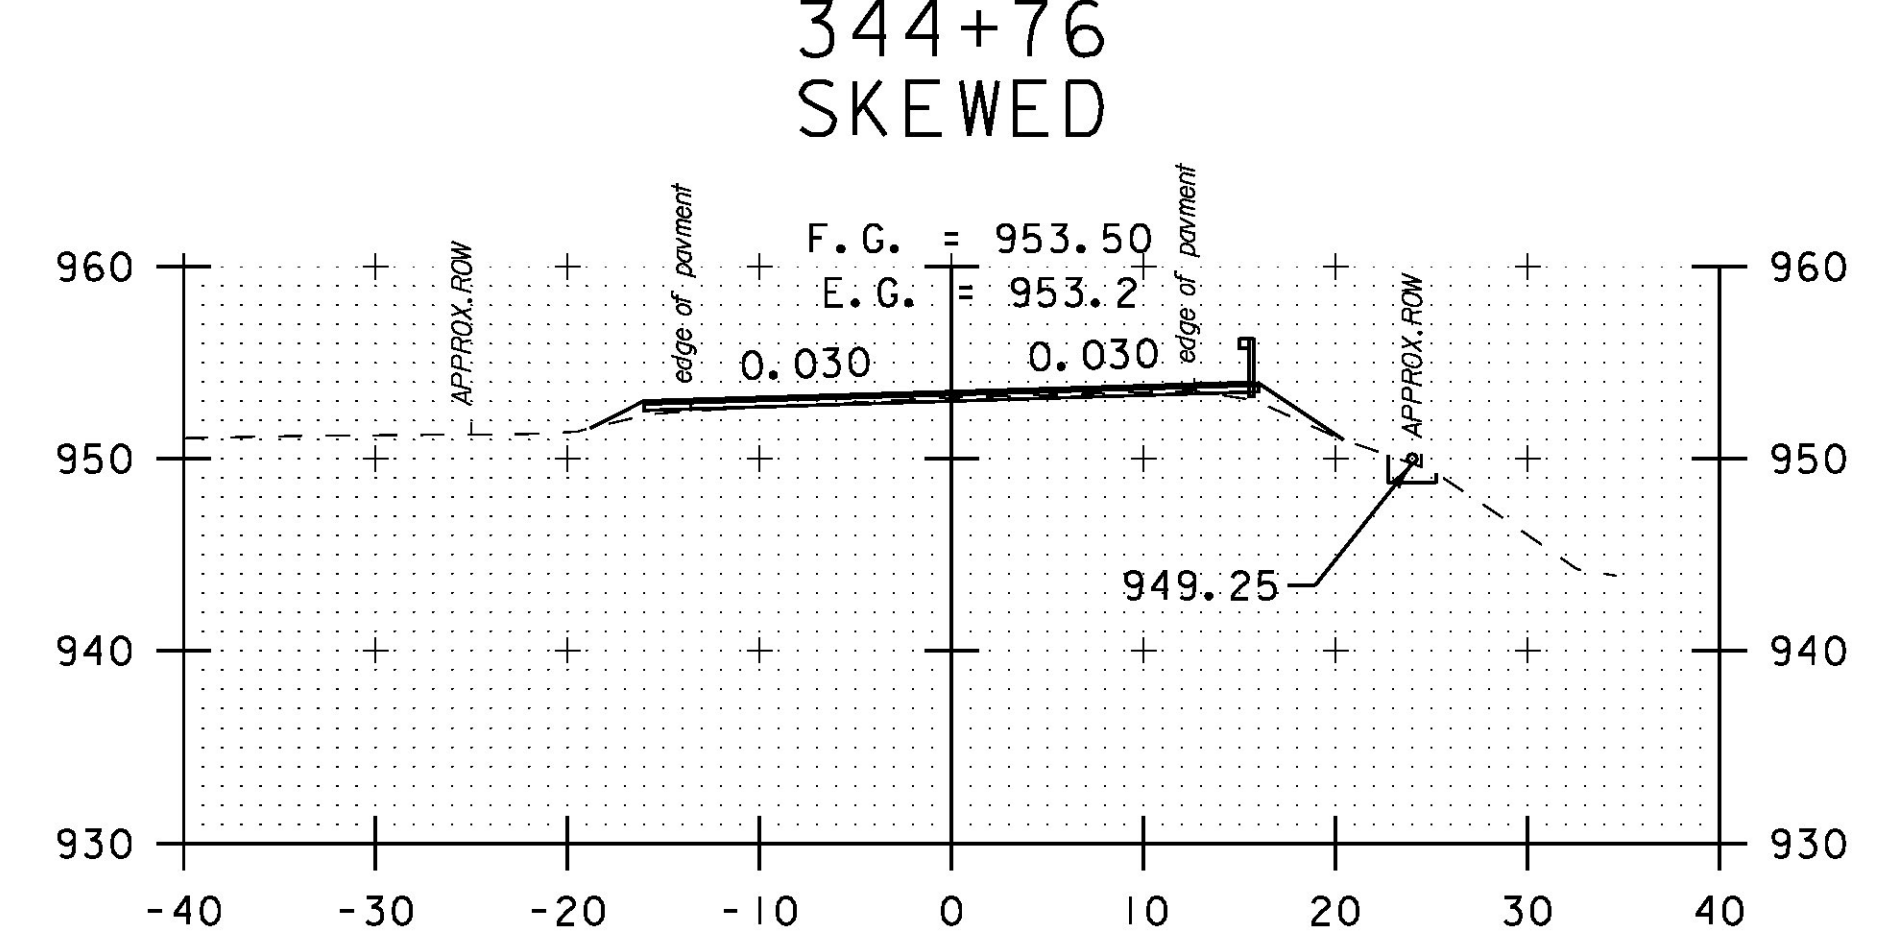

344+50

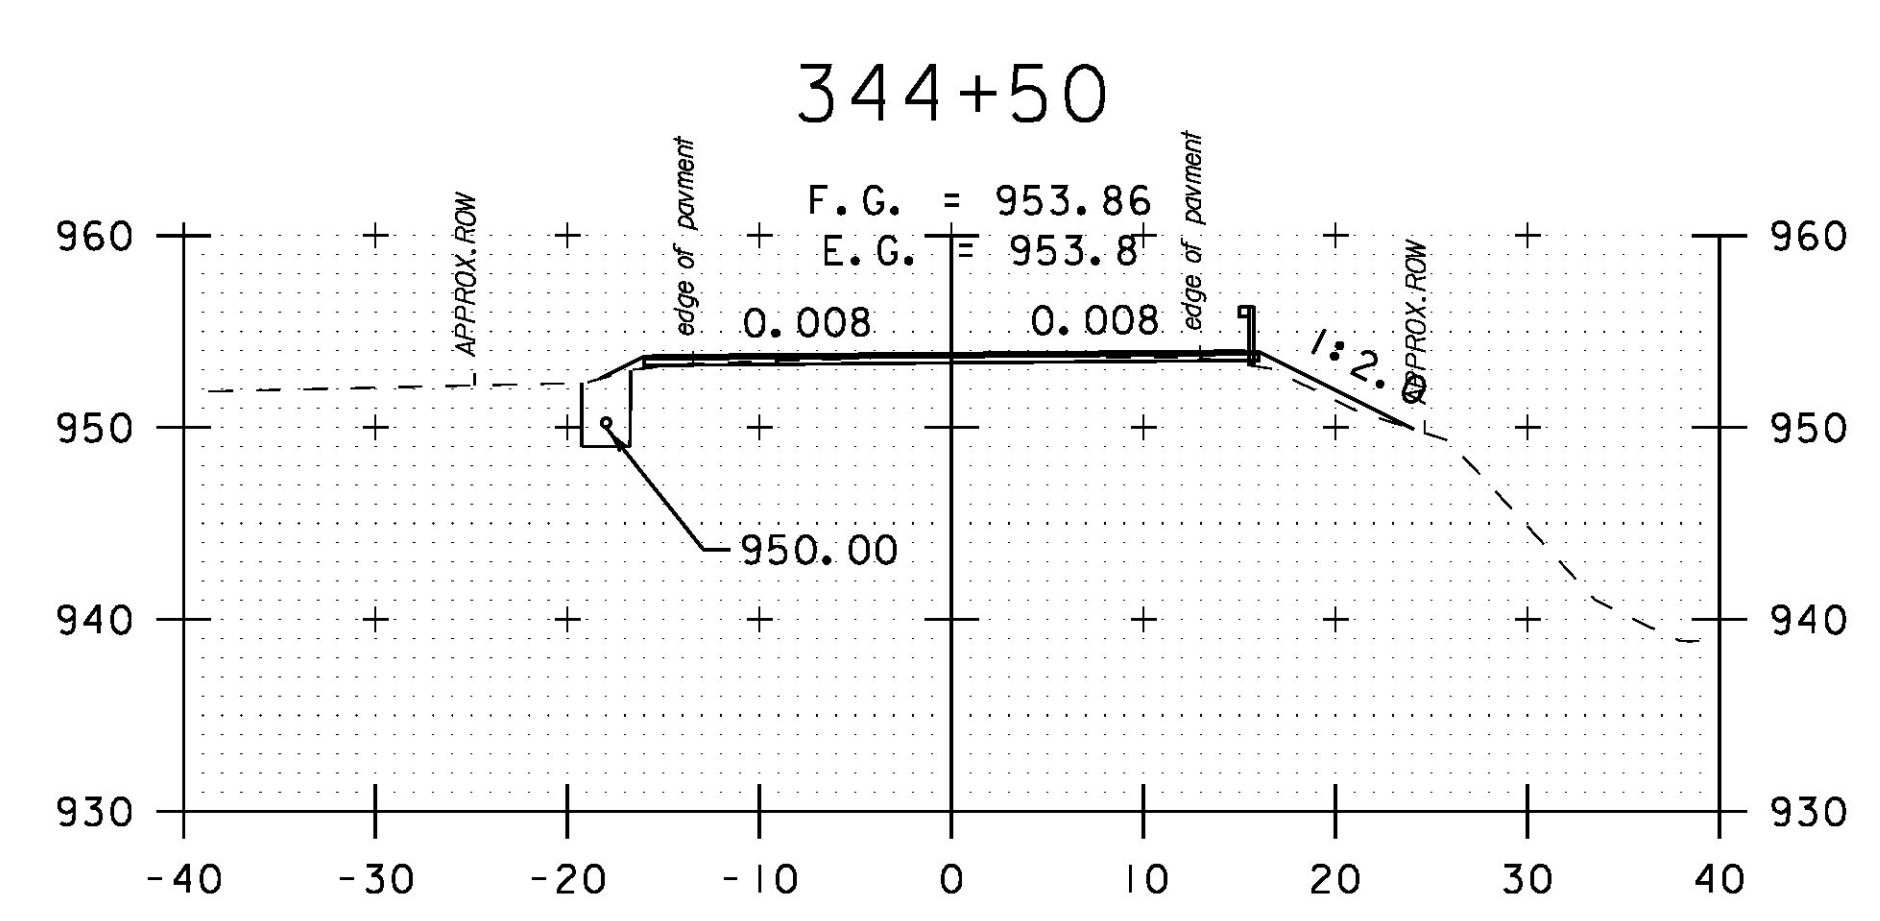

344+00

22

STA. 344+74.96 LT 20.28' TO
STA. 344+76.63 RT 21.72'
ASKEW ANGLE = 87.7559° RT
REMOVE EXISTING PIPE
INSTALL 18" CPEP (42'-0")
INV. IN = 948.34'
INV. OUT = 948.19'



PROJECT NAME: HANCOCK	PLOT DATE: 3/18/2015
PROJECT NUMBER: STP 2923 (1)	DRAWN BY: B. MARTIN
FILE NAME: z10c252xs.dgn	CHECKED BY: C. LATHROP
PROJECT LEADER: C. LATHROP	SHEET 194 OF 207
DESIGNED BY: B. MARTIN	
CROSS SECTION SHEET 67	