




356+50

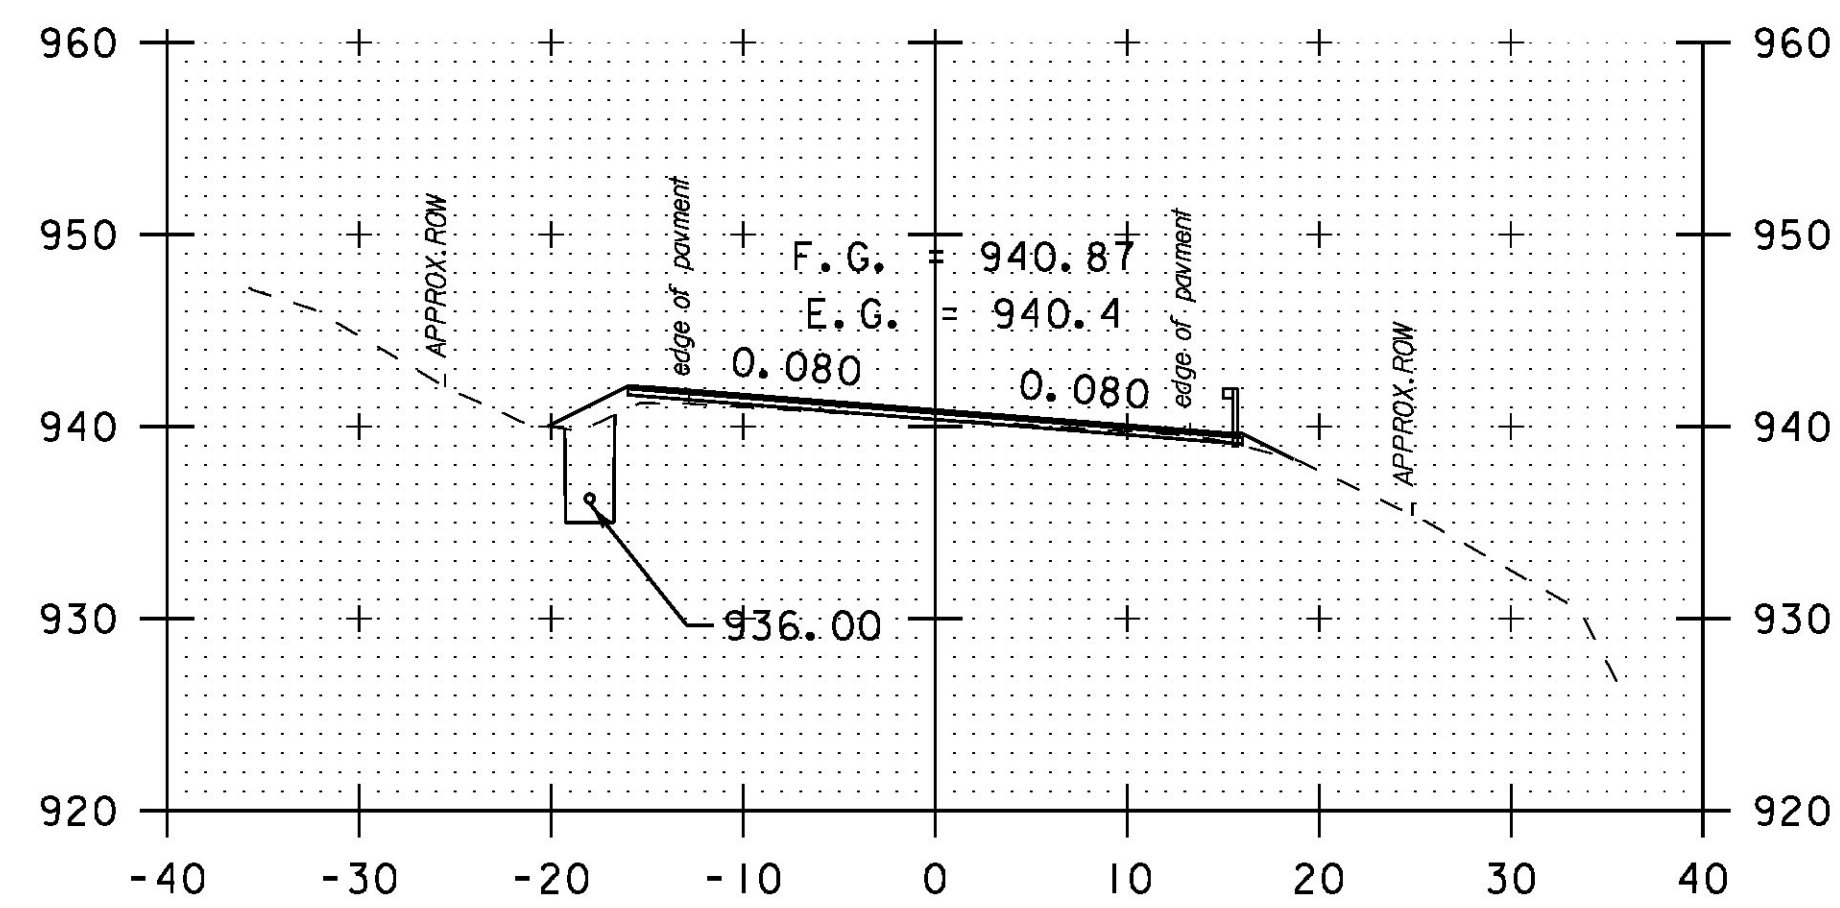


356+00

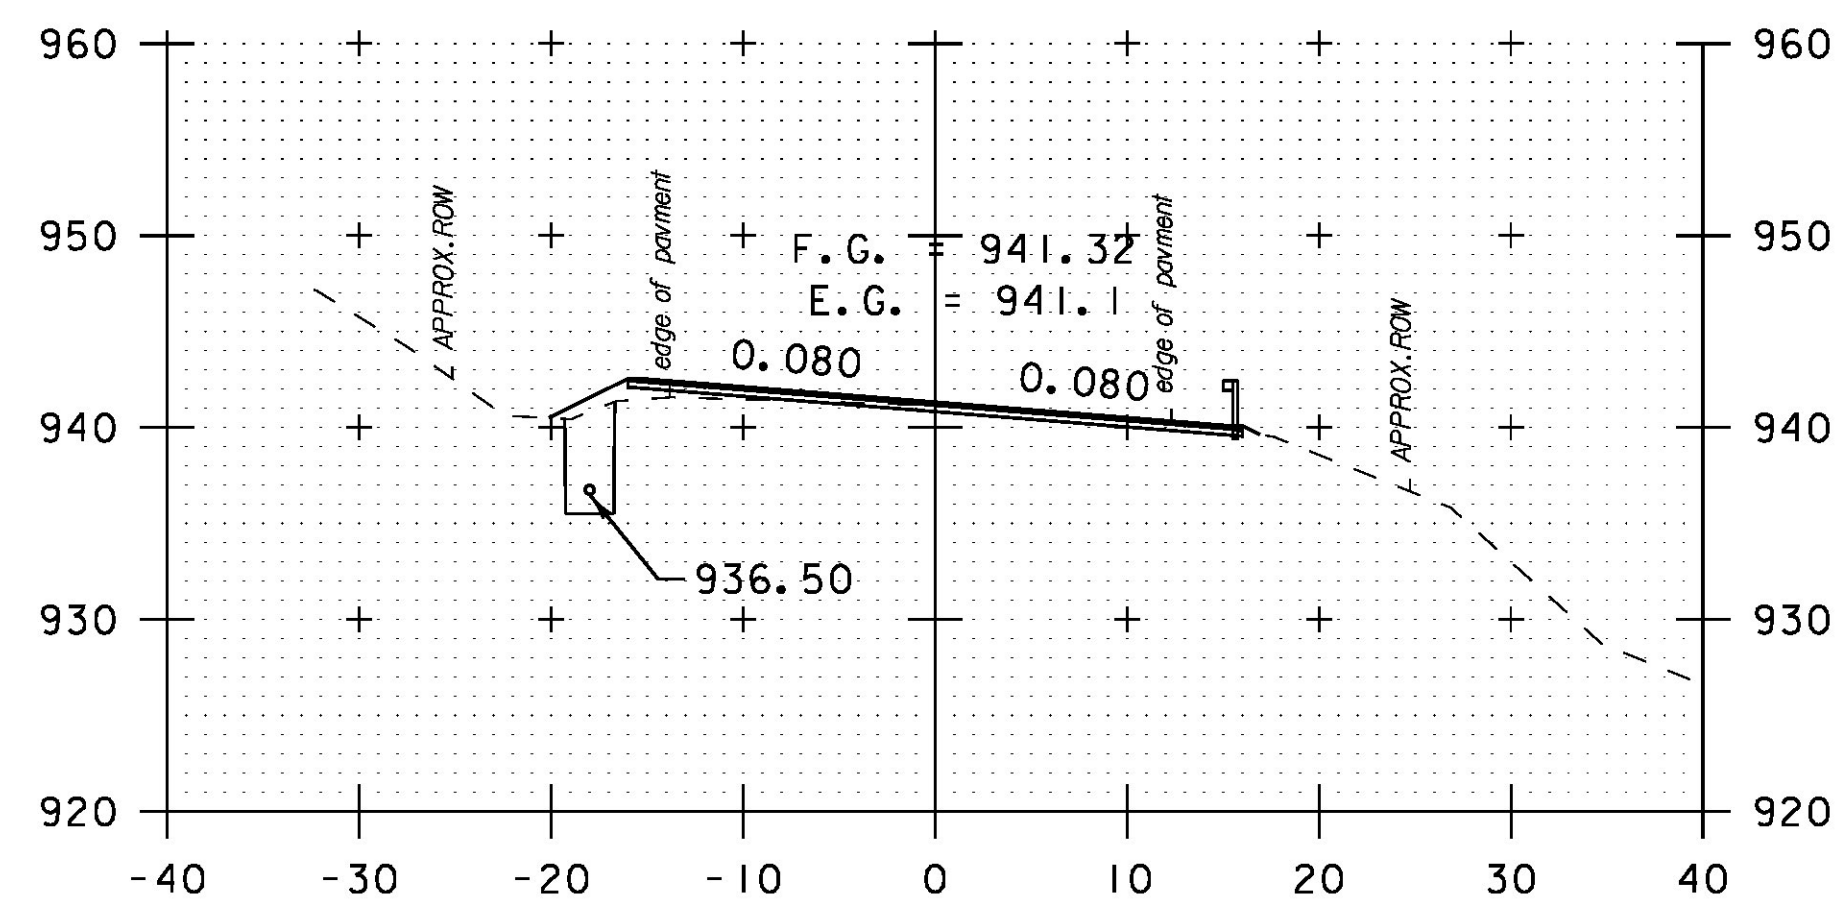


355+50

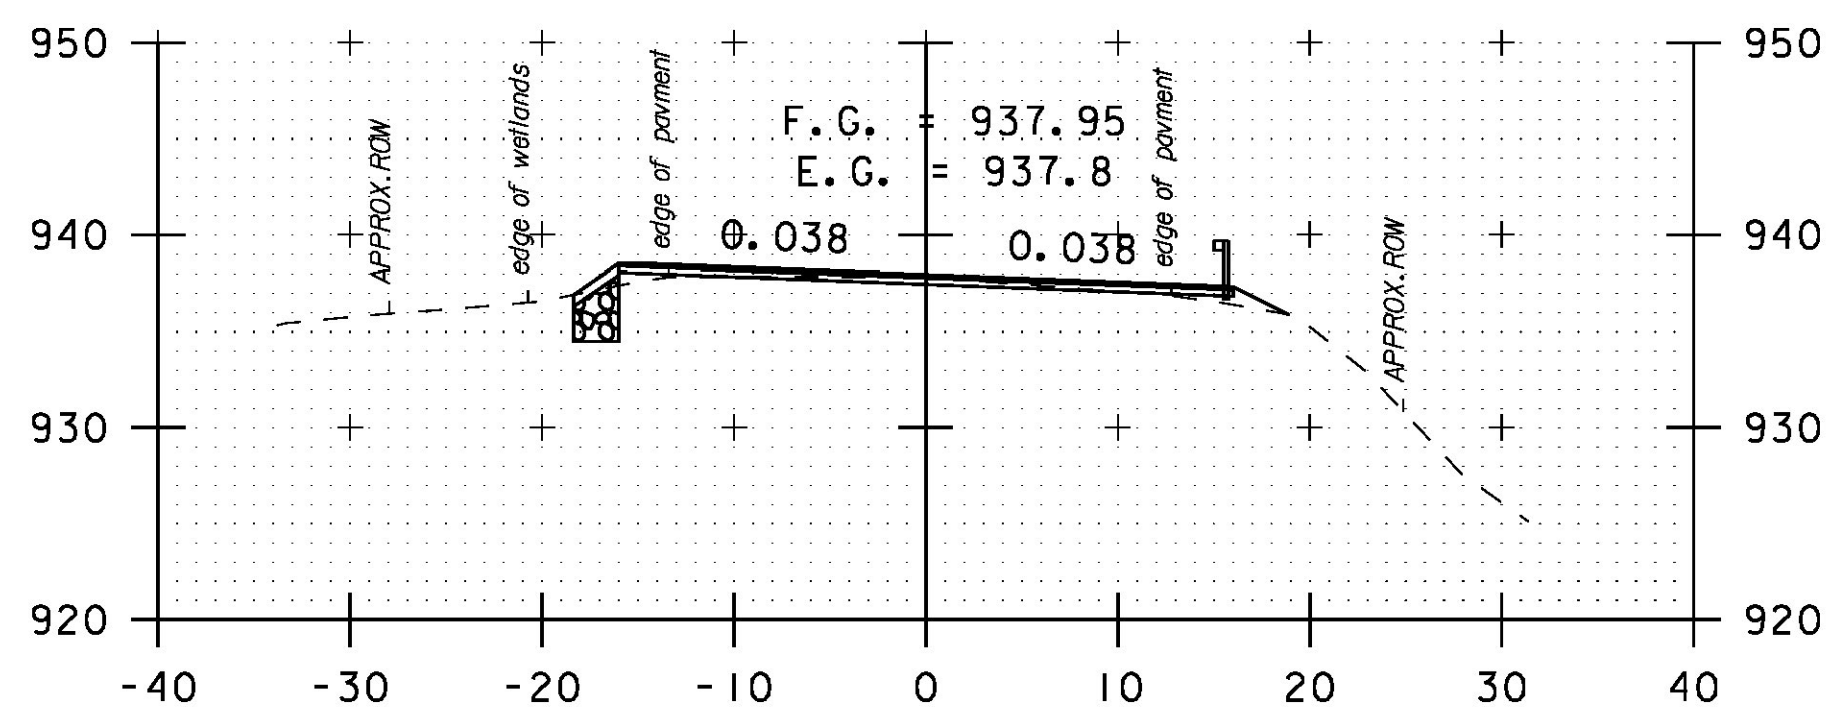


358+00

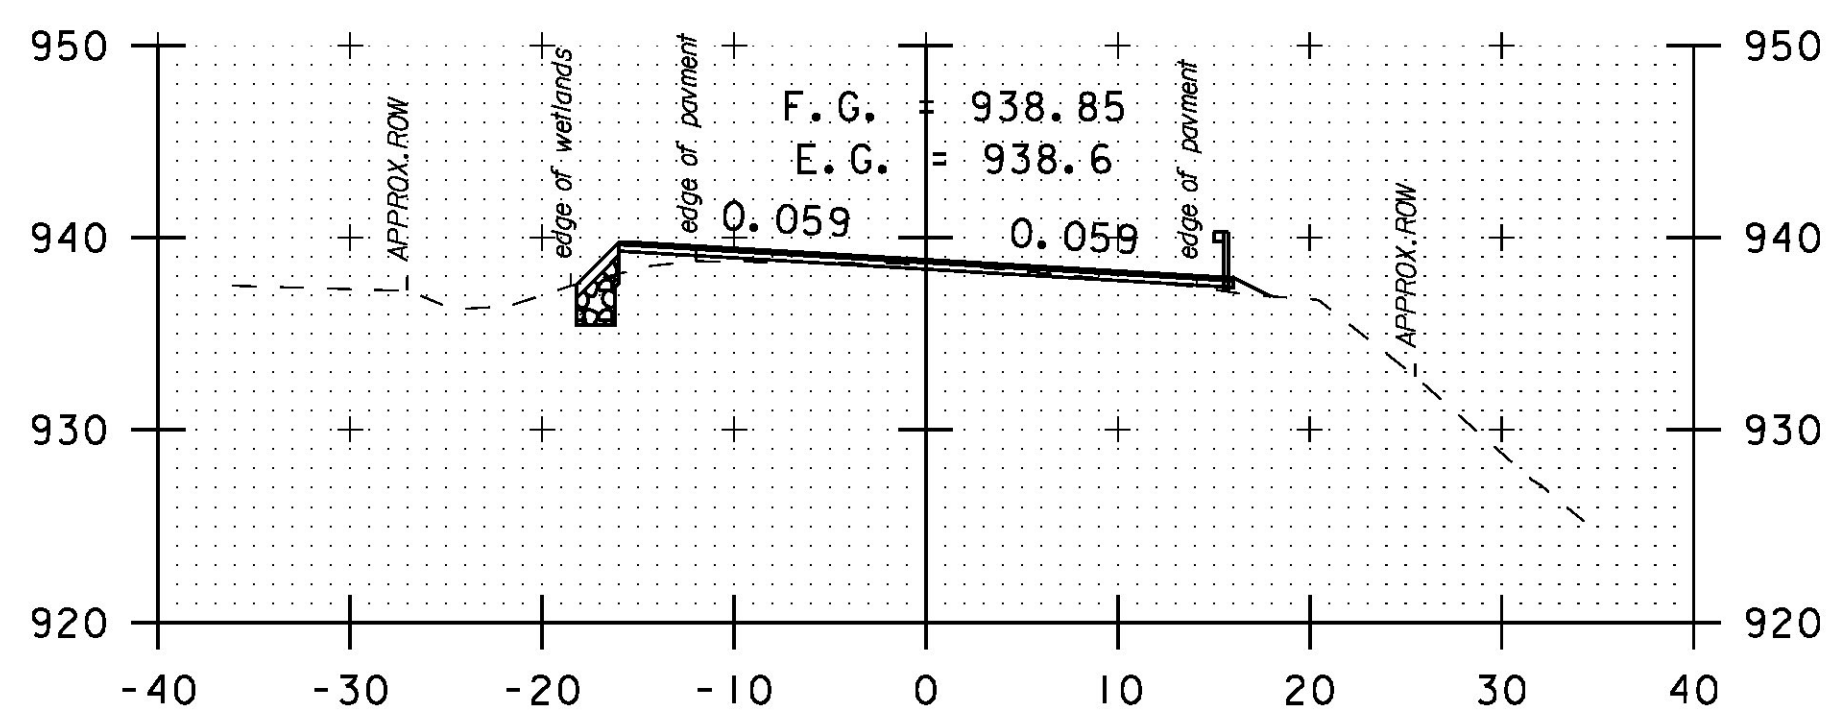


357+50

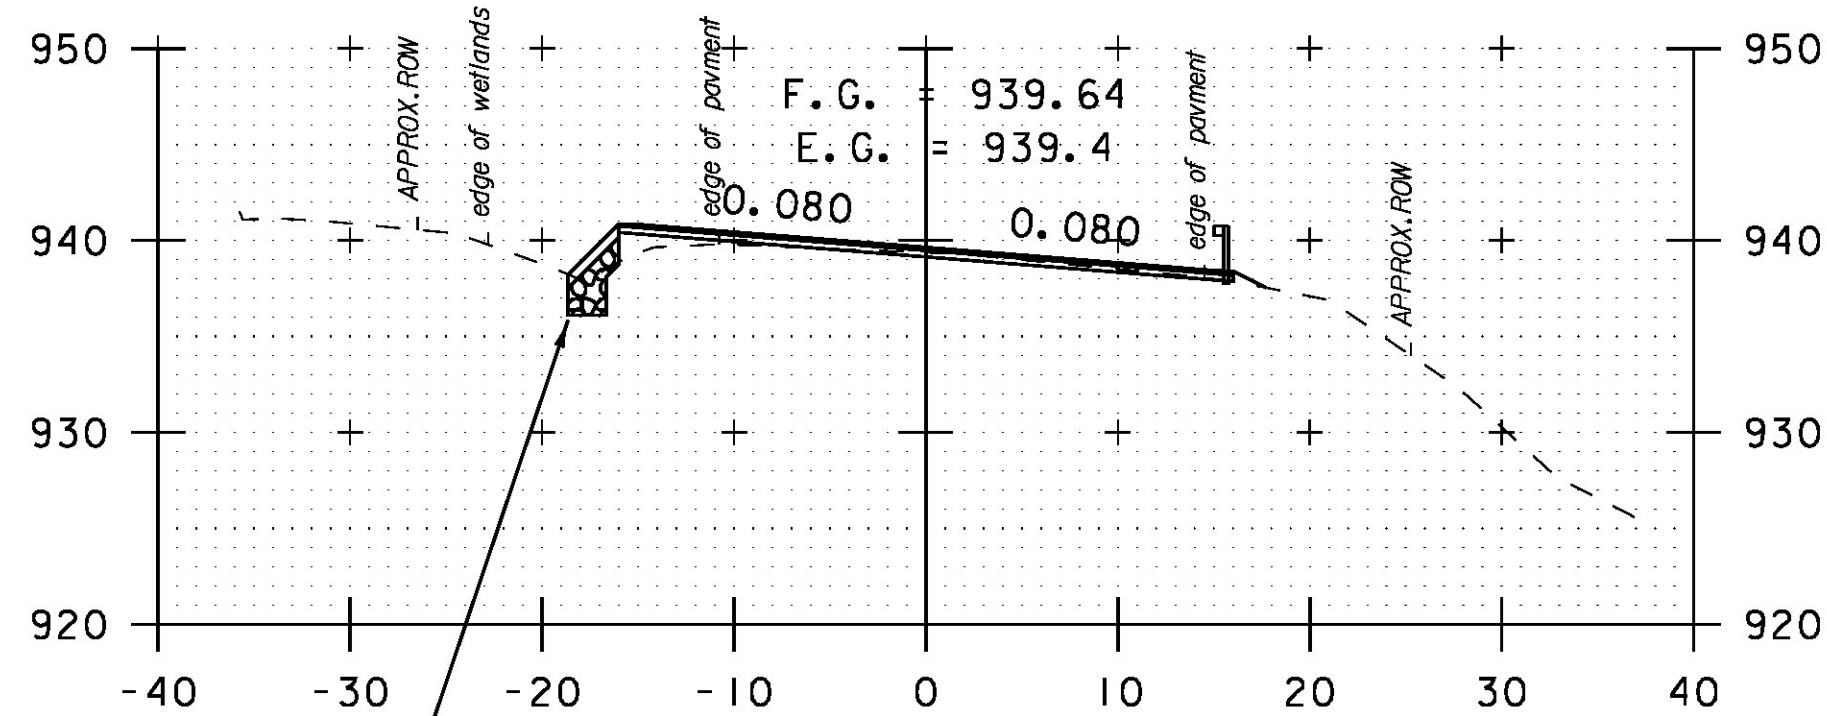


357+00

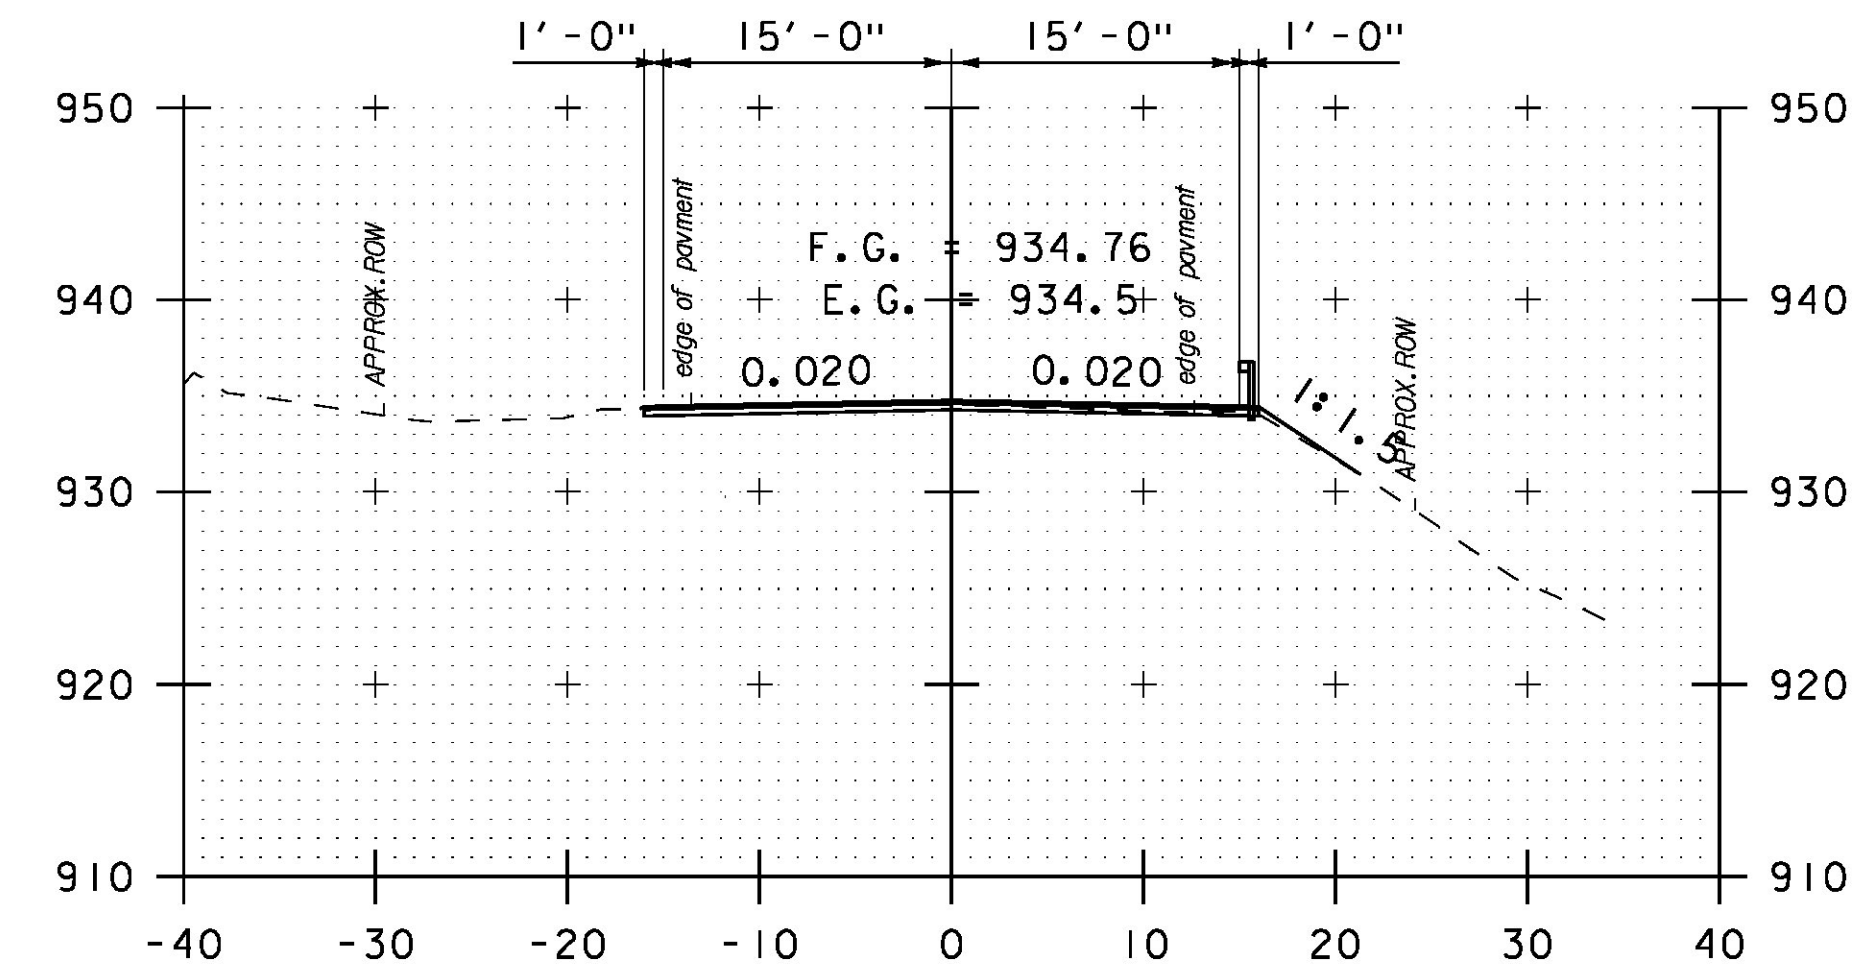

359+50

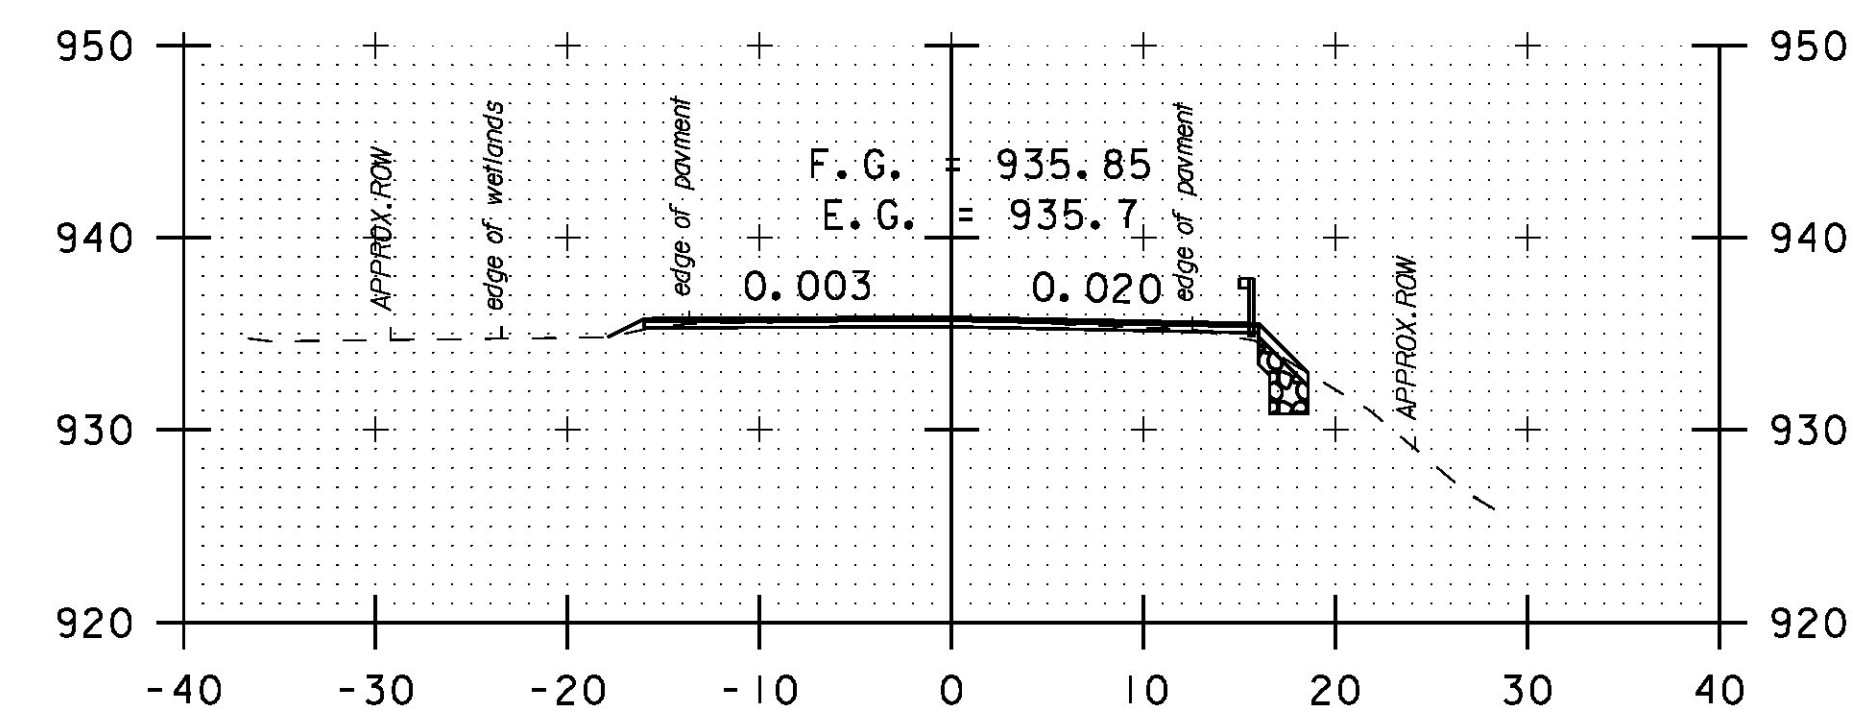

359+00

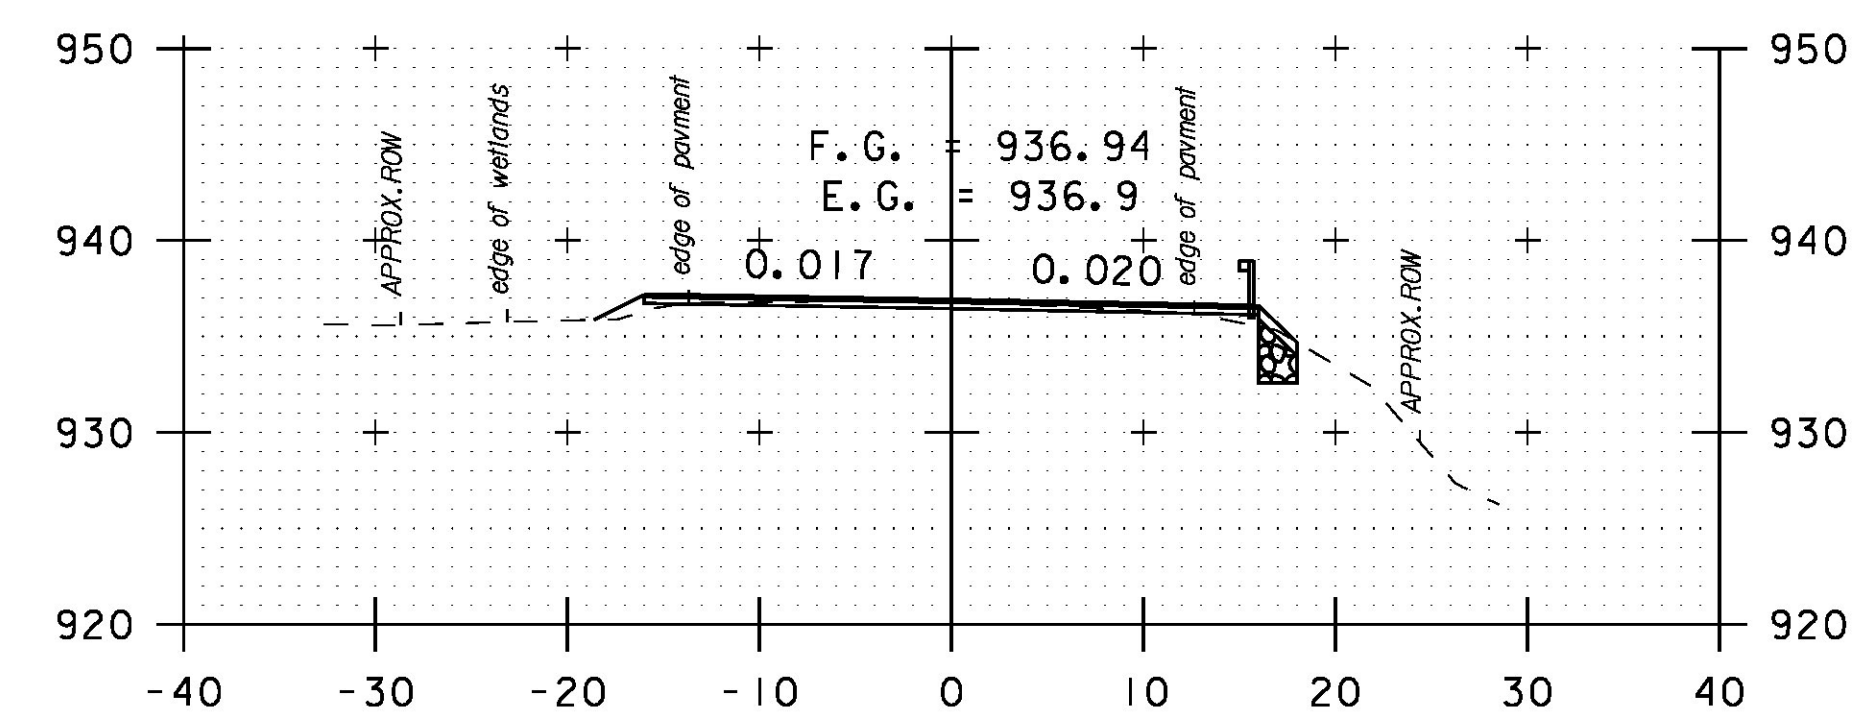

358+50

12" STONE FILL, TYPE I (TYP.)
GRUBBING MATERIAL (6") (TYP.)



PROJECT NAME: HANCOCK
PROJECT NUMBER: STP 2923 (1)

FILE NAME: z10c252xs.dgn
PROJECT LEADER: C. LATHROP
DESIGNED BY: B. MARTIN
CROSS SECTION SHEET 70

PLOT DATE: 3/18/2015
DRAWN BY: B. MARTIN
CHECKED BY: C. LATHROP
SHEET 197 OF 207