





360+50

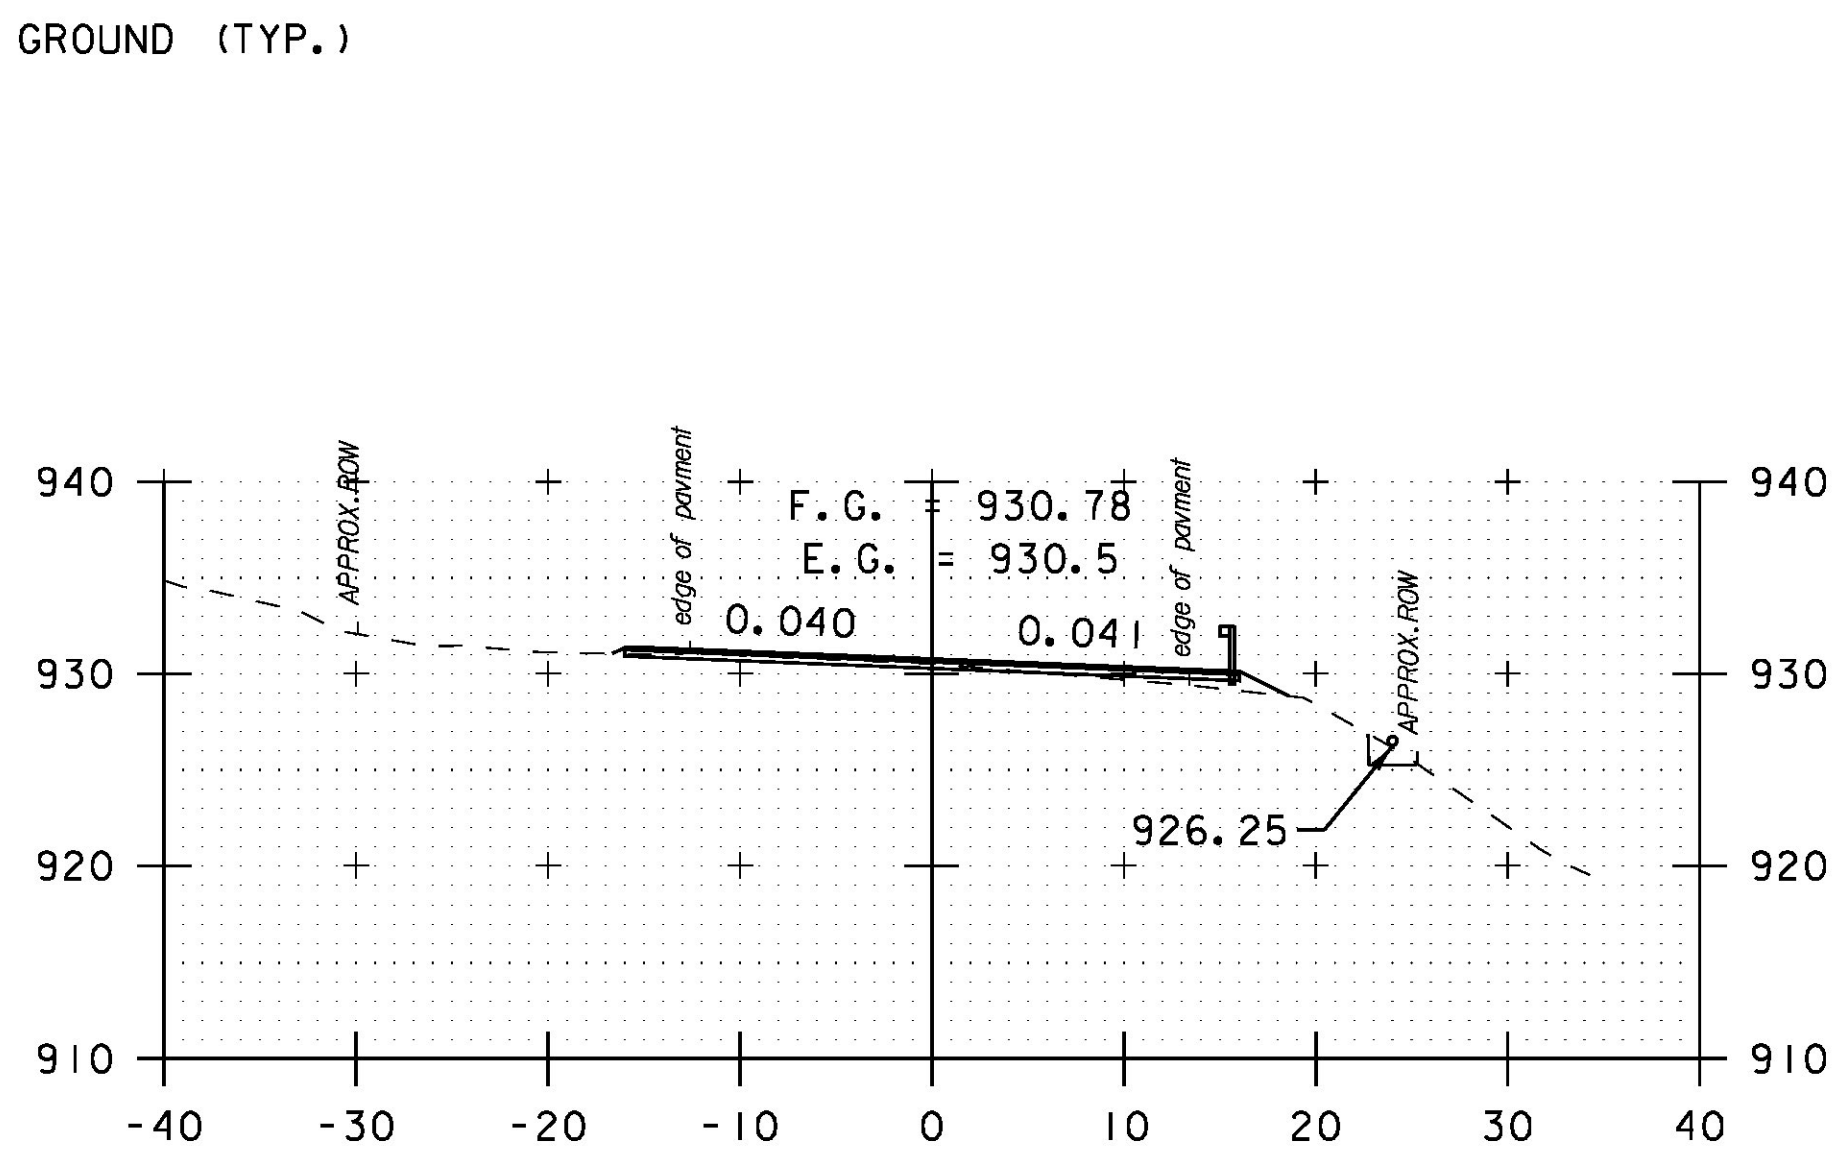


362+00
DRIVE LT

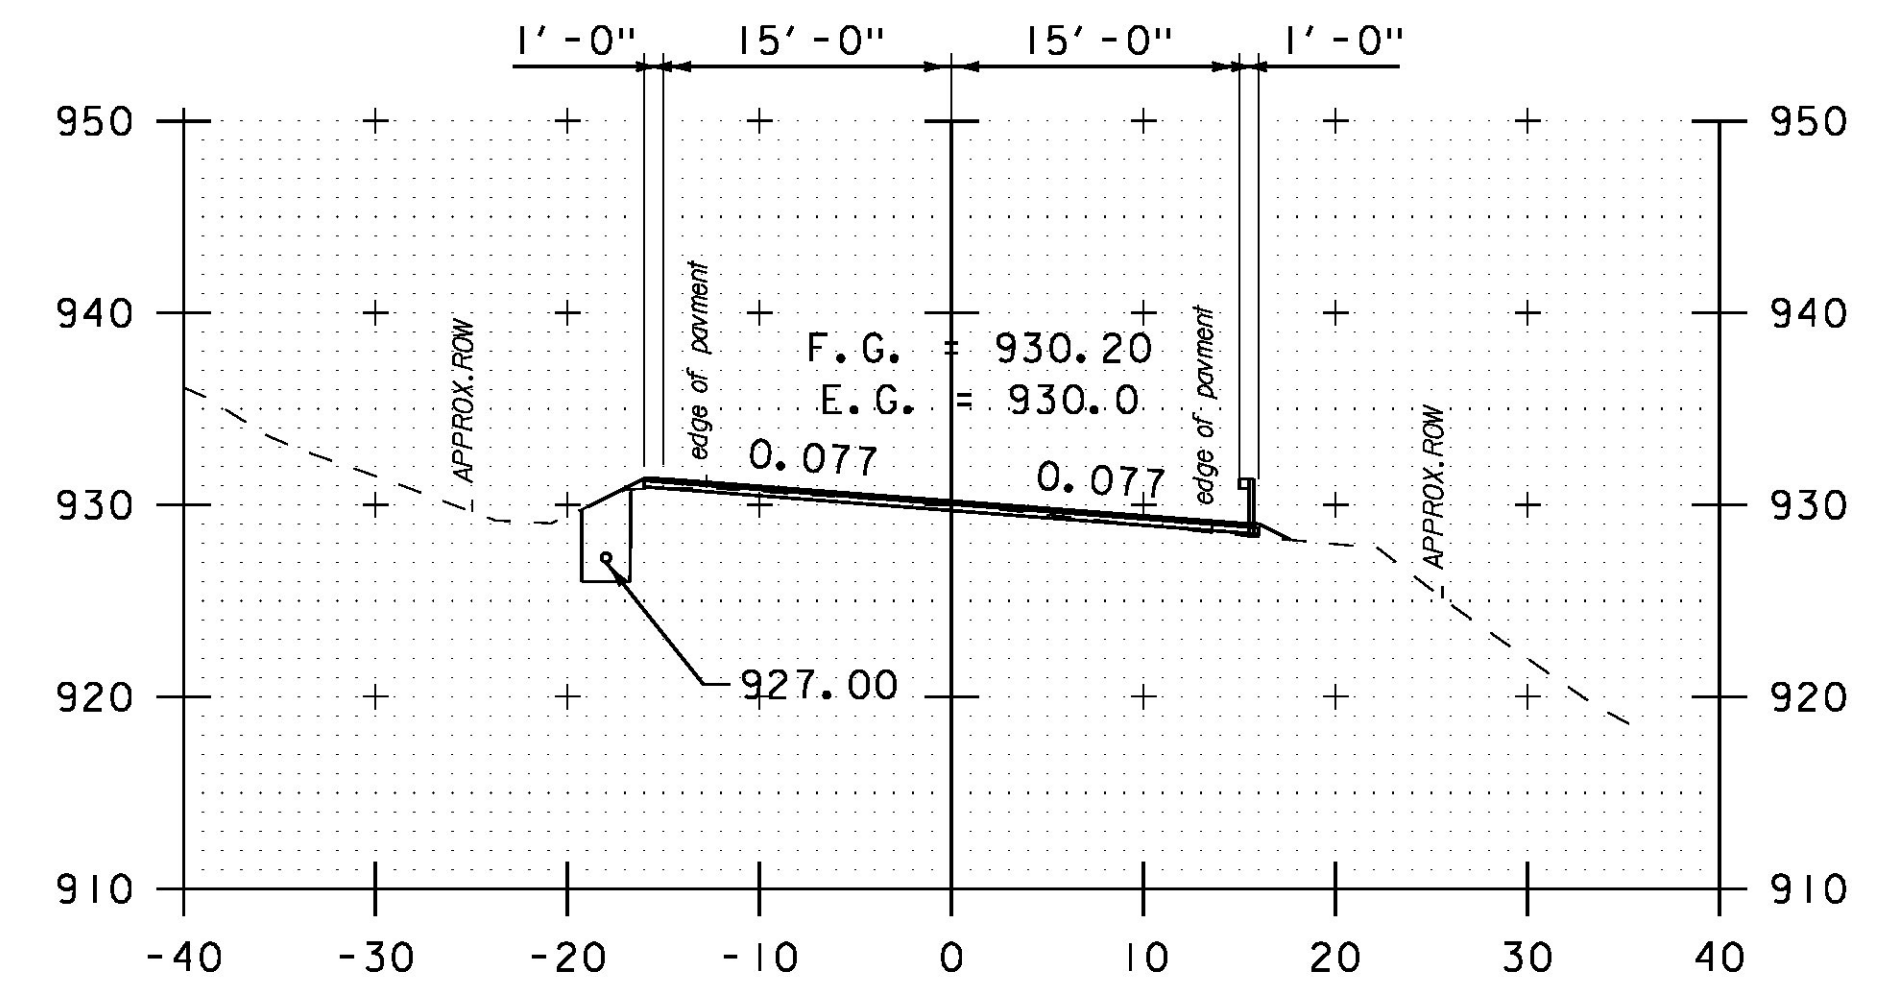


363+00

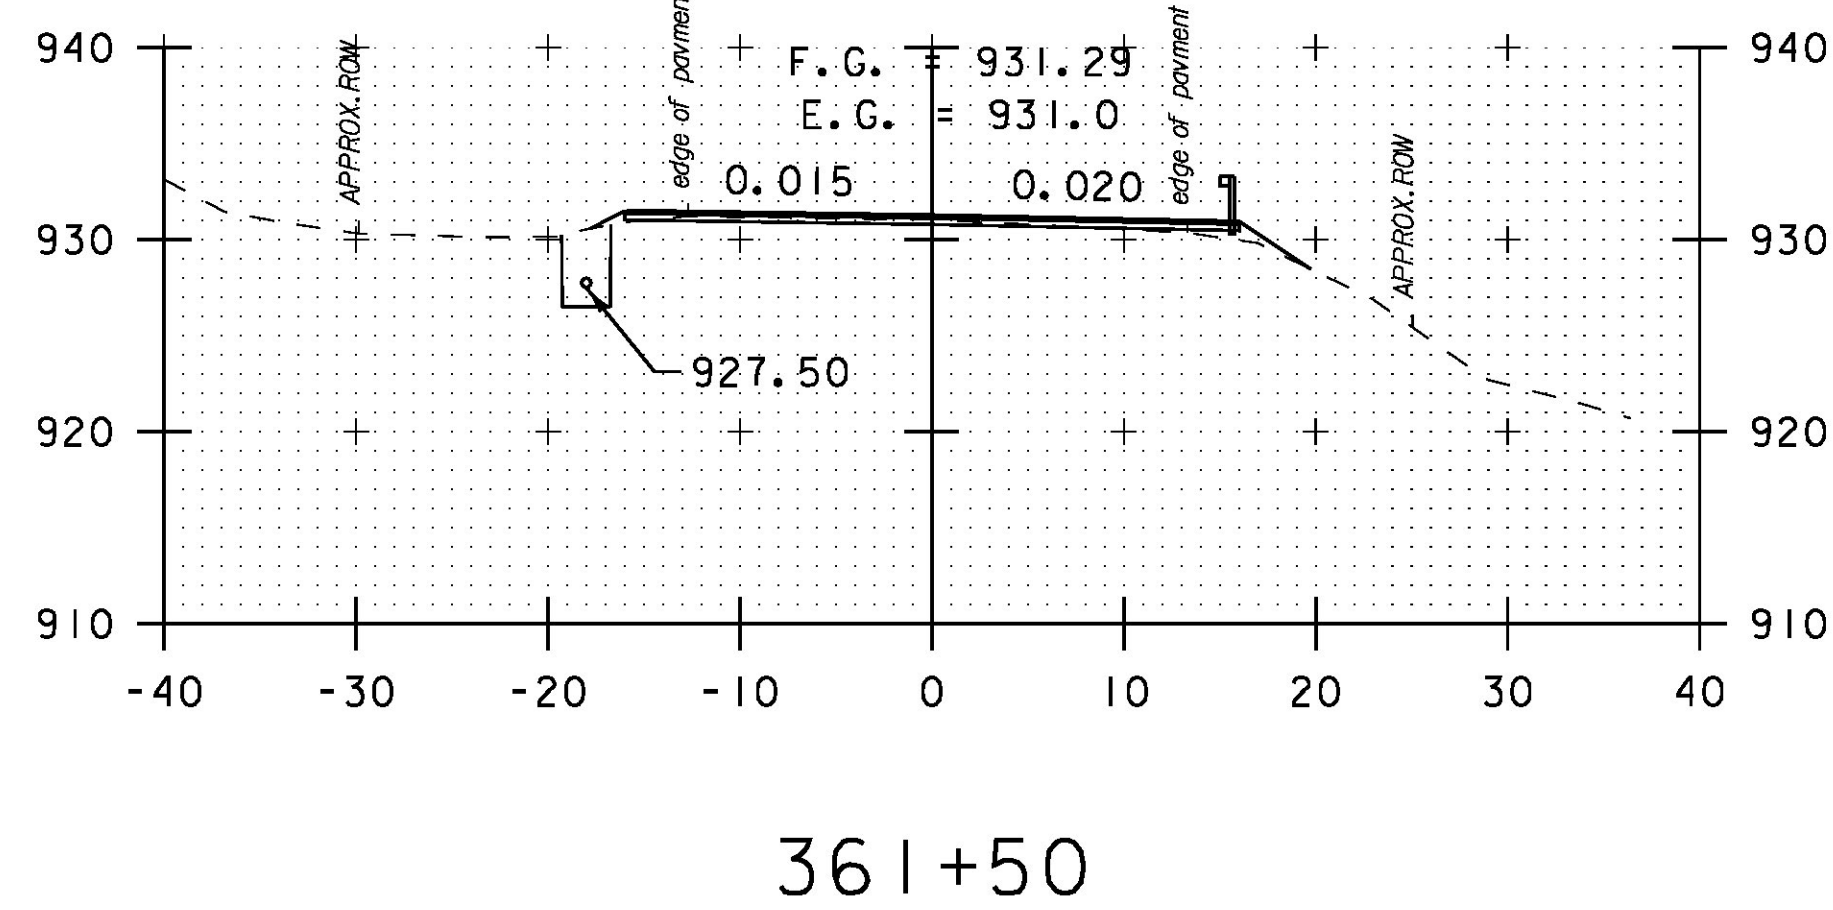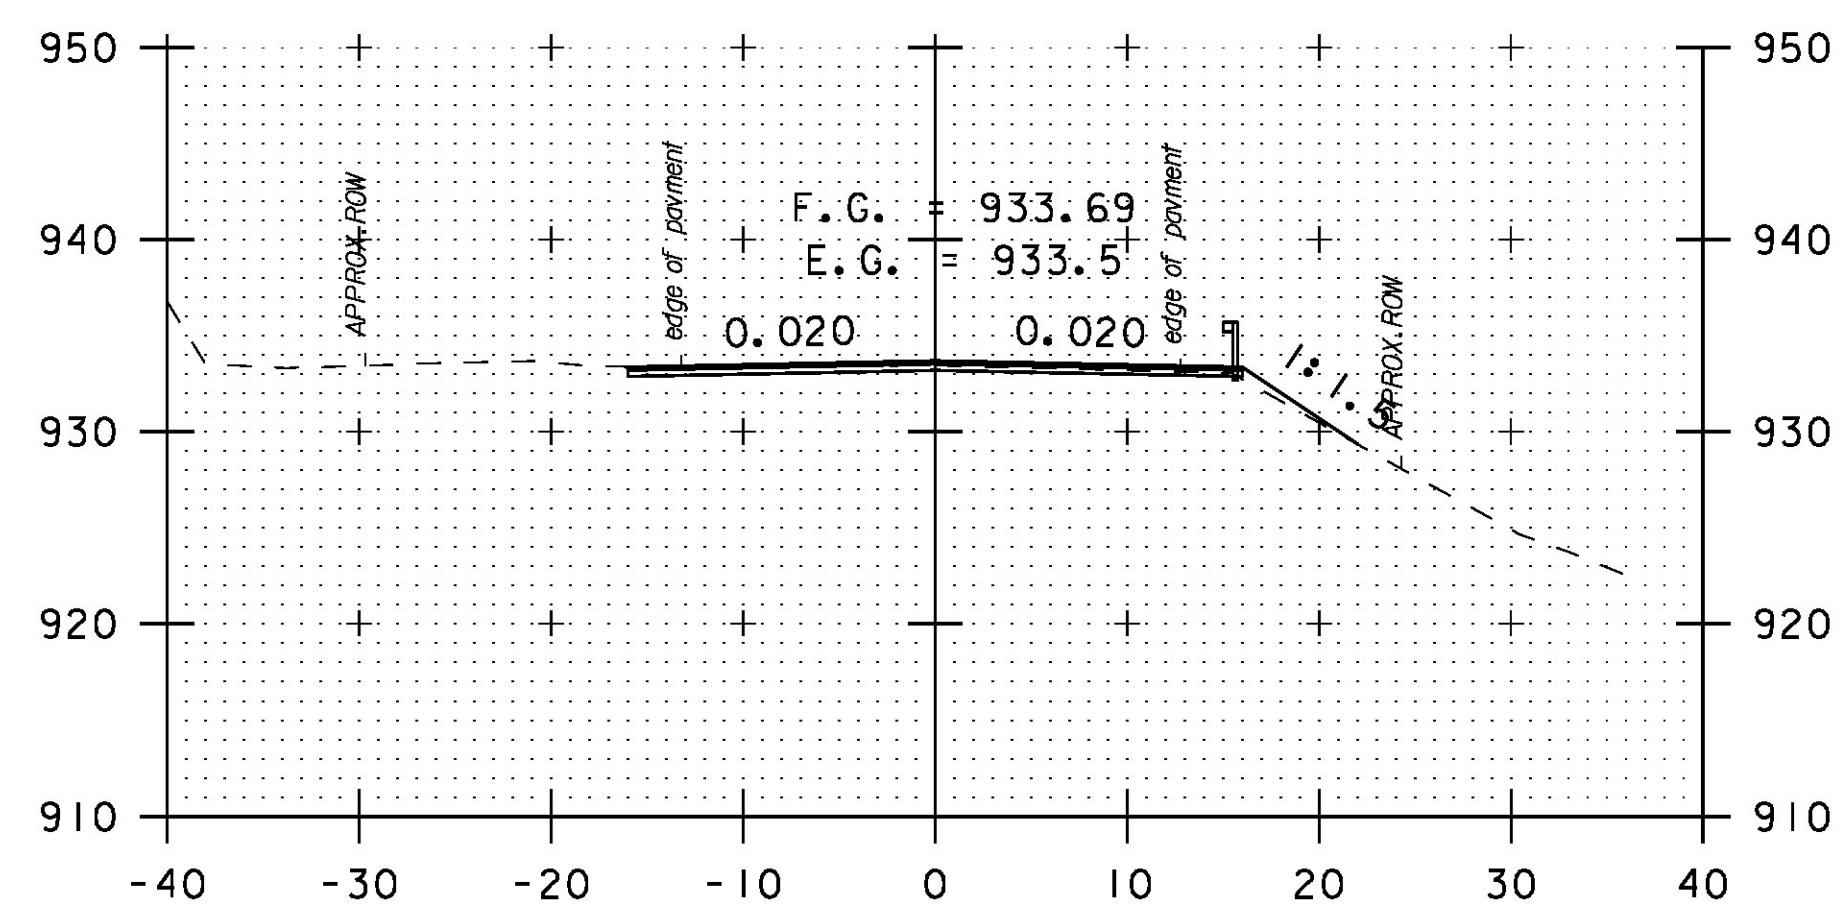


361+50

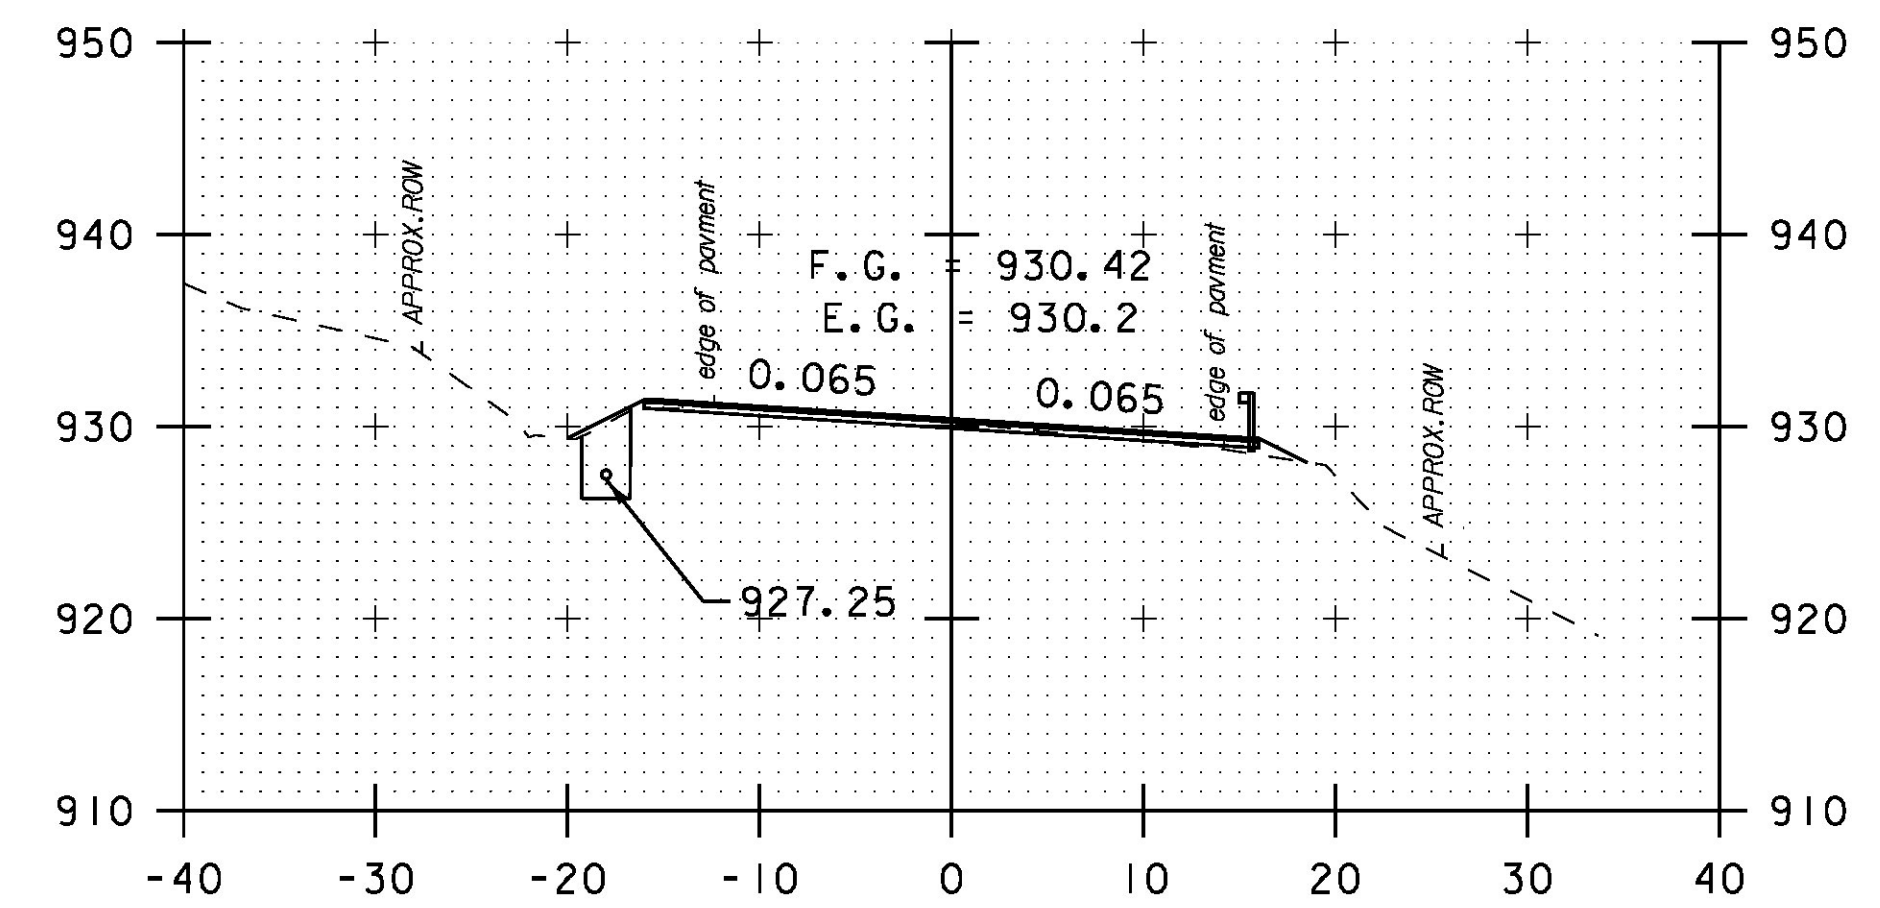


362+50

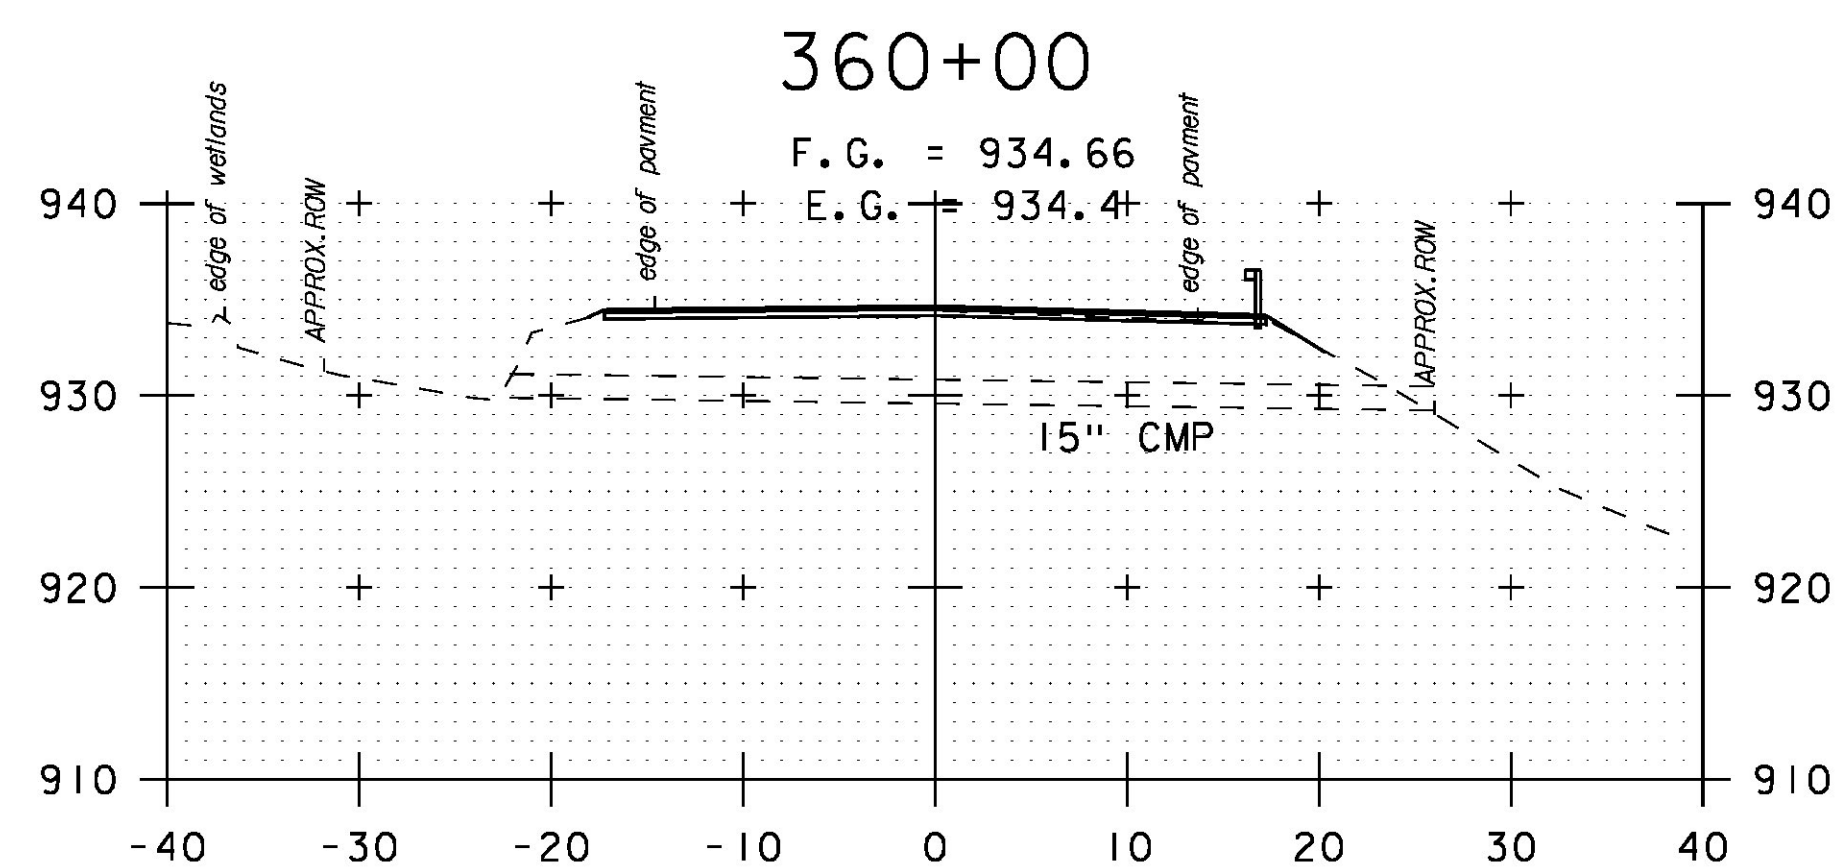


359+55
SKEWED

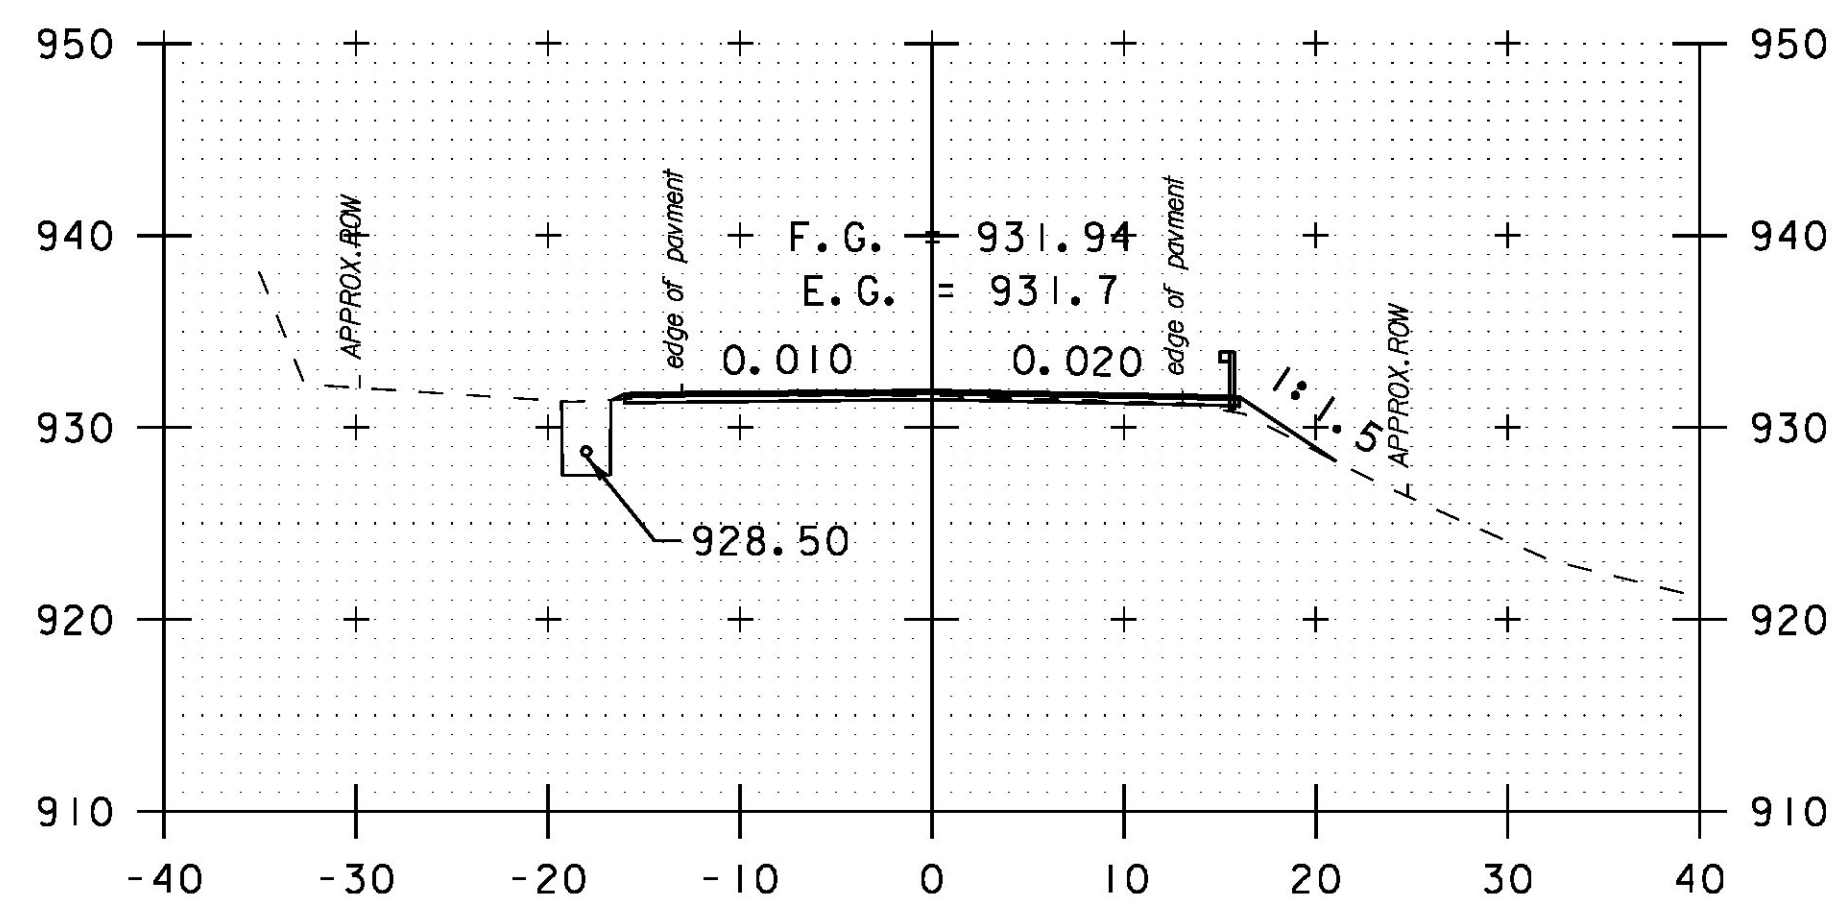

361+00

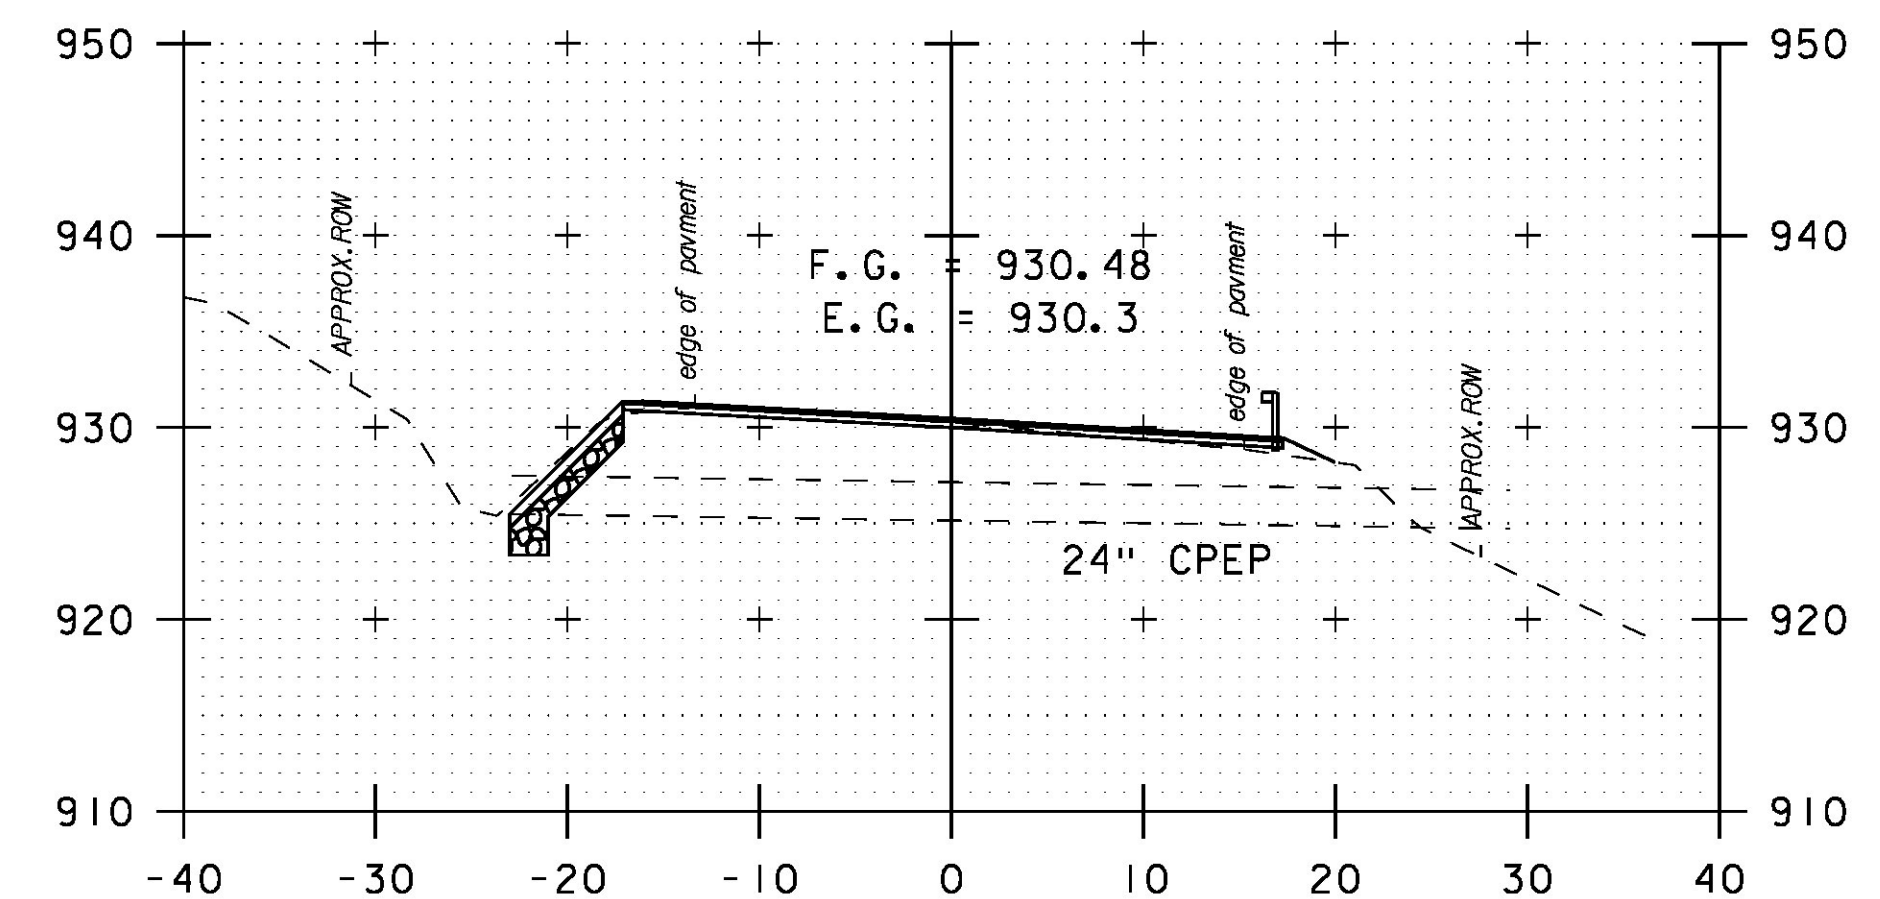

362+39
SKEWED

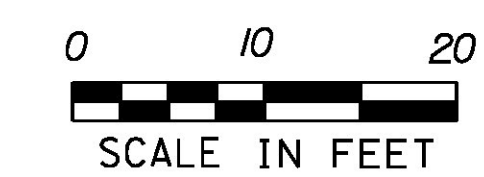

PROJECT NAME:	HANCOCK	PLOT DATE:	3/18/2015
PROJECT NUMBER:	STP 2923 (1)	DRAWN BY:	B. MARTIN
FILE NAME:	z10c252xs.dgn	CHECKED BY:	C. LATHROP
PROJECT LEADER:	C. LATHROP	SHEET	198 OF 207
DESIGNED BY:	B. MARTIN		
CROSS SECTION SHEET	71		