




364+00

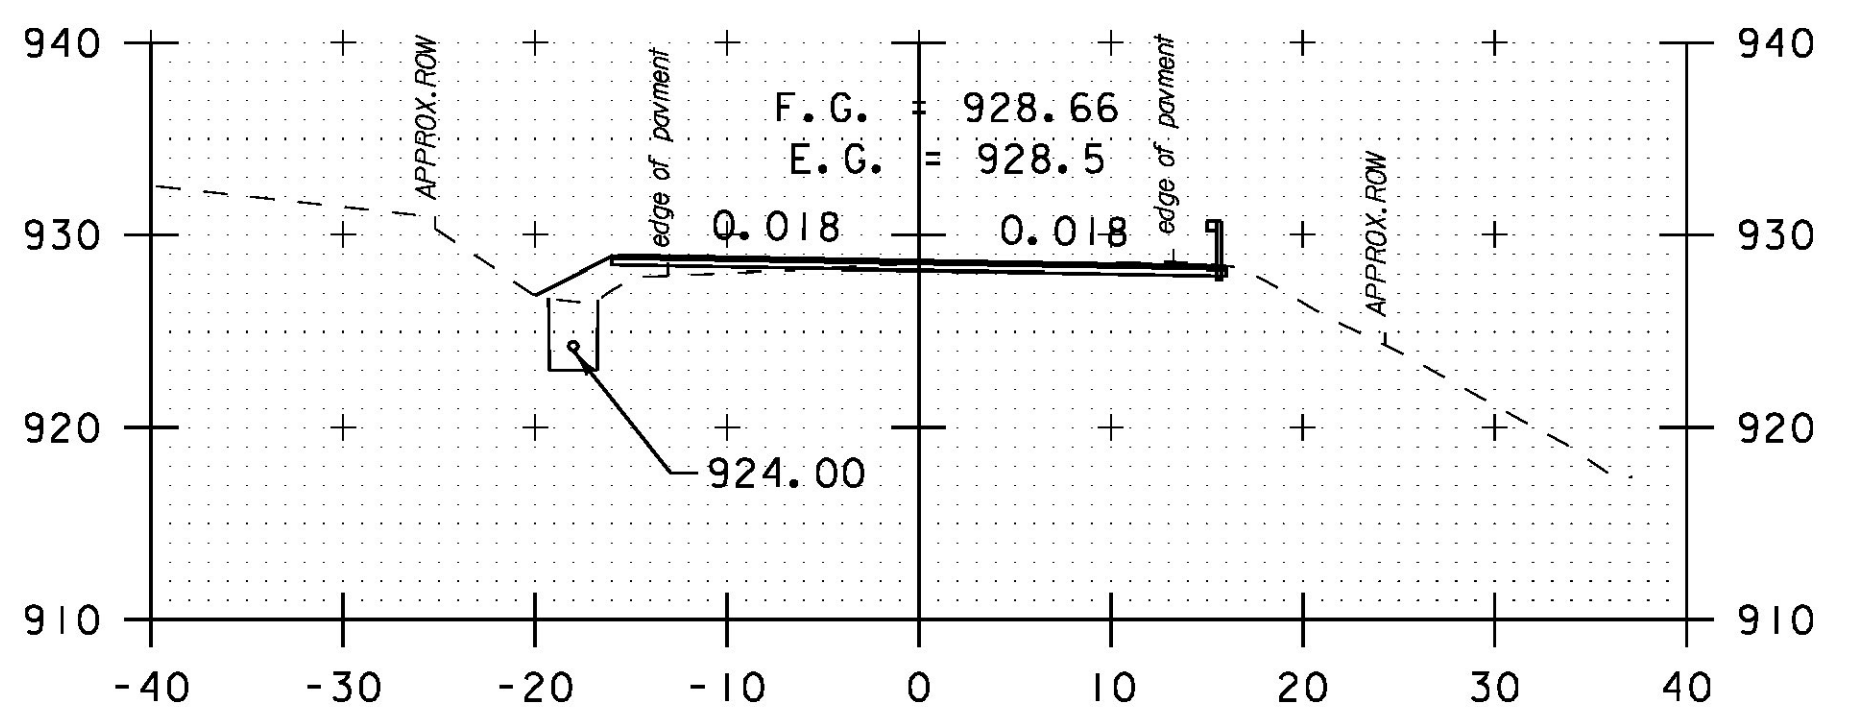


365+00

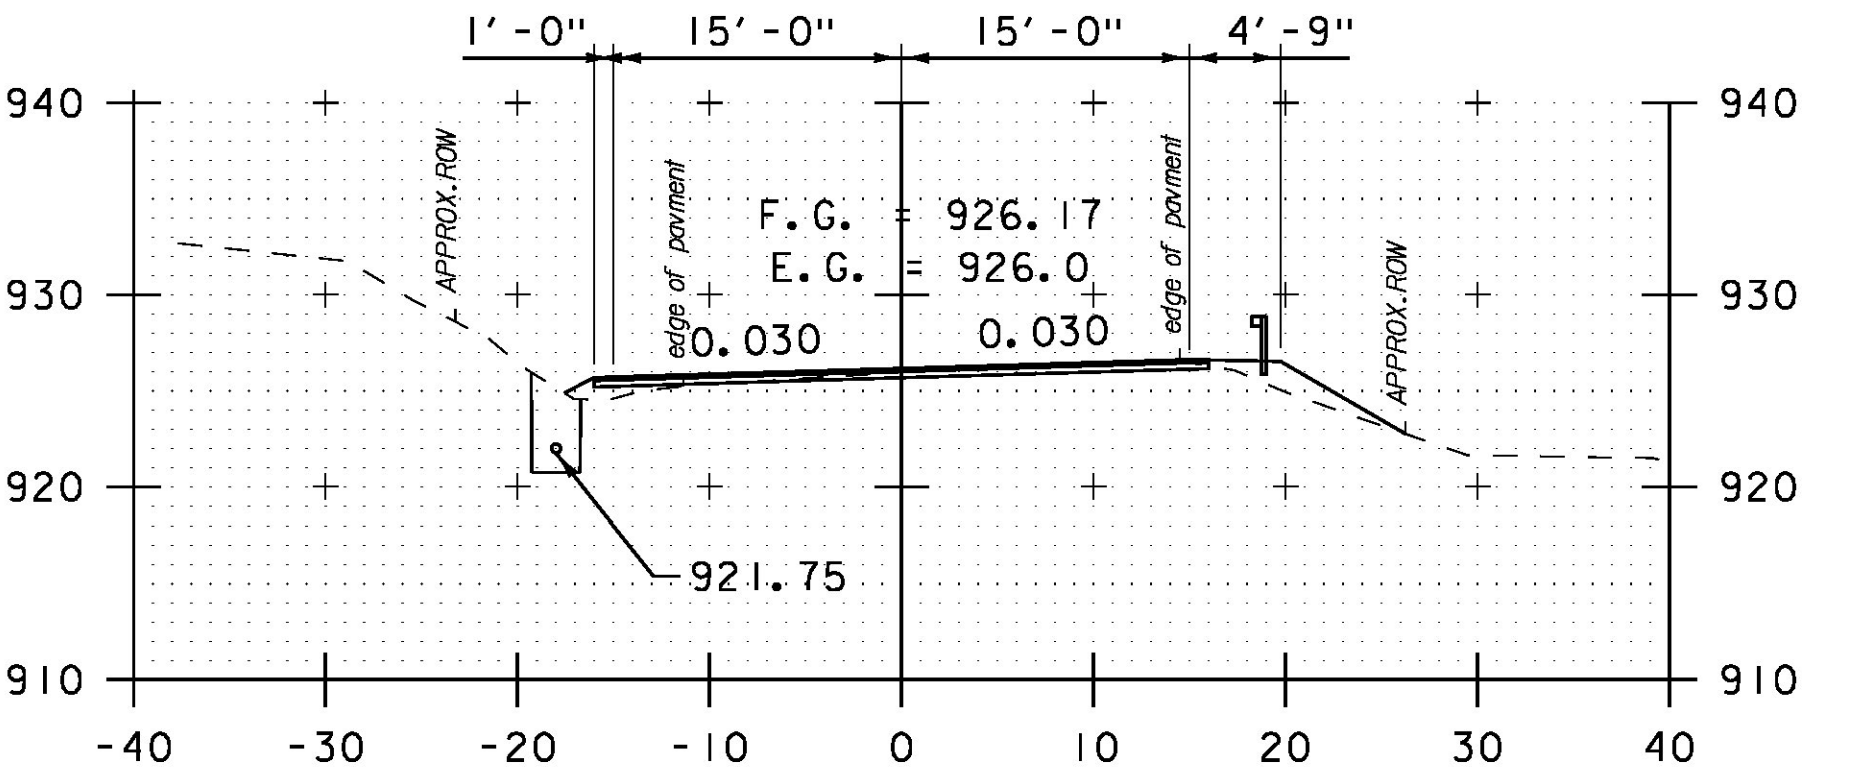


366+50

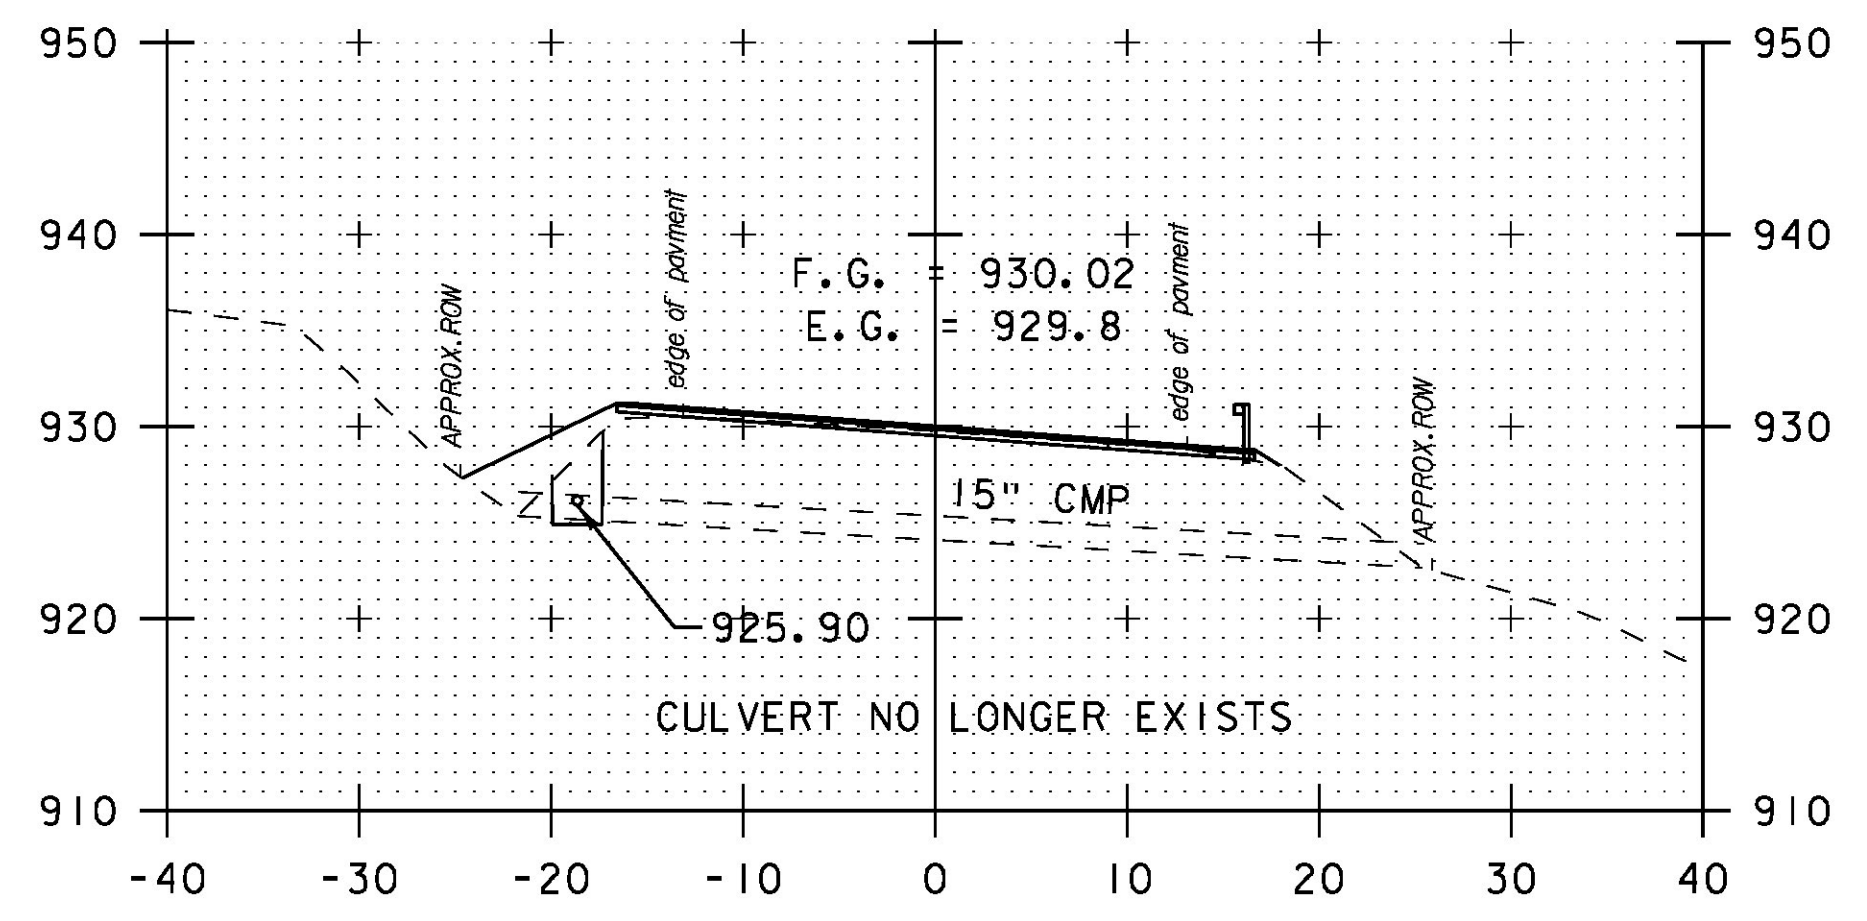


363+64  
SKEWED

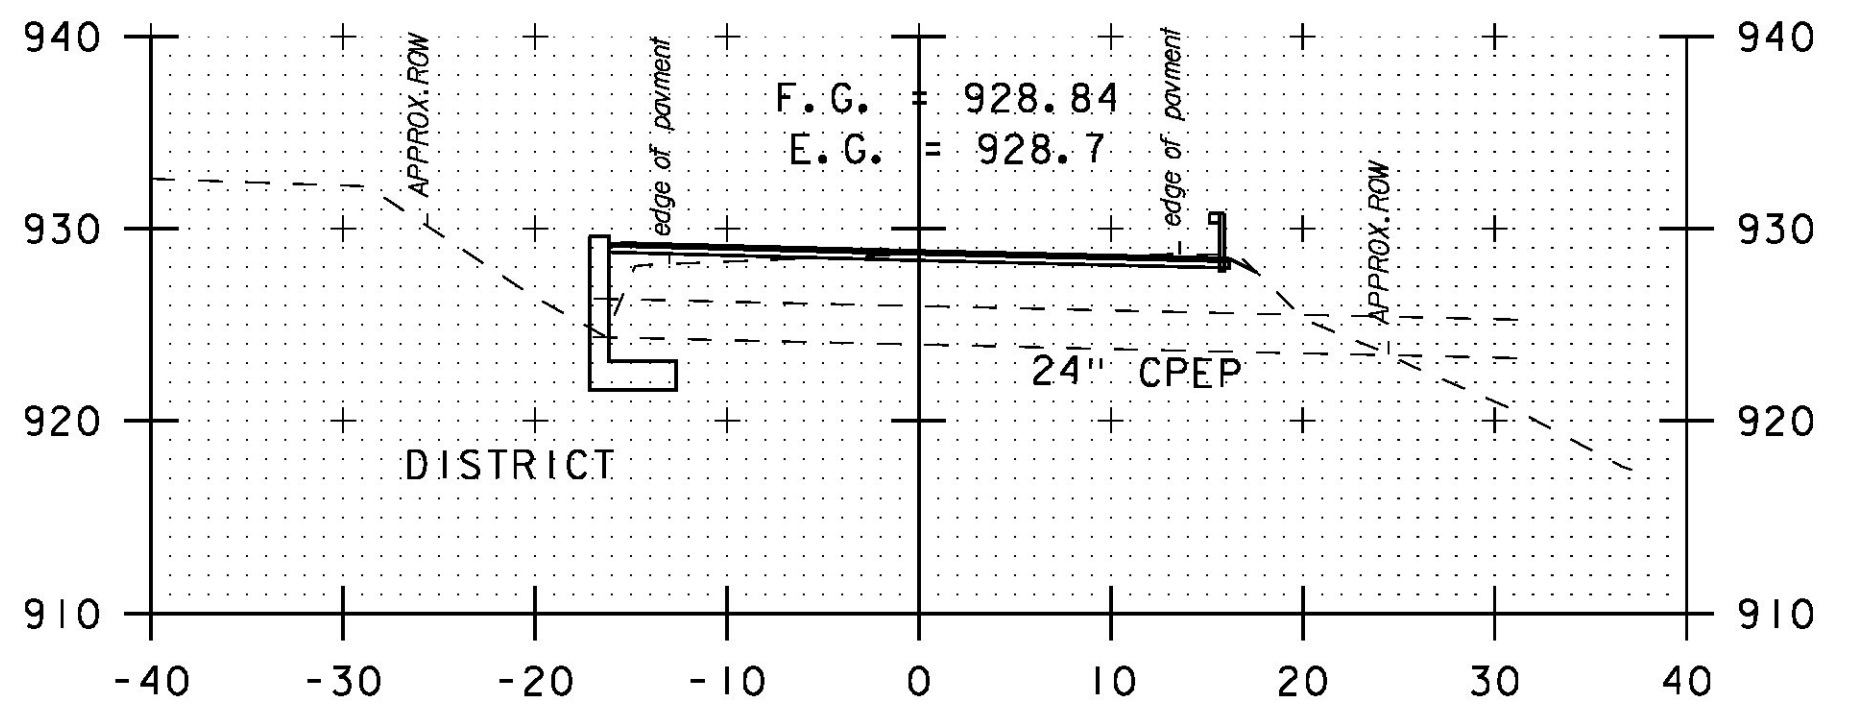


364+88  
SKEWED

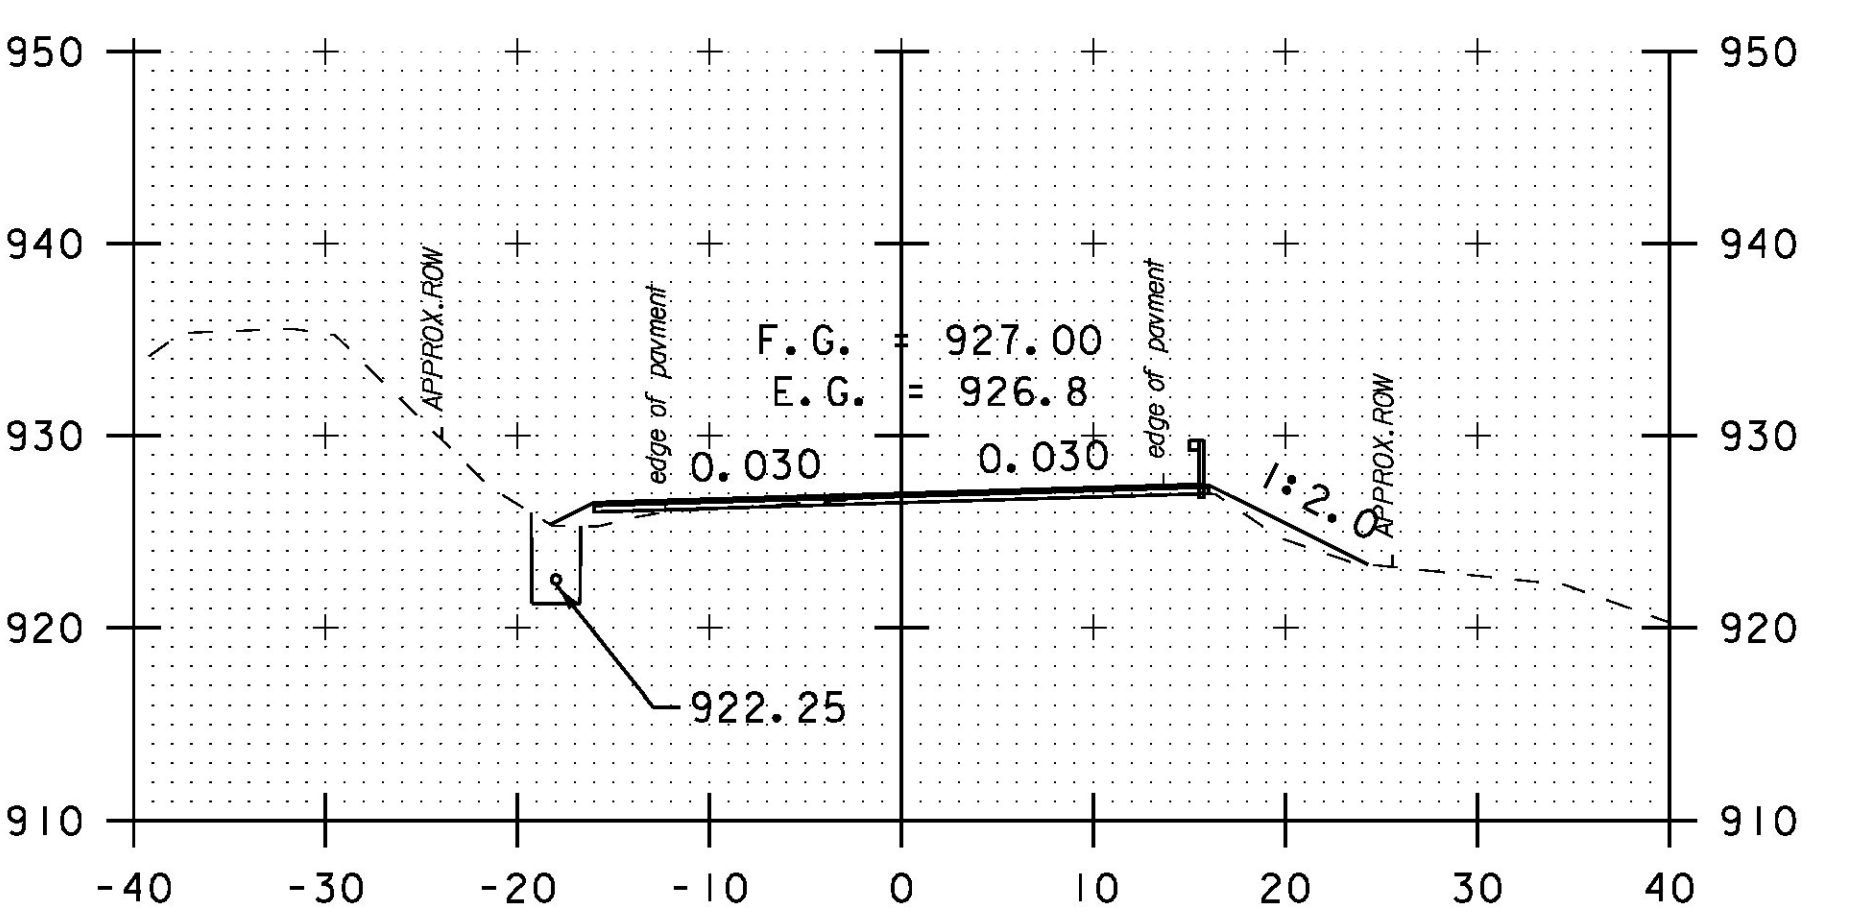


366+00

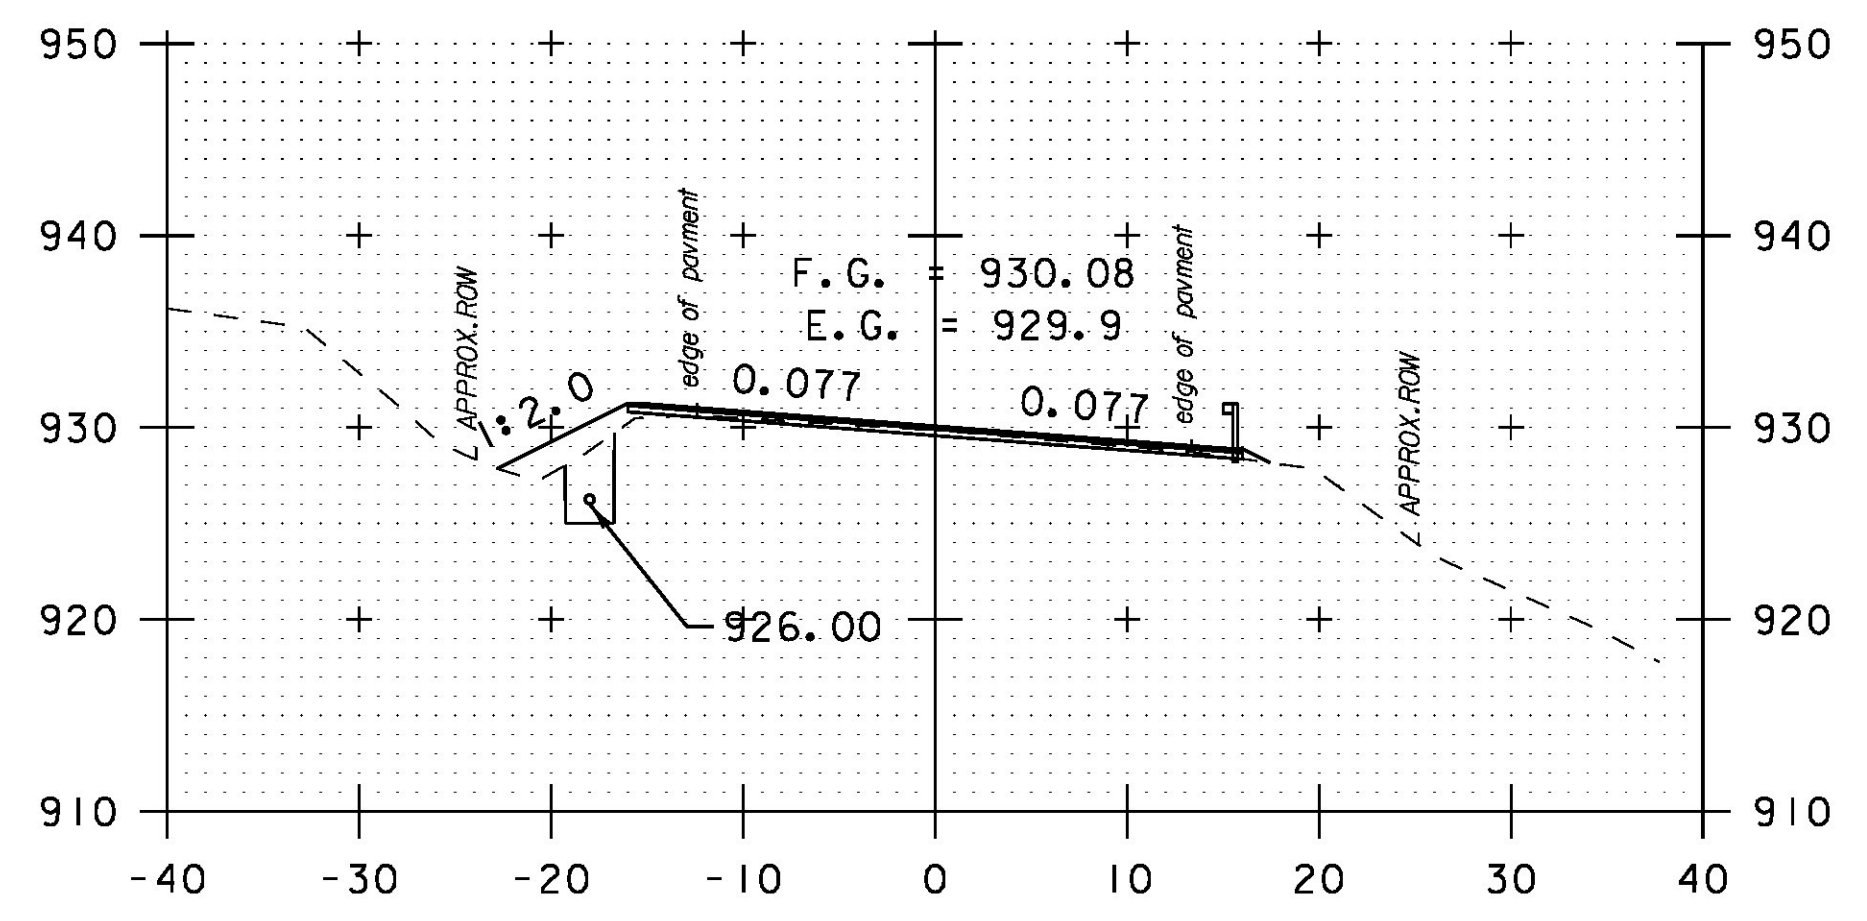

363+50

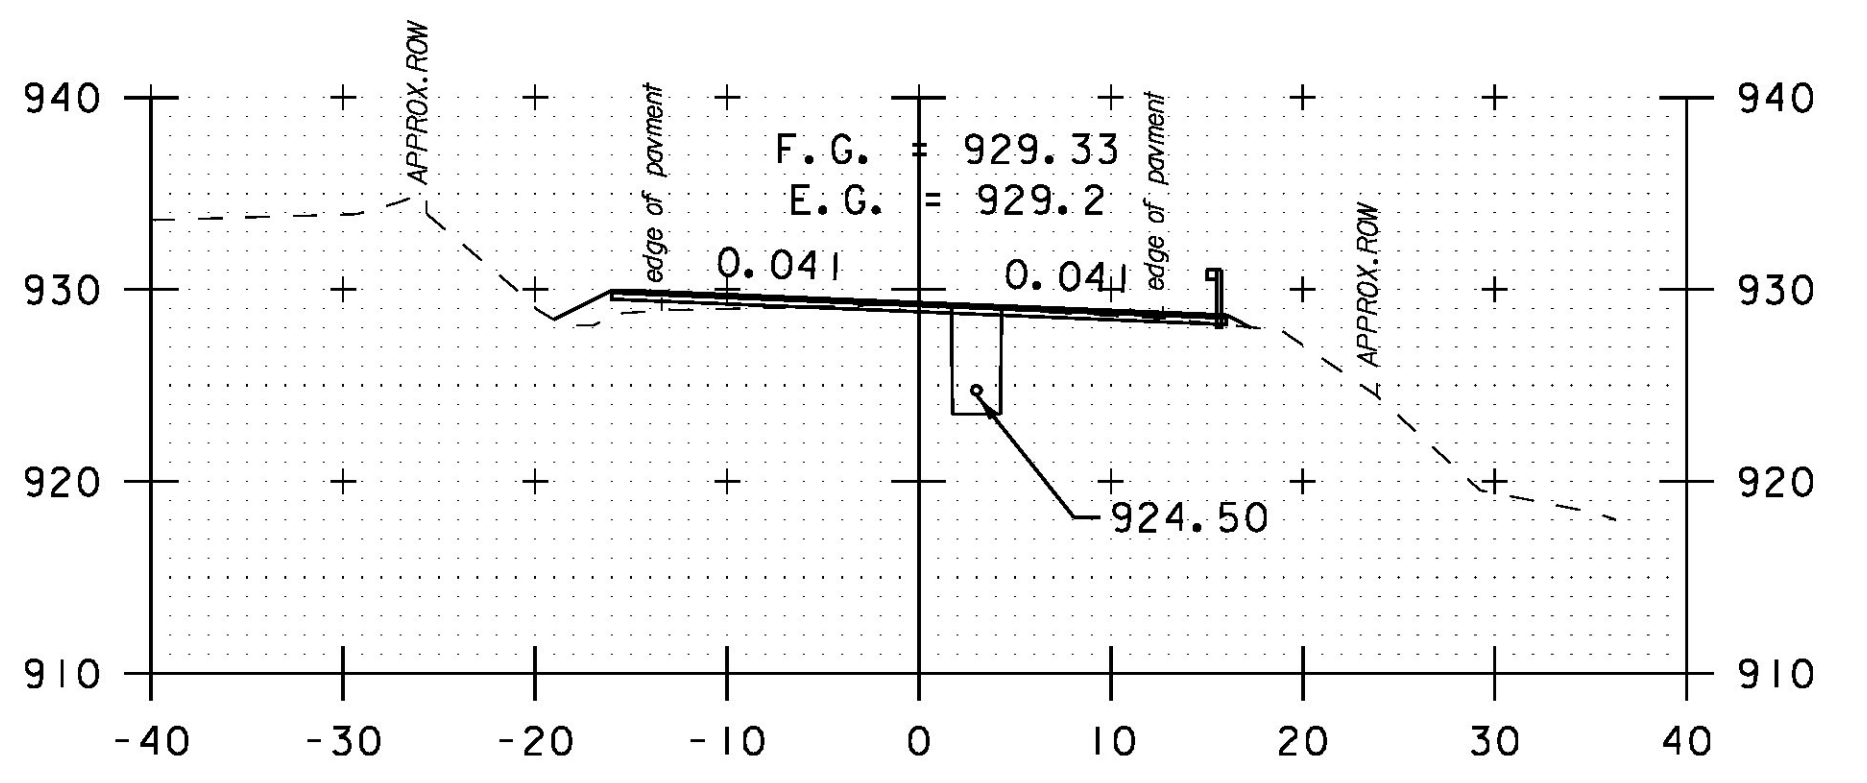

364+50

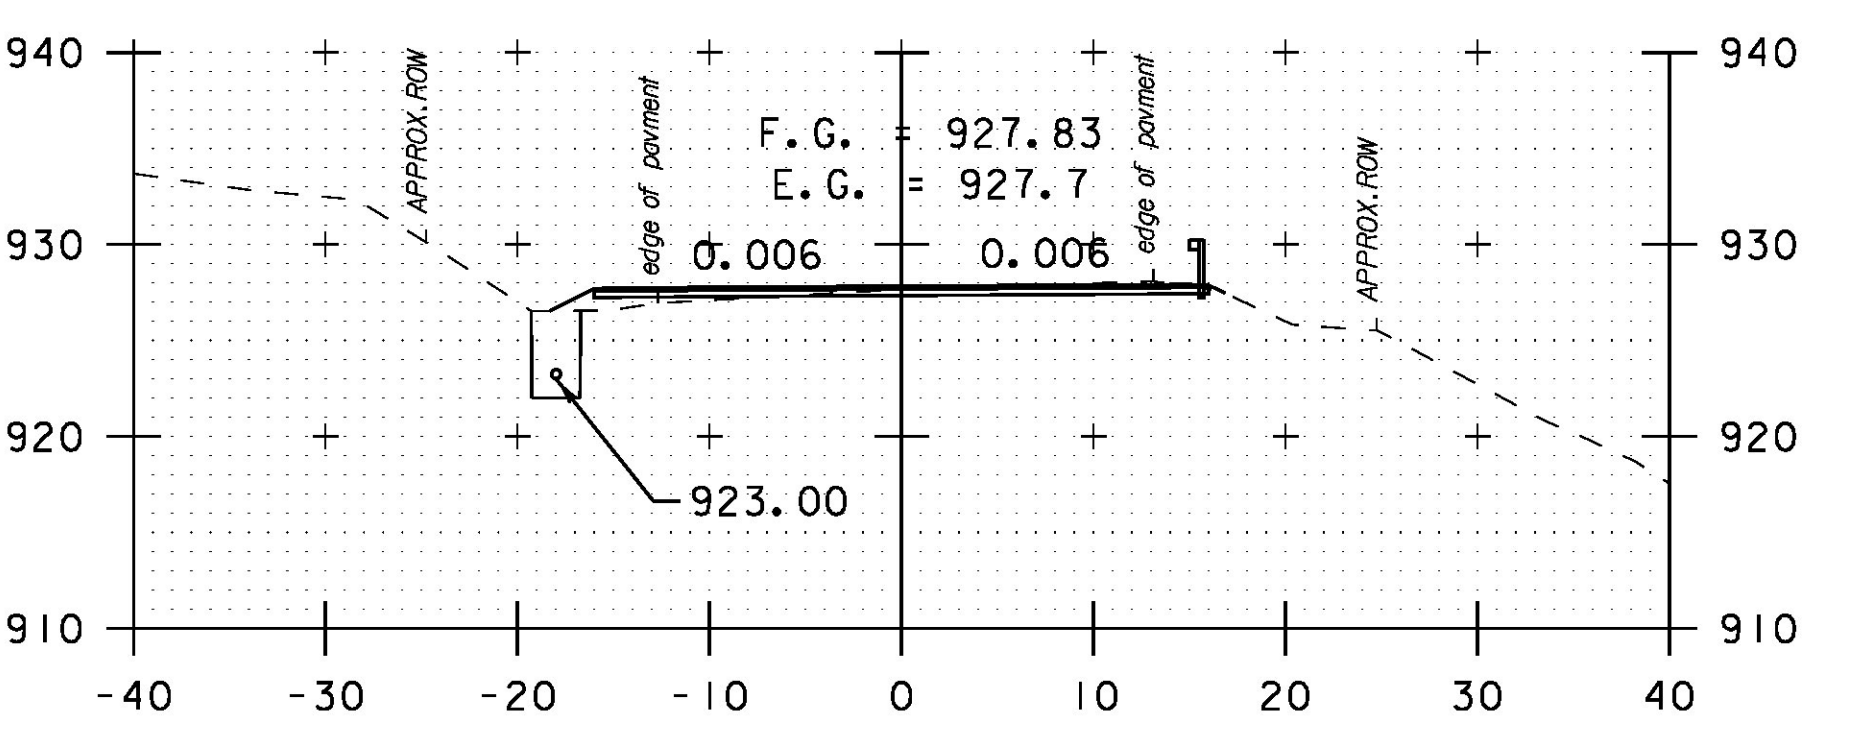

365+50



PROJECT NAME:	HANCOCK
PROJECT NUMBER:	STP 2923 (1)
FILE NAME:	z10c252xs.dgn
PROJECT LEADER:	C. LATHROP
DESIGNED BY:	B. MARTIN
CHECKED BY:	C. LATHROP
CROSS SECTION SHEET:	72
PLOT DATE:	3/18/2015
DRAWN BY:	B. MARTIN
CHECKED BY:	C. LATHROP
SHEET:	199 OF 207