




378+00

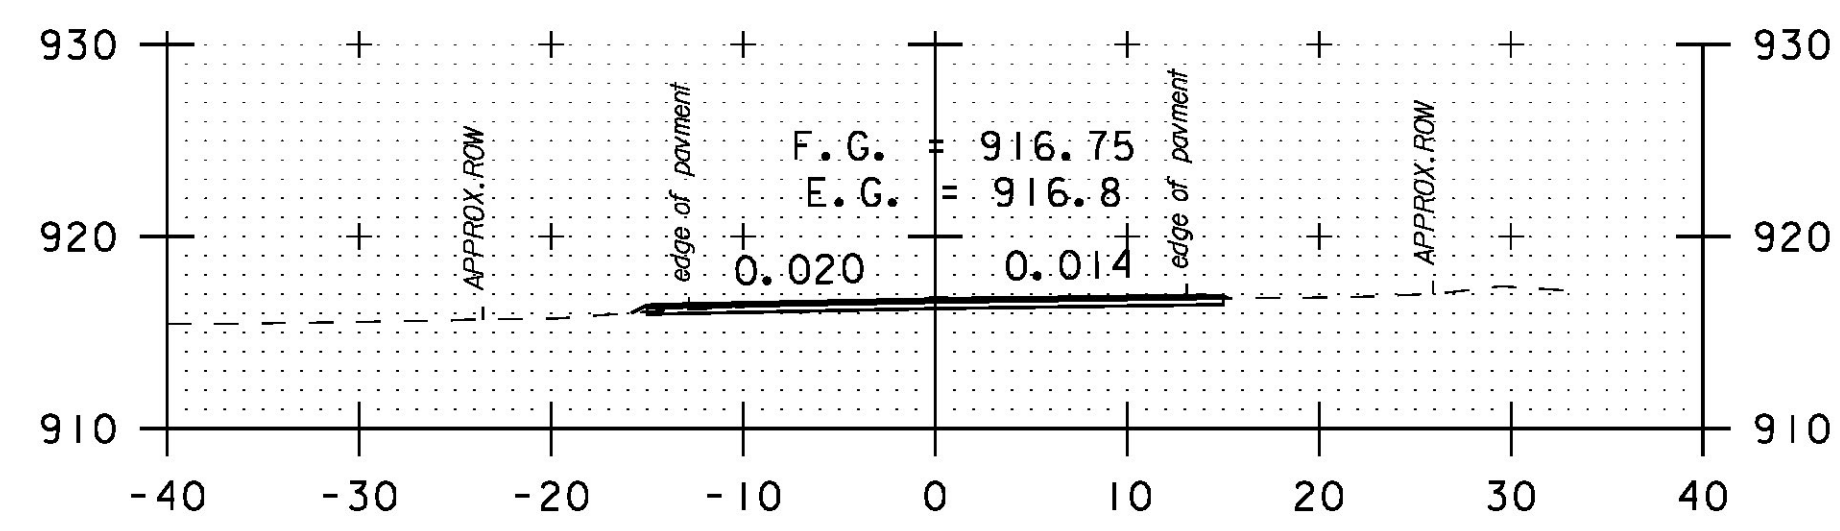


377+00  
DRIVE RT

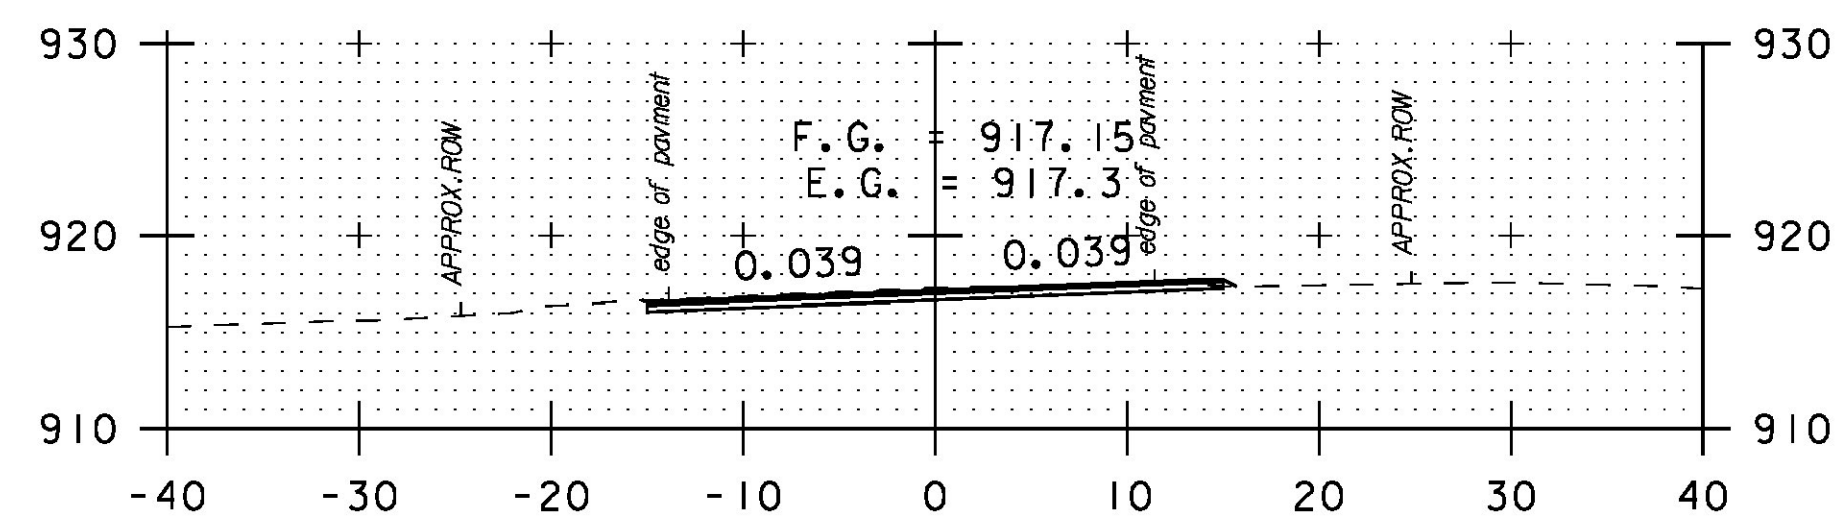


377+00

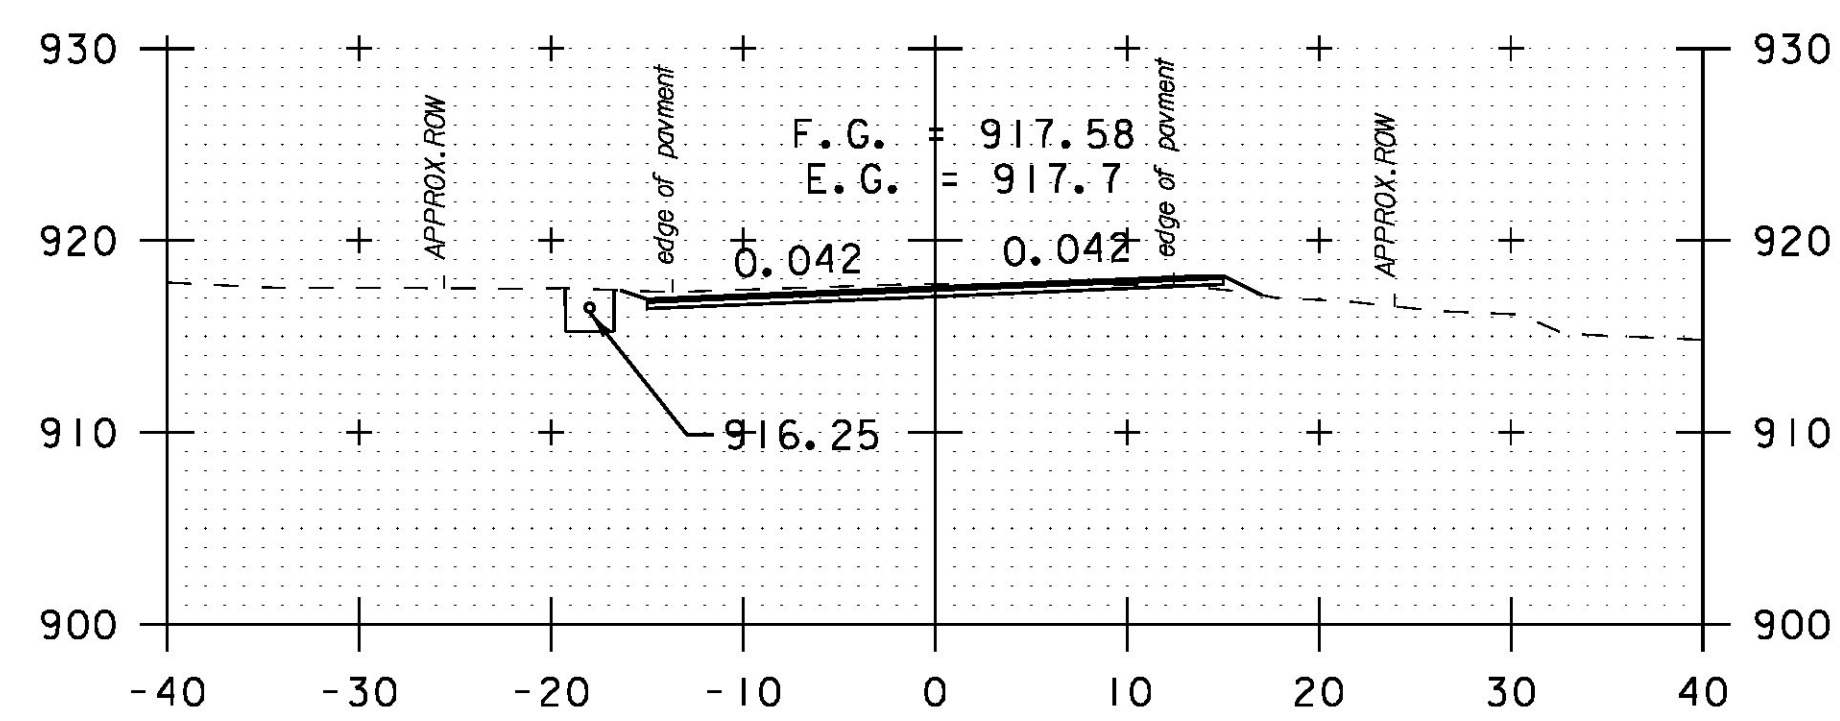


376+50

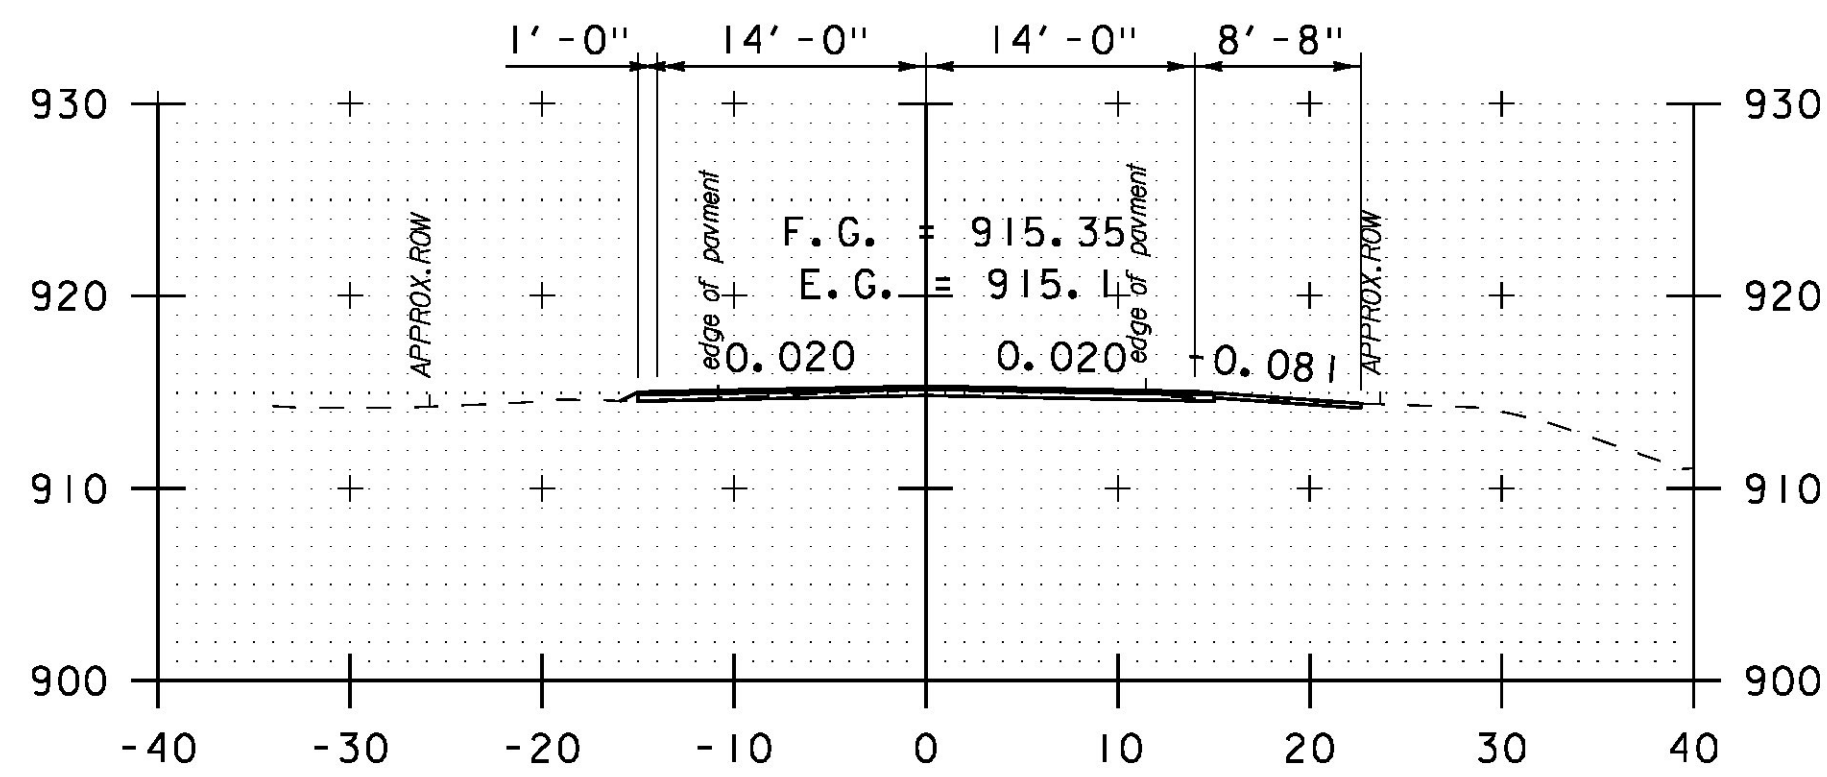


379+50

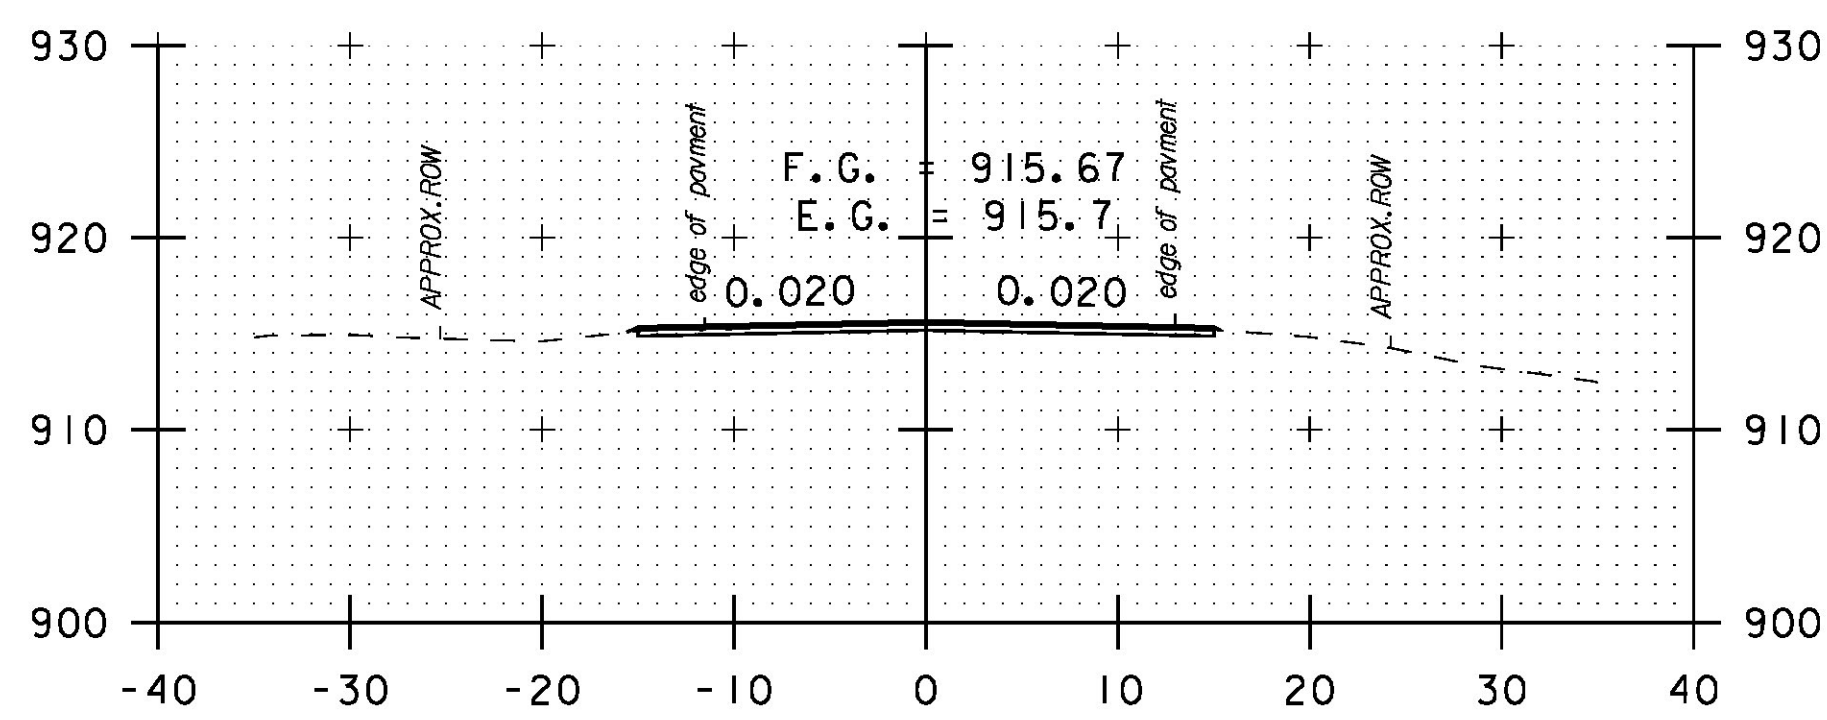


379+00

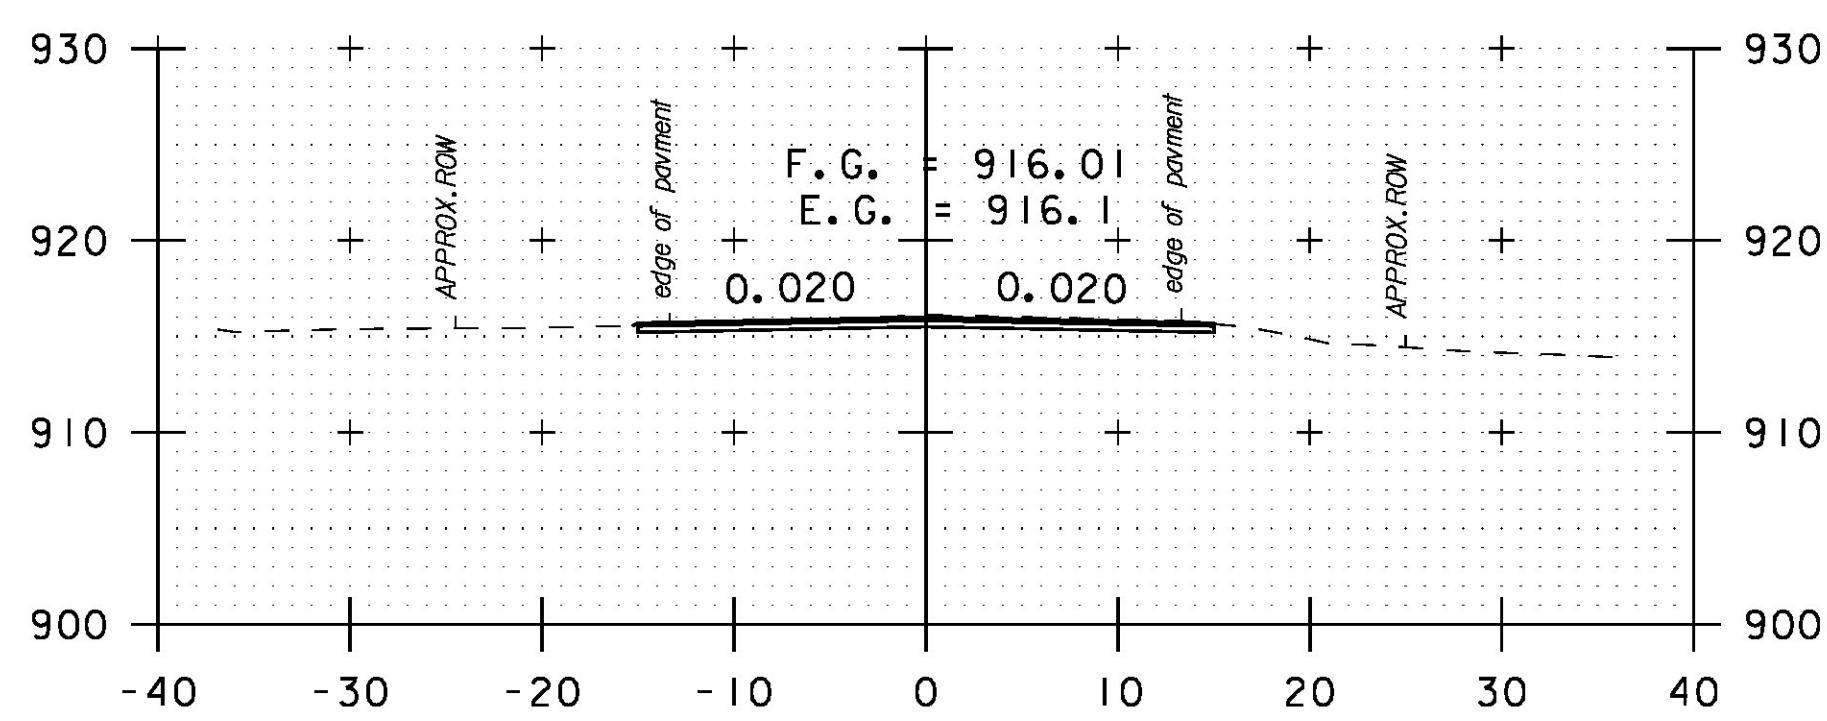


378+50

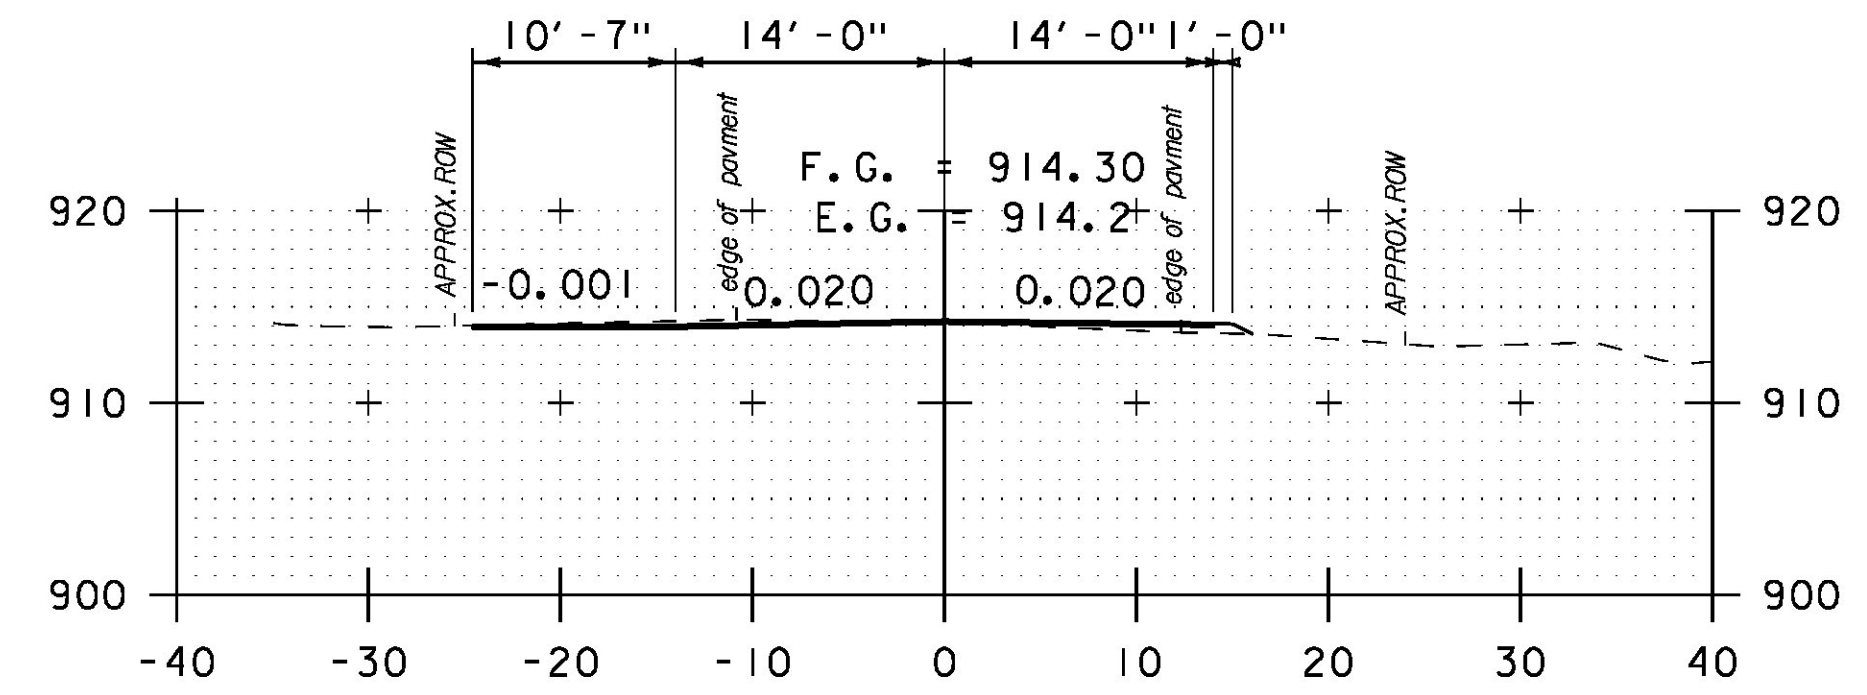


381+50

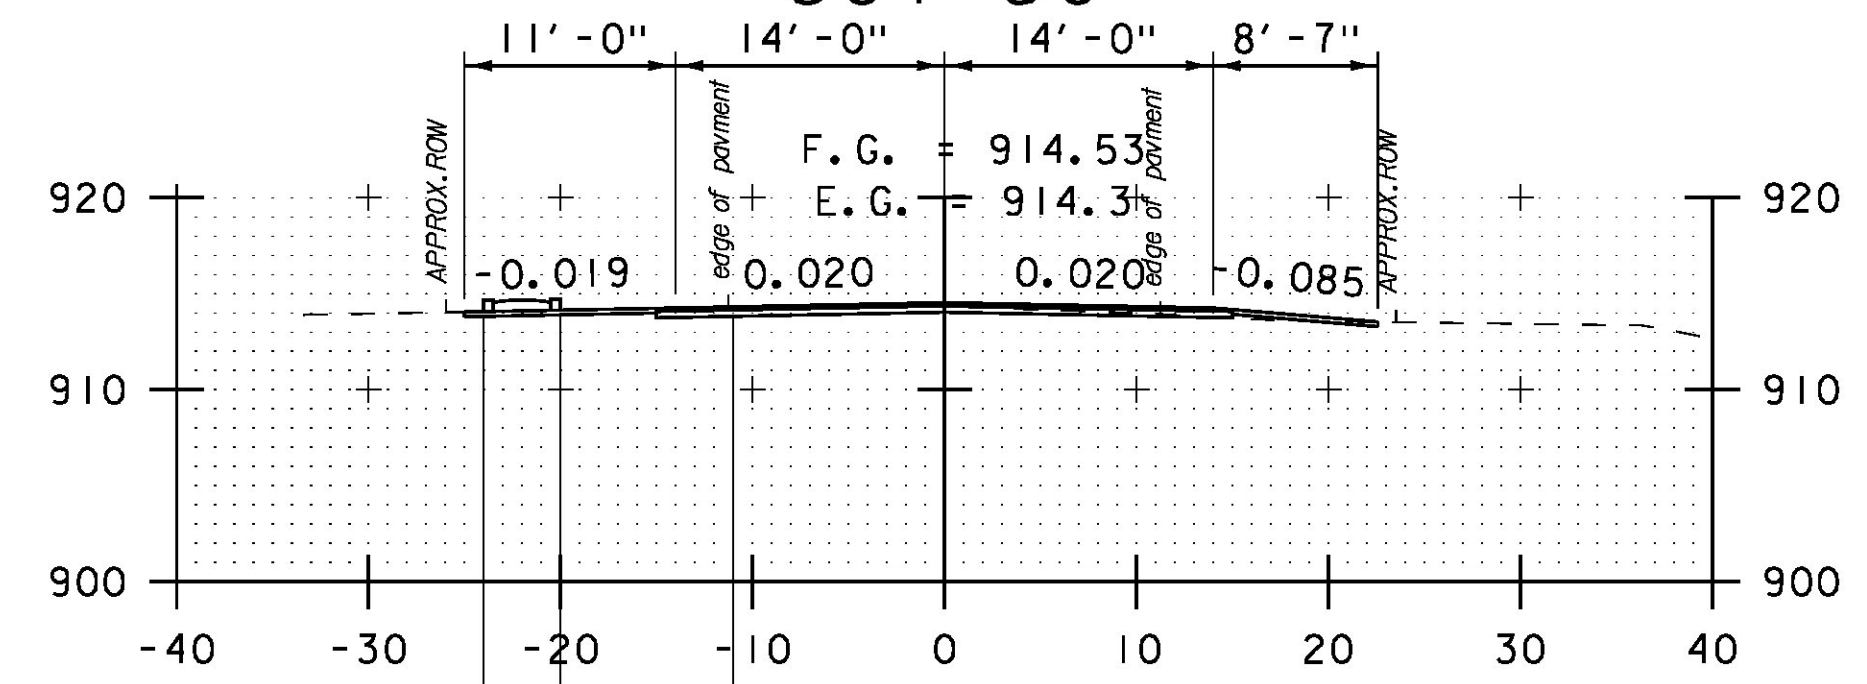


381+00

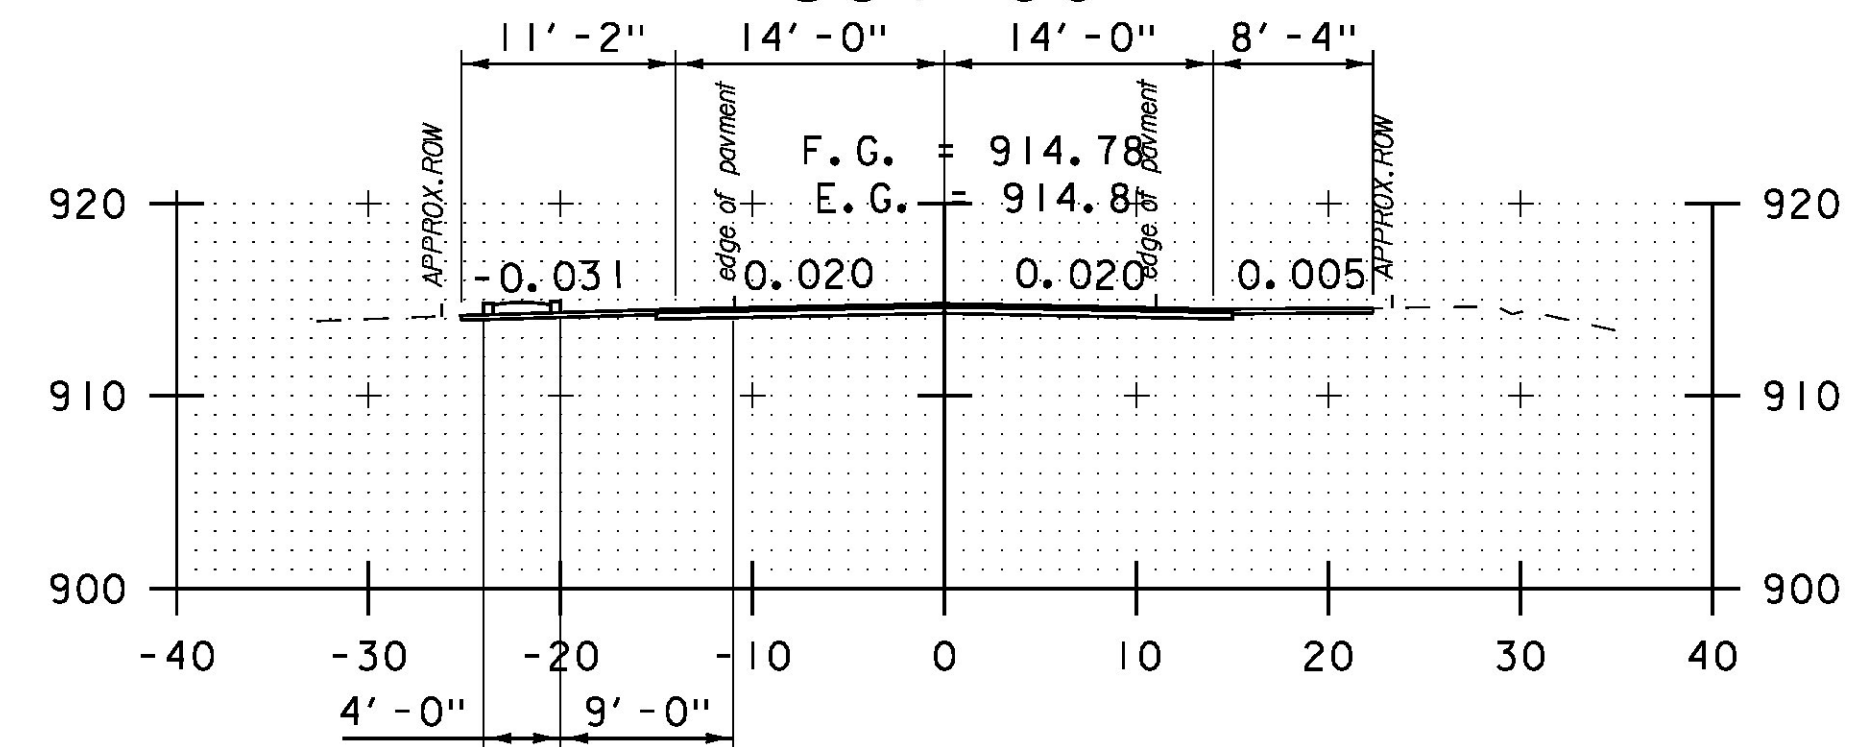

380+50

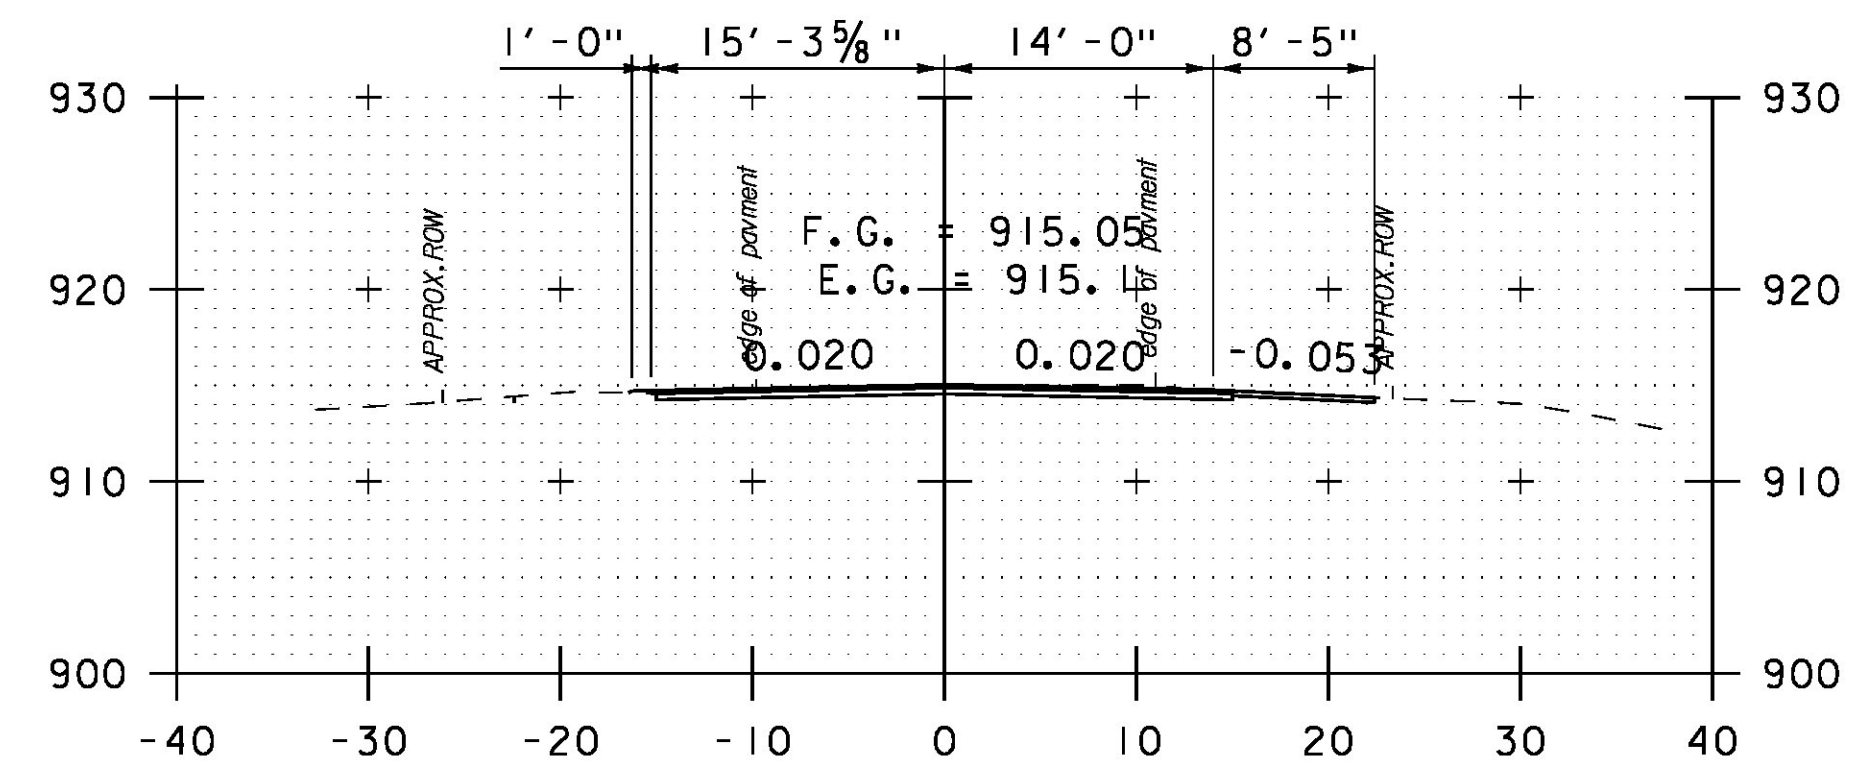

380+00

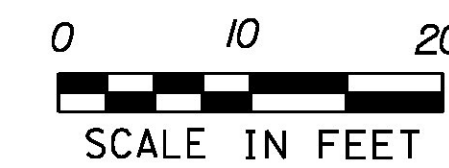

PROJECT NAME: HANCOCK  
PROJECT NUMBER: STP 2923 (1)

FILE NAME: z10c252xs.dgn  
PROJECT LEADER: C. LATHROP  
DESIGNED BY: B. MARTIN  
CROSS SECTION SHEET 75

PLOT DATE: 3/18/2015  
DRAWN BY: B. MARTIN  
CHECKED BY: C. LATHROP  
SHEET 202 OF 207