



END PROJECT
STA. 382+48
MATCH EXISTING


EXISTING GROUND (TYP.)

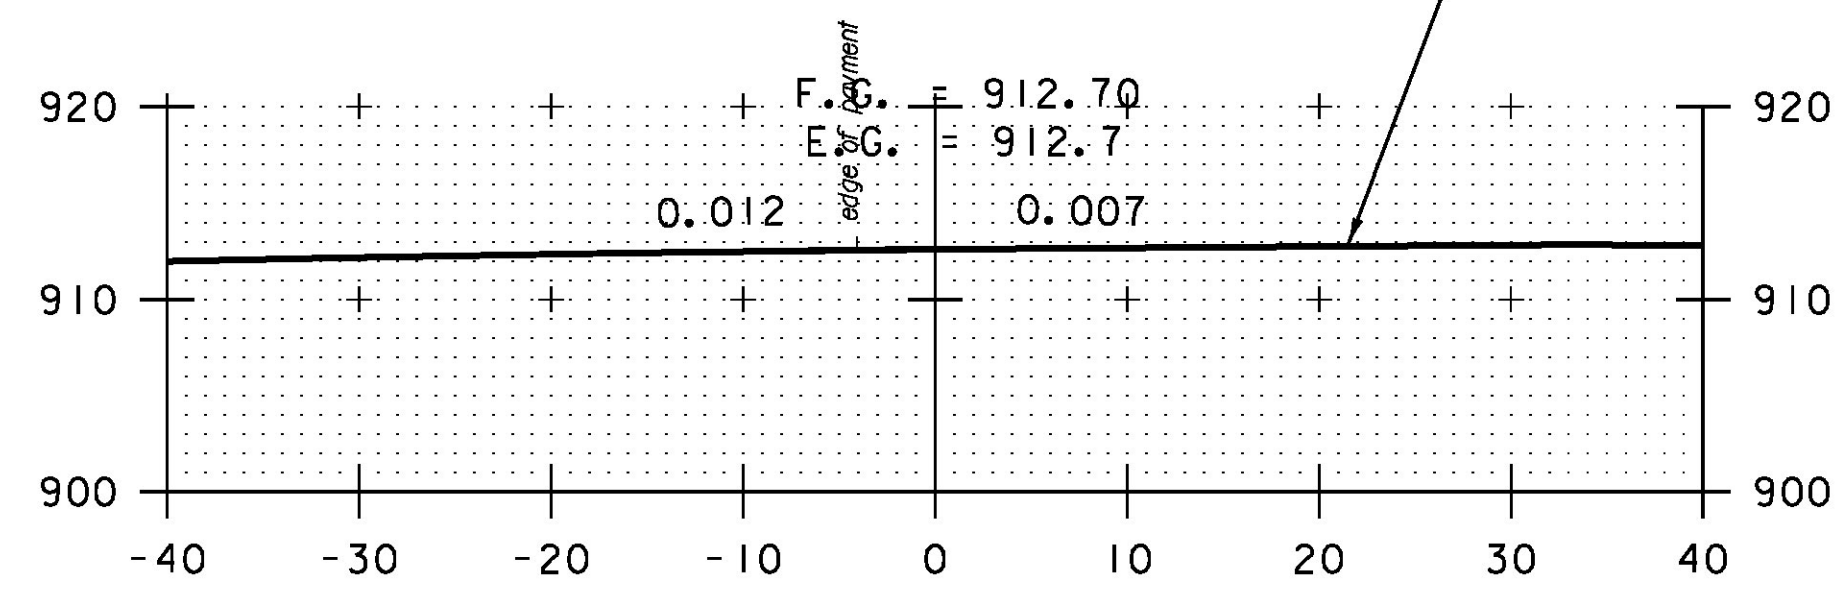

382+48

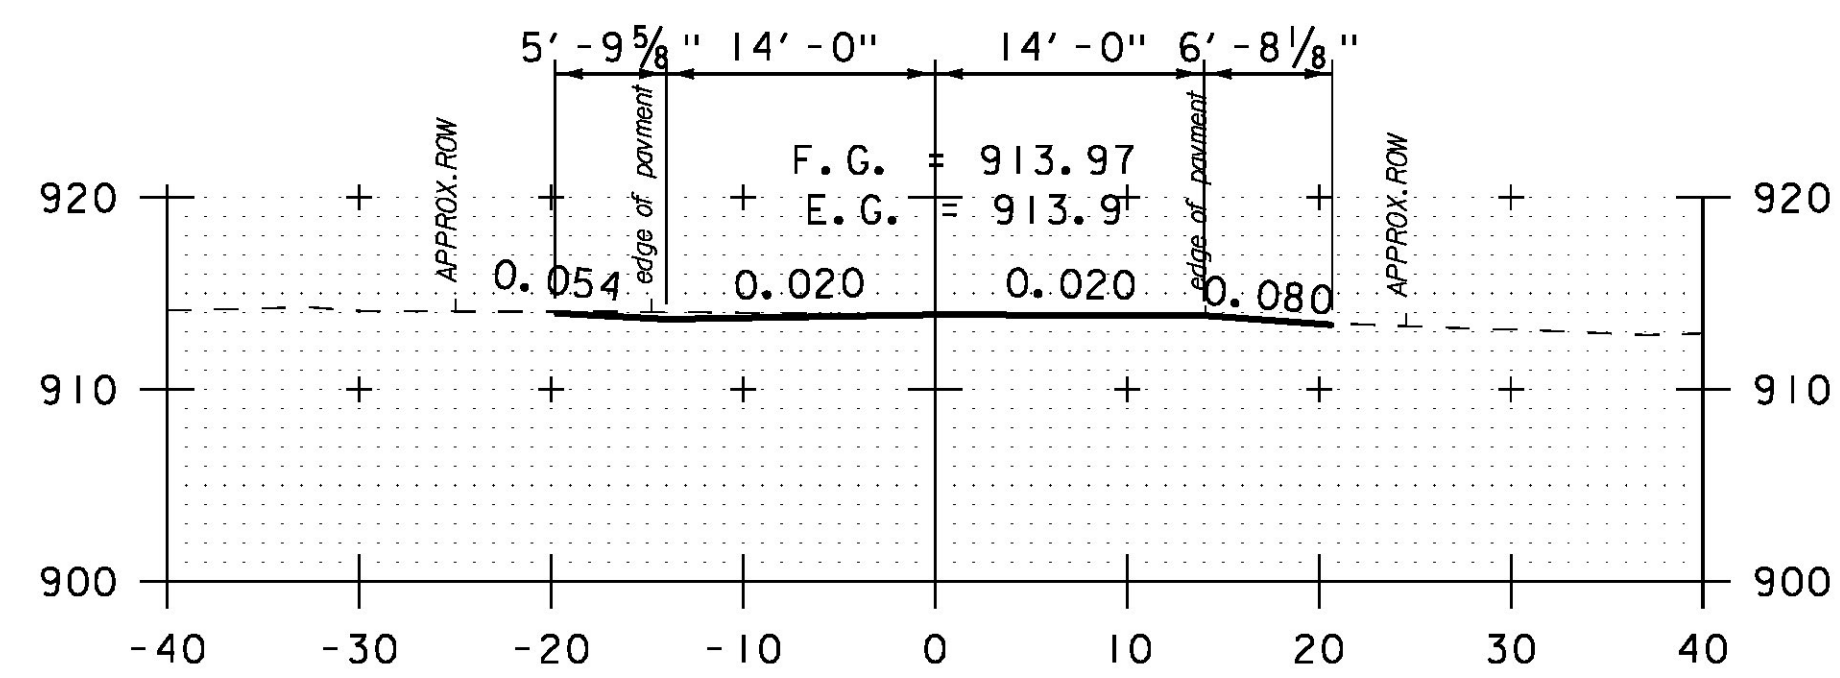

382+00

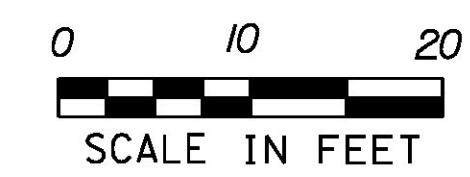

PROJECT NAME: HANCOCK	PLOT DATE: 3/18/2015
PROJECT NUMBER: STP 2923 (1)	DRAWN BY: B. MARTIN
FILE NAME: z10c252xs.dgn	CHECKED BY: C. LATHROP
PROJECT LEADER: C. LATHROP	SHEET 203 OF 207
DESIGNED BY: B. MARTIN	
CROSS SECTION SHEET 76	