


ST. JOHNSBURY
PIERCE ROAD MM 6.250 = STA. 330+00

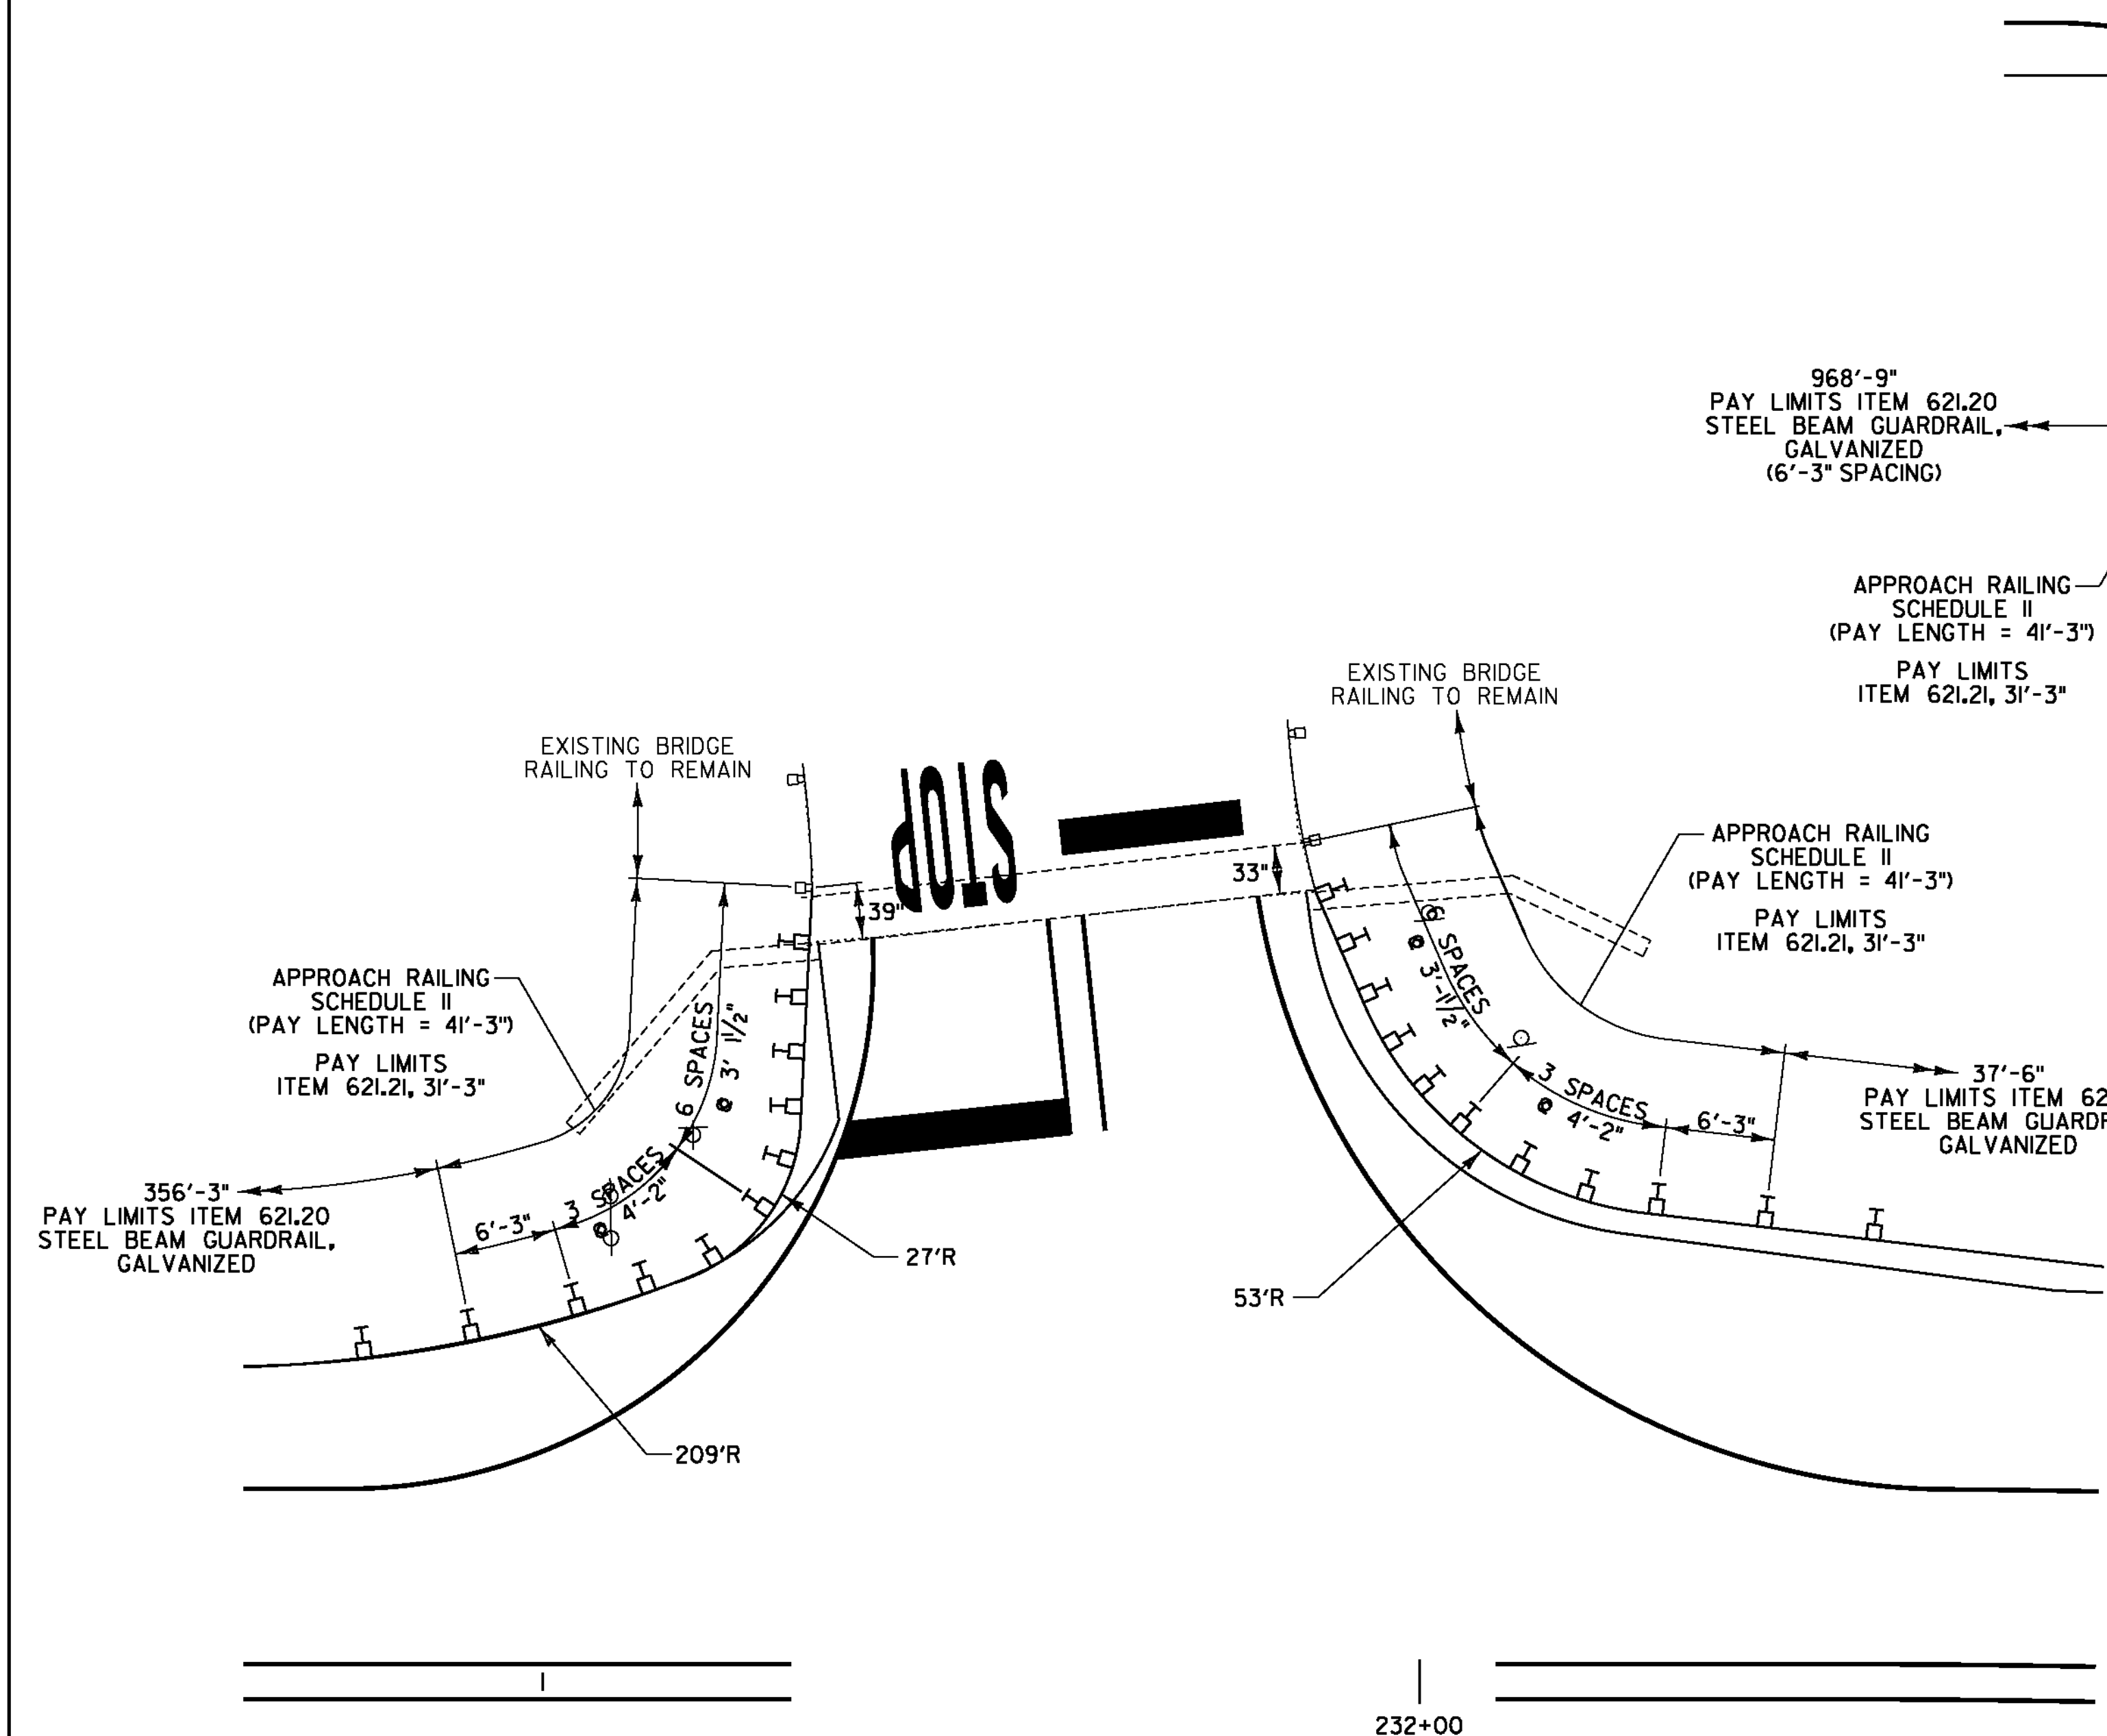

ST. JOHNSBURY
DEPOT HILL ROAD MM 4.390 = STA. 231+84

NOT TO SCALE

**BRIDGE
 DETAIL
 SHEET #2**



PROJECT NAME: ST. JOHNSBURY-LYNDON	
PROJECT NUMBER: STP 2928(I)	
FILE NAME: p10c262.dgn	PLOT DATE: 10/17/2013
PROJECT LEADER: JLL	DRAWN BY: STANTEC
DESIGNED BY: MCF	CHECKED BY: JLL
IPARM FILE: p10b266bds2.i	SHEET 21 OF 133