


**STEEL BEAM GUARDRAIL, GALVANIZED**  
 STA. 160+00 TO 165+00, LT  
**REMOVAL AND DISPOSAL OF GUARDRAIL**  
 STA. 160+00 TO 165+00, LT

**DURABLE & TEMPORARY 4 INCH WHITE LINE**  
 (ALL LINES WILL INCLUDE EDGE LINE BREAKS  
 AND RADII FOR SIDE ROADS)  
 STA. 160+00 TO 165+00, SOLID LT & RT

**DURABLE & TEMPORARY 4 INCH YELLOW LINE**  
 (ALL LINES WILL INCLUDE  $\phi$  BREAKS FOR SIDE ROADS)  
 STA. 160+00 TO 165+00, SOLID LT & RT

**REMOVING SIGNS**  
 AS SHOWN - 8

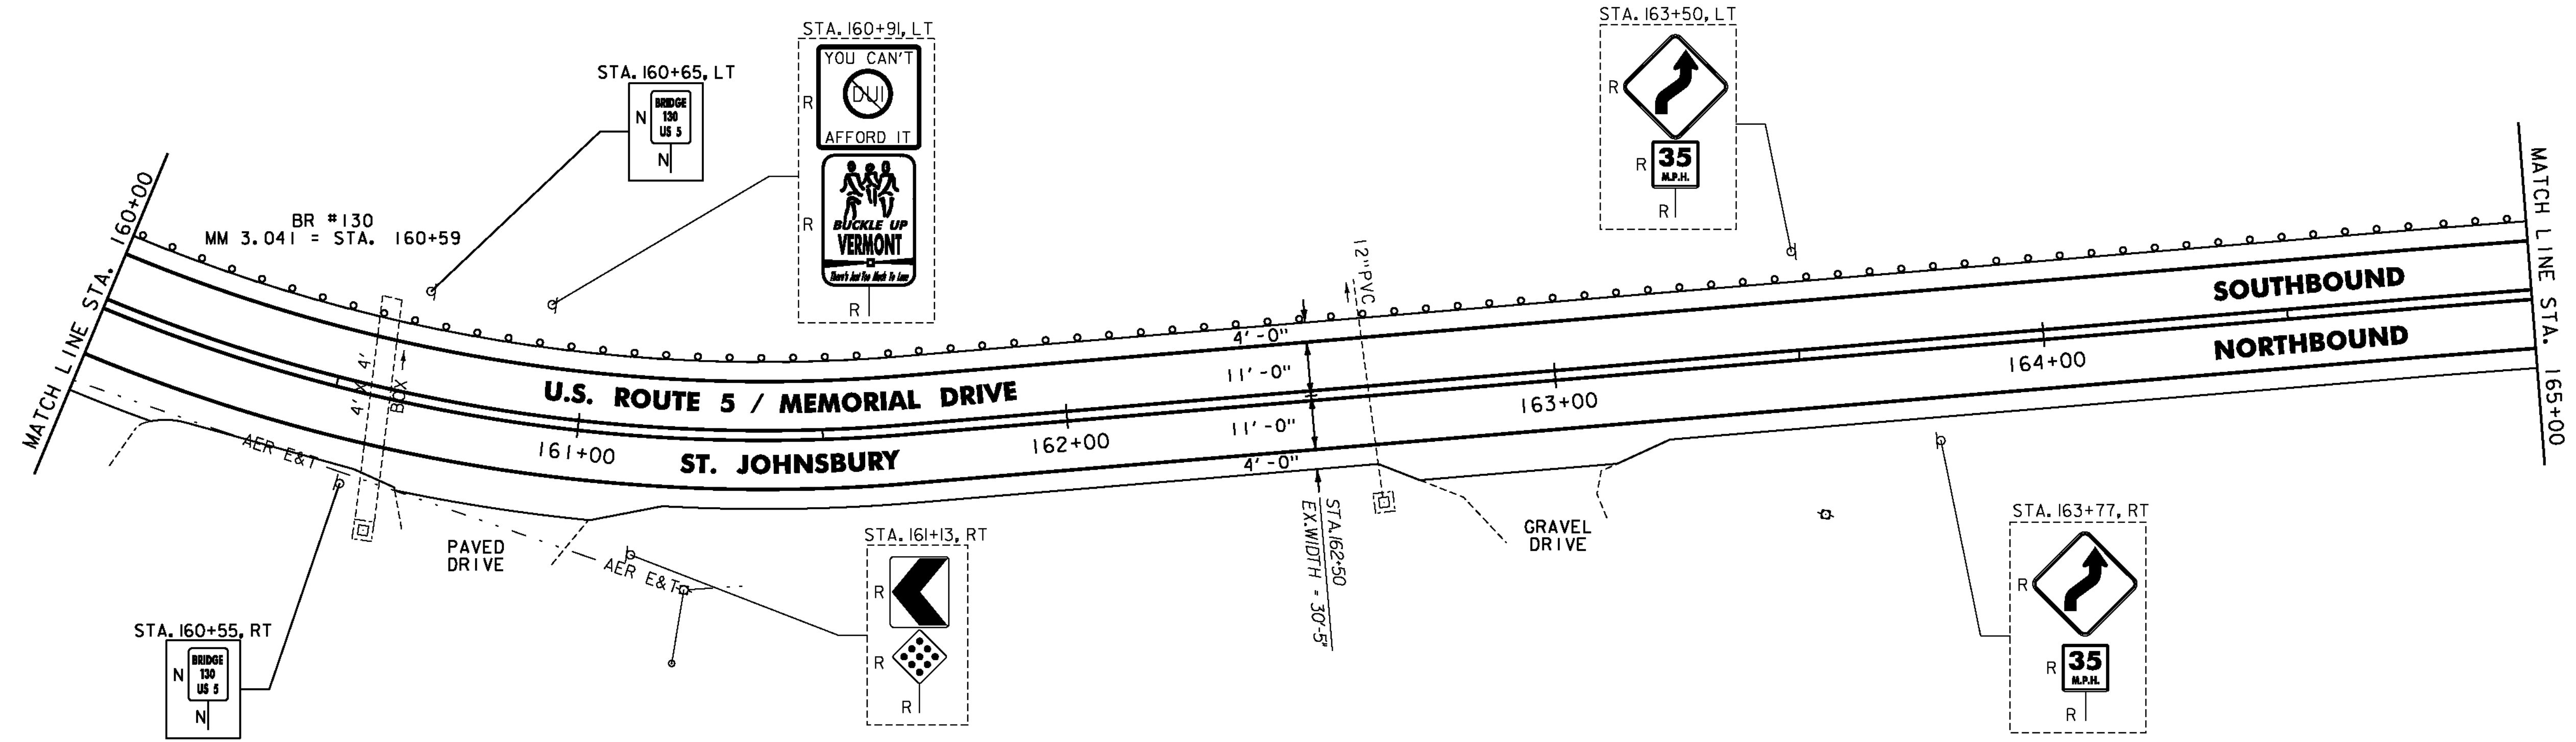

**STONE FILL, TYPE I**  
 STA. 166+78 TO 167+23, LT

**STEEL BEAM GUARDRAIL, GALVANIZED**  
 STA. 165+00 TO 168+48, LT

**ANCHOR FOR STEEL BEAM RAIL**  
 STA. 168+48, LT

**REMOVAL AND DISPOSAL OF GUARDRAIL**  
 STA. 165+00 TO 168+42, LT


**DURABLE & TEMPORARY 4 INCH WHITE LINE**  
 (ALL LINES WILL INCLUDE EDGE LINE BREAKS  
 AND RADII FOR SIDE ROADS)  
 STA. 165+00 TO 170+00, SOLID LT & RT

**DURABLE & TEMPORARY 4 INCH YELLOW LINE**  
 (ALL LINES WILL INCLUDE  $\phi$  BREAKS FOR SIDE ROADS)  
 STA. 165+00 TO 170+00, SOLID LT & RT

**GEOTEXTILE UNDER STONE FILL**  
 STA. 166+78 TO 167+23, LT

**GRUBBING MATERIAL**  
 STA. 166+78 TO 167+23, LT

**REMOVING SIGNS**  
 AS SHOWN - 1

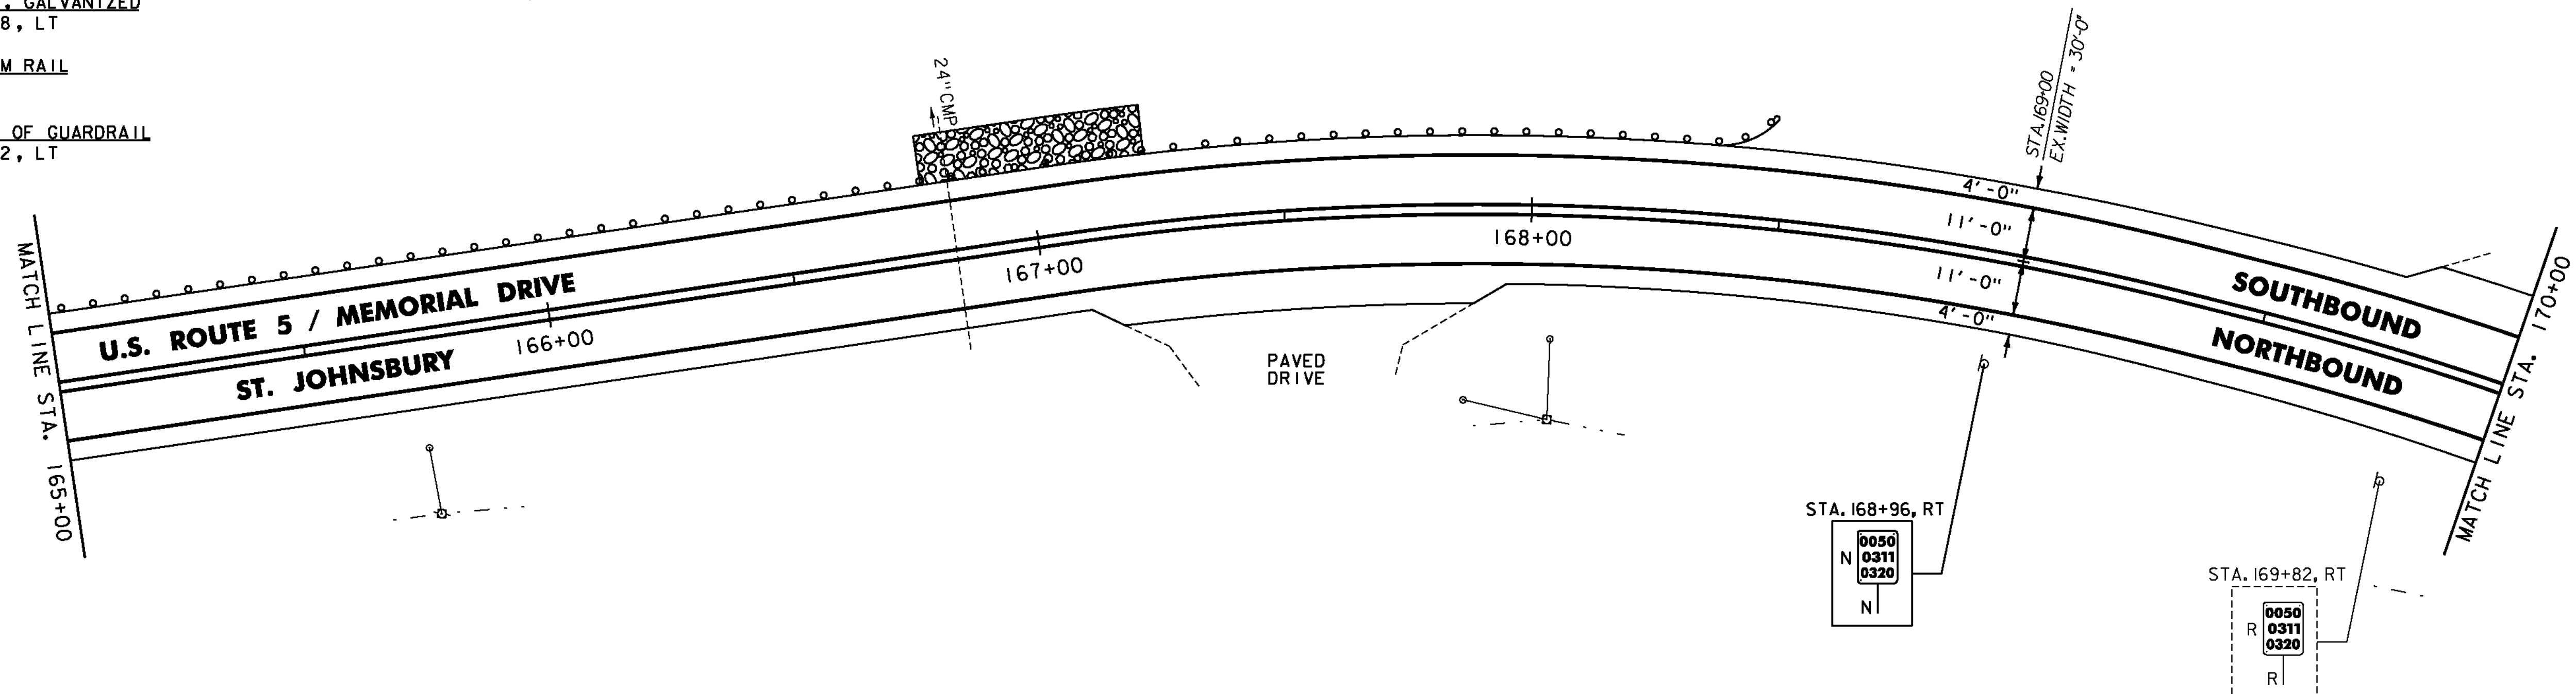

**NOTES:**

1. FOR LEGENDS, SEE SHEET 33.
2. ALL EXISTING SIGNS NOT SHOWN SHALL BE RETAINED.
3. DURABLE MARKINGS DETAILED ON THIS SHEET ARE OPTION BID ITEMS. SEE SHEETS 6-7.

NOT TO SCALE



**PROJECT LAYOUT SHEET #2**

PROJECT NAME: ST. JOHNSBURY-LYNDON

PROJECT NUMBER: STP 2928(I)

FILE NAME: p10c262.dgn

PROJECT LEADER: JLL

DESIGNED BY: MCF

IPARM FILE: p10c262102.i

PLOT DATE: 10/17/2013

DRAWN BY: STANTEC

CHECKED BY: JLL

SHEET 34 OF 133