

MILLED RUMBLE STRIPS
STA. 359+75 TO 365+00, ☐

STEEL BEAM GUARDRAIL, GALVANIZED
STA. 359+84.5 TO 362+86.5, RT


STEEL BEAM GUARDRAIL, GALVANIZED W/8 FEET POSTS
STA. 360+09 TO 361+56, LT

ANCHOR FOR STEEL BEAM RAIL
STA. 359+84.5, RT
STA. 360+09.0, LT
STA. 361+56.0, LT
STA. 362+86.5, RT

REMOVAL AND DISPOSAL OF GUARDRAIL
STA. 359+86 TO 362+88, RT
STA. 360+15 TO 361+56, LT

DURABLE & TEMPORARY 4 INCH WHITE LINE
(ALL LINES WILL INCLUDE EDGE LINE BREAKS
AND RADII FOR SIDE ROADS)
STA. 359+75 TO 365+00, SOLID LT & RT

DURABLE & TEMPORARY 4 INCH YELLOW LINE
(ALL LINES WILL INCLUDE ☐ BREAKS FOR SIDE ROADS)
STA. 359+75 TO 365+00, SOLID LT & RT

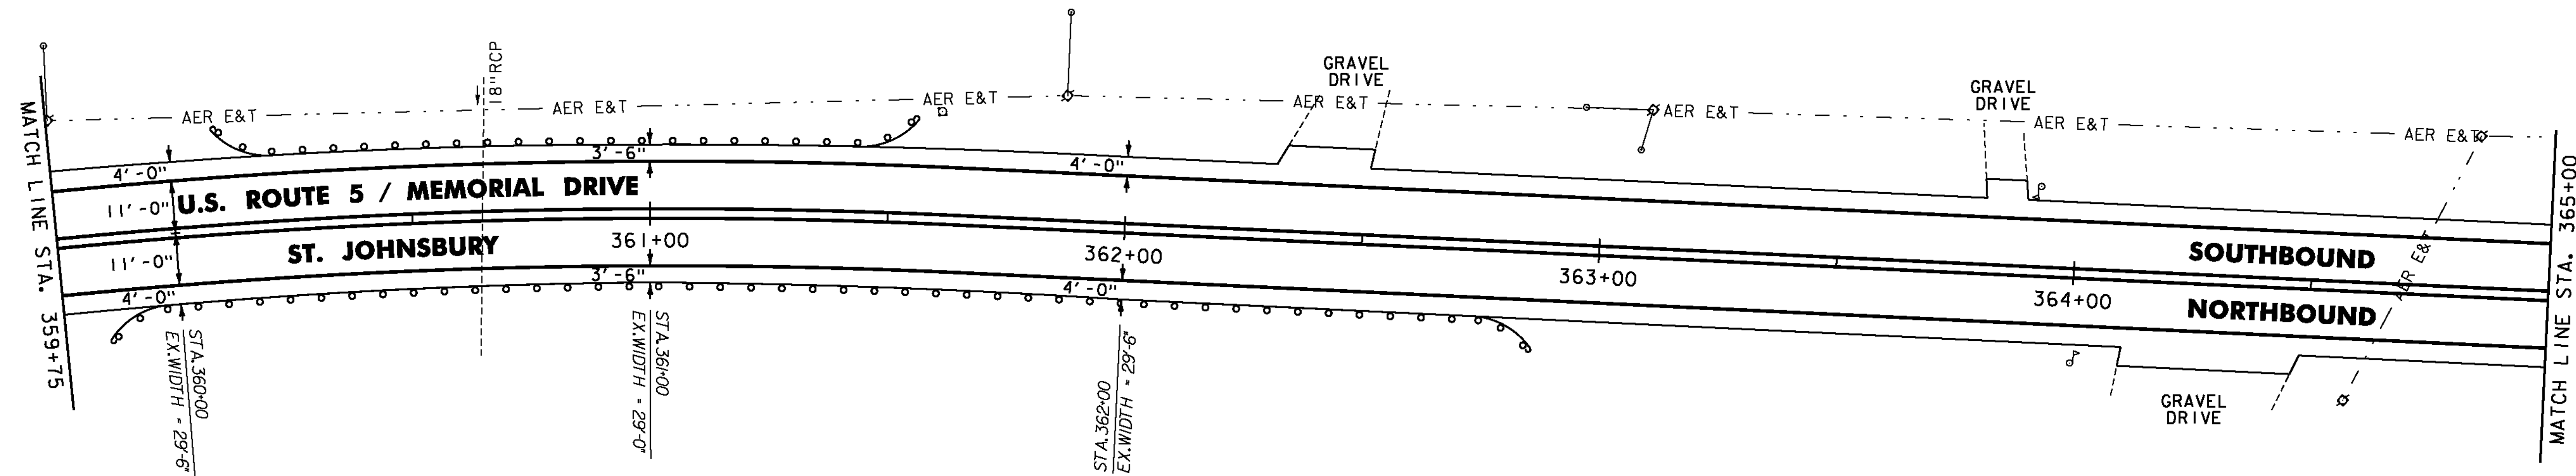

MILLED RUMBLE STRIPS
STA. 365+00 TO 370+00, ☐


STEEL BEAM GUARDRAIL, GALVANIZED
STA. 367+66.5 TO 370+00, RT

ANCHOR FOR STEEL BEAM RAIL
STA. 367+66.5, RT

REMOVAL AND DISPOSAL OF GUARDRAIL
STA. 367+66.5 TO 370+00, RT

DURABLE & TEMPORARY 4 INCH WHITE LINE
(ALL LINES WILL INCLUDE EDGE LINE BREAKS
AND RADII FOR SIDE ROADS)
STA. 365+00 TO 370+00, SOLID LT & RT

DURABLE & TEMPORARY 4 INCH YELLOW LINE
(ALL LINES WILL INCLUDE ☐ BREAKS FOR SIDE ROADS)
STA. 365+00 TO 370+00, SOLID LT & RT

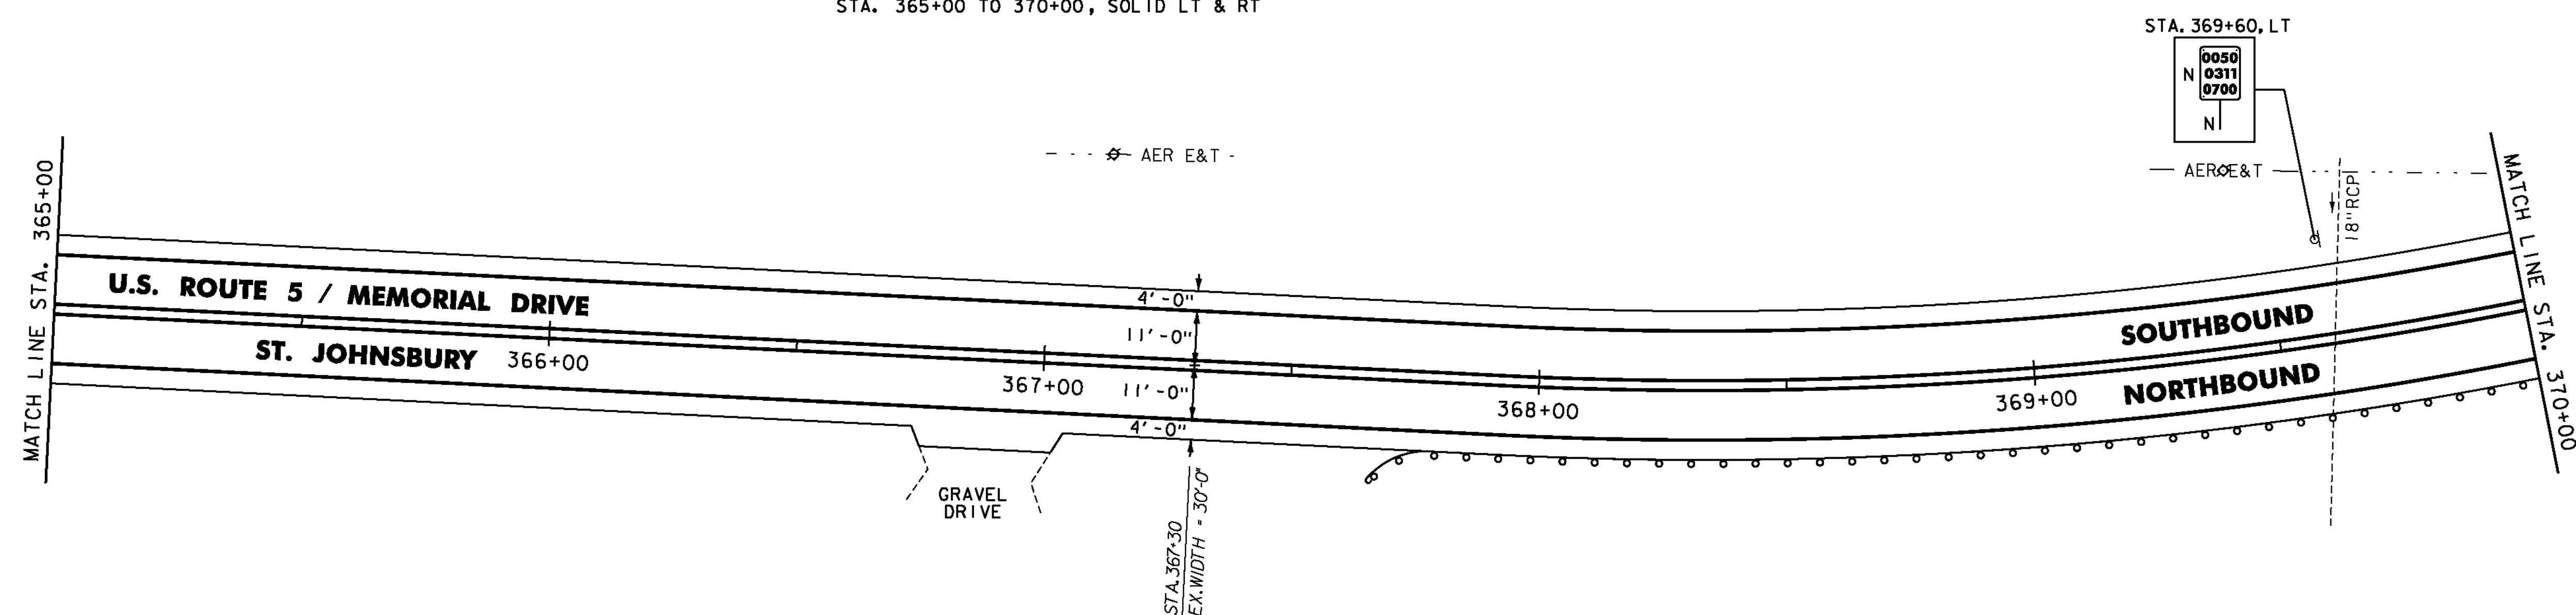

NOTES:

- FOR LEGENDS, SEE SHEET 33.
- ALL EXISTING SIGNS NOT SHOWN SHALL BE RETAINED.
- DURABLE MARKINGS DETAILED ON THIS SHEET ARE OPTION BID ITEMS. SEE SHEETS 6-7.

NOT TO SCALE



PROJECT LAYOUT SHEET #26

PROJECT NAME: ST. JOHNSBURY-LYNDON

PROJECT NUMBER: STP 2928(I)

FILE NAME: p10c262.dgn

PROJECT LEADER: JLL

DESIGNED BY: MCF

IPARM FILE: p10c262i26.i

PLOT DATE: 10/17/2013

DRAWN BY: STANTEC

CHECKED BY: JLL

SHEET 58 OF 133