


MILLED RUMBLE STRIPS
STA. 400+00 TO 405+00, ☒

DURABLE & TEMPORARY 4 INCH WHITE LINE
(ALL LINES WILL INCLUDE EDGE LINE BREAKS
AND RADI1 FOR SIDE ROADS)
STA. 400+00 TO 405+00, SOLID LT & RT

DURABLE & TEMPORARY 4 INCH YELLOW LINE
(ALL LINES WILL INCLUDE ☒ BREAKS FOR SIDE ROADS)
STA. 400+00 TO 405+00, SOLID LT & RT

REMOVING SIGNS
AS SHOWN - 1

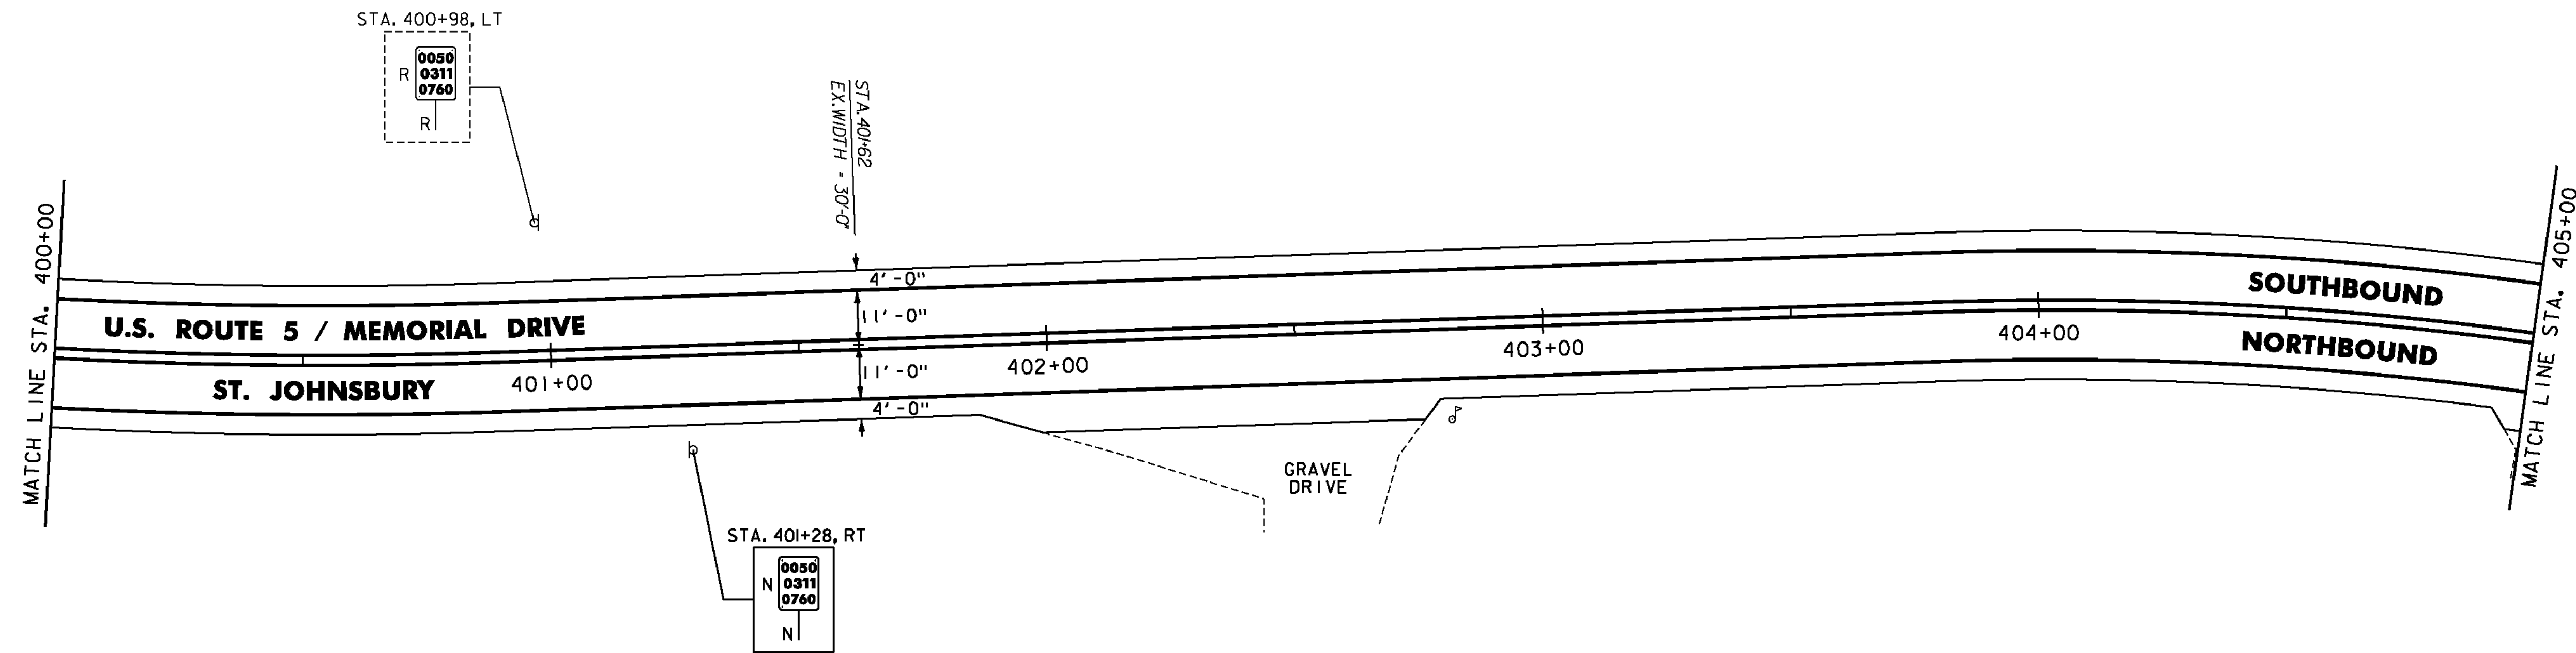


ST. JOHNSBURY STA. 405+26, LT
LYNDON STA. 0+00, LT

MILLED RUMBLE STRIPS
ST. JOHNSBURY STA. 405+00 TO 405+26.00, ☒
LYNDON STA. 0+00 TO 5+00, ☒

DURABLE & TEMPORARY 4 INCH WHITE LINE
(ALL LINES WILL INCLUDE EDGE LINE BREAKS
AND RADI1 FOR SIDE ROADS)
ST. JOHNSBURY STA. 405+00 TO 405+26.00, SOLID LT & RT
LYNDON STA. 0+00 TO 5+00, SOLID LT & RT

DURABLE & TEMPORARY 4 INCH YELLOW LINE
(ALL LINES WILL INCLUDE ☒ BREAKS FOR SIDE ROADS)
ST. JOHNSBURY STA. 405+00 TO 405+26.00, SOLID LT & RT
LYNDON STA. 0+00 TO 5+00, SOLID LT & RT

REMOVING SIGNS
AS SHOWN - 3

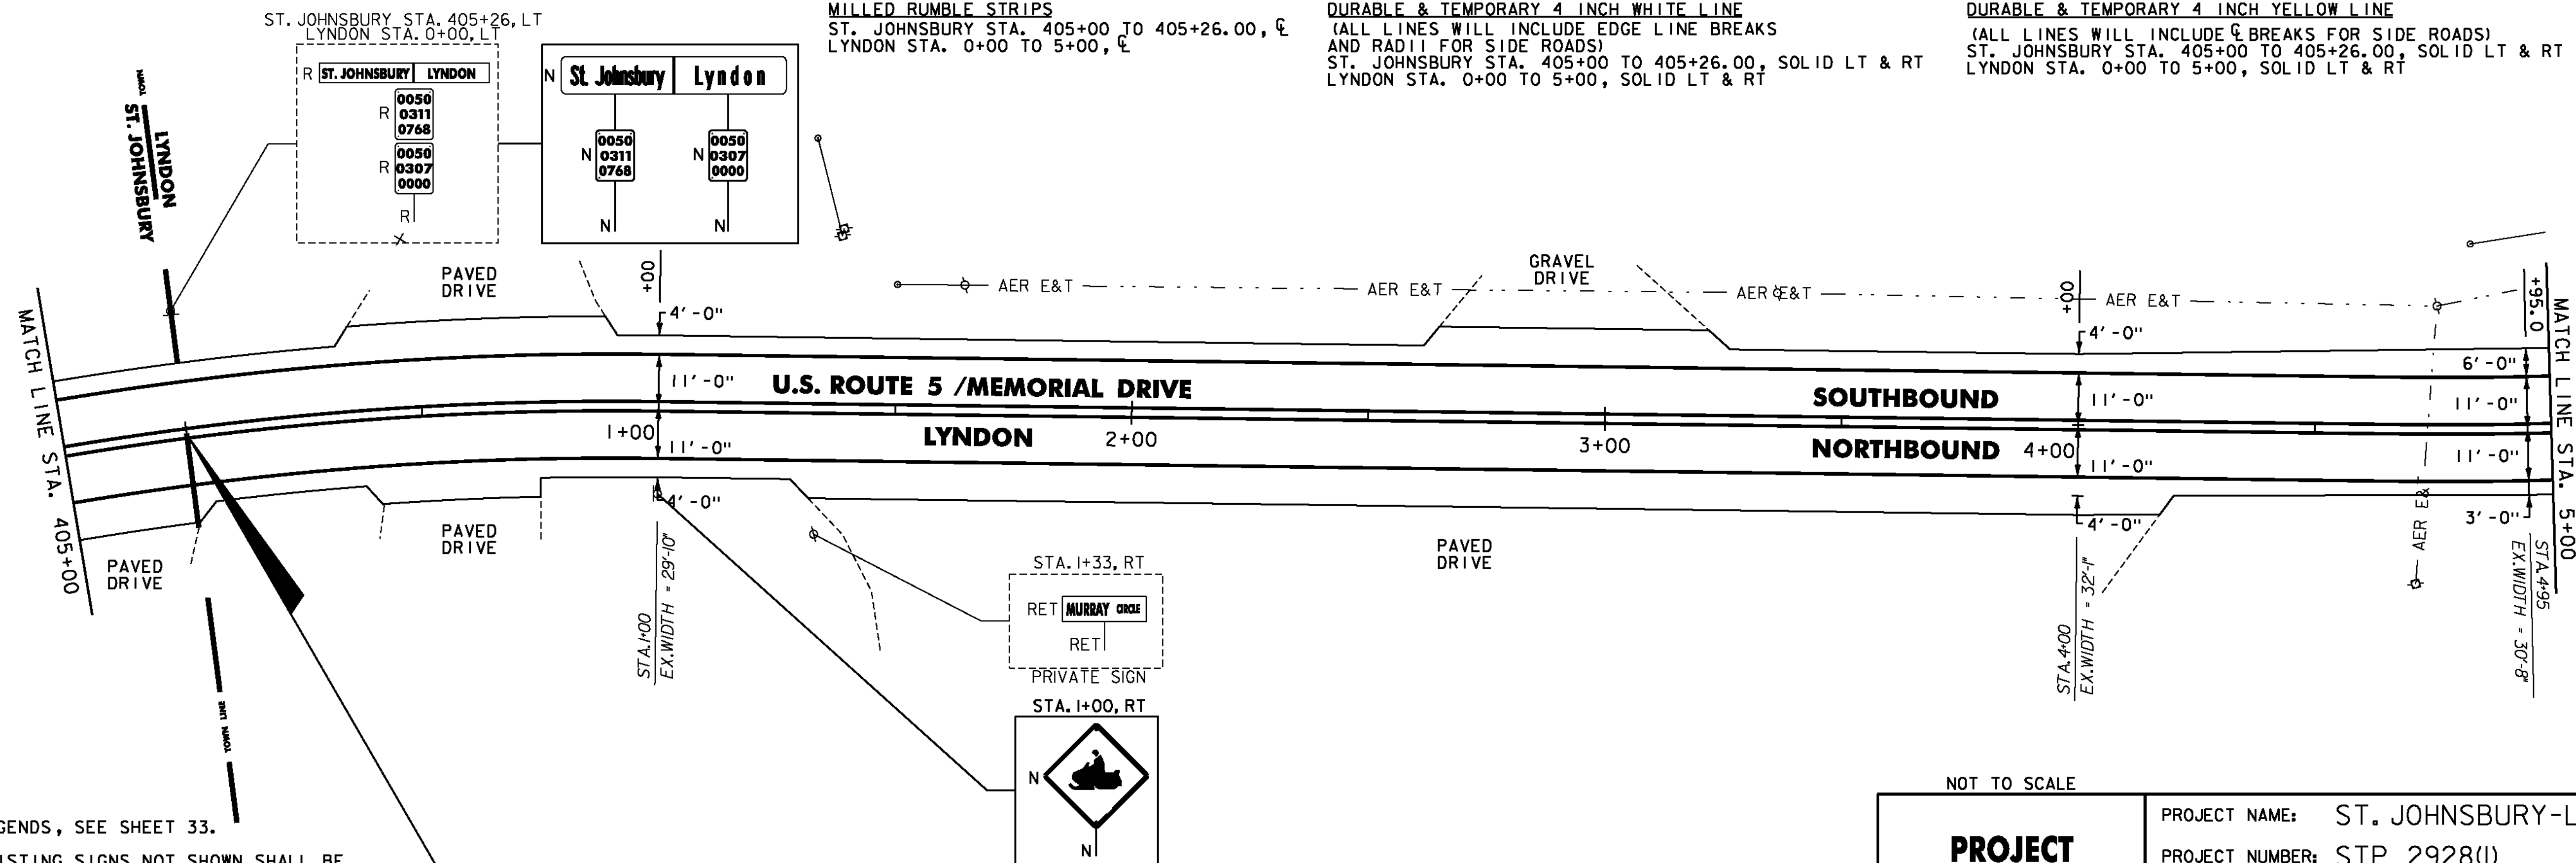

NOTES:

- FOR LEGENDS, SEE SHEET 33.
- ALL EXISTING SIGNS NOT SHOWN SHALL BE RETAINED.
- DURABLE MARKINGS DETAILED ON THIS SHEET ARE OPTION BID ITEMS. SEE SHEETS 6-7.

ST. JOHNSBURY U.S. ROUTE 5 P.O.C. STA. 405+26.00 BACK =
LYNDON U.S. ROUTE 5 P.O.C. STA. 0+00.00 AHEAD



NOT TO SCALE

**PROJECT
LAYOUT
SHEET #30**

PROJECT NAME: ST. JOHNSBURY-LYNDON

PROJECT NUMBER: STP 2928(I)

FILE NAME: p10c262.dgn

PROJECT LEADER: JLL

DESIGNED BY: MCF

IPARM FILE: p10c262i30.i

PLOT DATE: 10/17/2013

DRAWN BY: STANTEC

CHECKED BY: JLL

SHEET 62 OF 133