

REHAB. DIS, CBS OR MHS, CLASS I OR II
 STA. 90+53, LT

REMOVING AND RESETTING CURB
 STA. 90+38, RT

BITUMINOUS CONCRETE GUTTERS AND TRAFFIC ISLANDS
 STA. 87+95, LT
 (FOR DETAIL, SEE SHEET 31)

PORTLAND CEMENT CONCRETE
 SIDEWALK, 5 INCH
 STA. 90+38, RT

DETECTABLE WARNING SURFACE
 STA. 90+38, RT


DURABLE & TEMPORARY 4 INCH WHITE LINE
 (ALL LINES WILL INCLUDE EDGE LINE BREAKS
 AND RADII FOR SIDE ROADS)
 STA. 86+25 TO 91+00, SOLID LT & RT
 STA. 86+25 TO 86+54, SOLID C (LANE LINE)
 STA. 86+25 TO 89+54, SOLID LT (LANE LINE)
 STA. 86+54 TO 88+61, DOTTED C (LANE LINE)
 STA. 87+07 TO 88+61, DOTTED RT (LANE LINE)
 STA. 88+61 TO 91+00, SOLID RT (LANE LINE)
 STA. 89+54 TO 90+90, DOTTED LT (LANE LINE)
 STA. 90+90 TO 91+00, DASHED LT (LANE LINE)

DURABLE & TEMPORARY 4 INCH YELLOW LINE
 (ALL LINES WILL INCLUDE C BREAKS FOR SIDE ROADS)
 STA. 86+25 TO 88+61, DOUBLE SOLID RT
 STA. 88+61 TO 91+00, SOLID LT & RT

DURABLE LETTER OR SYMBOL
 STA. 86+45, LT "ONLY"
 STA. 86+50, LT ARROW
 STA. 86+50, RT ARROW
 STA. 87+45, LT ARROW
 STA. 87+45, RT ARROW
 STA. 88+49, LT "ONLY"
 STA. 88+65, RT ARROW
 STA. 89+50, LT ARROWS (2)
 STA. 89+72, RT "ONLY"
 STA. 90+80, RT ARROW

TEMPORARY LETTER OR SYMBOL, PAINT
 STA. 86+50, LT ARROW
 STA. 86+50, RT ARROW
 STA. 87+45, LT ARROW
 STA. 88+65, RT ARROW
 STA. 89+50, LT ARROWS (2)
 STA. 90+80, RT ARROW

REMOVING SIGNS
 AS SHOWN - 2

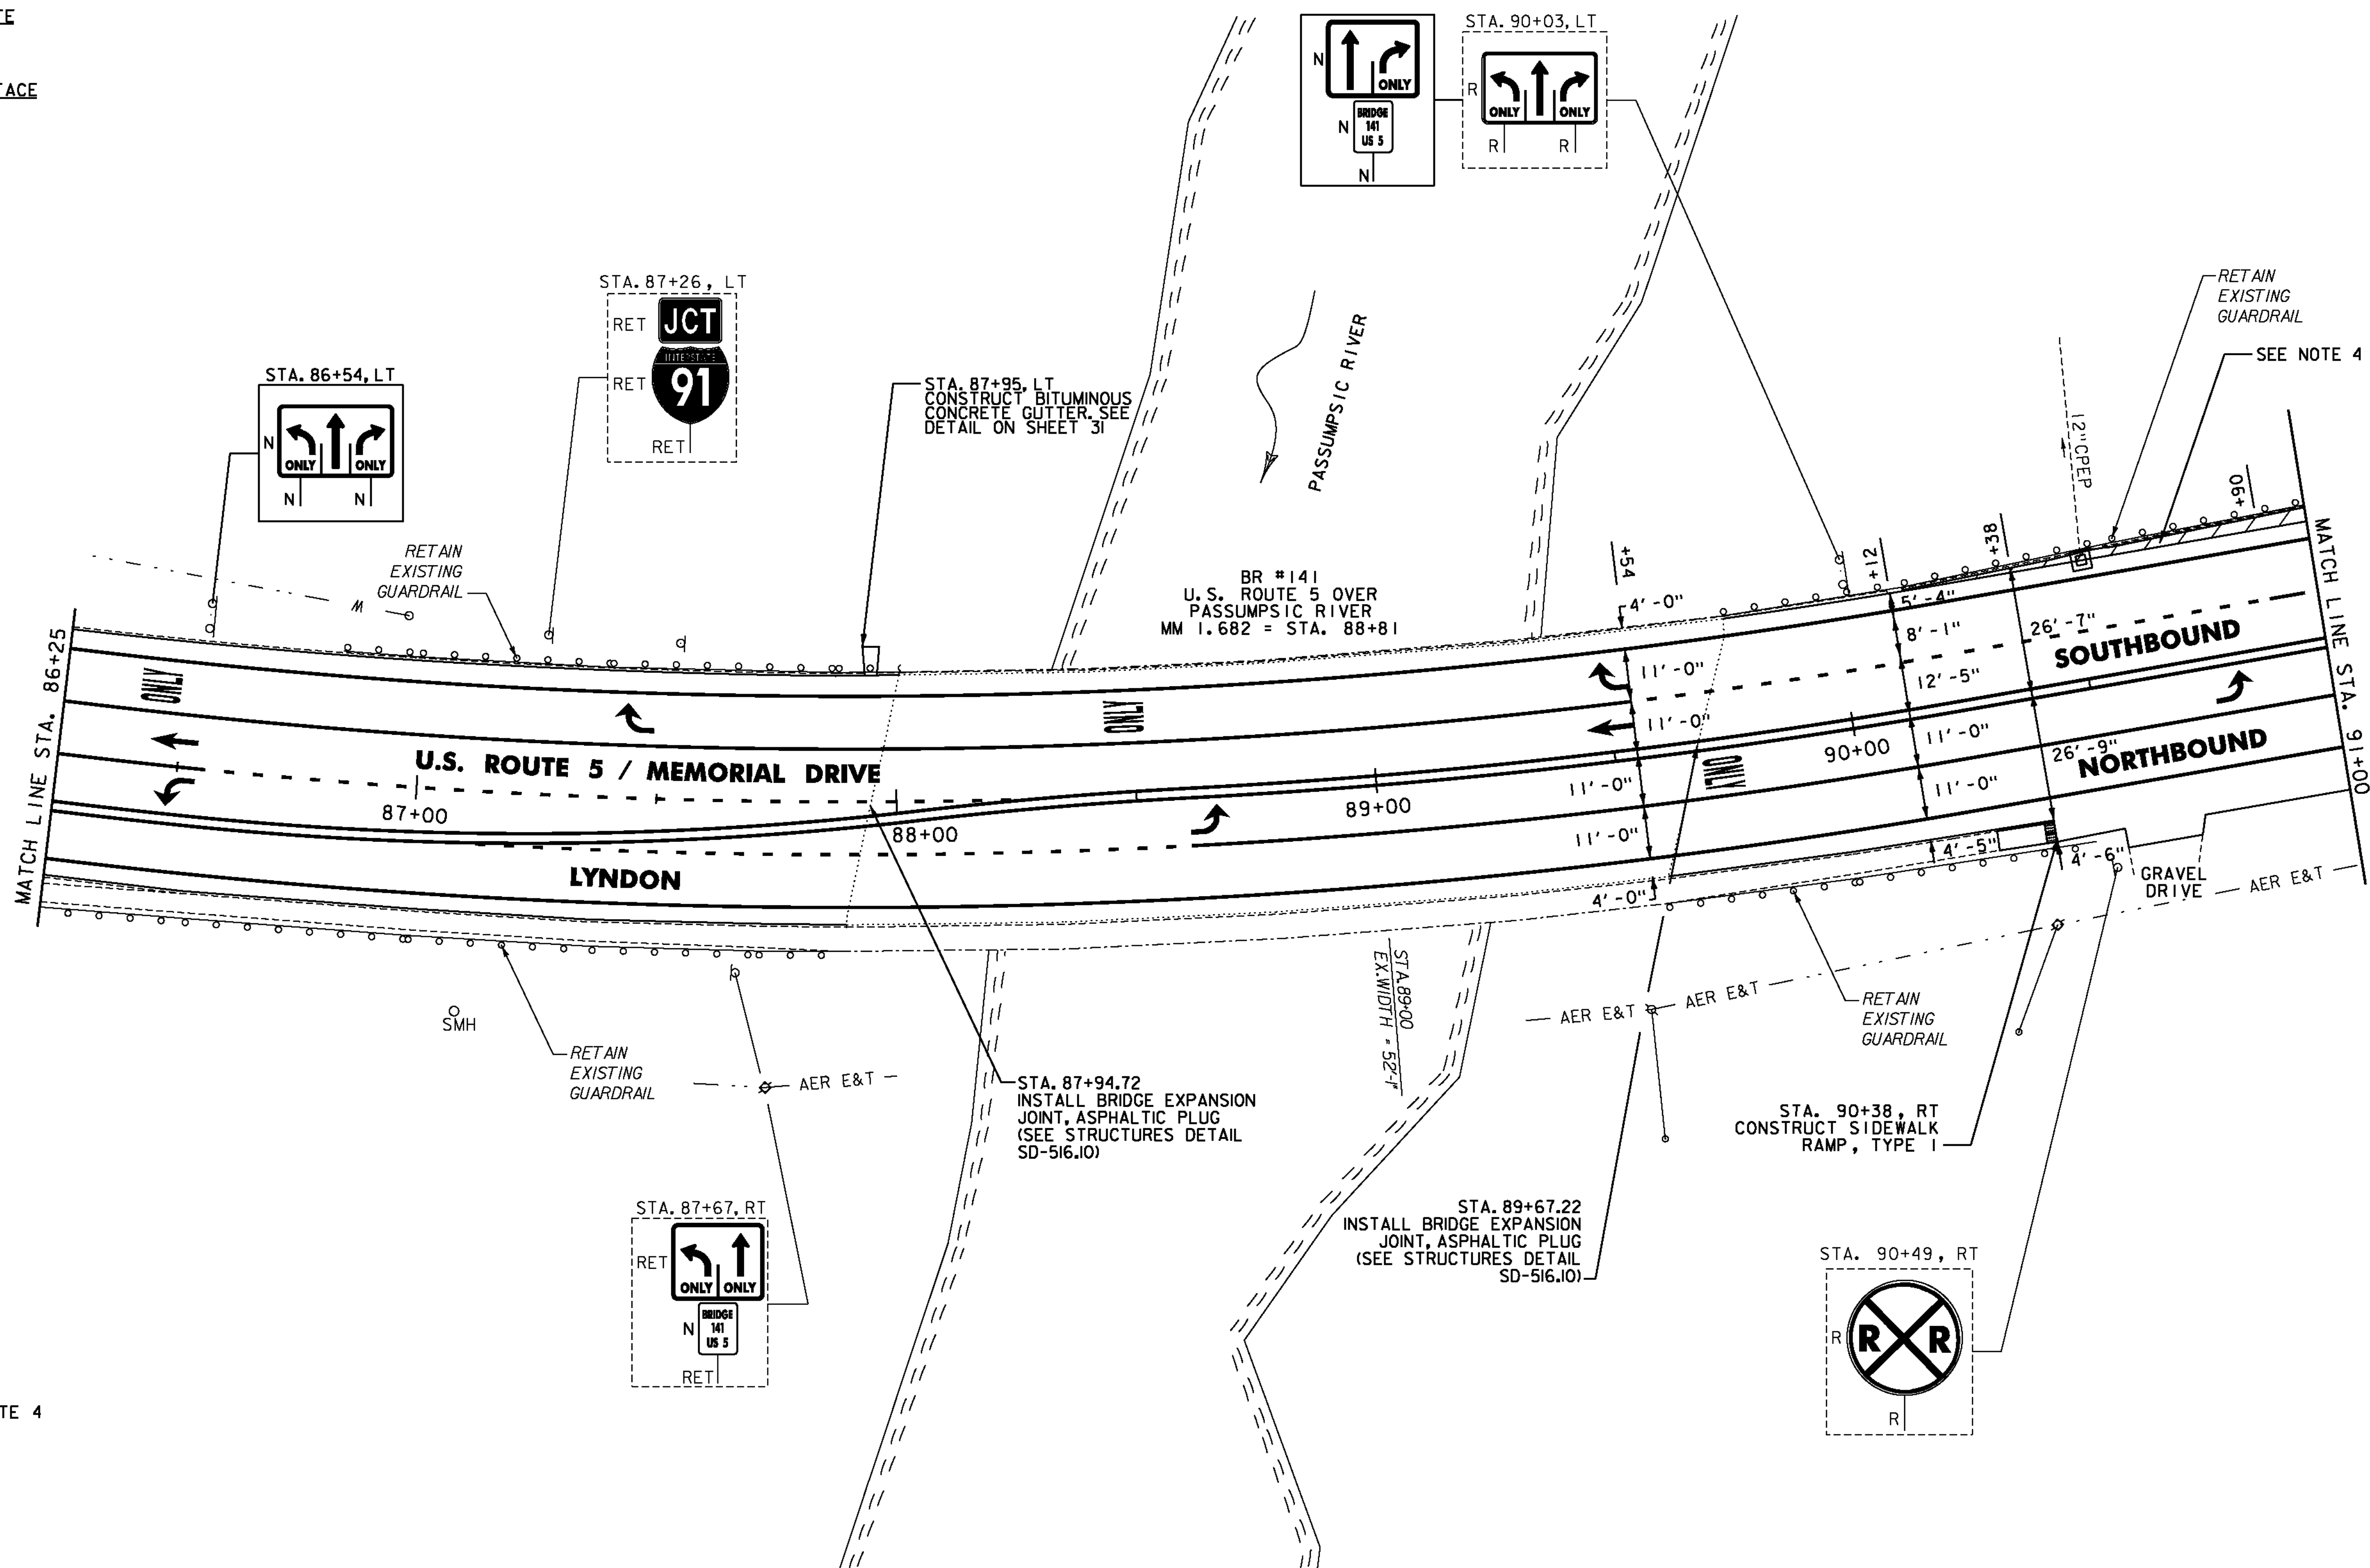

SEE NOTE 4

- NOTES:
- FOR LEGENDS, SEE SHEET 33.
 - ALL EXISTING SIGNS NOT SHOWN SHALL BE RETAINED.
 - DURABLE MARKINGS DETAILED ON THIS SHEET ARE OPTION BID ITEMS. SEE SHEETS 6-7.
 - EXCAVATE HATCHED AREA A MINIMUM OF FOUR INCHES, PAID FOR AS ITEM 203.15 COMMON EXCAVATION. INSTALL FOUR INCHES OF TOPSOIL, THEN SEED, FERTILIZER, LIMESTONE AND TEMPORARY EROSION MATTING PER APPLICATION RATES ON SHEET 4.



NOT TO SCALE

**PROJECT
 LAYOUT
 SHEET #41**

PROJECT NAME: ST. JOHNSBURY-LYNDON

PROJECT NUMBER: STP 2928(I)

FILE NAME: p10c262.dgn
 PROJECT LEADER: JLL
 DESIGNED BY: MCF
 IPARM FILE: p10c262141.i

PLOT DATE: 10/17/2013
 DRAWN BY: STANTEC
 CHECKED BY: JLL
 SHEET 73 OF 133