

REHAB. DIS. CBS OR MHS. CLASS I OR II
 STA. 126+61, RT

CHANGING ELEVATION OF SEWER MANHOLES
 STA. 126+93, LT

STEEL BEAM GUARDRAIL, GALVANIZED
 STA. 124+18 TO 124+36, LT
 STA. 124+61 TO 125+19, LT

HD STEEL BEAM GUARDRAIL, GALVANIZED
 STA. 124+36 TO 124+61, LT

ANCHOR FOR STEEL BEAM RAIL
 STA. 124+18, LT
 STA. 125+19, LT

REMOVAL AND DISPOSAL OF GUARDRAIL
 STA. 124+17.5 TO 125+18.5, LT


DURABLE & TEMPORARY 4 INCH WHITE LINE
 (ALL LINES WILL INCLUDE EDGE LINE BREAKS
 AND RADIUS FOR SIDE ROADS)
 STA. 123+00 TO 128+50, SOLID LT & RT
 STA. 124+04, SOLID RT (LANE LINE, CHARLES STREET)
 STA. 124+04, SOLID RT (EDGE LINES, CHARLES STREET)

DURABLE & TEMPORARY 4 INCH YELLOW LINE
 (ALL LINES WILL INCLUDE BREAKS FOR SIDE ROADS)
 STA. 123+00 TO 128+50, SOLID LT & RT
 STA. 124+04, DOUBLE SOLID RT (CHARLES STREET)

DURABLE & TEMPORARY 24 INCH STOP BAR
 STA. 124+04, RT (CHARLES STREET)

REMOVING SIGNS
 AS SHOWN - 4

DURABLE & TEMPORARY LETTER OR SYMBOL
 STA. 124+04, RT (CHARLES STREET) "STOP" (2)

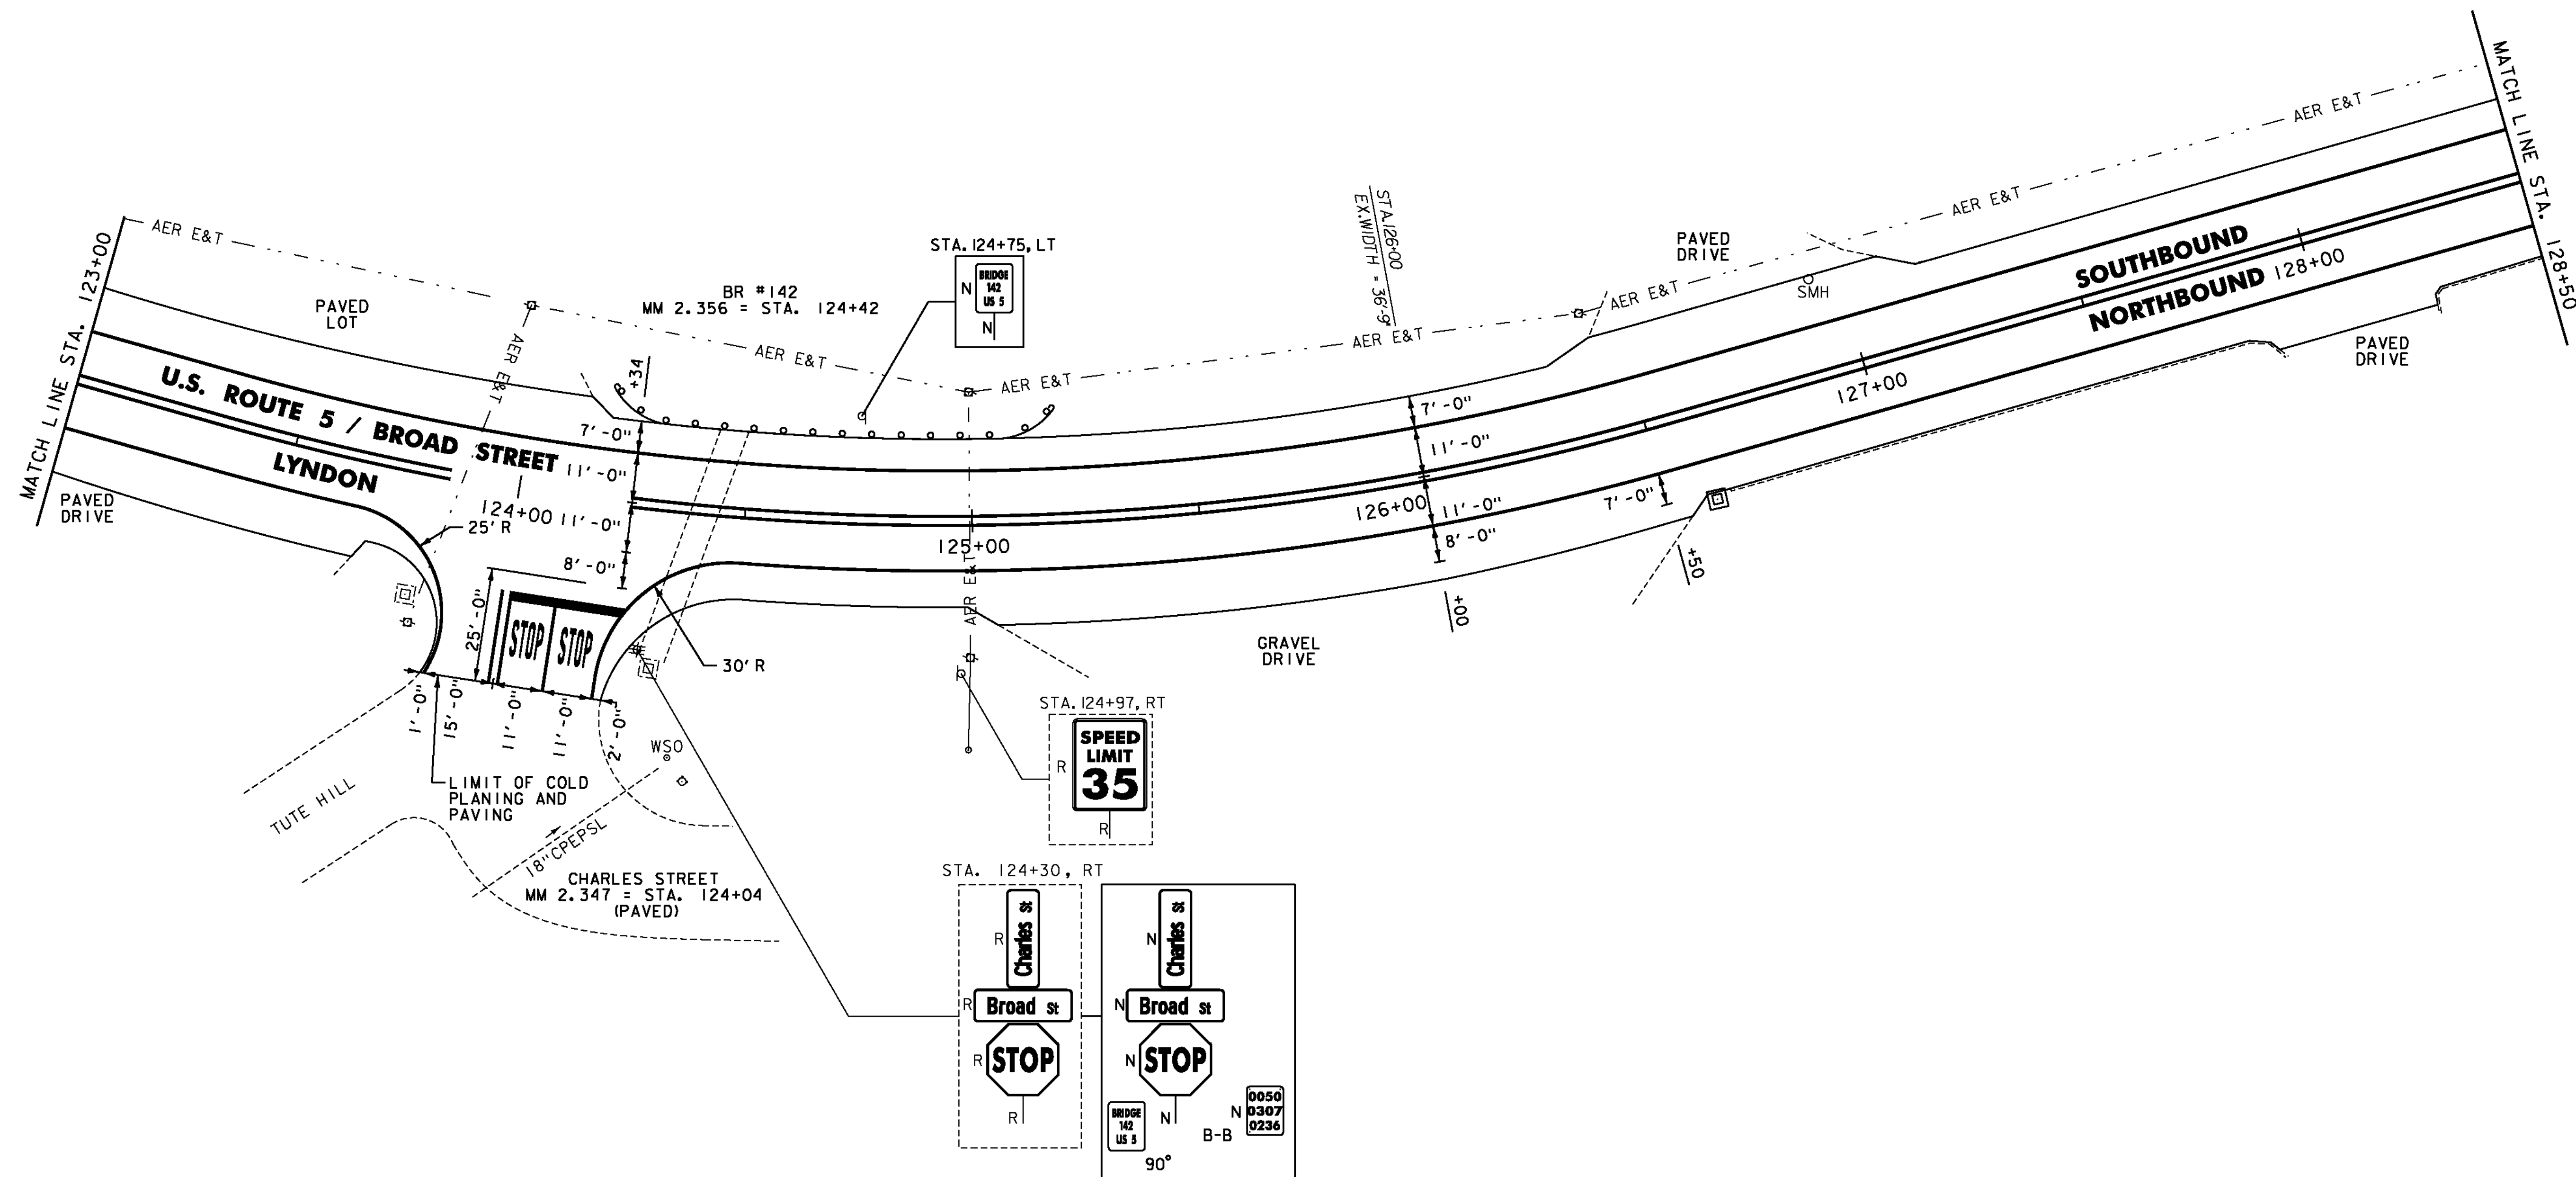

NOTES:

- FOR LEGENDS, SEE SHEET 33.
- ALL EXISTING SIGNS NOT SHOWN SHALL BE RETAINED.
- DURABLE MARKINGS DETAILED ON THIS SHEET ARE OPTION BID ITEMS. SEE SHEETS 6-7.

NOT TO SCALE



PROJECT LAYOUT SHEET #46

PROJECT NAME: ST. JOHNSBURY-LYNDON

PROJECT NUMBER: STP 2928(I)

FILE NAME: p10c262.dgn

PROJECT LEADER: JLL

DESIGNED BY: MCF

IPARM FILE: p10c262146.i

PLOT DATE: 10/17/2013

DRAWN BY: STANTEC

CHECKED BY: JLL

SHEET 78 OF 133