



LEVEL AND OVERLAY TYPICAL SECTION

NEWBURY US ROUTE 5 - N 219+65 - N 224+00	(3 FEET SHOULDER)	N 313+89 - N 373+35	LT (3 FEET SHOULDER)
N 224+00 - N 231+70	LT (9 FEET SHOULDER)	N 313+89 - N 426+96	RT (4 FEET SHOULDER)
N 224+00 - N 225+56	RT (8 FEET SHOULDER)	N 373+35 - N 423+10	LT (4 FEET SHOULDER)
N 225+56 - N 231+70	RT (13 FEET SHOULDER)	N 423+10 - N 464+83	LT (3 FEET SHOULDER)
N 231+70 - N 266+77	(3 FEET SHOULDER)	N 426+96 - N 436+46	RT (3 FEET SHOULDER)
N 266+77 - N 308+90	(4 FEET SHOULDER)	N 436+46 - N 472+55	RT (4 FEET SHOULDER)
N 312+09 - N 313+89	(3 FEET SHOULDER)	N 464+83 - N 472+55	LT (4 FEET SHOULDER)

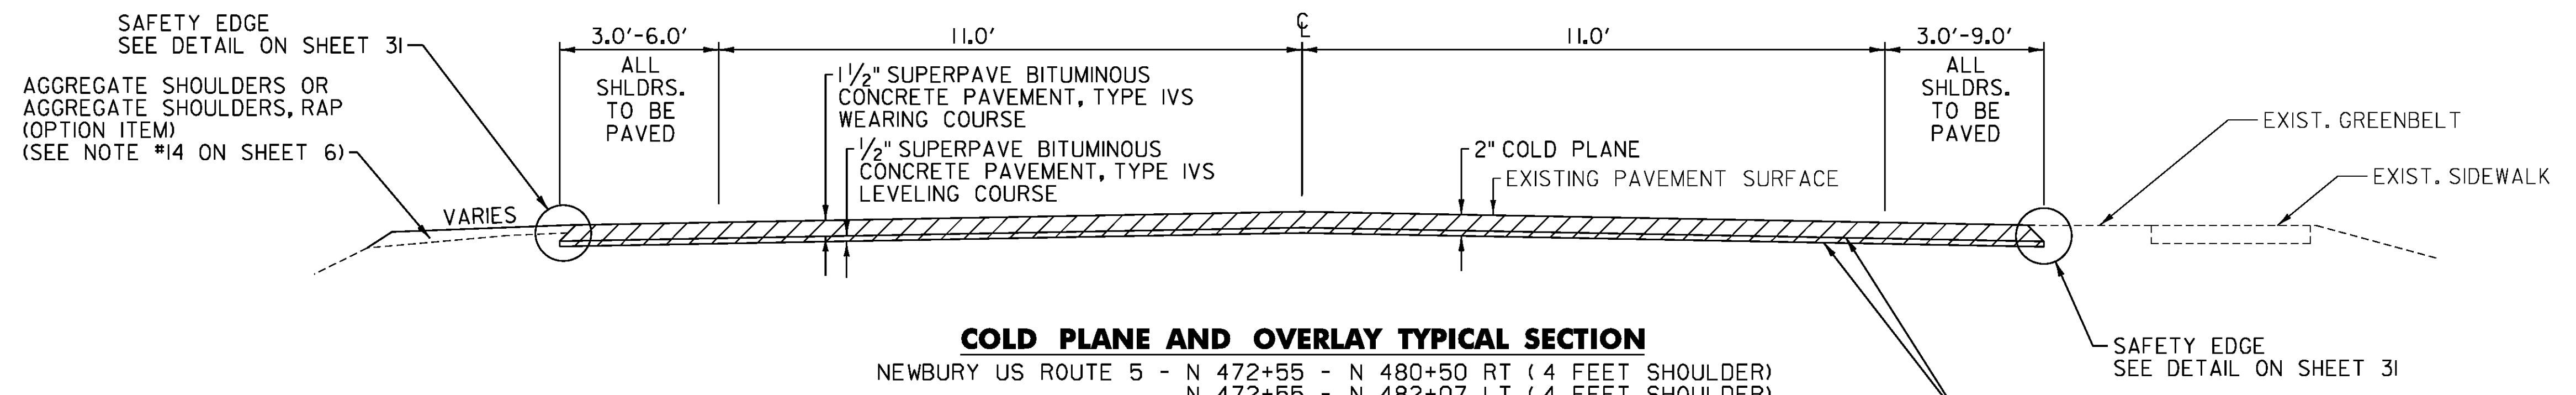

COLD PLANE AND OVERLAY TYPICAL SECTION

NEWBURY US ROUTE 5 - N 472+55 - N 480+50	RT (4 FEET SHOULDER)
N 472+55 - N 482+07	LT (4 FEET SHOULDER)
N 480+50 - N 486+55	RT (3 FEET SHOULDER)
N 482+07 - N 489+20	LT (3 FEET SHOULDER)
N 486+55 - N 491+33	RT (4 FEET SHOULDER)
N 489+20 - N 491+90	LT (5 FEET SHOULDER)
N 491+33 - N 492+40	RT (9 FEET SHOULDER)
N 491+90 - N 494+18	LT (6 FEET SHOULDER)
N 492+40 - N 494+18	RT (5 FEET SHOULDER)

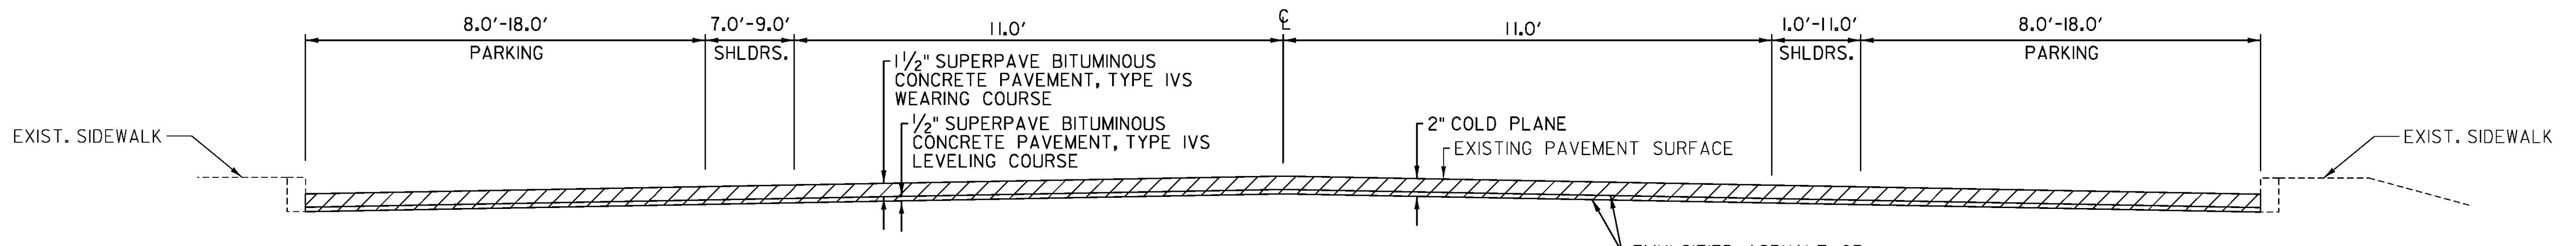

COLD PLANE AND OVERLAY TYPICAL SECTION

NEWBURY US ROUTE 5 - N 494+18 - N 499+52

PROJECT NAME: BRADFORD-RYEGATE	PLOT DATE: 2/4/2016
PROJECT NUMBER: STP 2929(I)	DRAWN BY: W. GORDON
FILE NAME: z10c264frm.dgn	CHECKED BY: P. SHEDD
DESIGNED BY: N. LEMAY	SHEET 10 OF 239
TYPICAL SECTIONS SHEET 4	

NOT TO SCALE

CLD 14-0278