

TEMPORARY 4 INCH WHITE LINE, PAINT  
 DURABLE 4 INCH WHITE LINE (OPTION ITEM)  
 86+50 TO 92+50 SOLID LT & RT  
 89+00 TO 92+50 SOLID LT (DIAGONALS)

TEMPORARY 4 INCH YELLOW LINE, PAINT  
 DURABLE 4 INCH YELLOW LINE (OPTION ITEM)  
 86+50 TO 86+55 DOUBLE SOLID LT & RT  
 86+55 TO 92+50 SOLID LT & RT  
 89+00 TO 92+50 SOLID LT (SHOULDER)

TEMPORARY 8 INCH WHITE LINE, PAINT  
 DURABLE 8 INCH WHITE LINE (OPTION ITEM)  
 89+00 TO 92+50 SOLID LT (SHOULDER)


DURABLE 8 INCH YELLOW LINE (OPTION ITEM)  
 86+50 TO 86+63 CL (DIAGONALS)

DURABLE LETTER OR SYMBOL (OPTION ITEM)  
 89+94 LT - STRAIGHT ARROW  
 90+06 LT - PEDESTRIAN SYMBOL  
 90+06 LT - BICYCLE SYMBOL

REHAB. DROP INLETS, CATCH BASINS,  
 OR MANHOLES, CLASS I, CLASS II  
 91+47 LT  
 91+47 RT

REMOVING SIGNS  
 AS SHOWN - 1

ERECTING SALVAGED SIGNS  
 AS SHOWN - 1

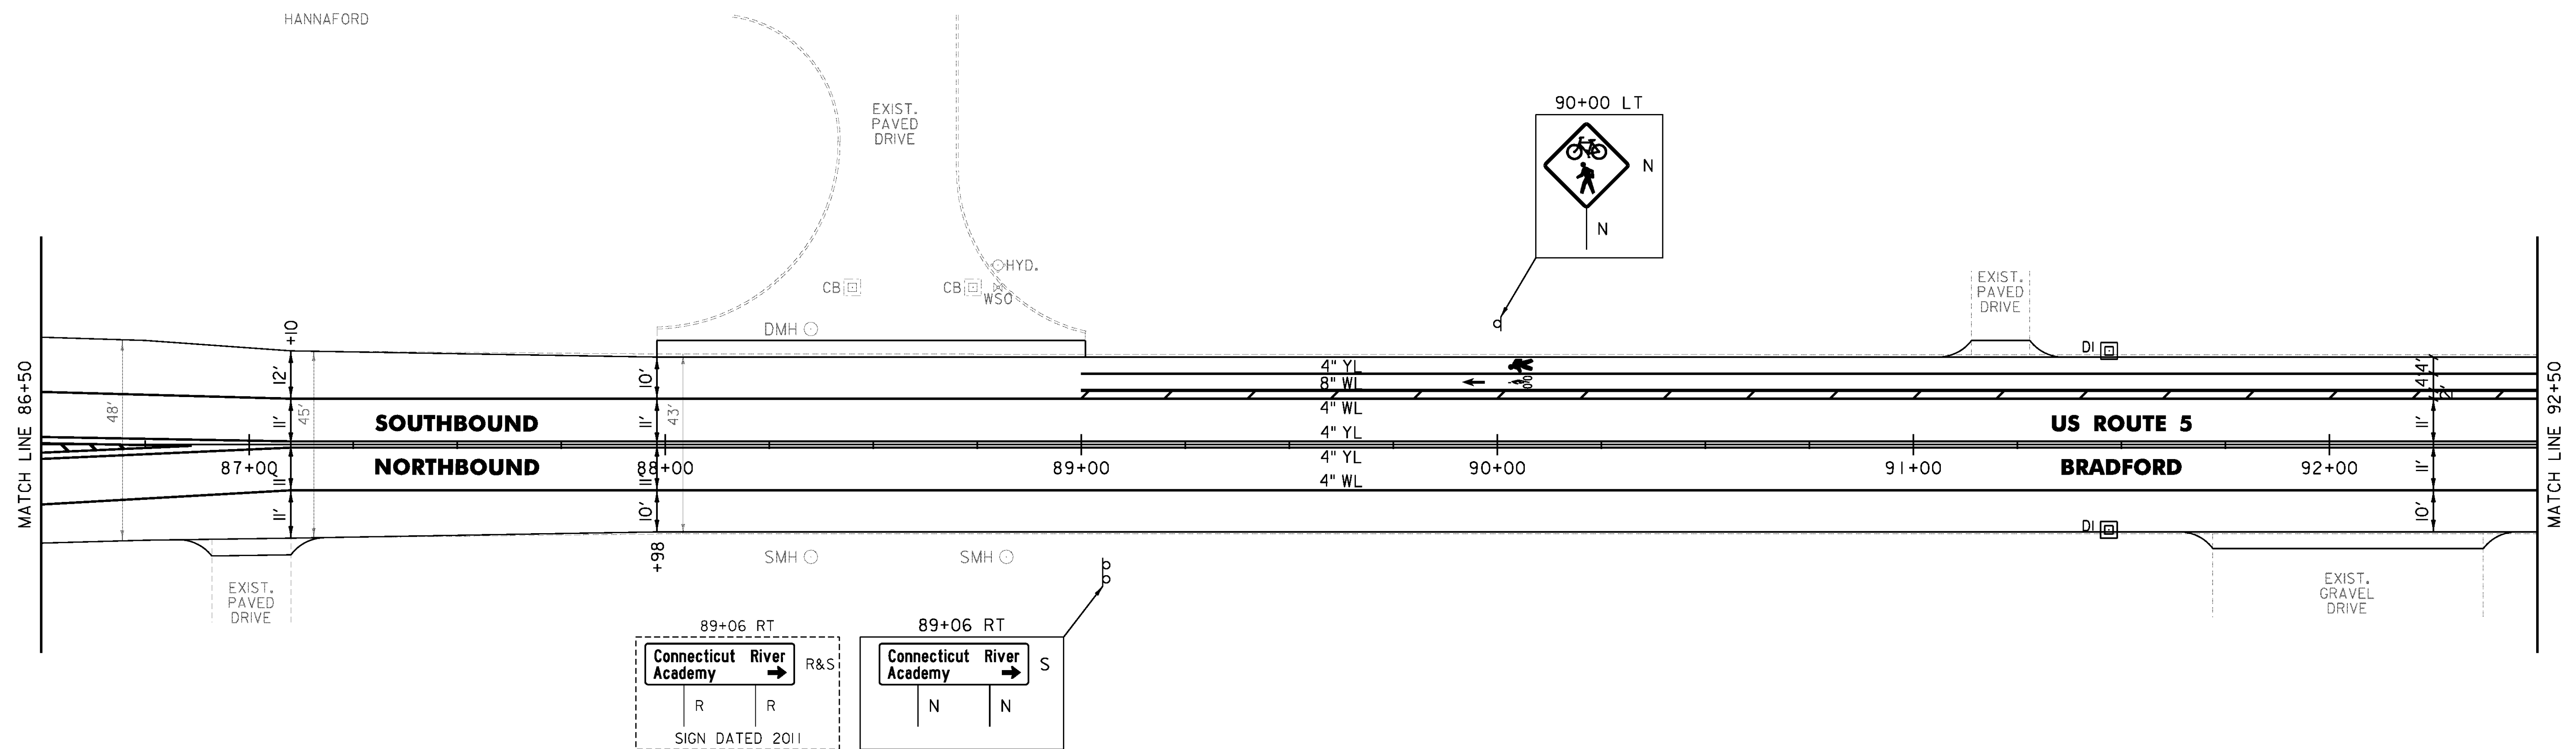

NOT TO SCALE

PROJECT NAME: BRADFORD-RYEGATE	PLOT DATE: 2/4/2016
PROJECT NUMBER: STP 2929(I)	DRAWN BY: W. GORDON
FILE NAME: z10c264bdr.dgn	CHECKED BY: P. SHEDD
DESIGNED BY: N. LEMAY	SHEET 60 OF 239
US 5 PLAN SHEET 2	