

TEMPORARY 4 INCH WHITE LINE, PAINT
 DURABLE 4 INCH WHITE LINE (OPTION ITEM)
 110+50 TO 116+50 SOLID LT & RT
 110+50 TO 116+50 SOLID LT (DIAGONALS)

TEMPORARY 4 INCH YELLOW LINE, PAINT
 DURABLE 4 INCH YELLOW LINE (OPTION ITEM)
 110+50 TO 116+50 SOLID LT & RT
 110+50 TO 116+50 SOLID LT (SHOULDER)

TEMPORARY 8 INCH WHITE LINE, PAINT
 DURABLE 8 INCH WHITE LINE (OPTION ITEM)
 110+50 TO 116+50 SOLID LT (SHOULDER)

REHAB. DROP INLETS, CATCH BASINS,
 OR MANHOLES, CLASS I, CLASS II

110+52 LT
 112+53 RT
 112+67 LT
 114+52 RT

STEEL BEAM GUARDRAIL, GALVANIZED

110+50 TO 116+50 RT
 114+74.5 TO 115+12 LT


ANCHOR FOR STEEL BEAM RAIL
 1 (SEE STANDARD G-1d)

REMOVAL AND DISPOSAL OF GUARDRAIL

110+50 TO 116+50 RT
 114+74.5 TO 115+12 LT

DELINEATOR WITH STEEL POST
 115+12 LT

REMOVING SIGNS
 AS SHOWN - 1

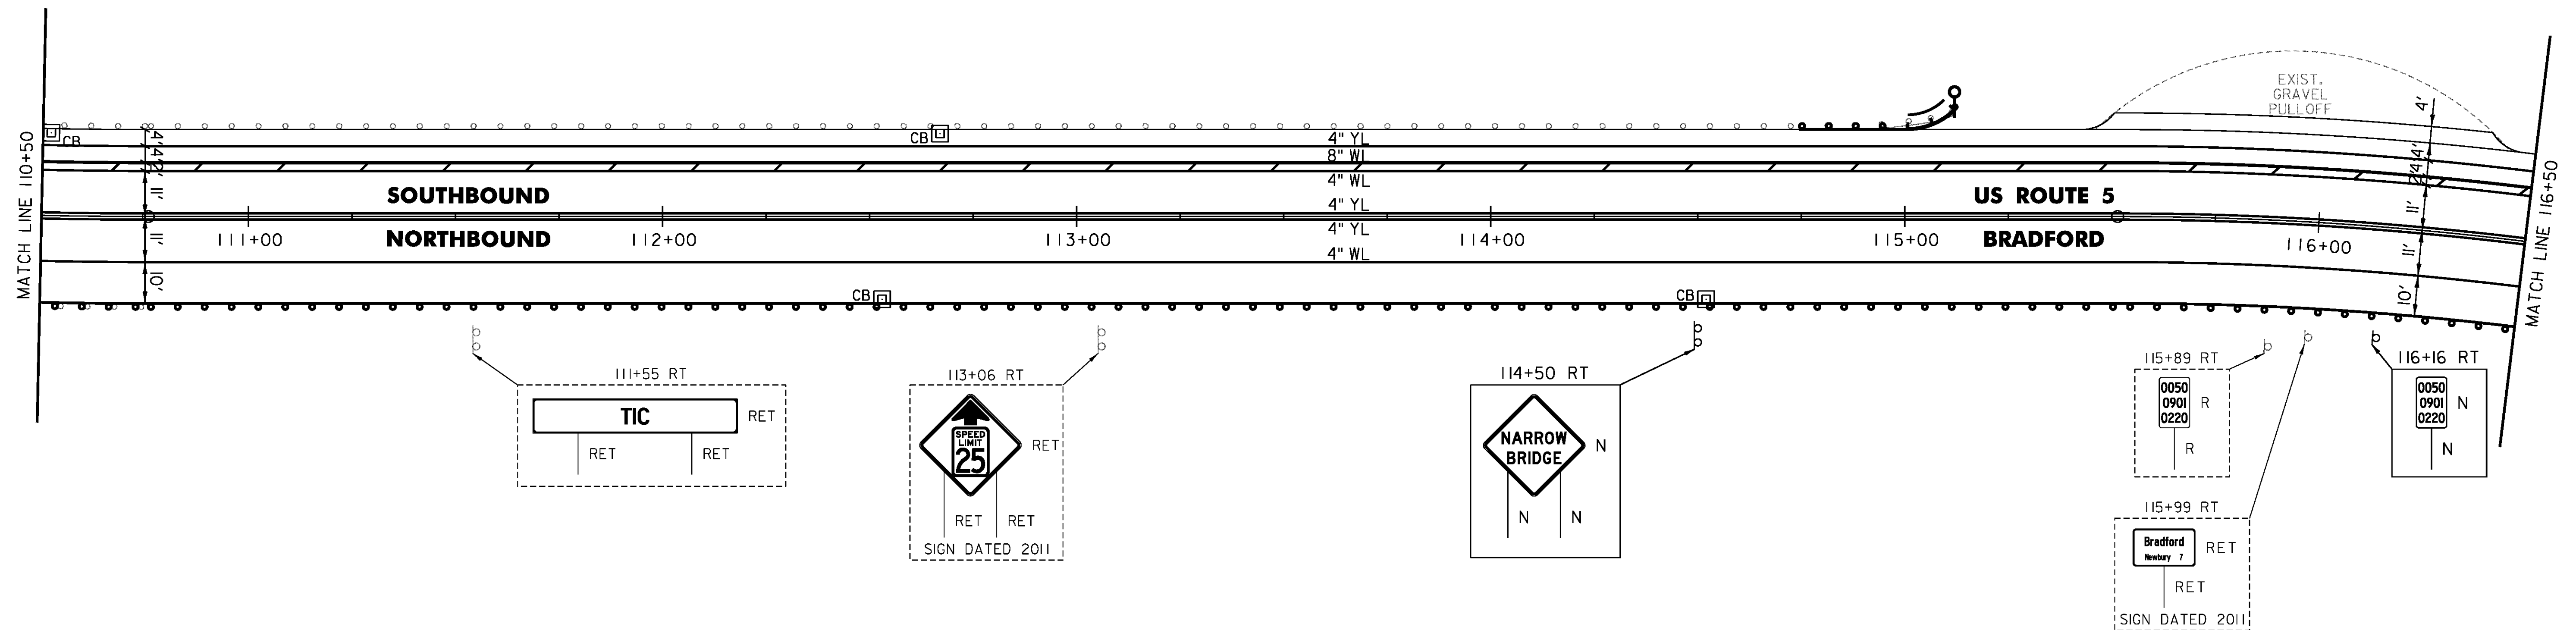

NOT TO SCALE

PROJECT NAME: BRADFORD-RYEGATE
 PROJECT NUMBER: STP 2929(I)

FILE NAME: z10c264bdr.dgn
 PROJECT LEADER: P. SHEDD
 DESIGNED BY: N. LEMAY
 US 5 PLAN SHEET 6

PLOT DATE: 2/4/2016
 DRAWN BY: W. GORDON
 CHECKED BY: P. SHEDD
 SHEET 64 OF 239